




38+25

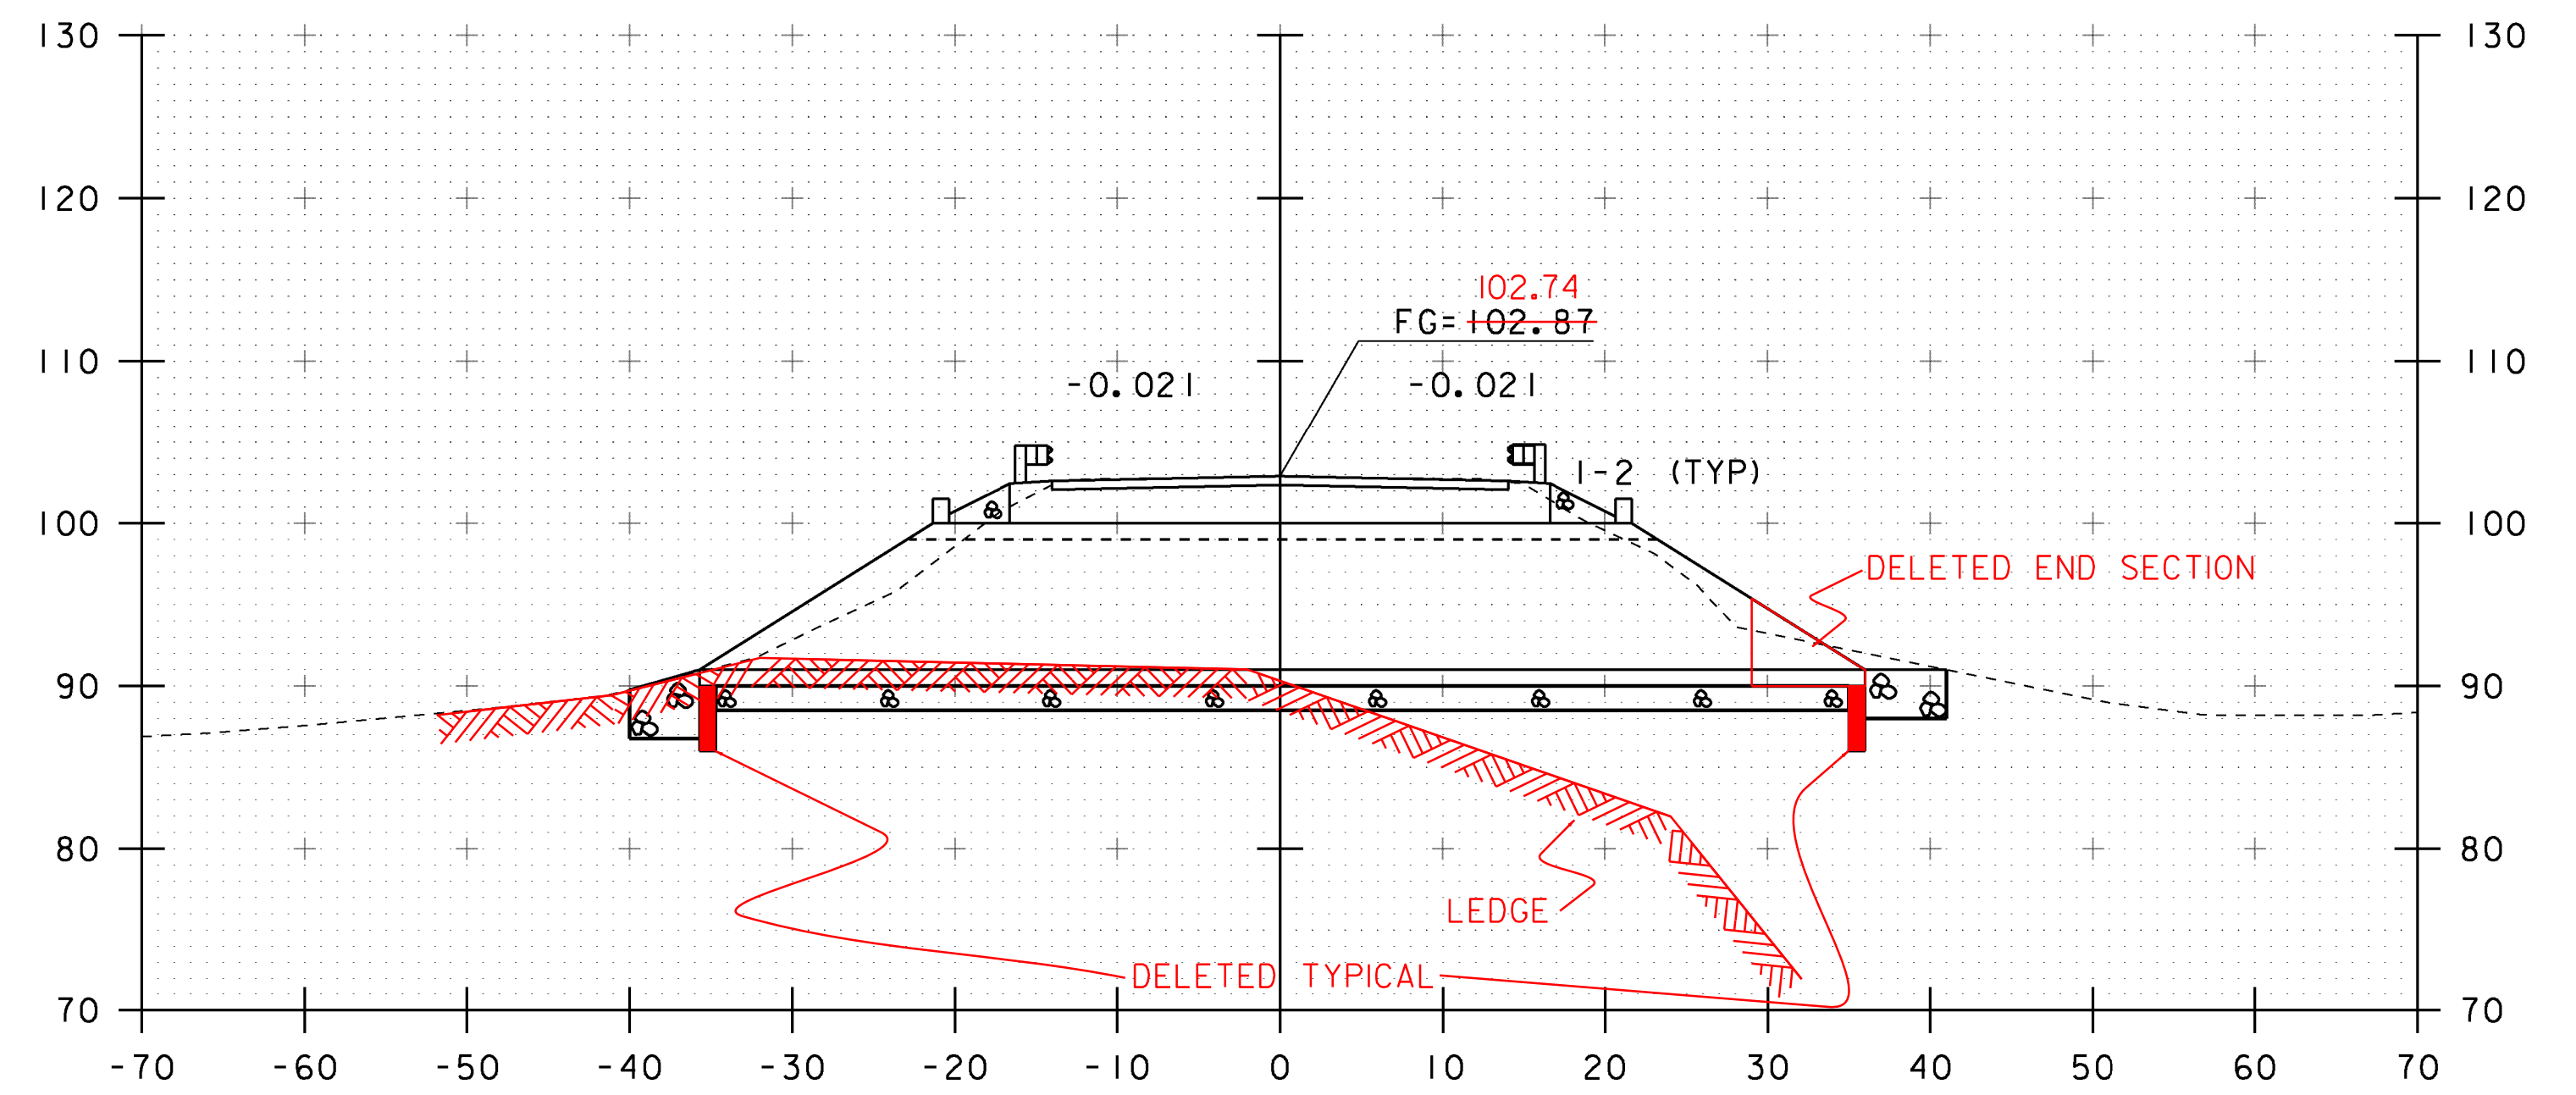

☐ BOX CULVERT
38+65

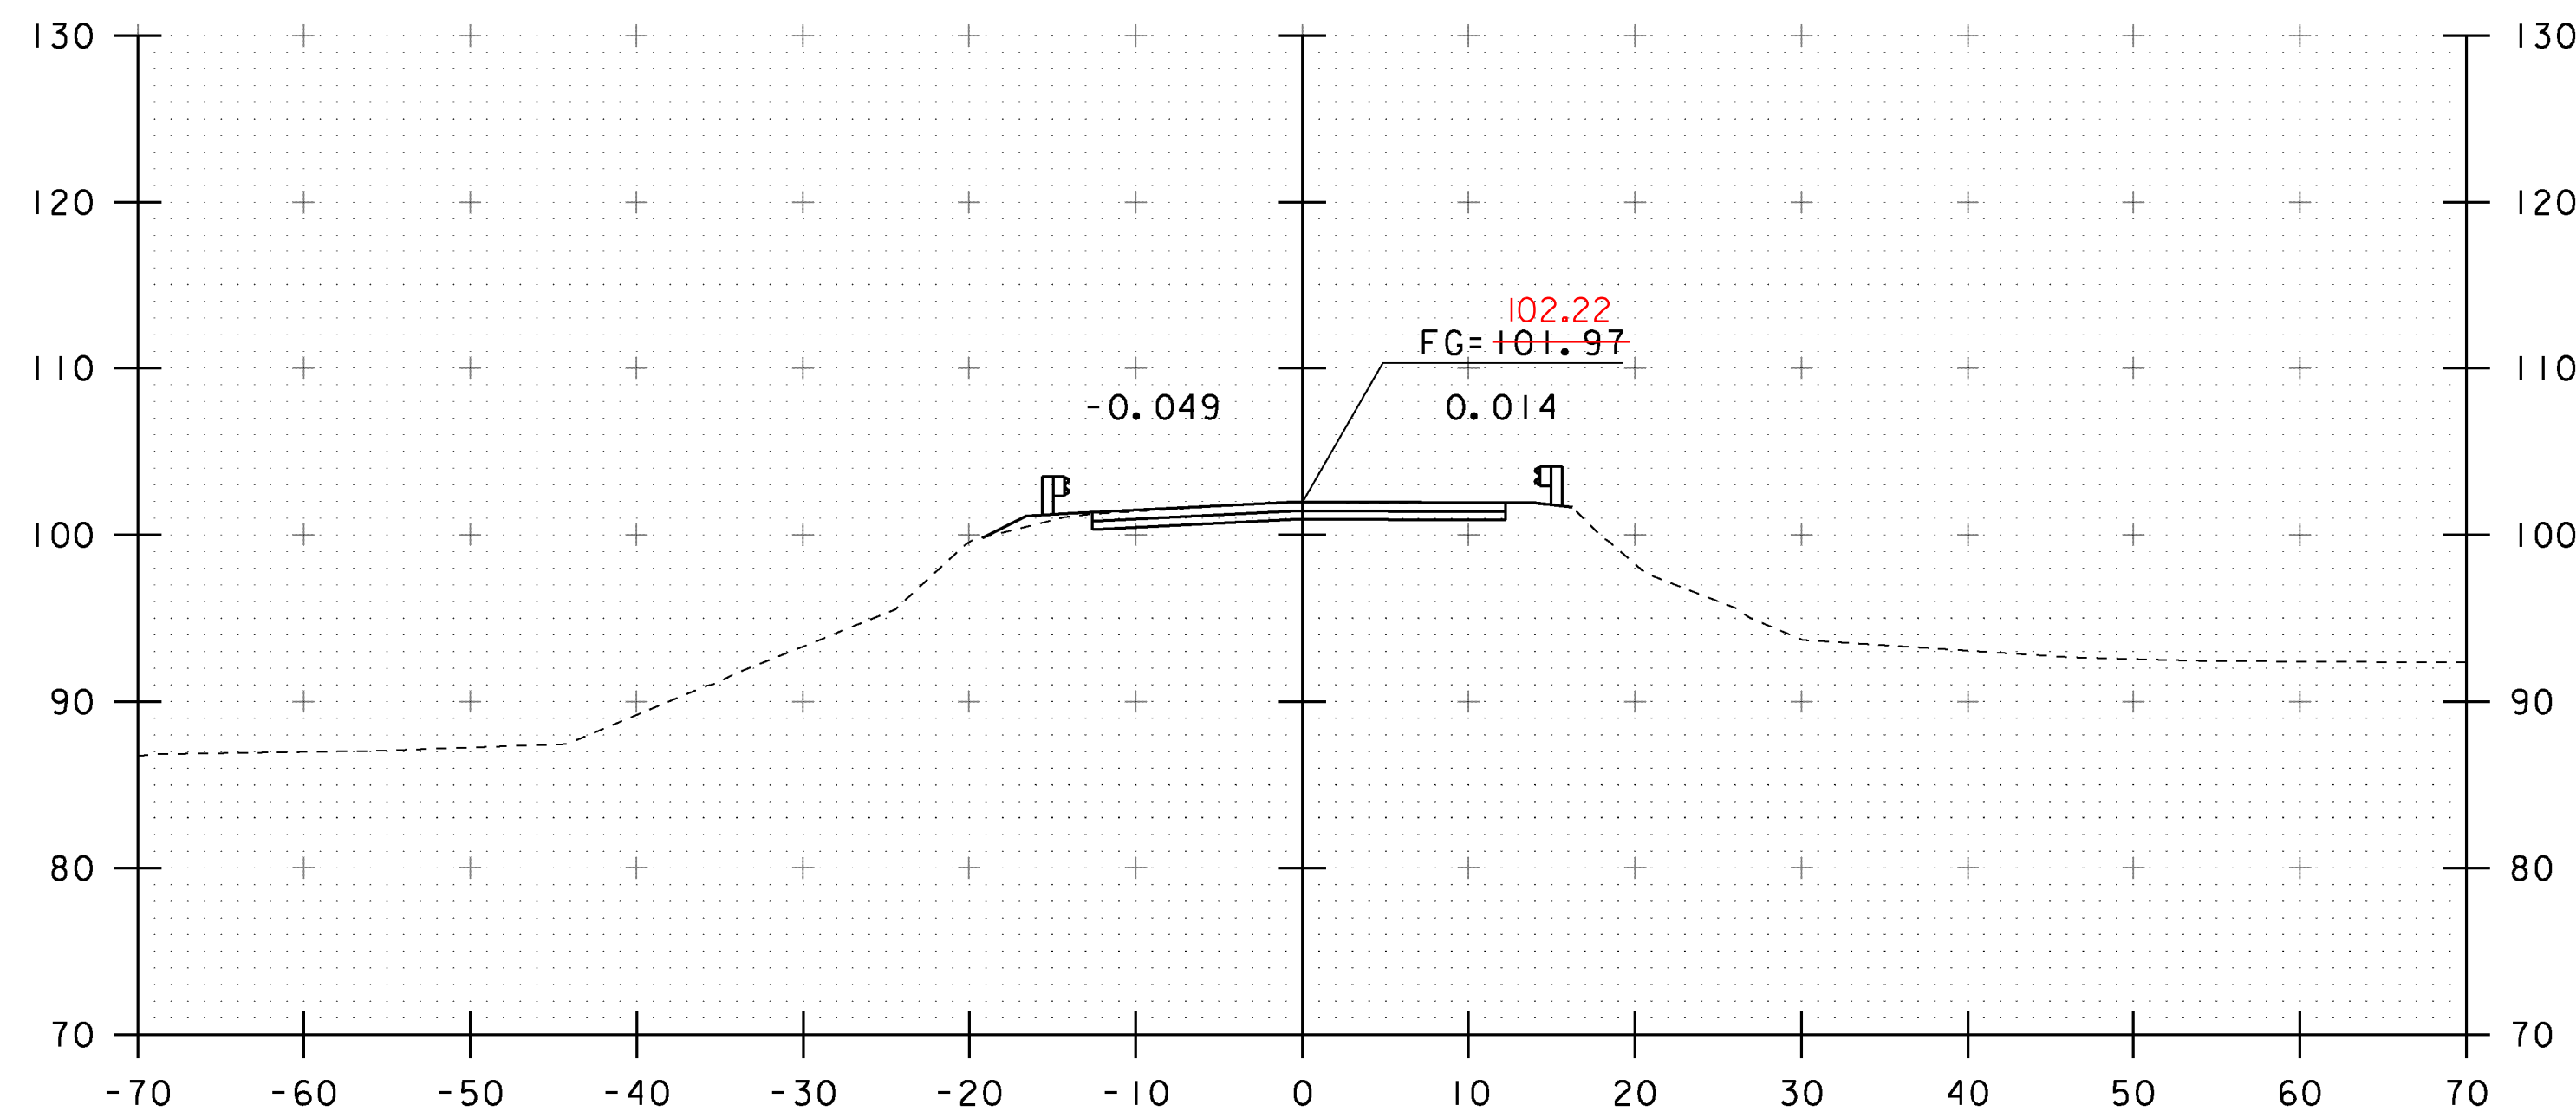

BEGIN PROJECT
38+00

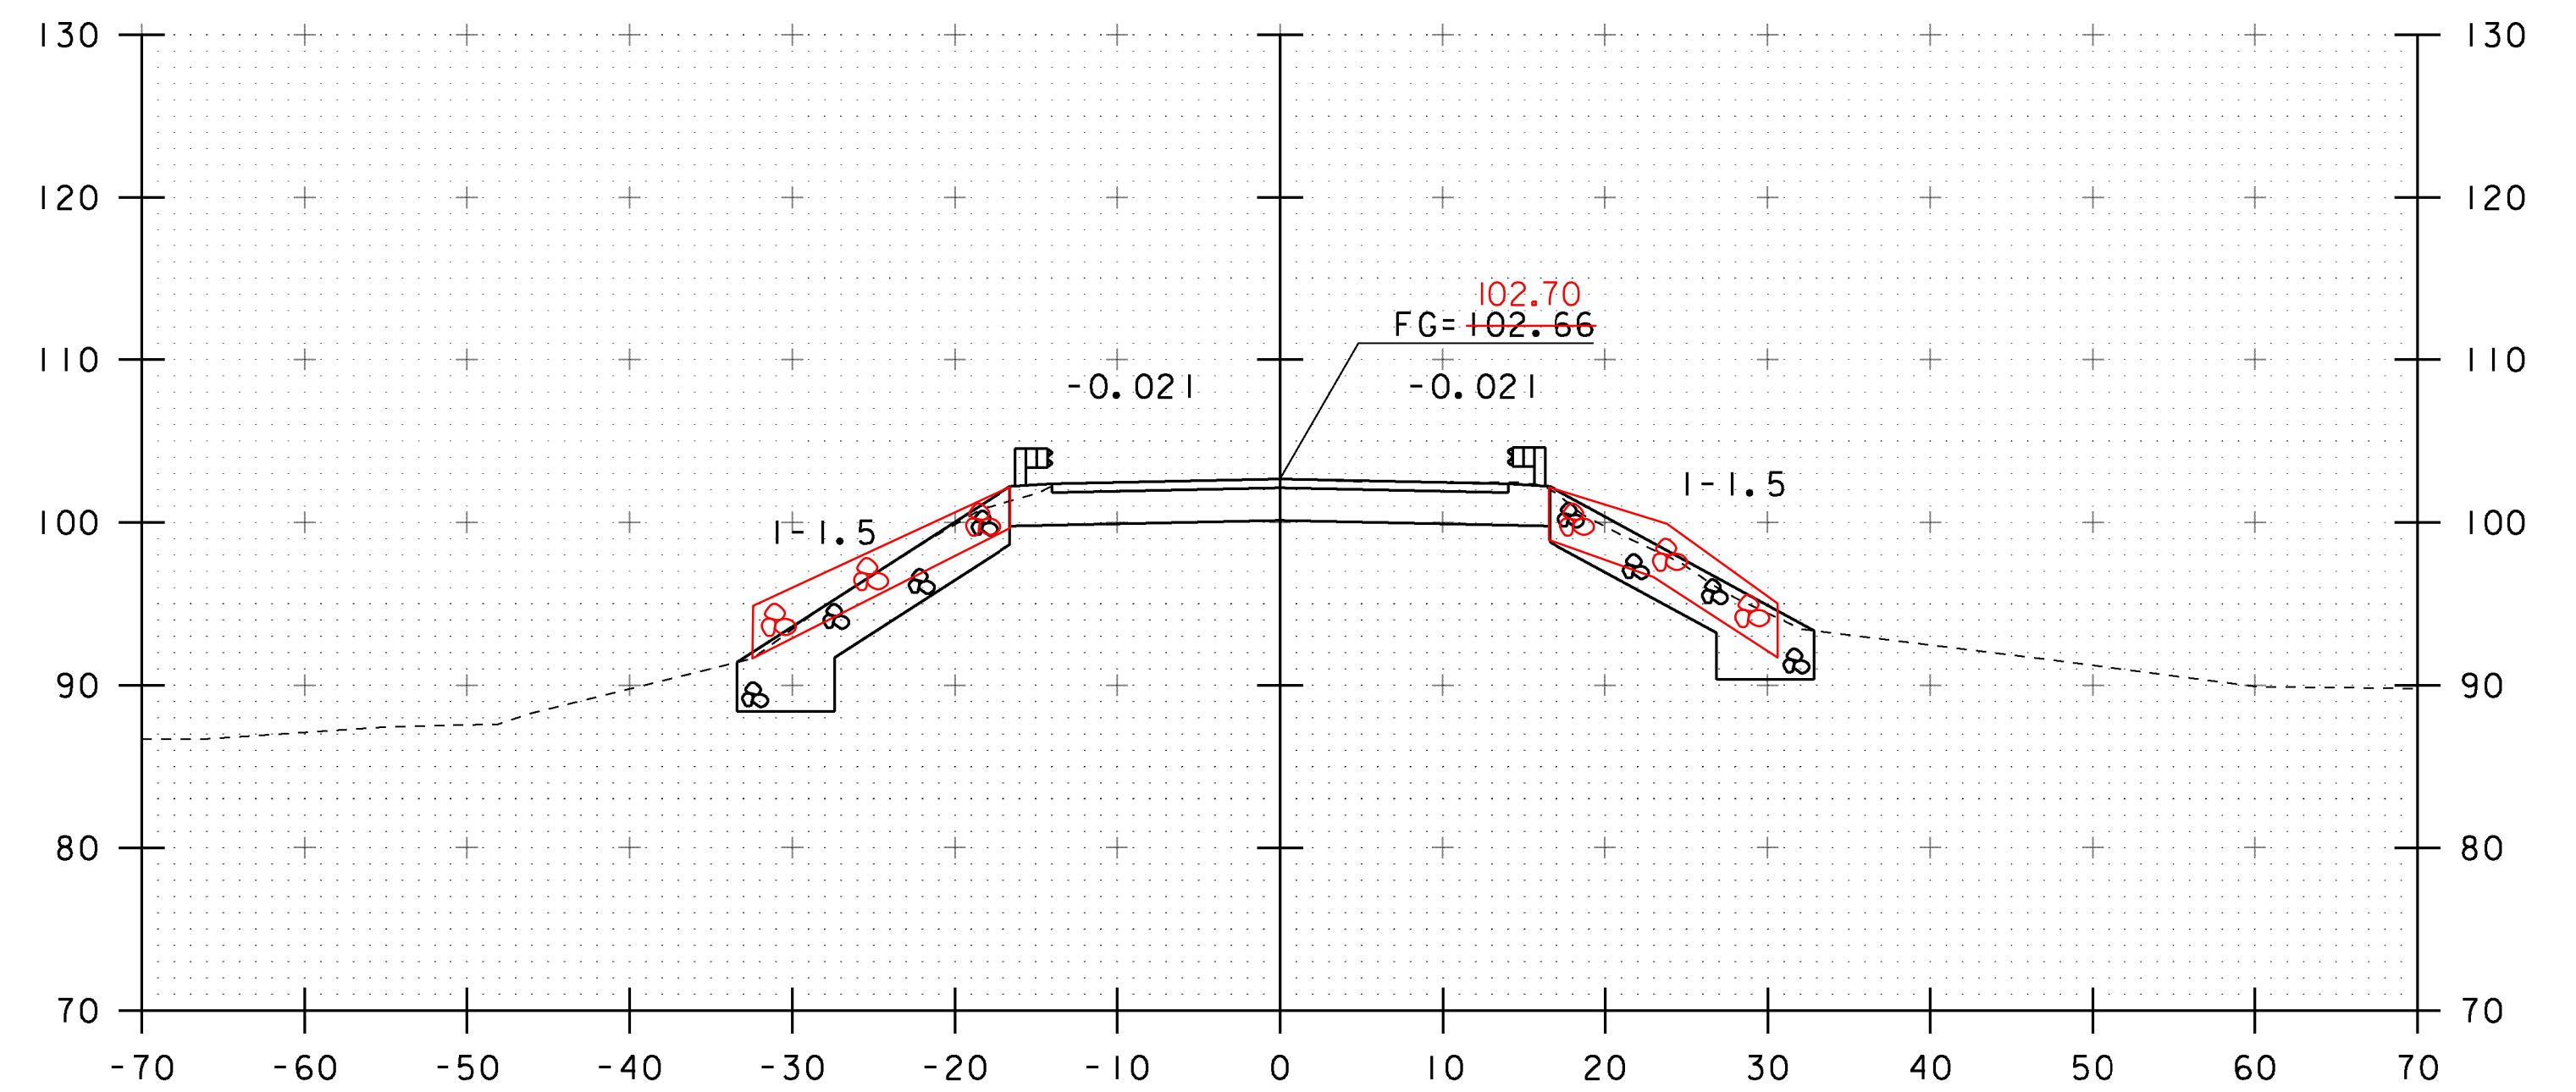

38+50

STA. 38+00 TO STA. 38+65

PROJECT NAME: ADDISON	PLOT DATE: 09-MAR-2013
PROJECT NUMBER: STP CULV(14)	DRAWN BY: J. SALVATORI
FILE NAME: s08b062xs.dgn	DESIGNED BY: J. SALVATORI
PROJECT LEADER: K. HIGGINS	CHECKED BY: W. LAMMER
MAINLINE SECTIONS - 2	SHEET 21 OF 28