




39+00

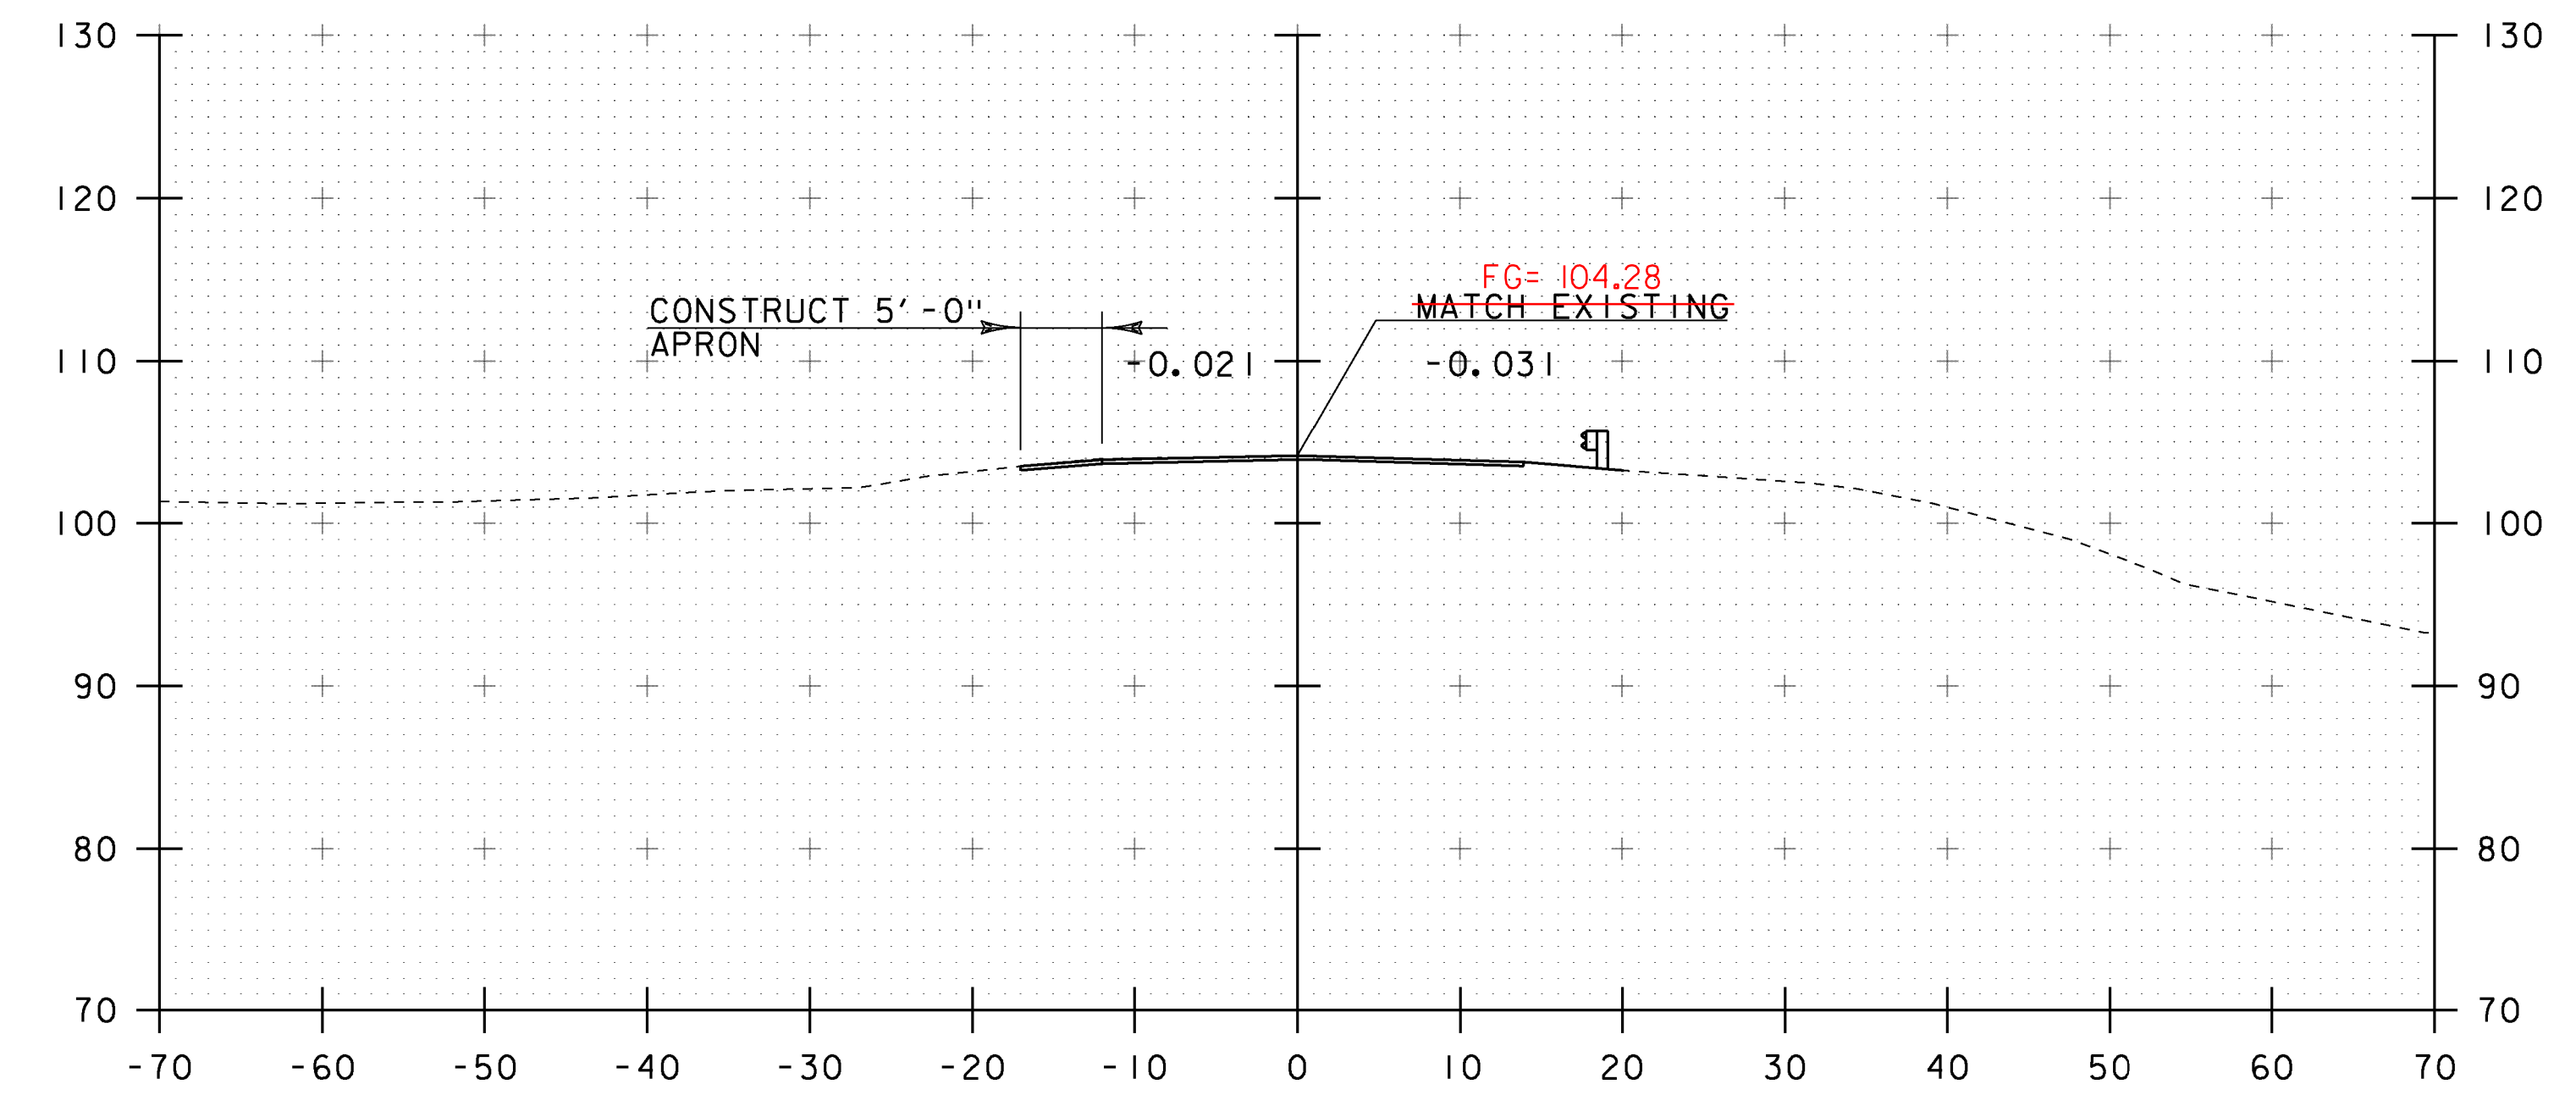

39+50

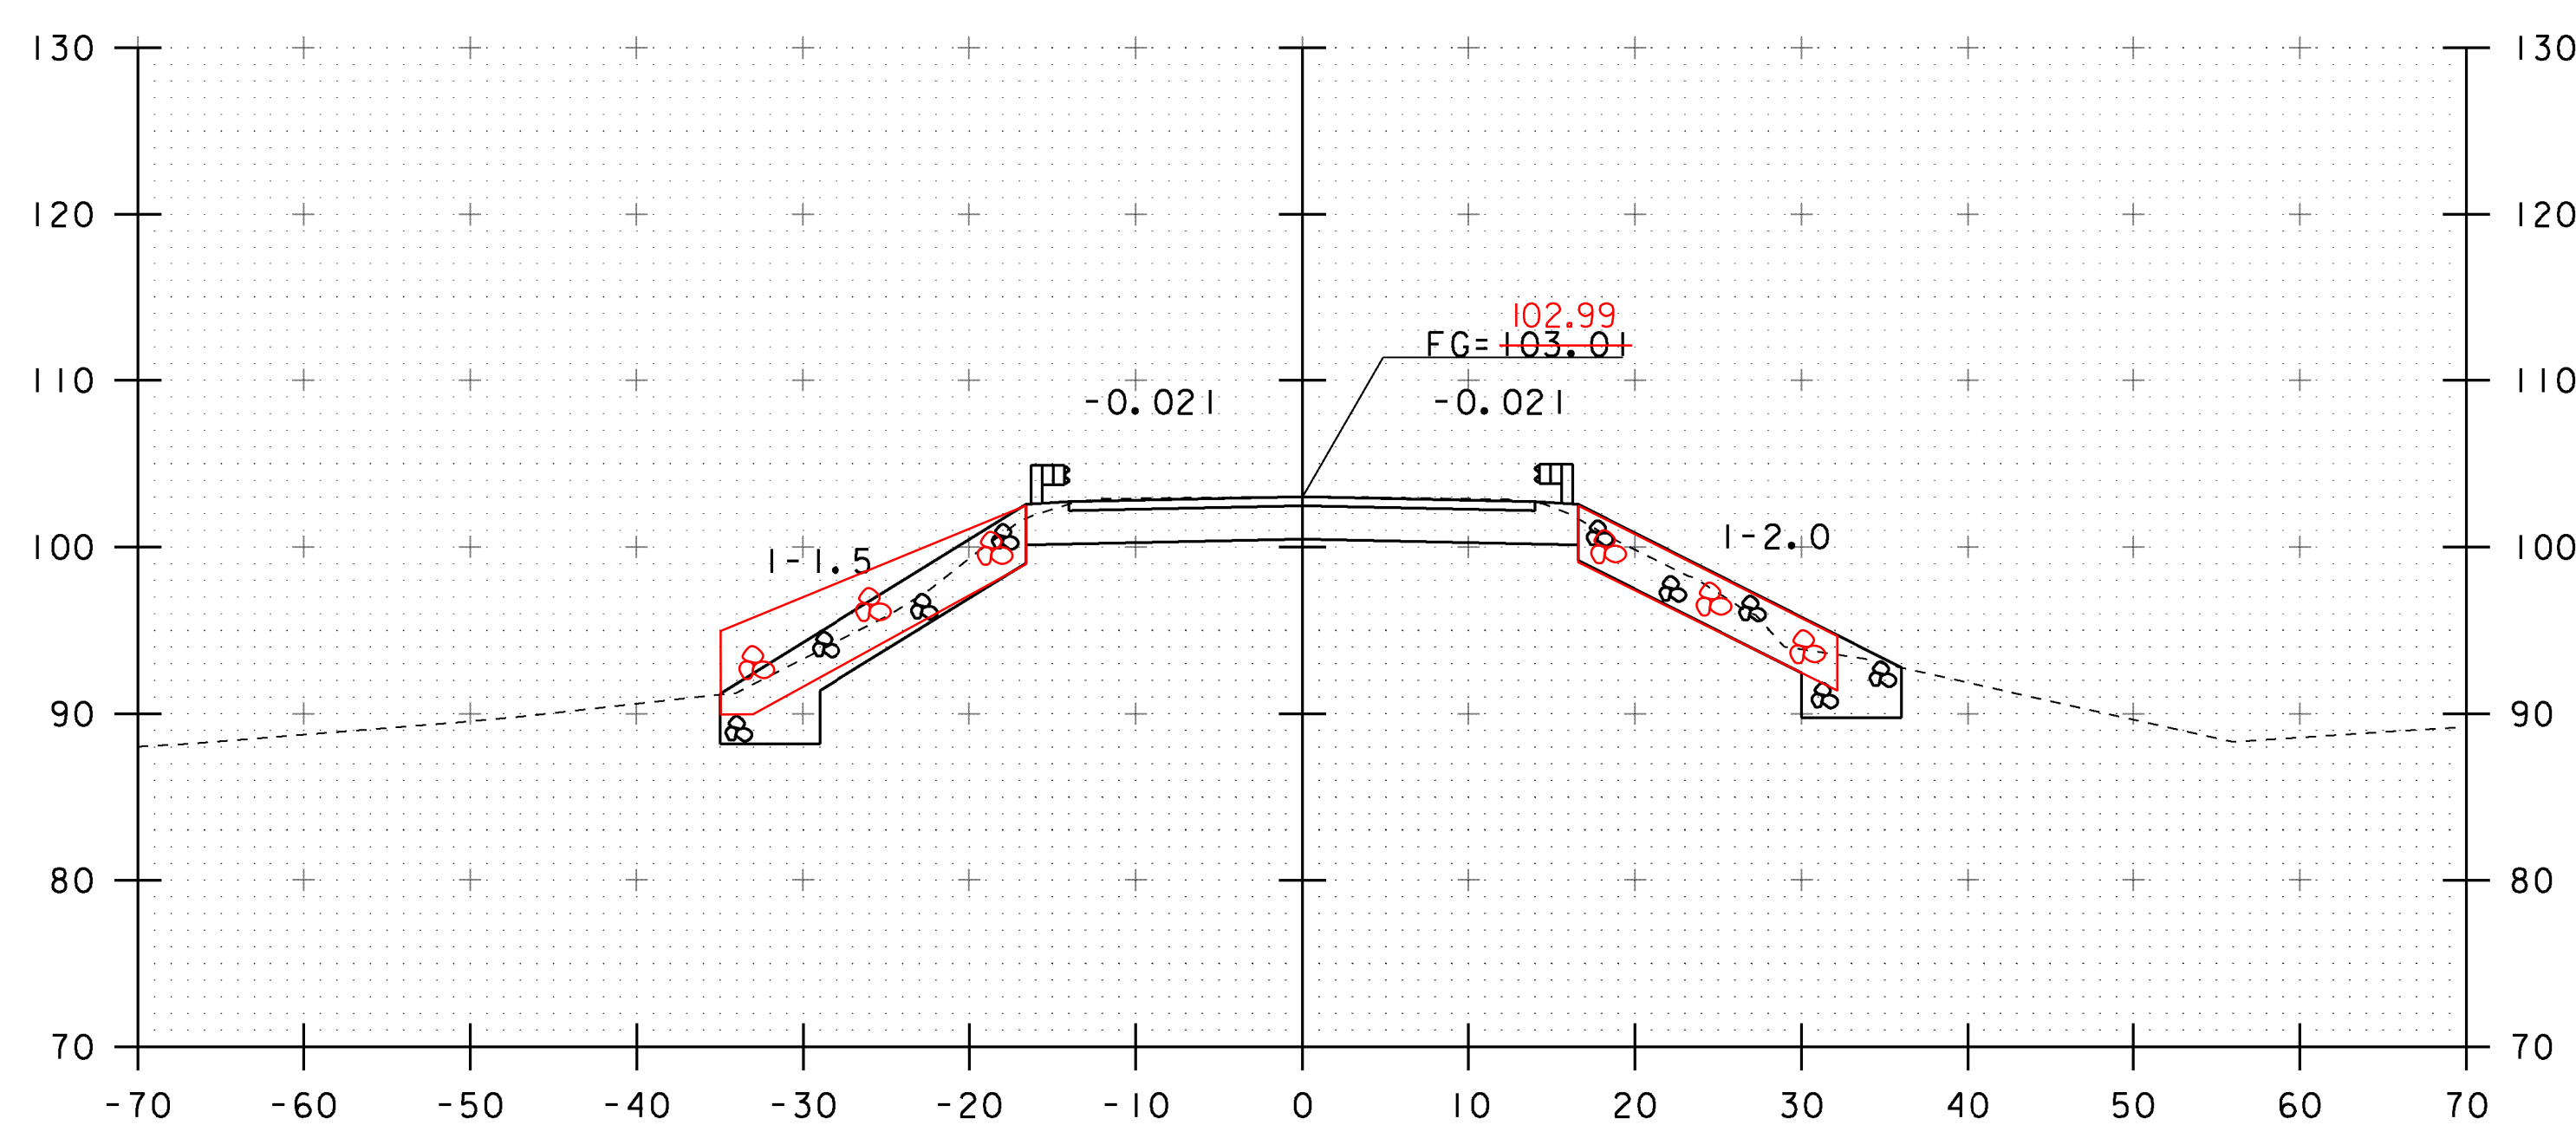

38+75

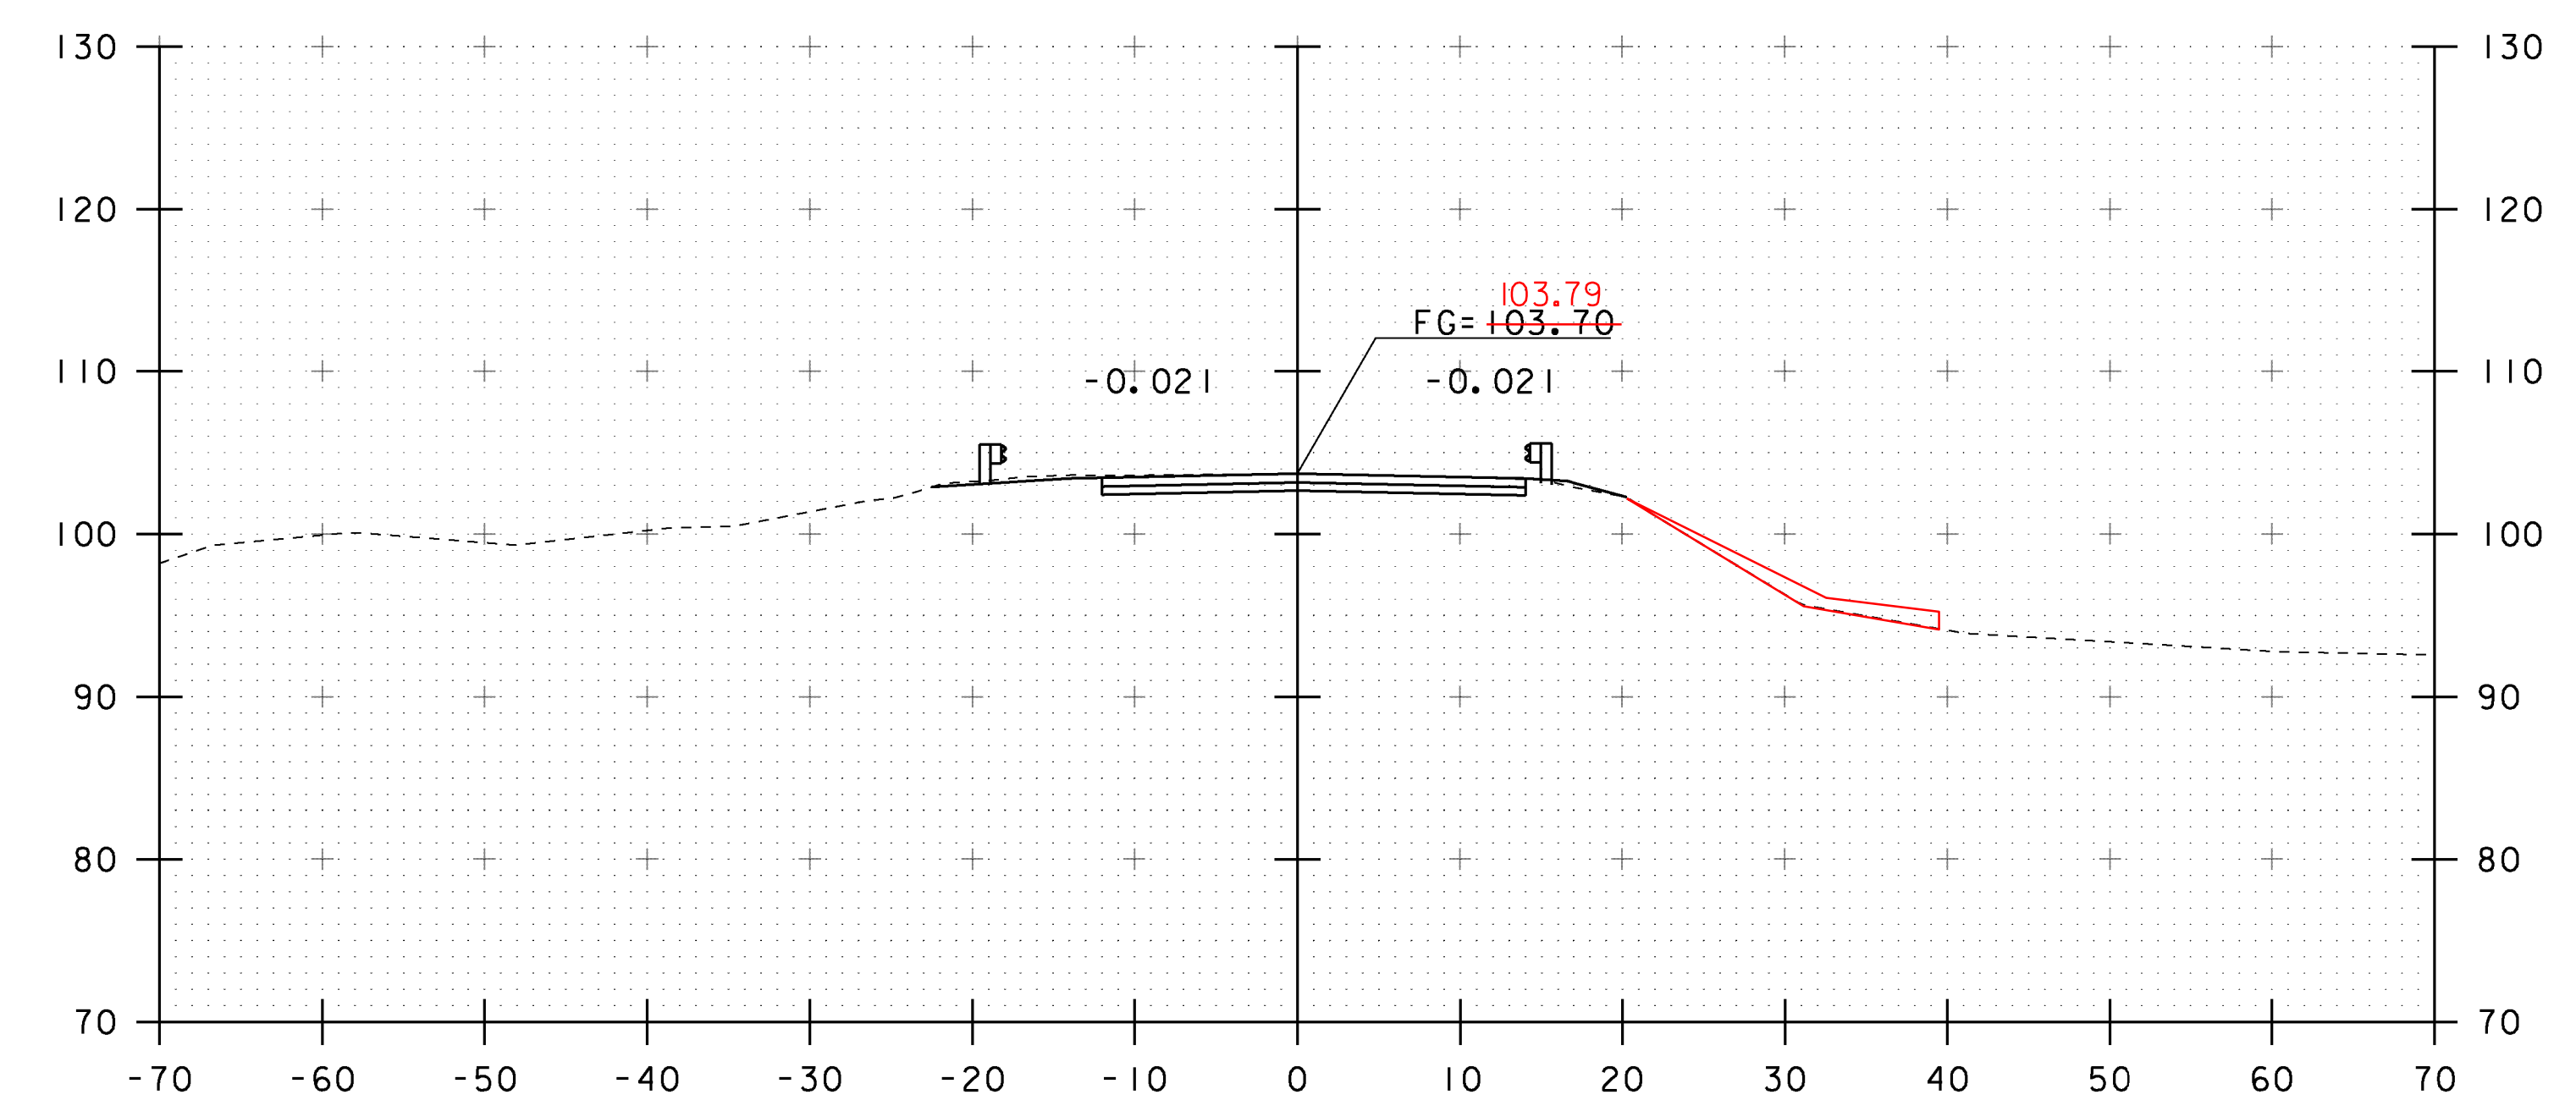

END PROJECT
39+25

STA. 38+75 TO STA. 39+50

PROJECT NAME: ADDISON	PLOT DATE: 09-MAR-2013
PROJECT NUMBER: STP CULV(14)	DRAWN BY: J. SALVATORI
FILE NAME: s08b062xs.dgn	CHECKED BY: W. LAMMER
PROJECT LEADER: K. HIGGINS	SHEET 22 OF 28
DESIGNED BY: J. SALVATORI	
MAINLINE SECTIONS - 3	