


40+00

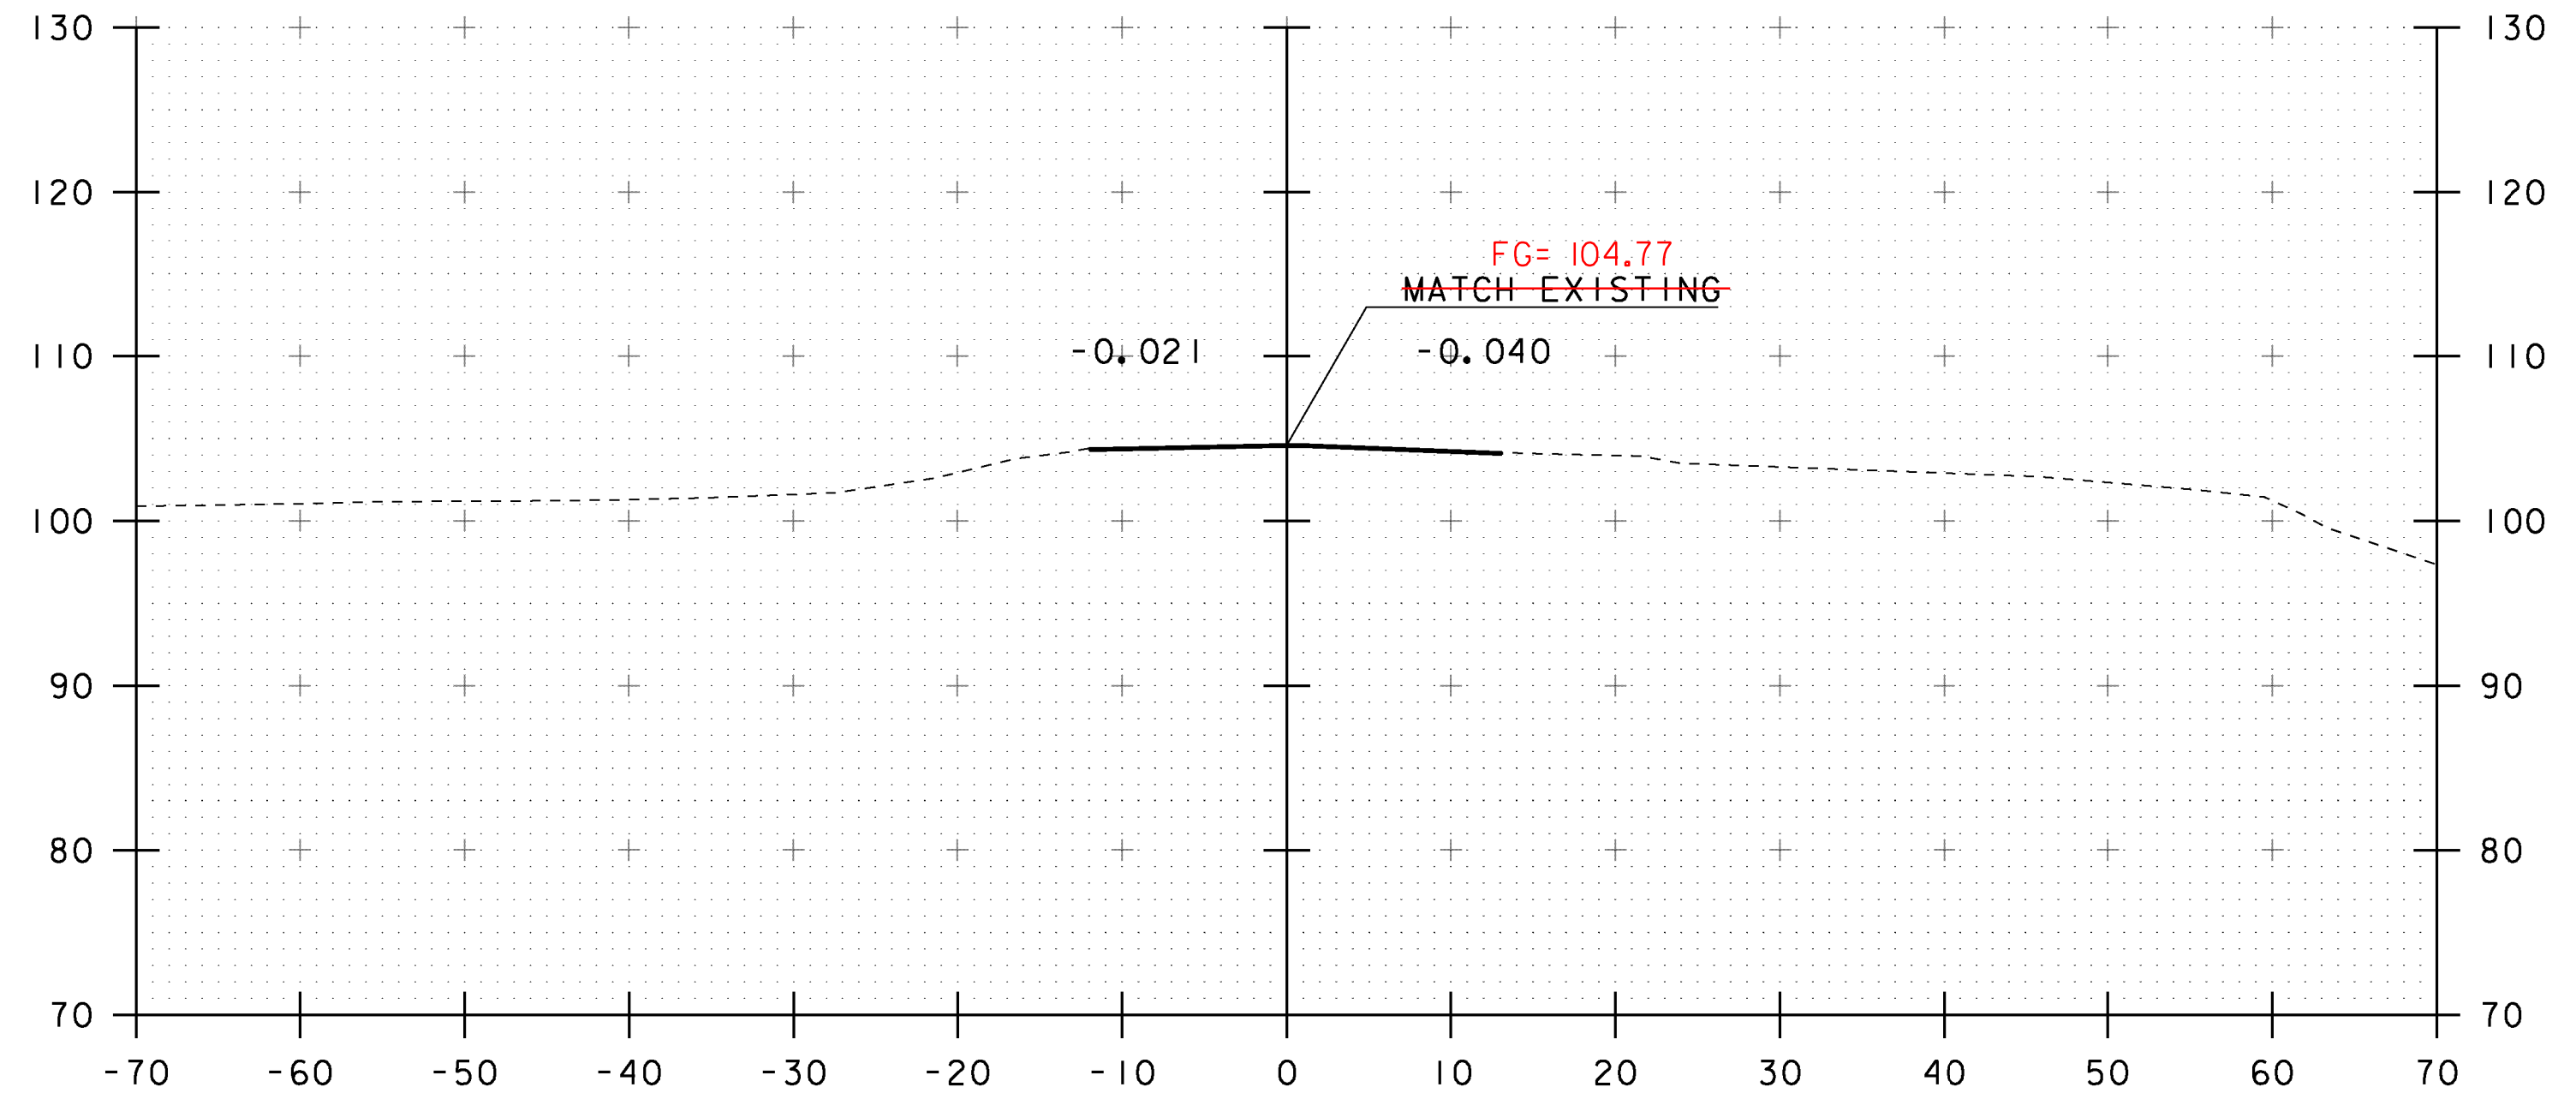

END APPROACH  
39+75

STA. 39+75 TO STA. 40+00

PROJECT NAME: ADDISON	PLOT DATE: 09-MAR-2013
PROJECT NUMBER: STP CULV(14)	DRAWN BY: J. SALVATORI
FILE NAME: s08b062xs.dgn	CHECKED BY: W. LAMMER
PROJECT LEADER: K. HIGGINS	SHEET 23 OF 28
DESIGNED BY: J. SALVATORI	MAINLINE SECTIONS - 4