




STA 10+60.00
 BEGIN UNCLASSIFIED CHANNEL EXCAVATION
 GEOTEXTILE UNDER STONE FILL
 STONE FILL, TYPE III

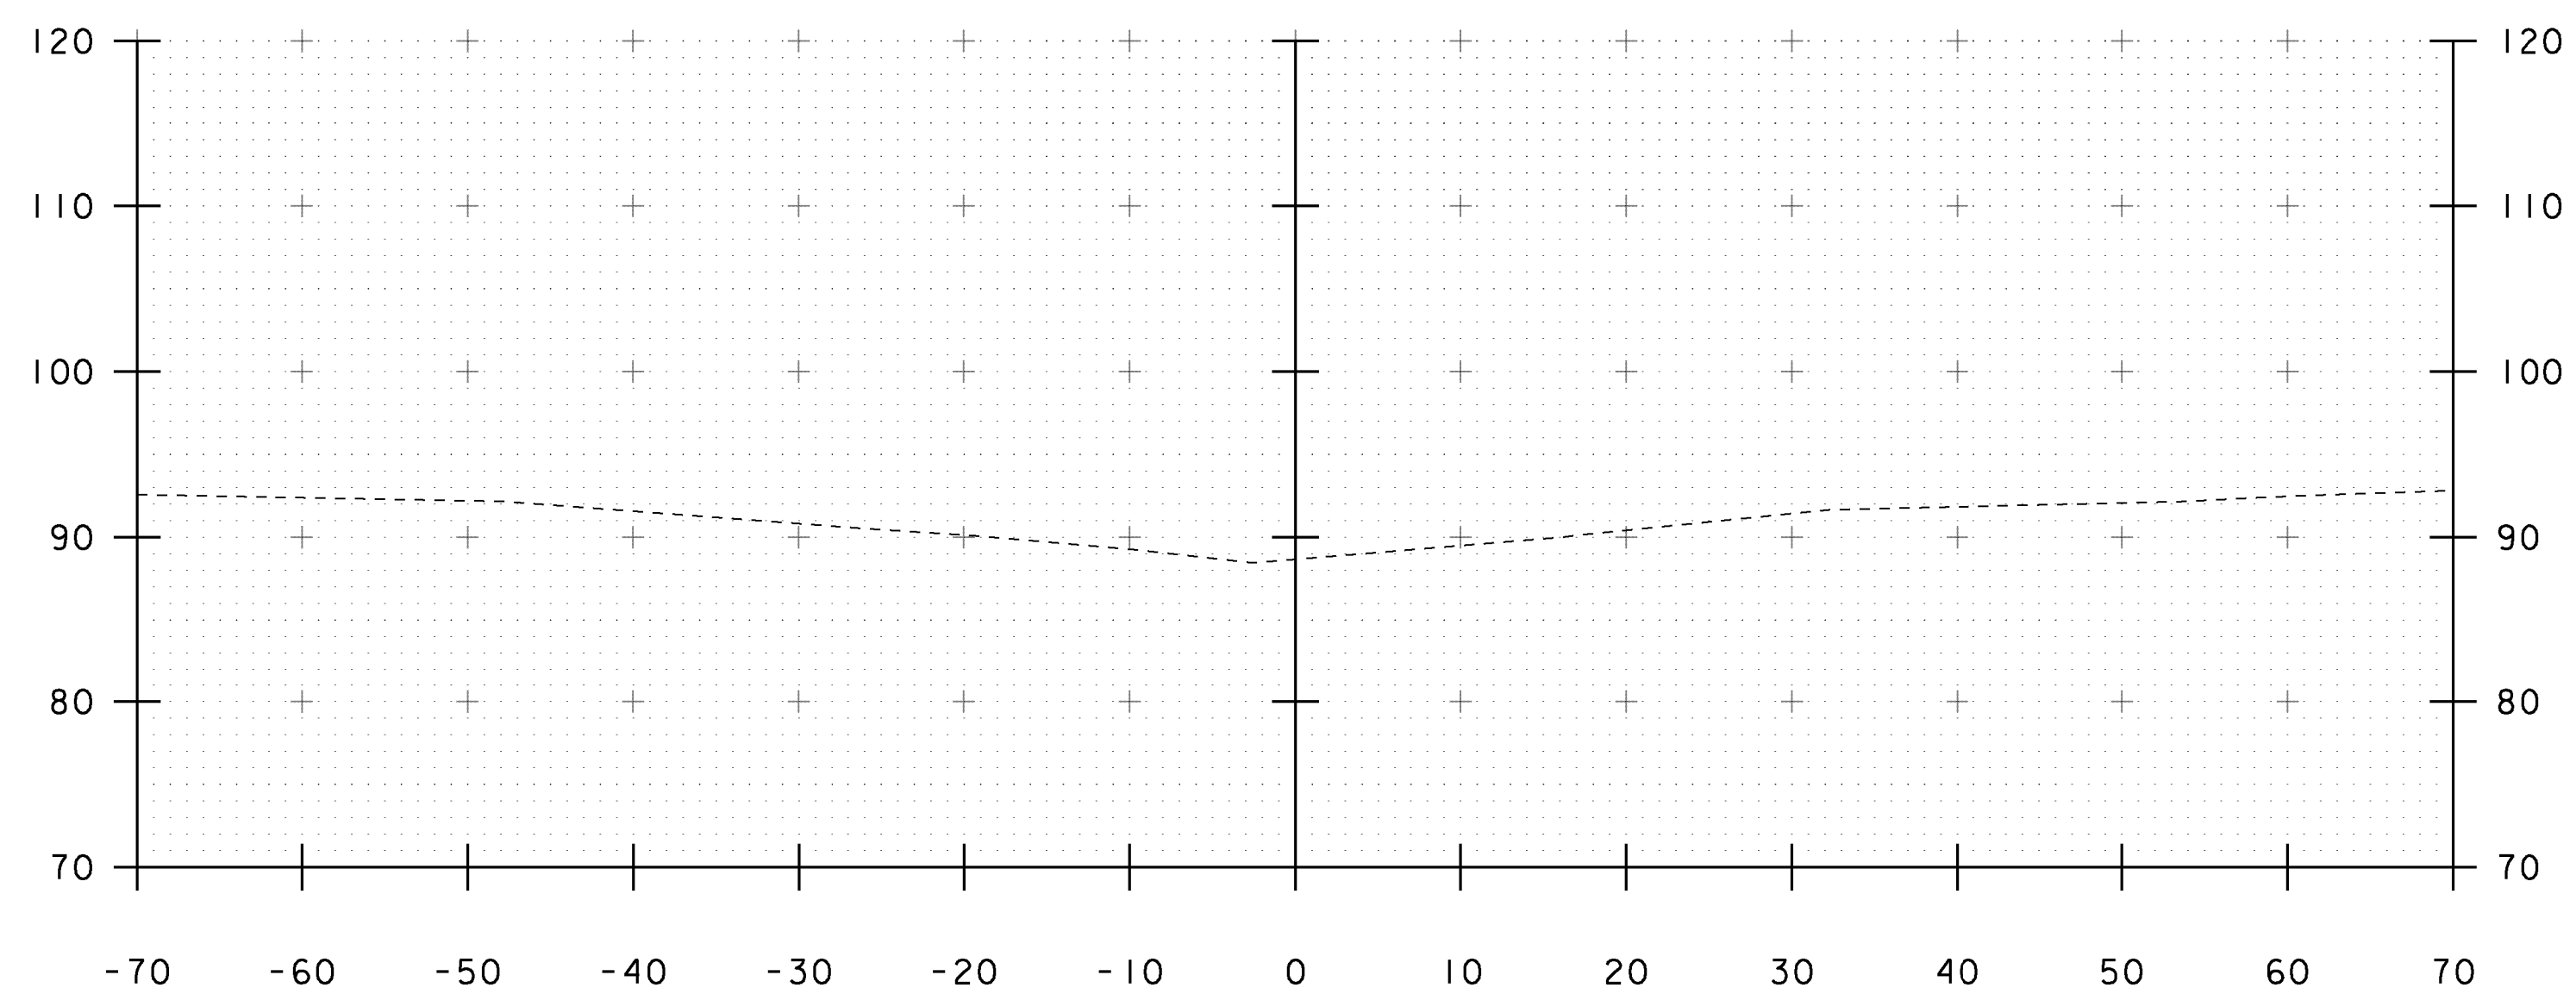


10+25

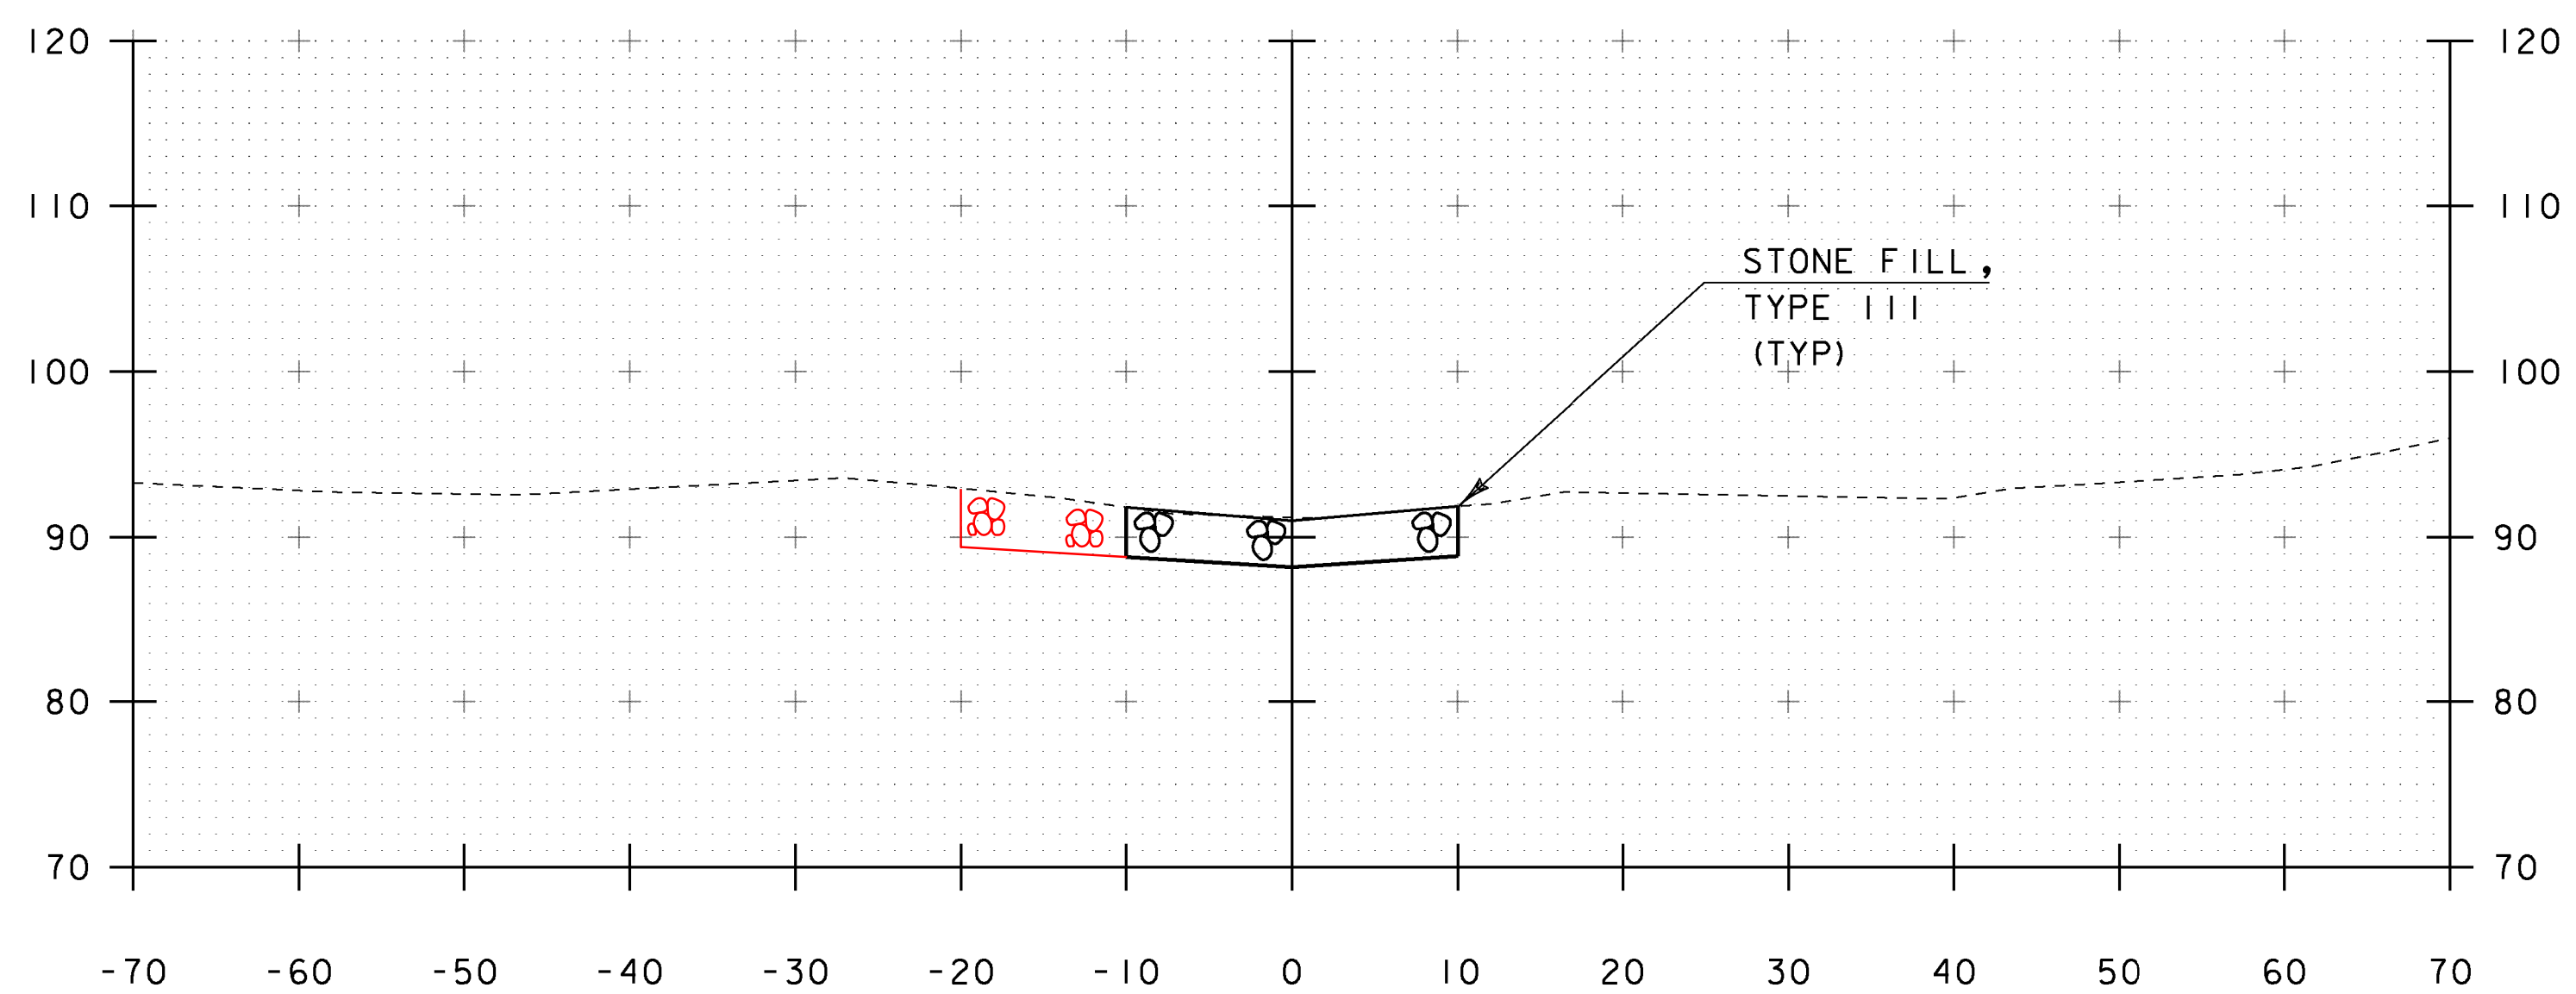

10+60

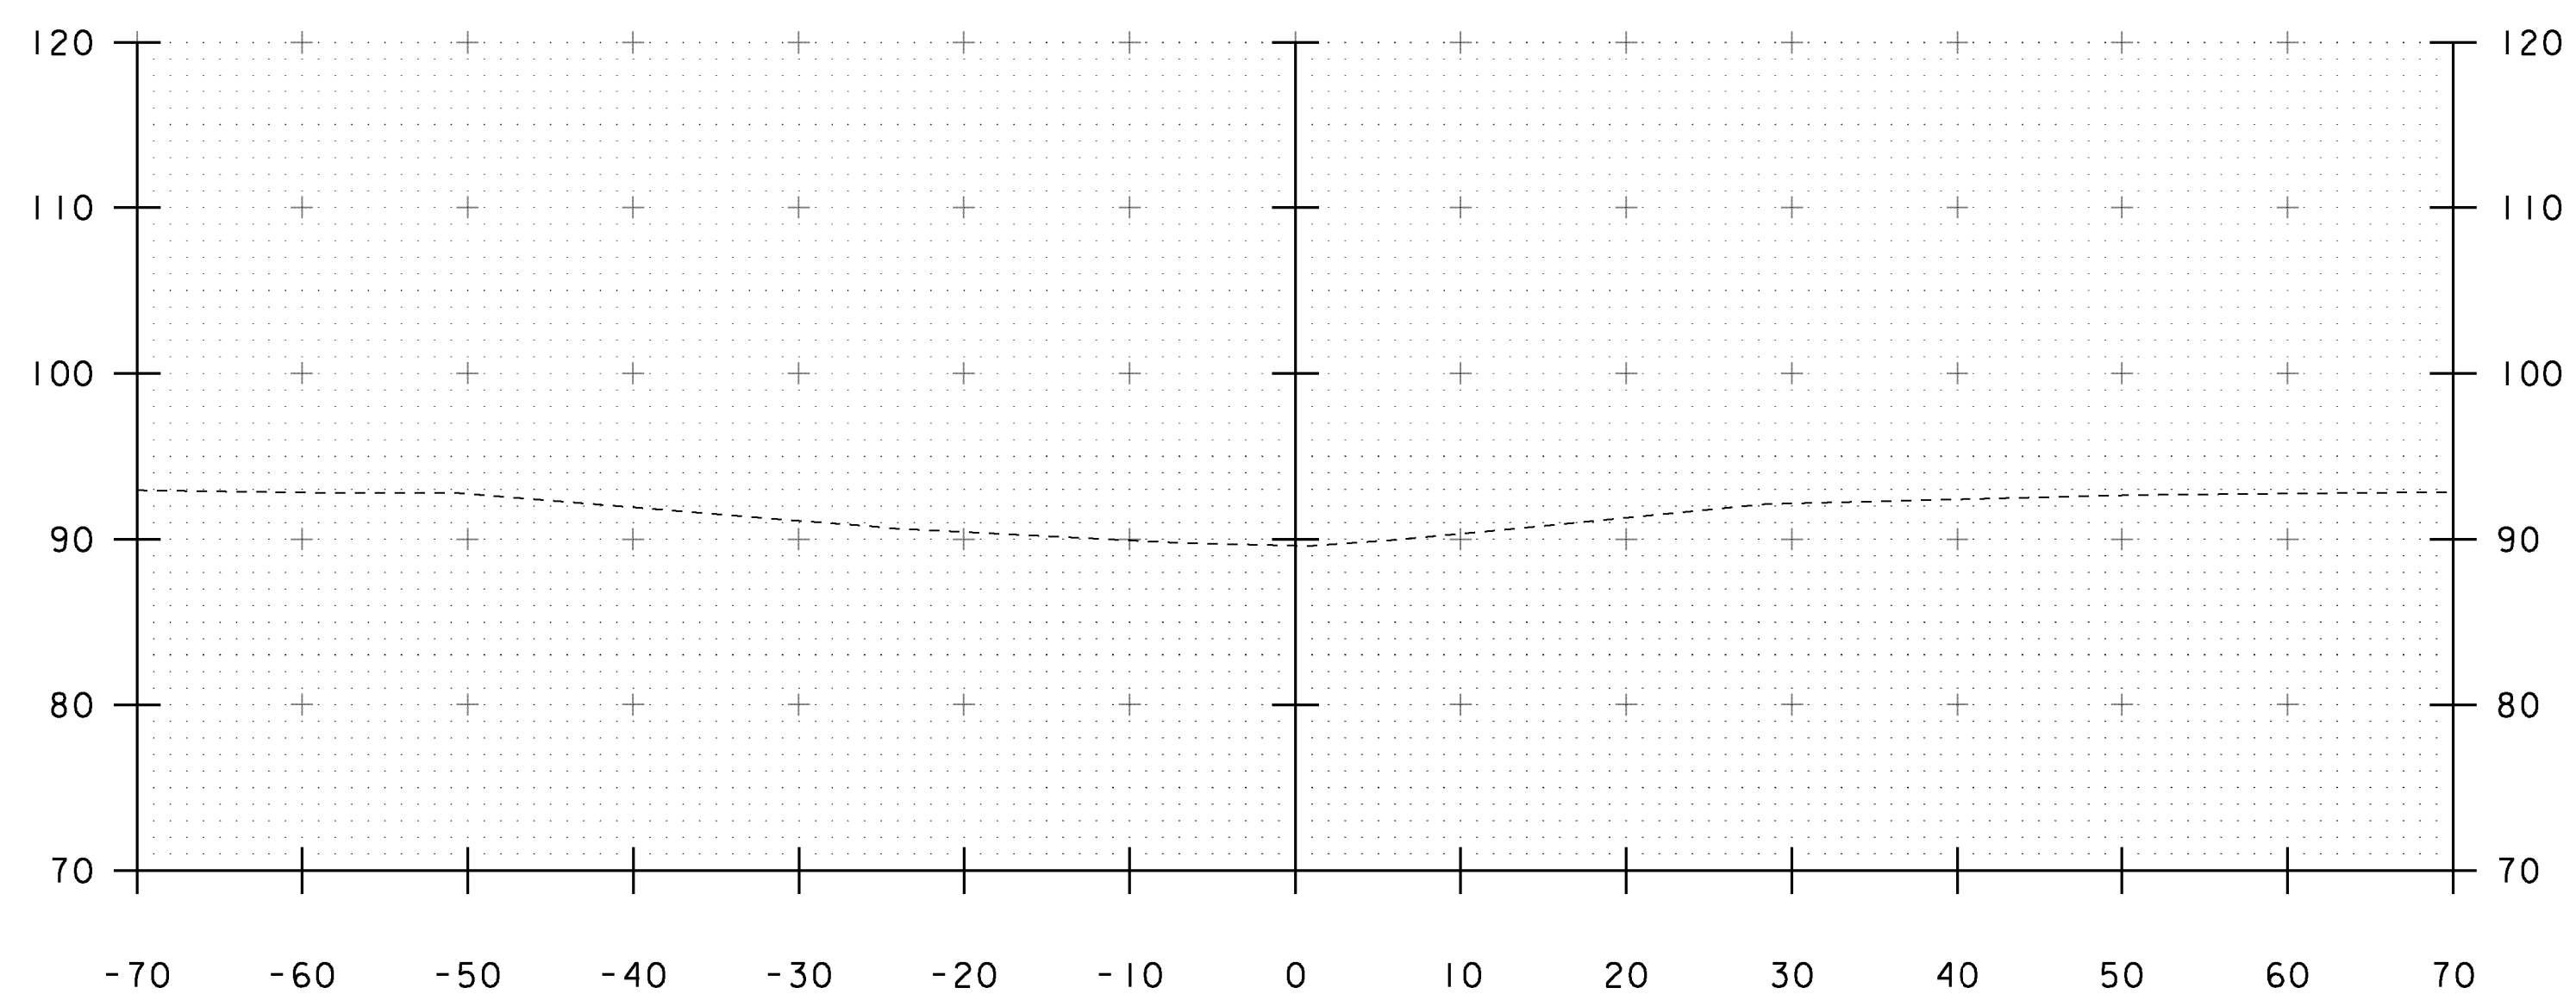

10+00

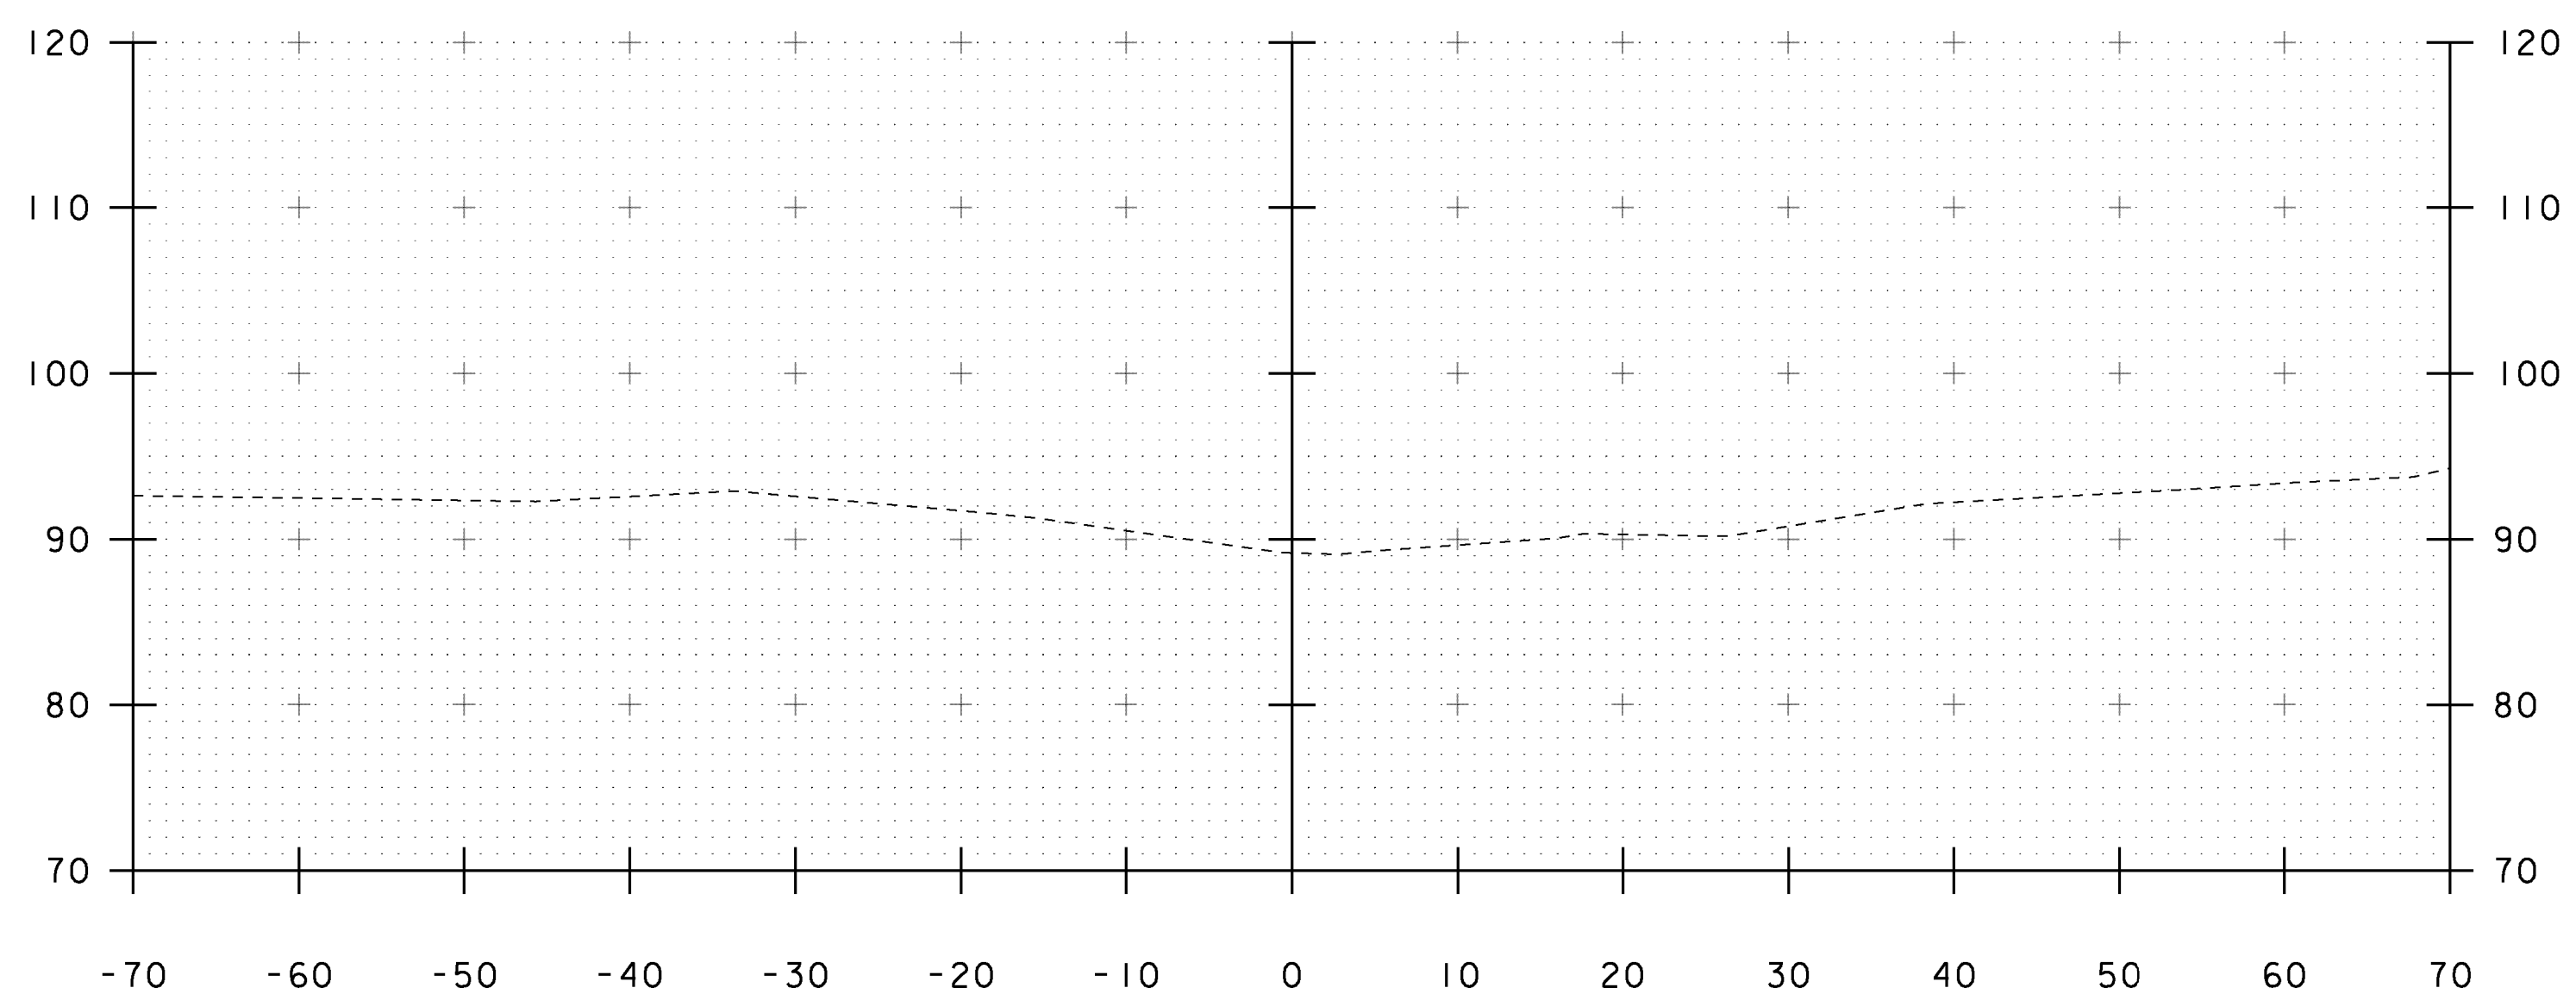

10+50

PROJECT NAME: ADDISON	PLOT DATE: 09-MAR-2013
PROJECT NUMBER: STP CULV(14)	DRAWN BY: J. GRIGAS
FILE NAME: s08b062xs.dgn	DESIGNED BY: J. SALVATORI
PROJECT LEADER: K. HIGGINS	CHECKED BY: J. SALVATORI
CHANNEL SECTIONS - 1	SHEET 24 OF 28

STA. 10+00 TO STA. 10+60