




STA 10+83.40  
 END UNCLASSIFIED CHANNEL EXCAVATION  
 GEOTEXTILE UNDER STONE FILL  
 STONE FILL, TYPE III

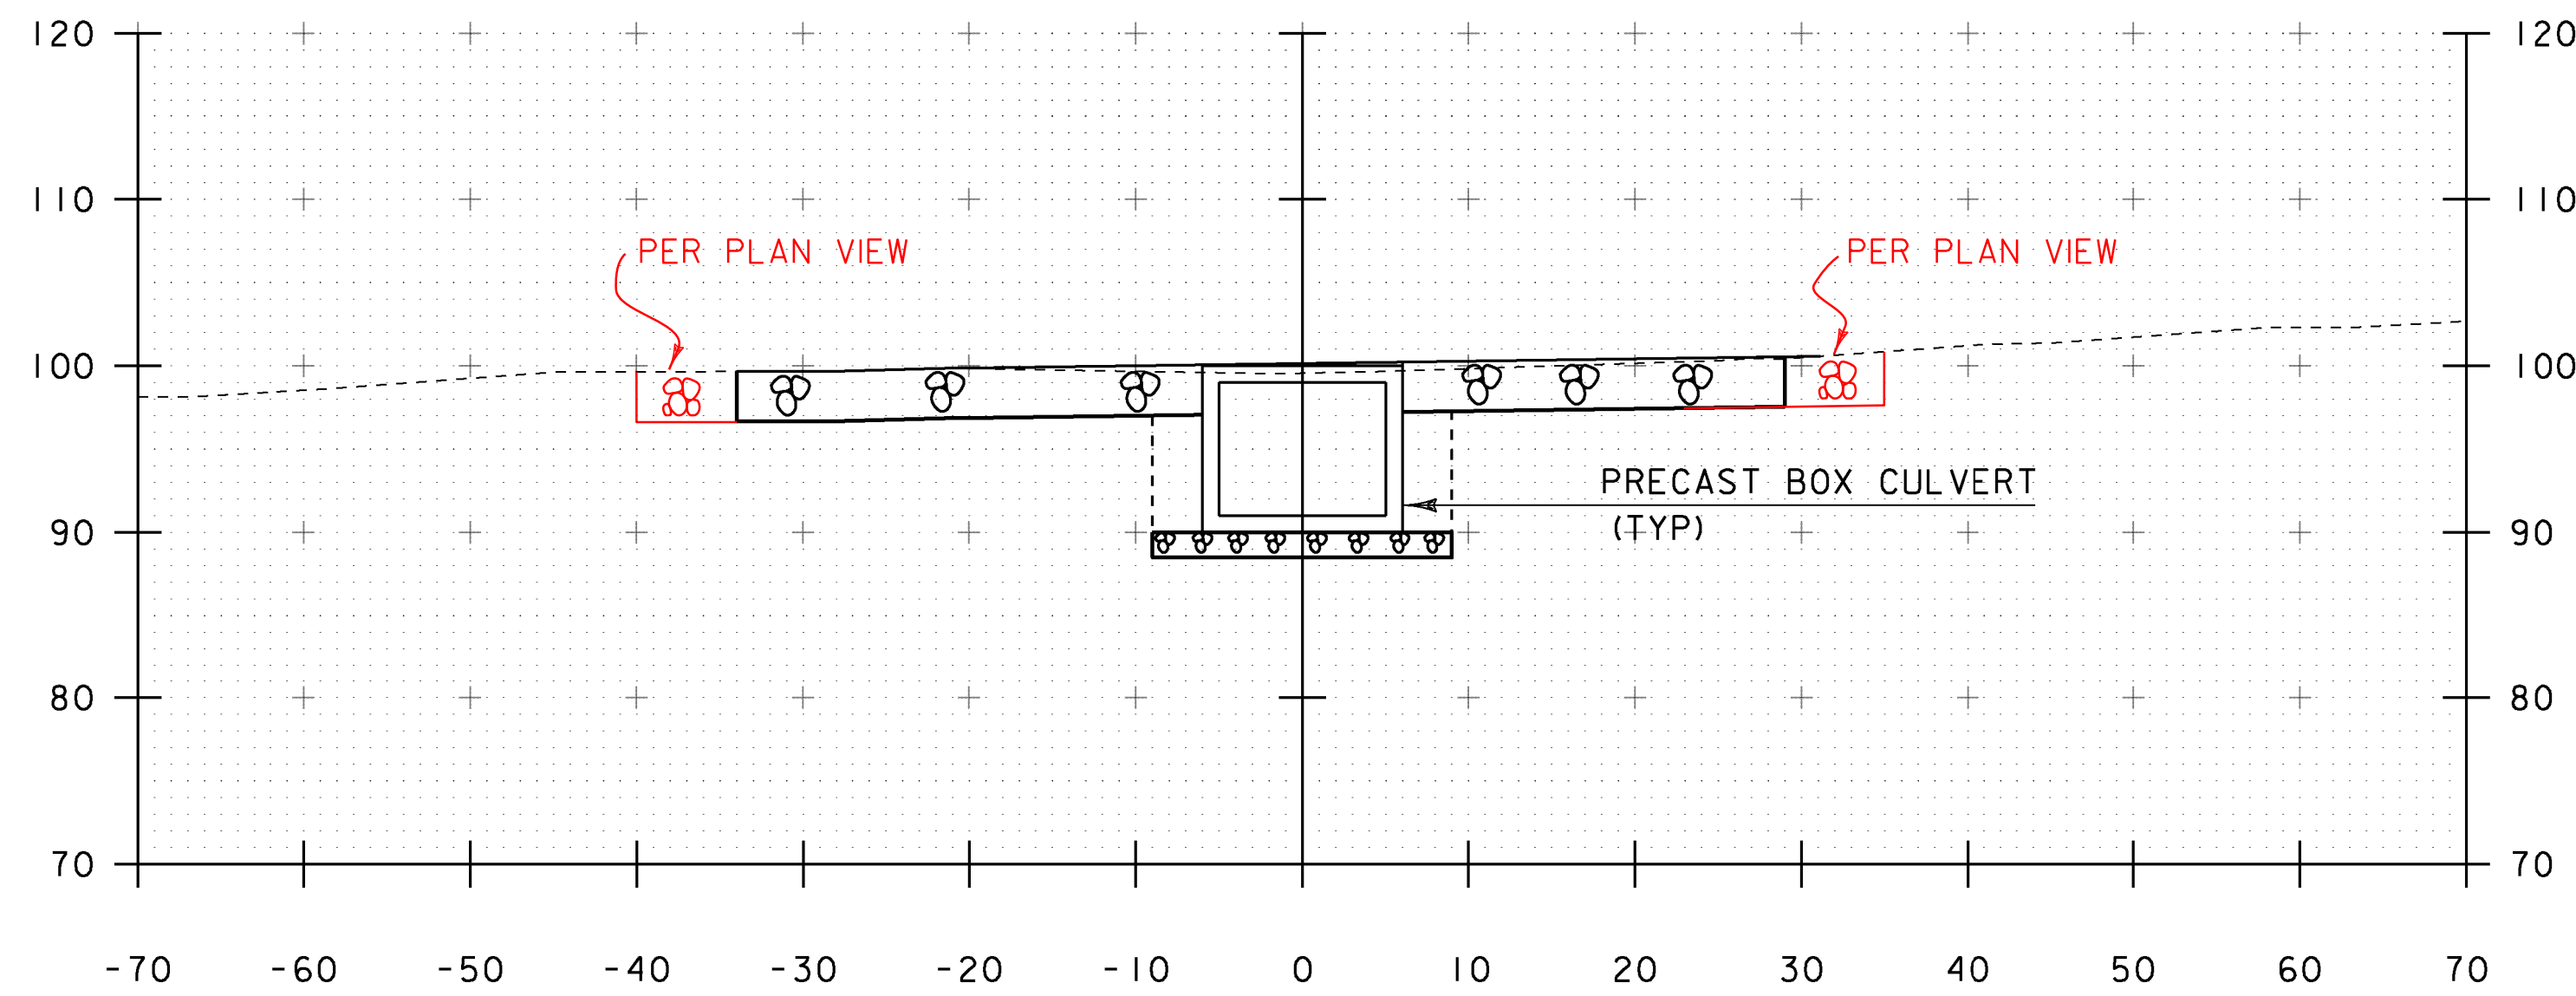


10+80

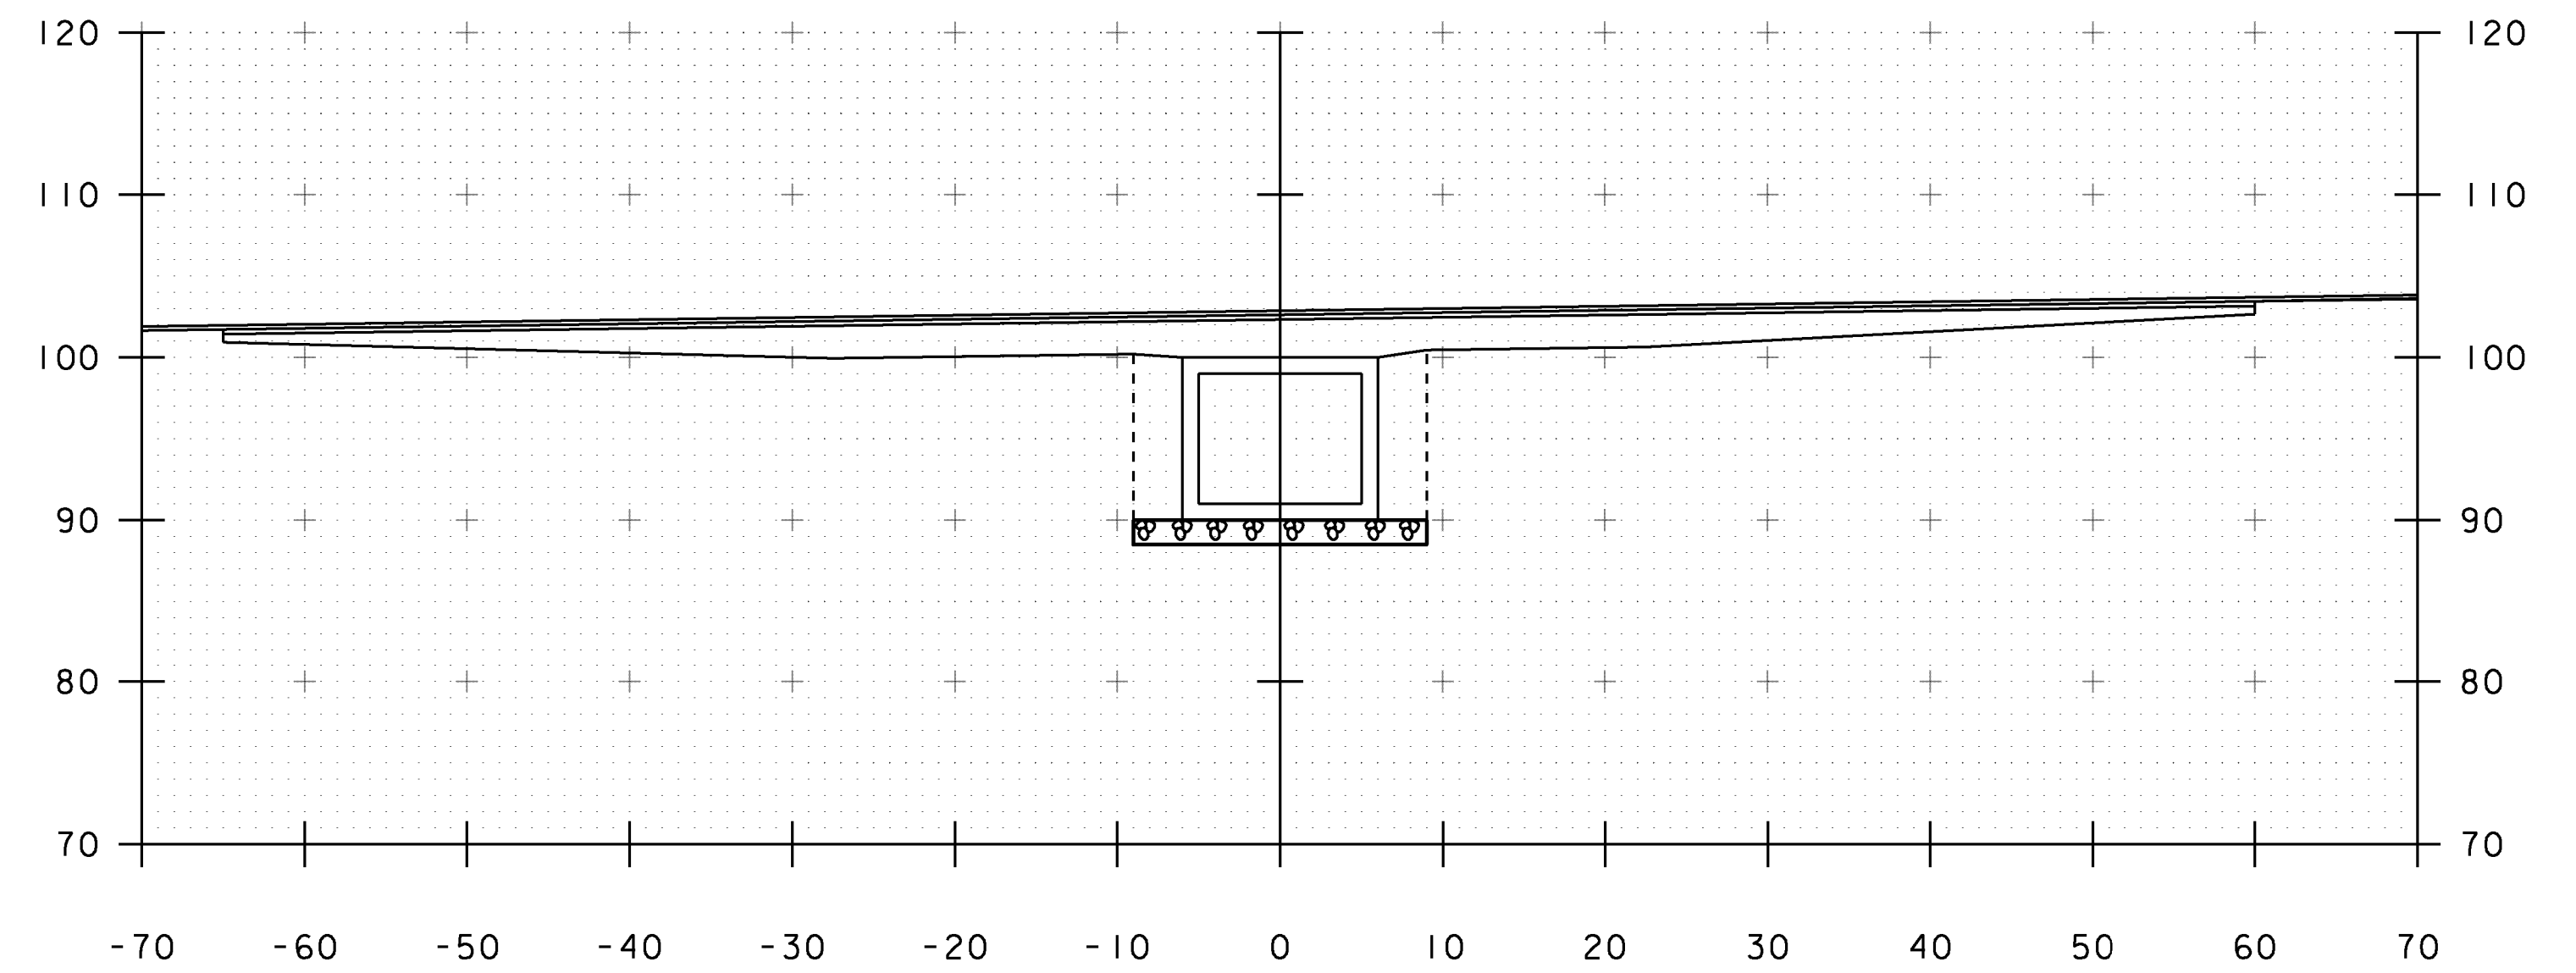

11+00

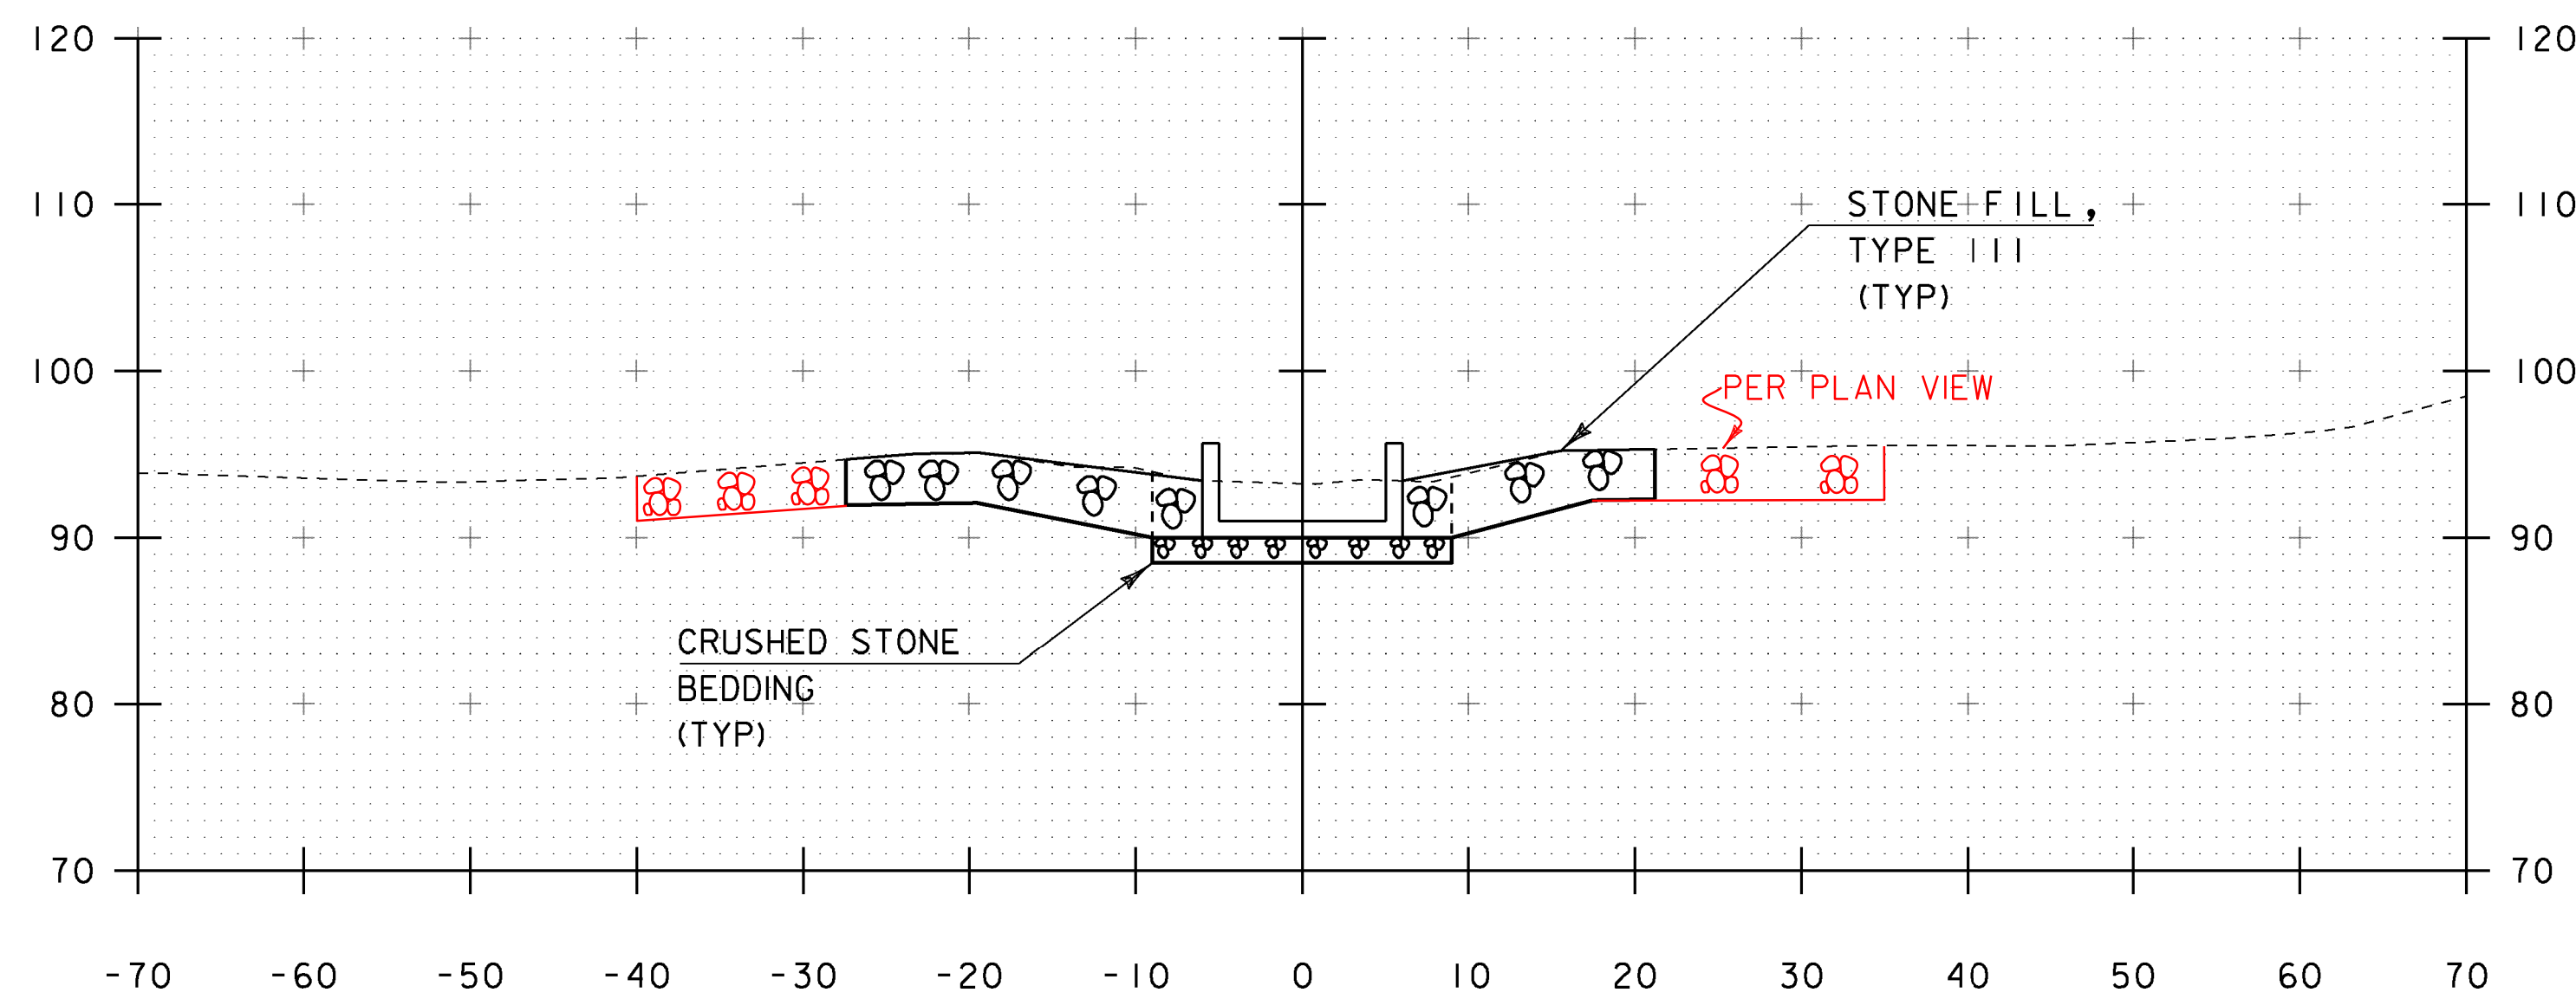

10+70

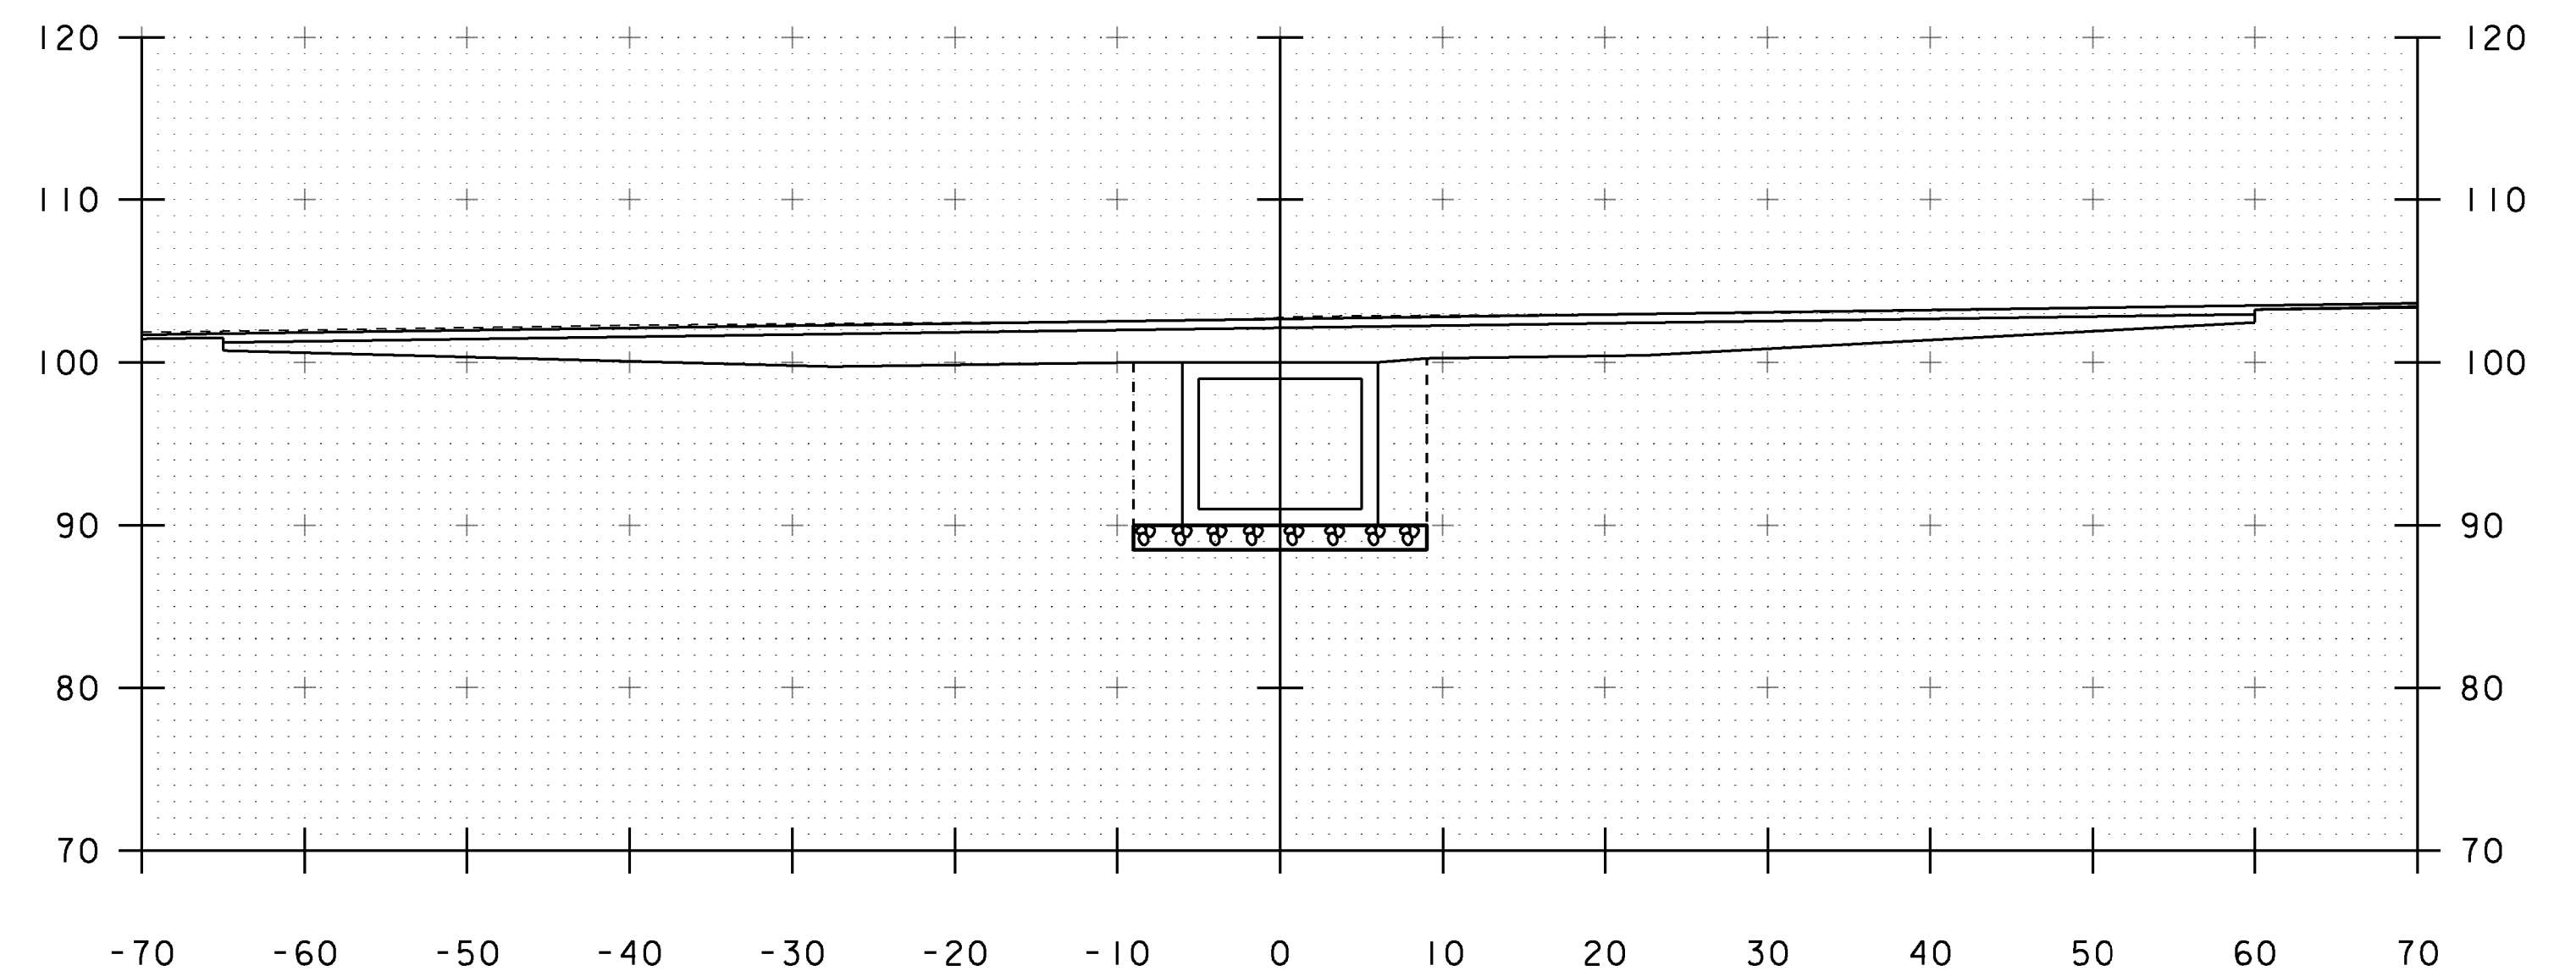

10+90

STA. 10+70 TO STA. 11+00

|                              |                           |
|------------------------------|---------------------------|
| PROJECT NAME: ADDISON        | PLOT DATE: 09-MAR-2013    |
| PROJECT NUMBER: STP CULV(14) | DRAWN BY: J. GRIGAS       |
| FILE NAME: s08b062xs.dgn     | DESIGNED BY: J. SALVATORI |
| PROJECT LEADER: K. HIGGINS   | CHECKED BY: J. SALVATORI  |
| CHANNEL SECTIONS - 2         | SHEET 25 OF 28            |