



STA 11+16.70
 BEGIN UNCLASSIFIED CHANNEL EXCAVATION
 GEOTEXTILE UNDER STONE FILL
 STONE FILL, TYPE III


STA 11+40.00
 END UNCLASSIFIED CHANNEL EXCAVATION
 GEOTEXTILE UNDER STONE FILL
 STONE FILL, TYPE III

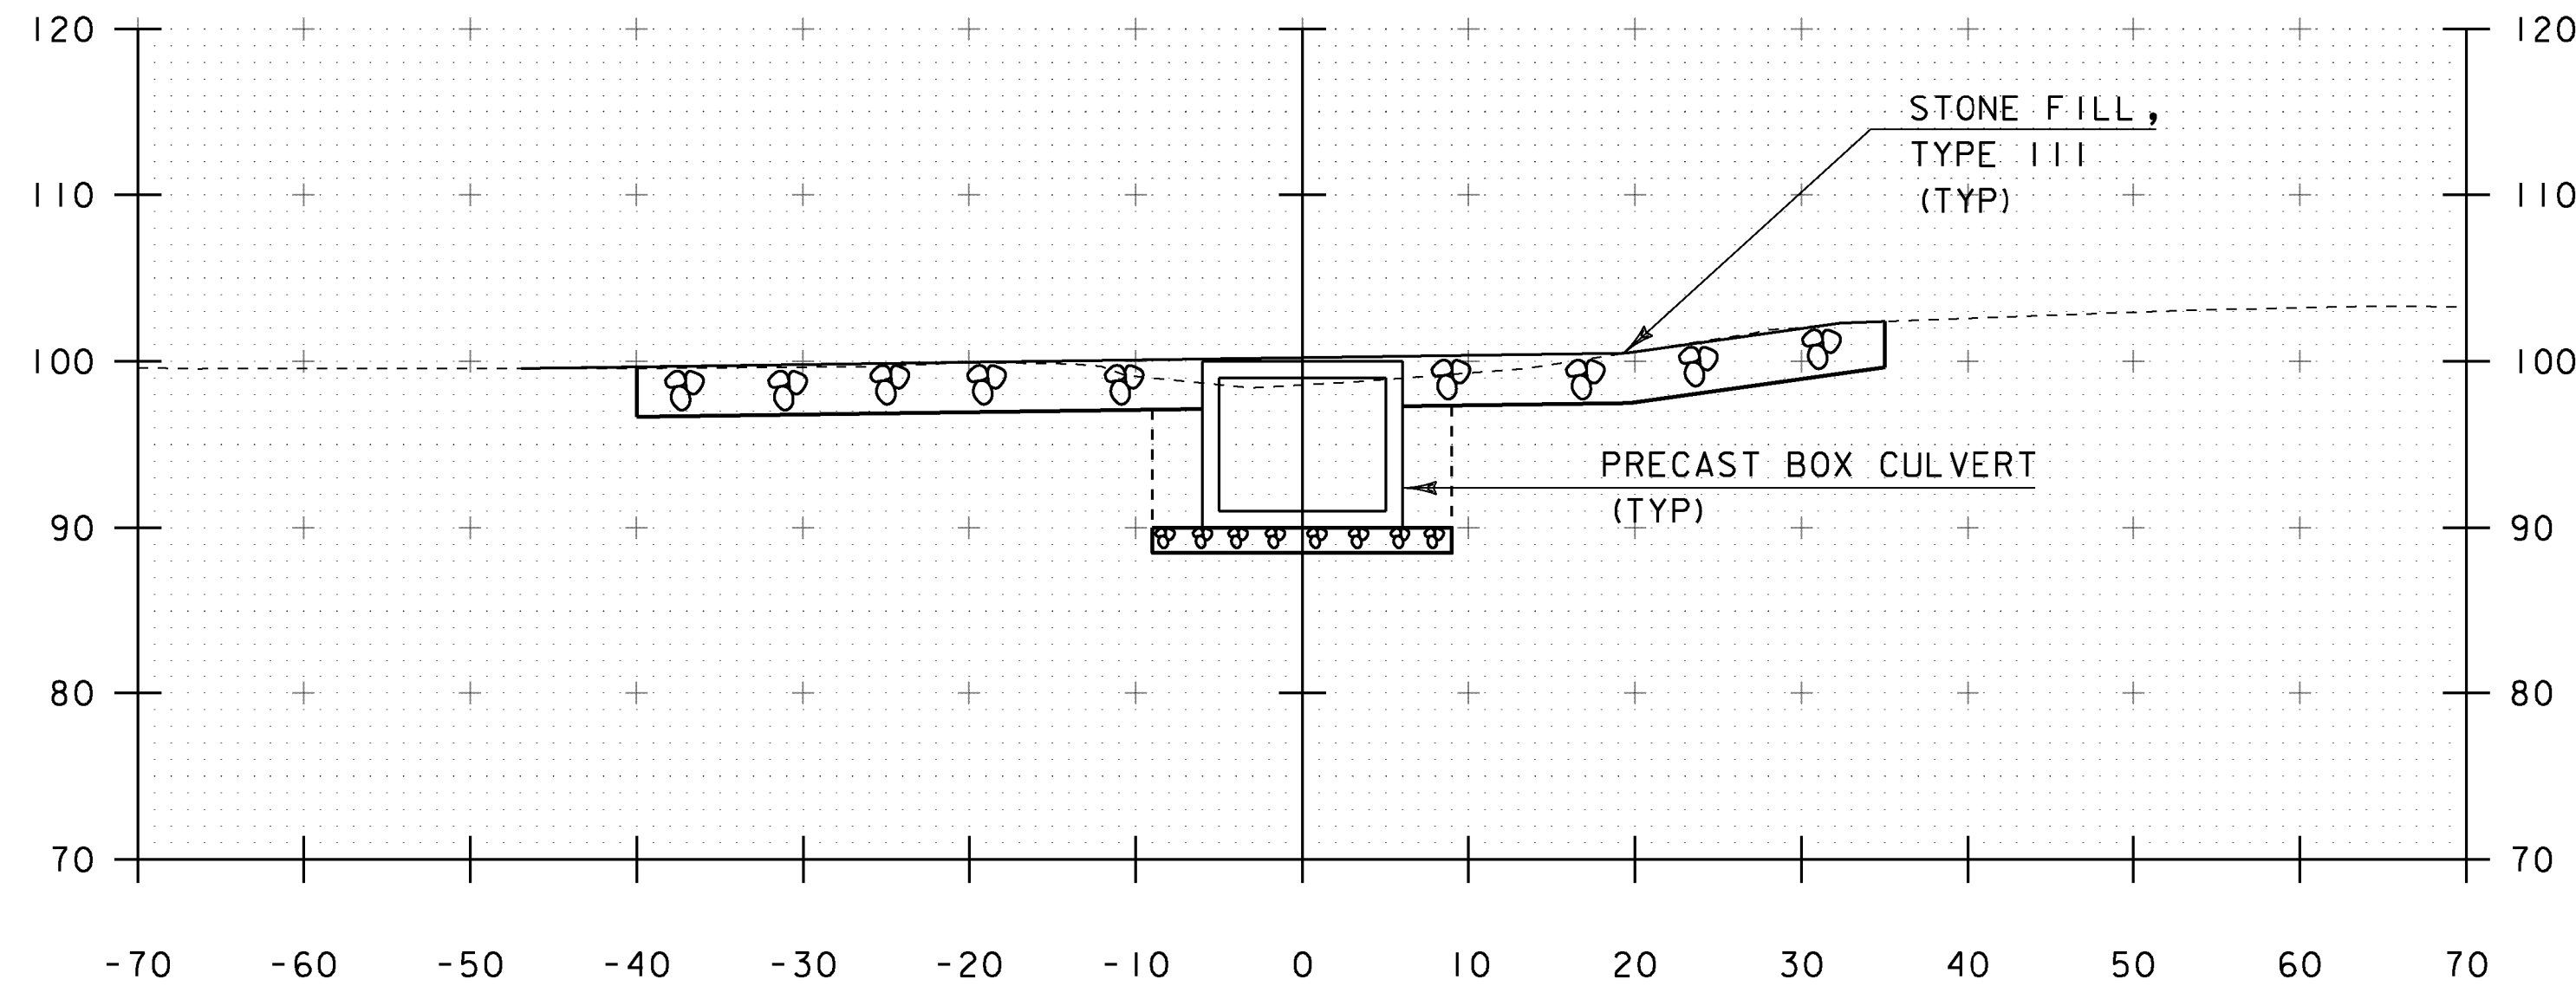


11+20

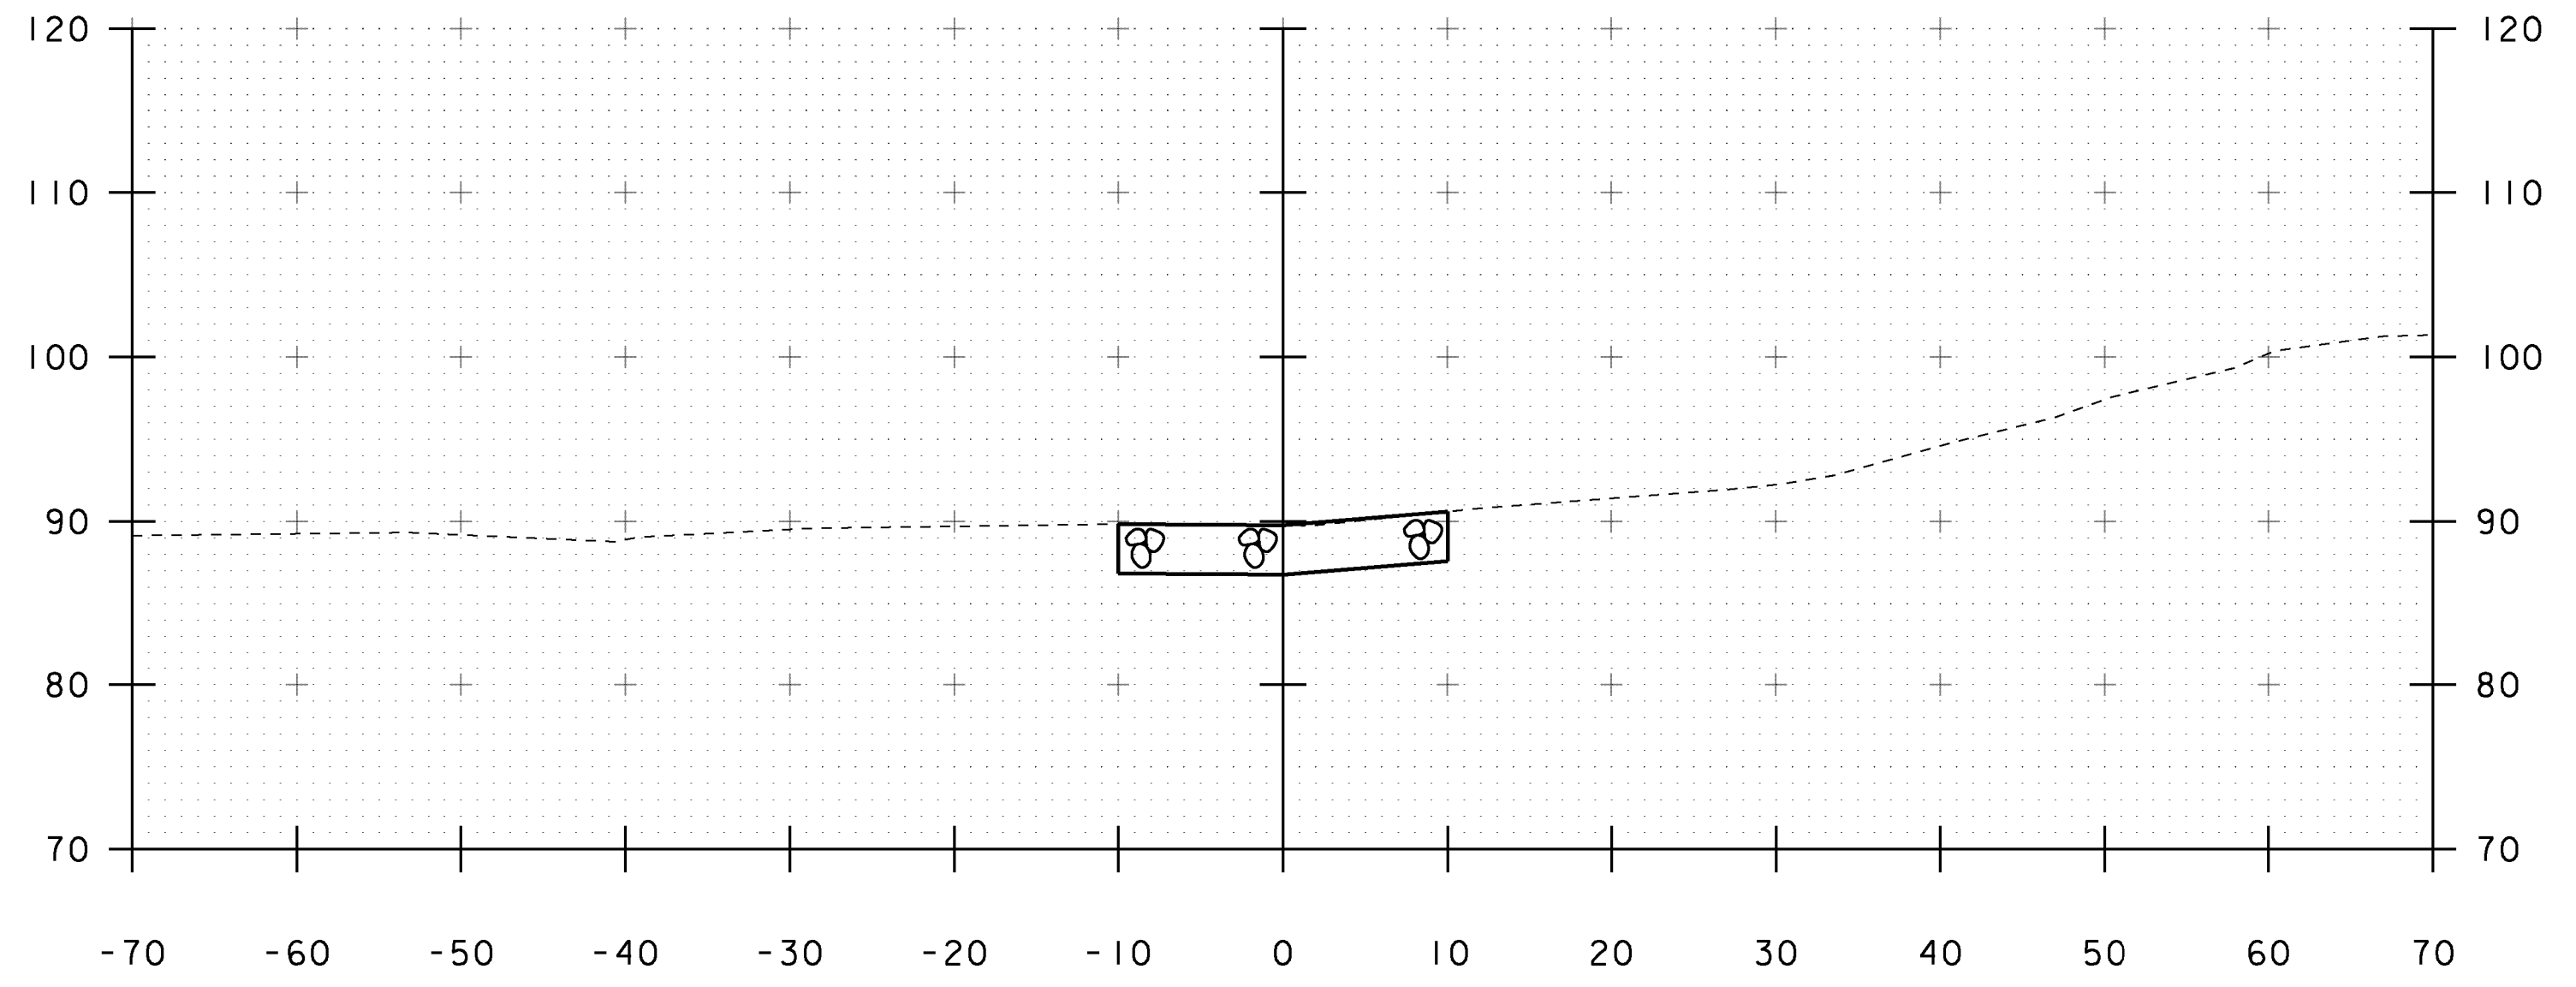

11+40

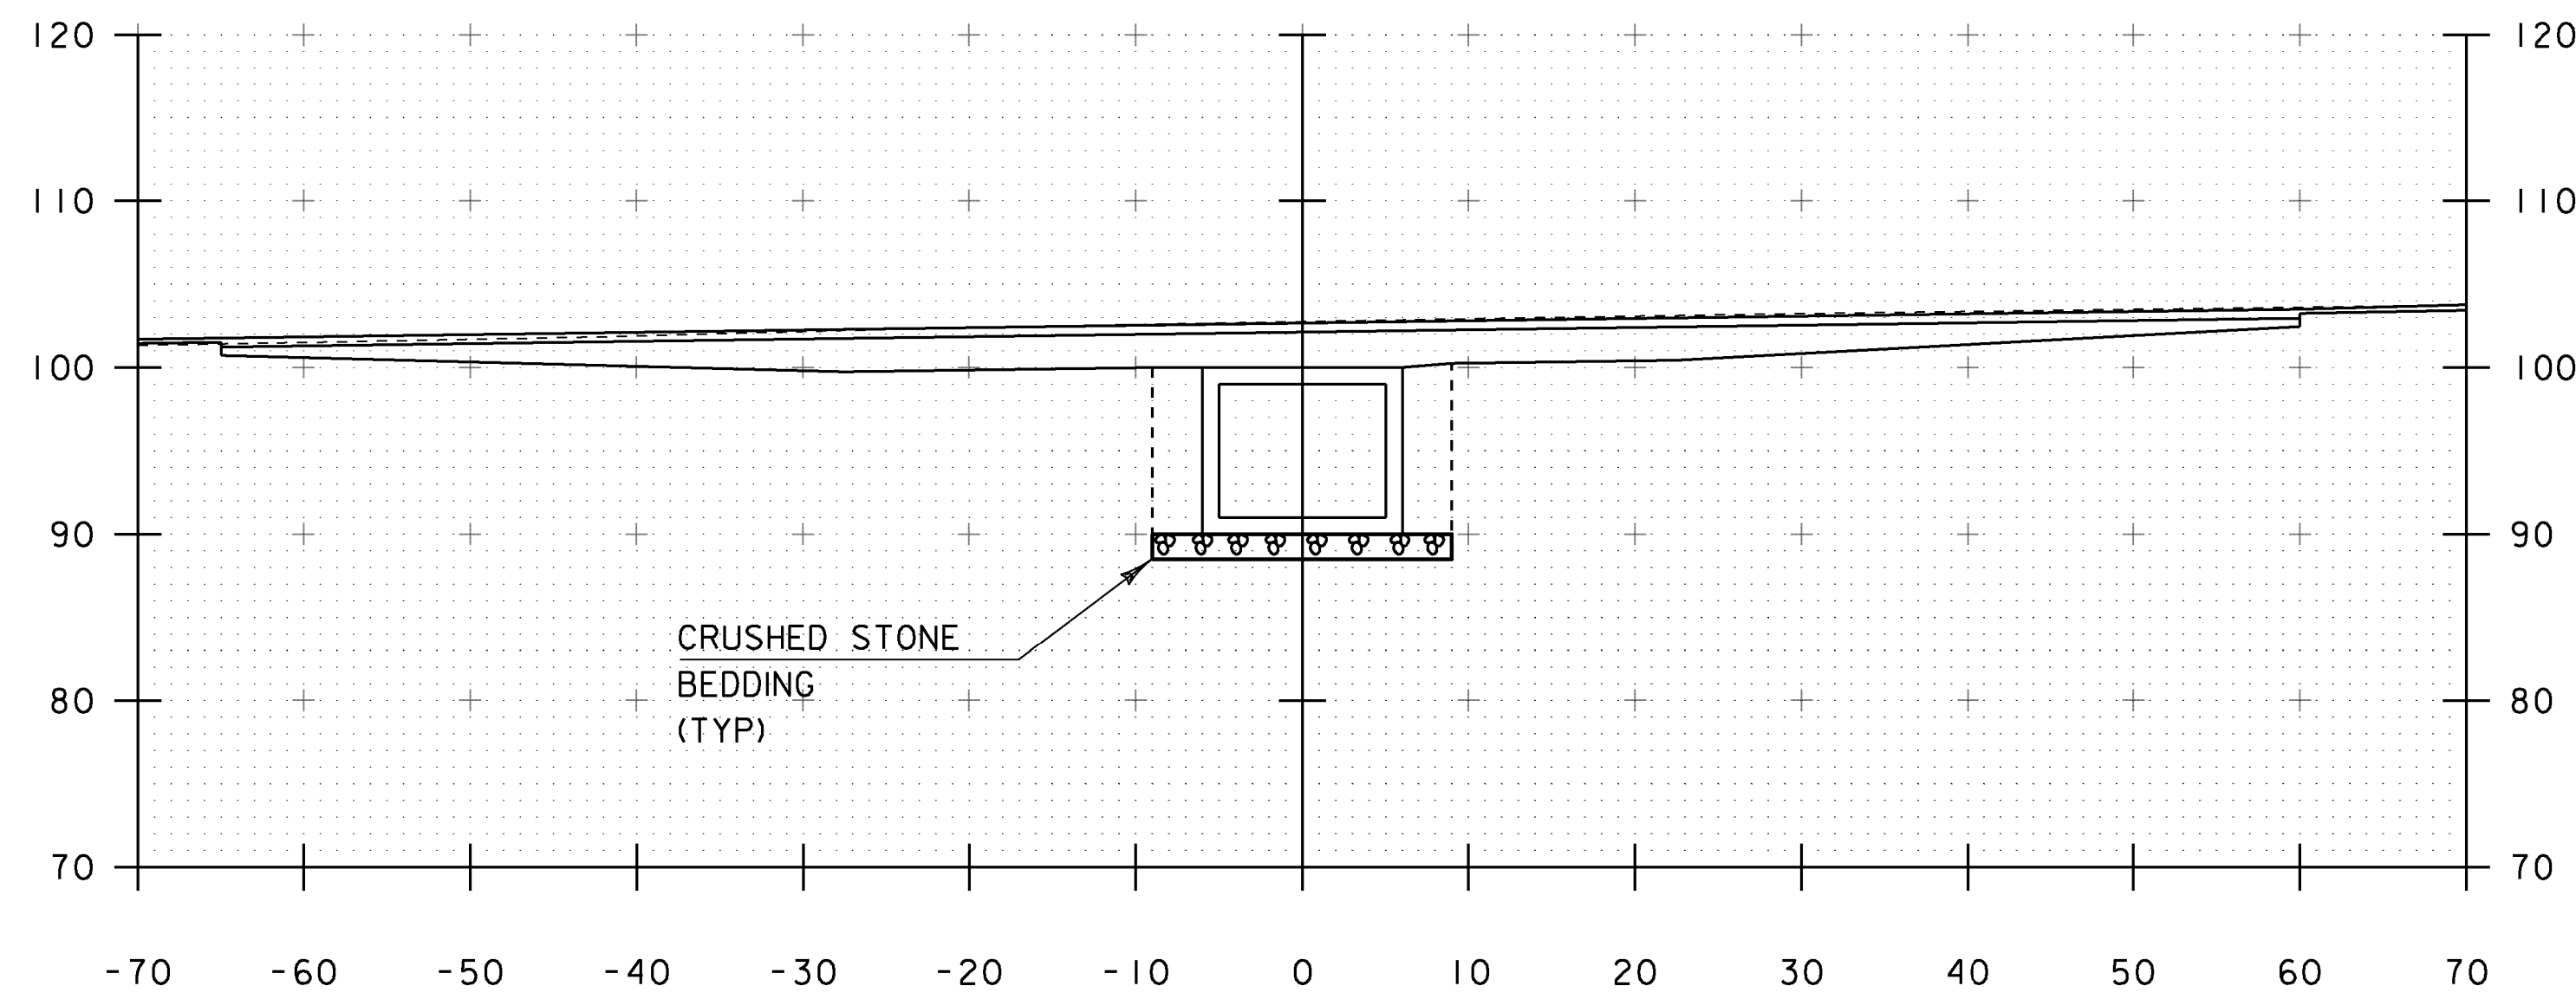

11+10

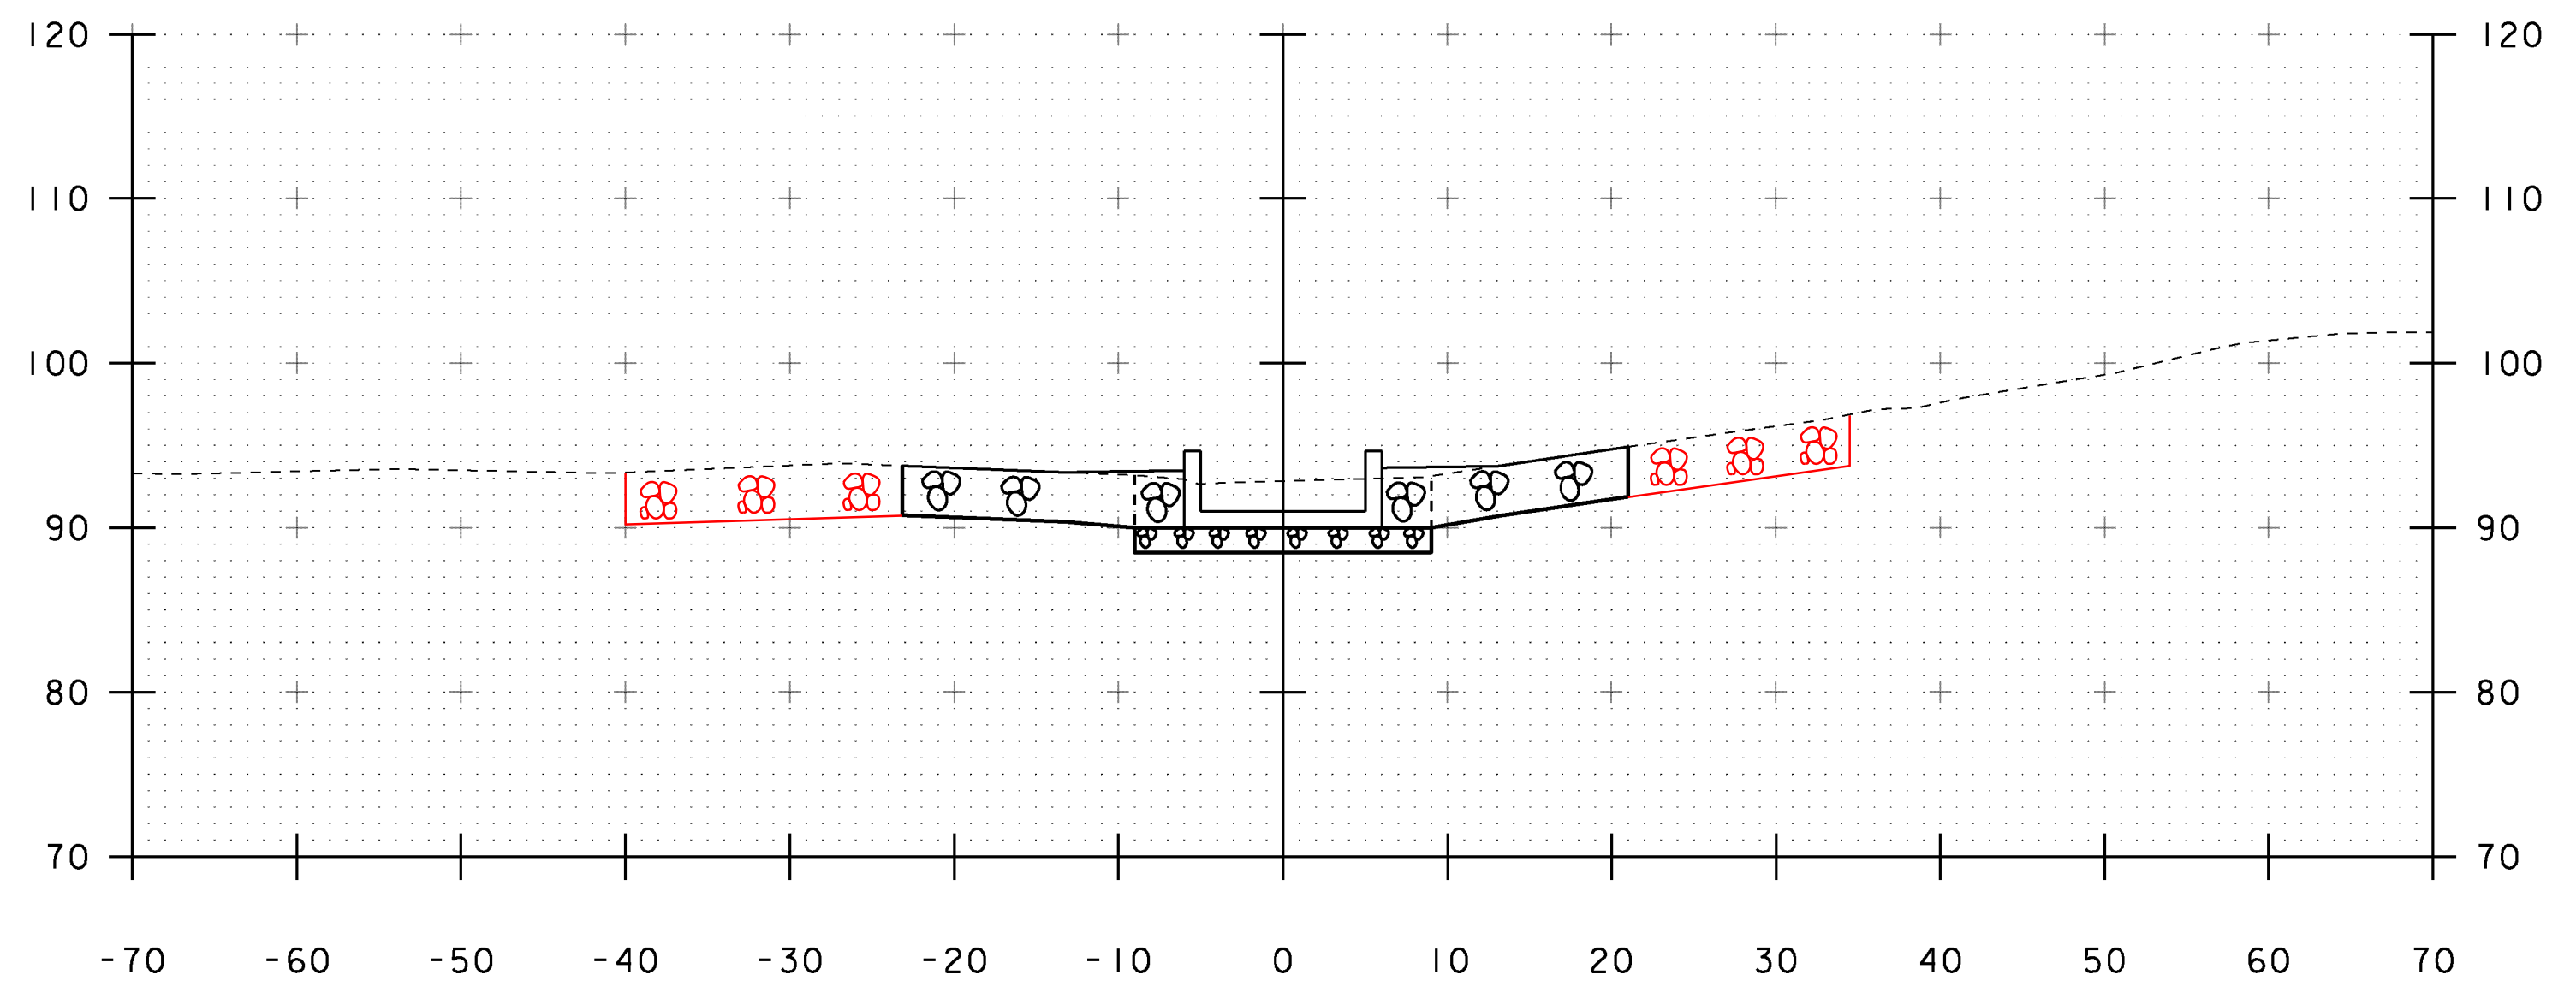

11+30

STA. 11+10 TO STA. 11+40

PROJECT NAME: ADDISON	PLOT DATE: 09-MAR-2013
PROJECT NUMBER: STP CULV(14)	DRAWN BY: J. GRIGAS
FILE NAME: s08b062xs.dgn	DESIGNED BY: J. SALVATORI
PROJECT LEADER: K. HIGGINS	CHECKED BY: J. SALVATORI
CHANNEL SECTIONS - 3	SHEET 26 OF 28