



11+75

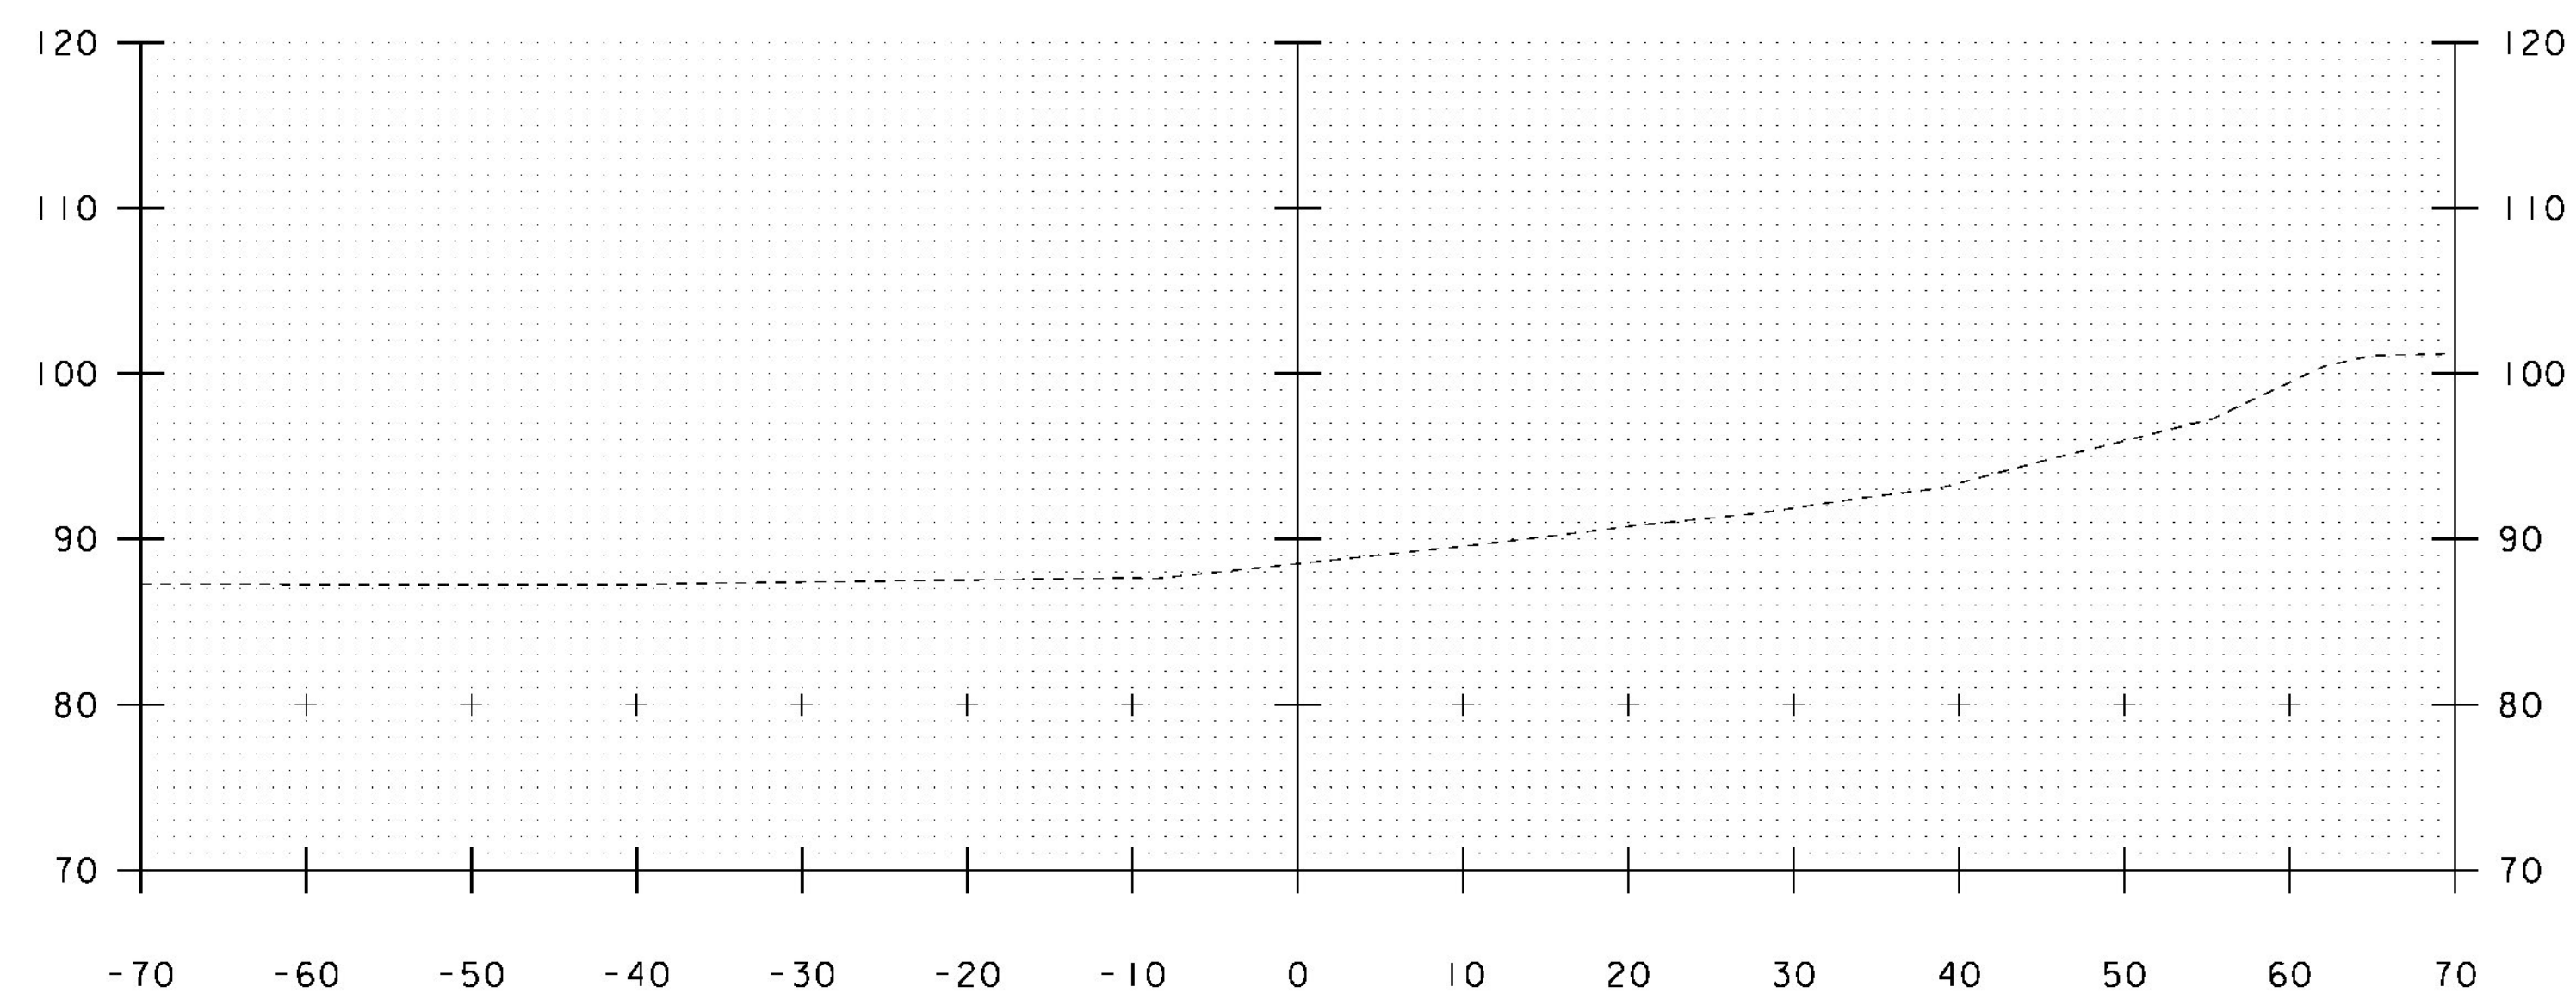

11+50

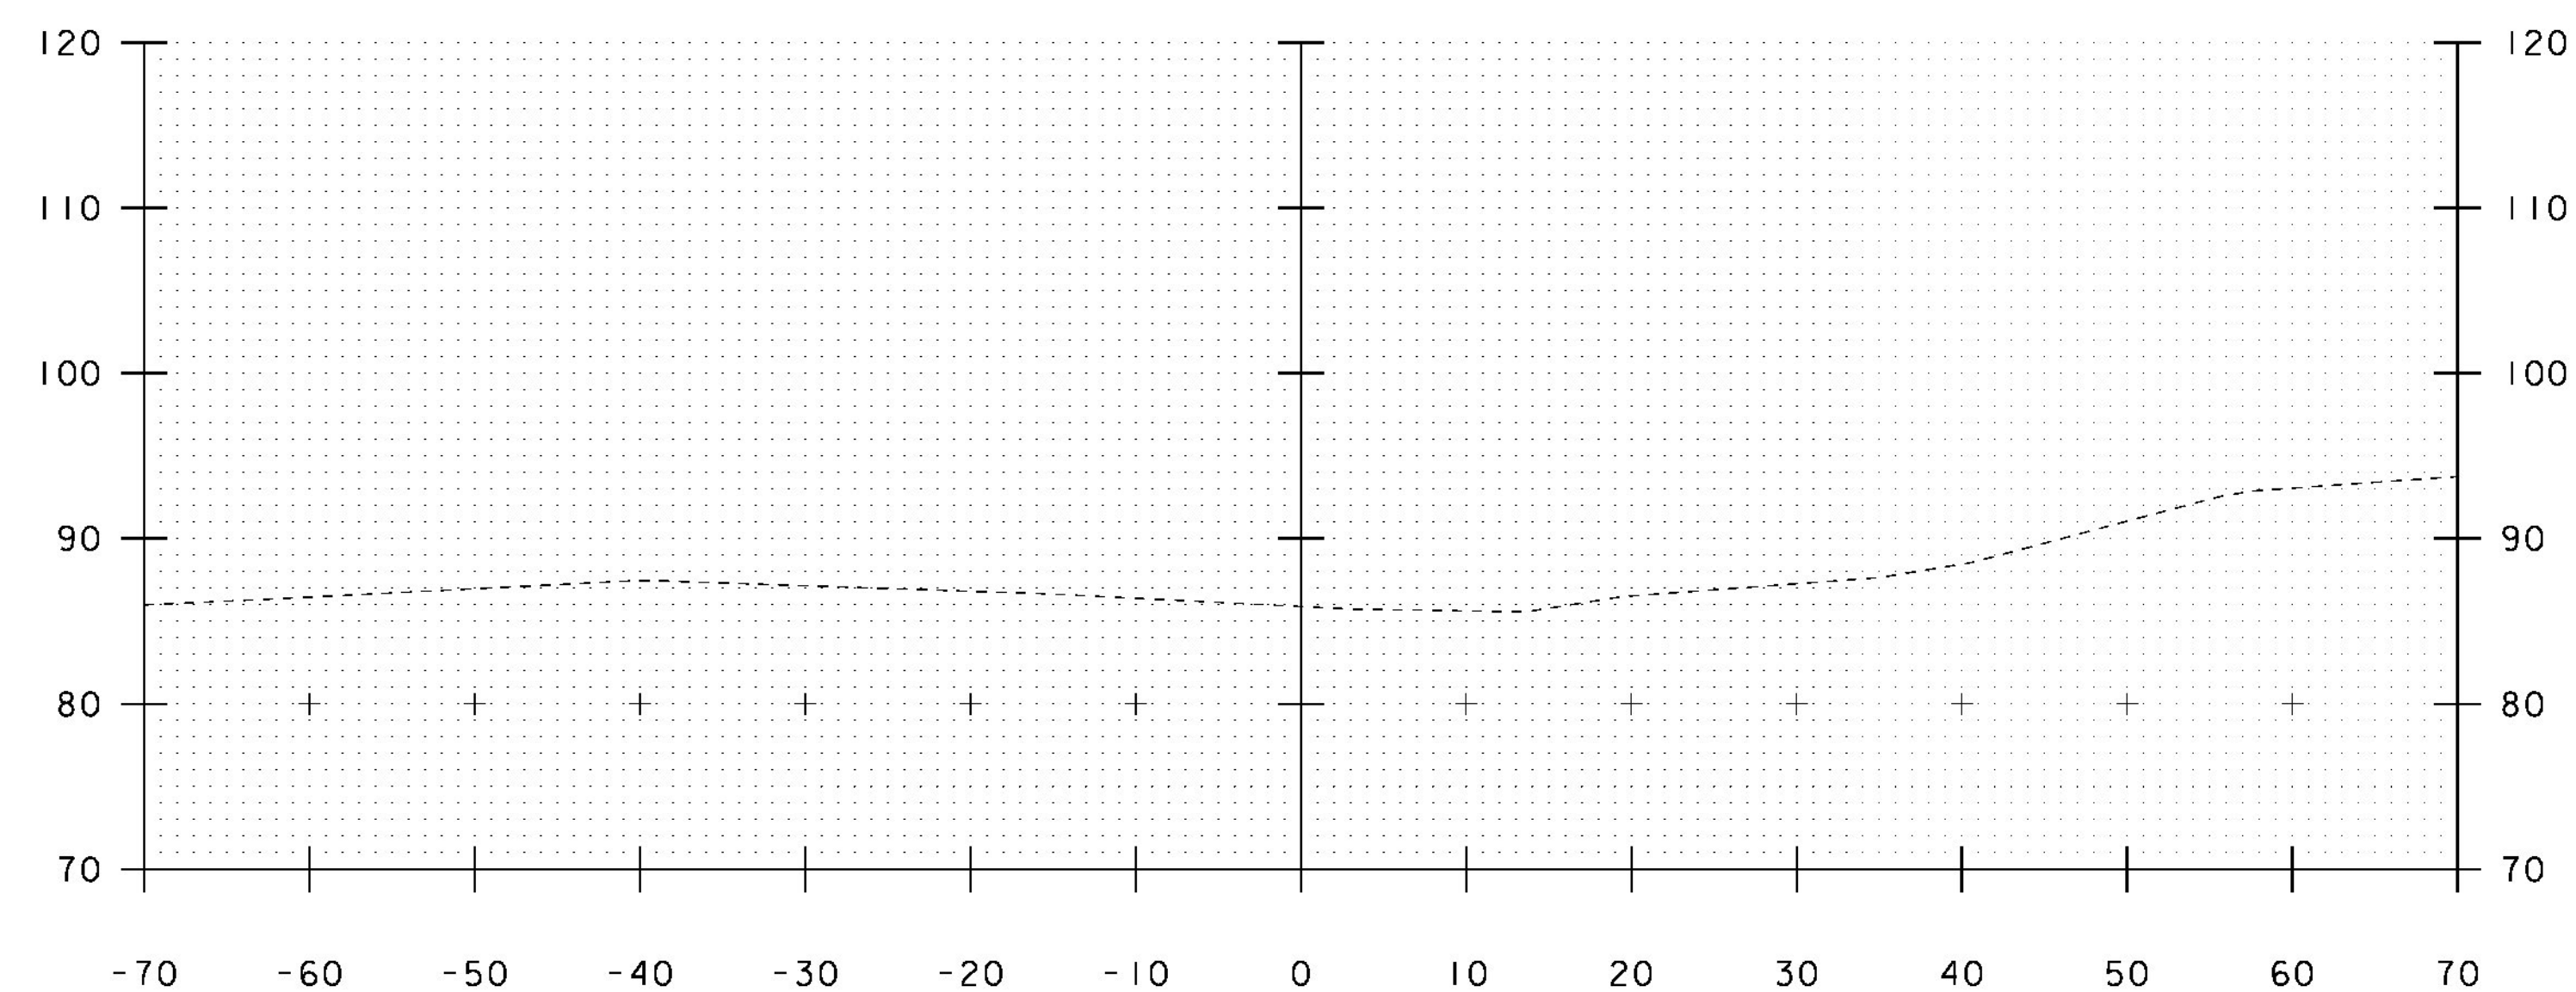

12+00

STA. 11+50 TO STA. 12+00

PROJECT NAME:	ADDISON	PLOT DATE:	09-MAR-2013
PROJECT NUMBER:	STP CULV(14)	DRAWN BY:	J. GRIGAS
FILE NAME:	s08b062xs.dgn	DESIGNED BY:	J. SALVATORI
PROJECT LEADER:	K. HIGGINS	CHECKED BY:	J. SALVATORI
CHANNEL SECTIONS -	4	SHEET	27 OF 28