



Plan View

Vermont Agency of Transportation
RECEIVED
 CK'D BY RKJW OK'D BY JS
 September 26, 2013

REVISED 10-25-2013 JTS
 BC-1 HAS BEEN OMITTED AND WILL NOT BE FABRICATED.
 HOLES FOR FOR DOWELING CUT OFF WALL SHALL BE ADDED TO BC-2

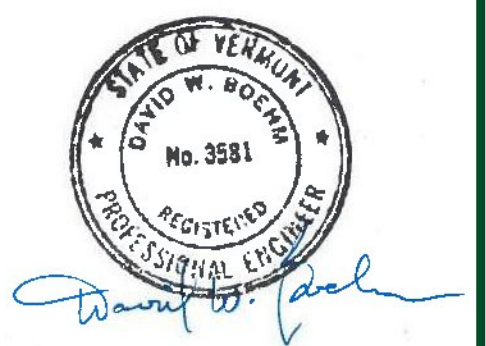

RESUBMIT NO Approved AsNoted
 BY KH DATE 10-25-2013

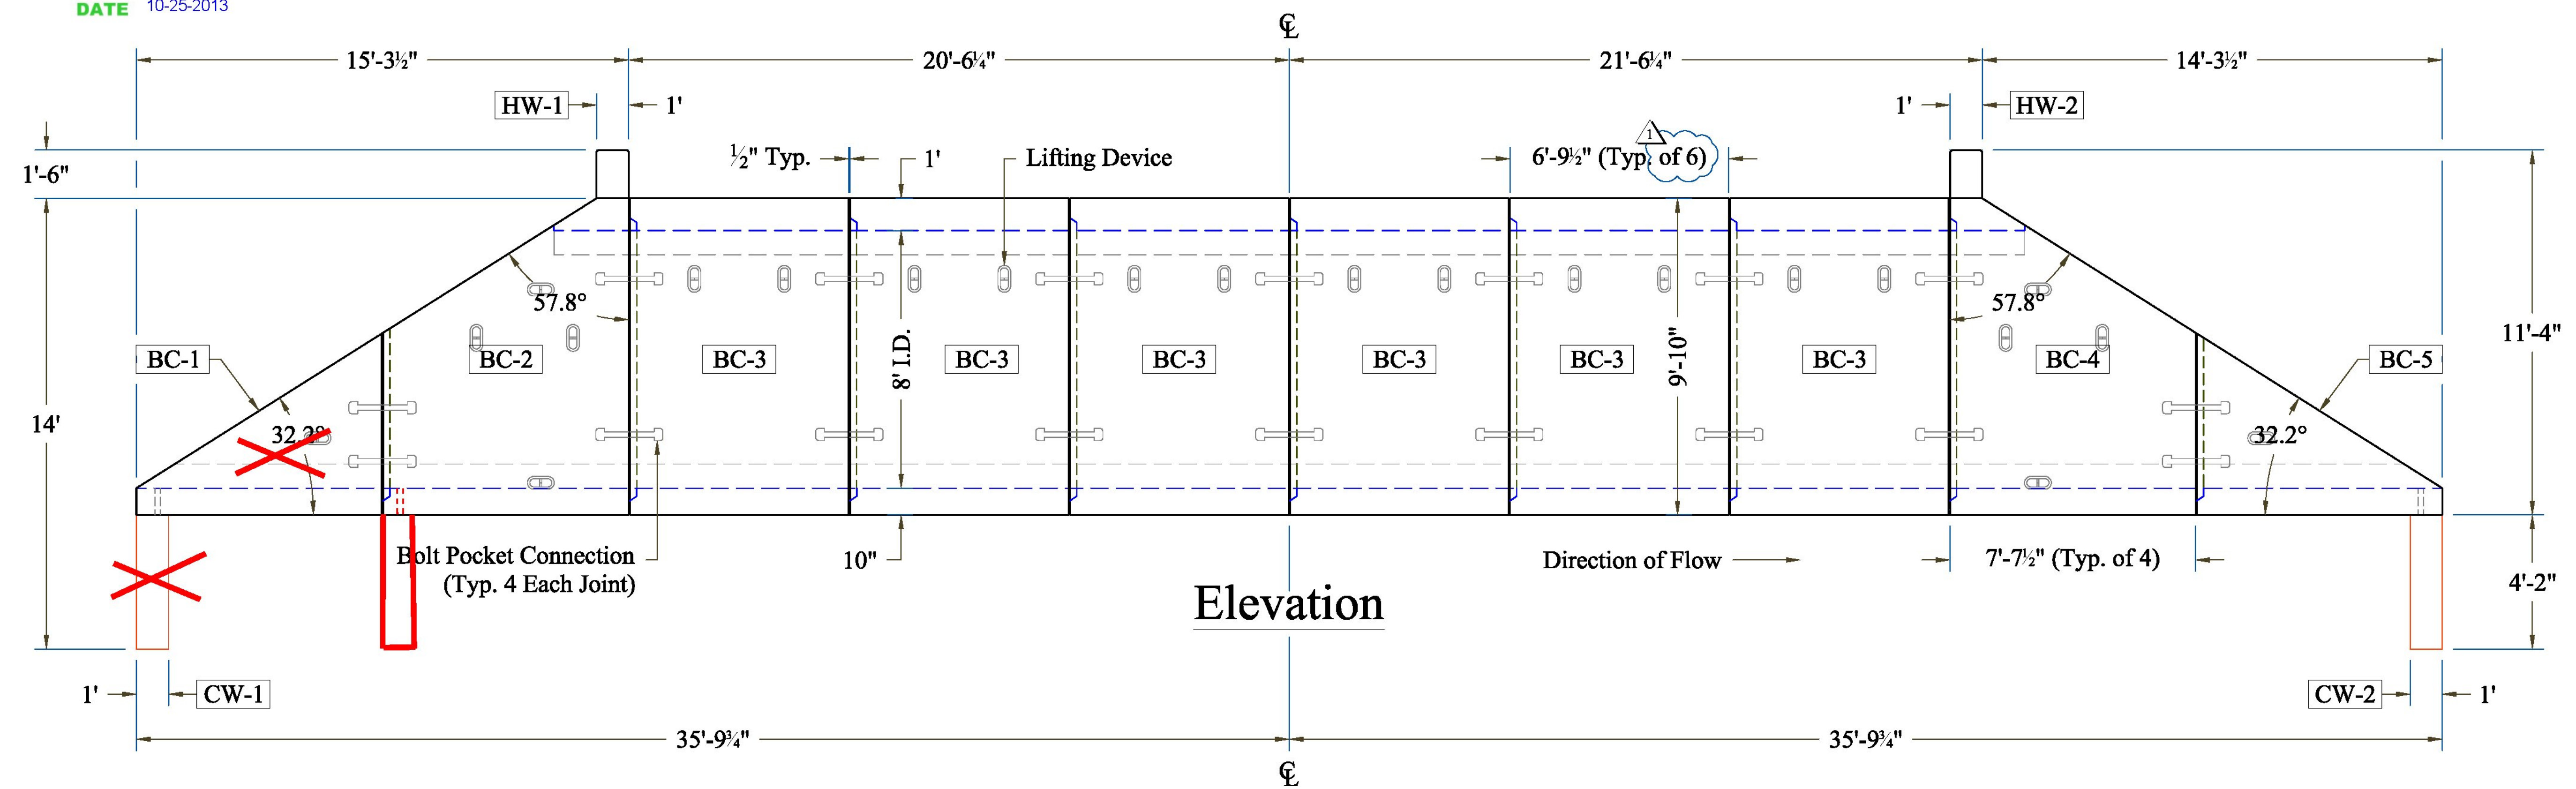

Elevation

Table of Units *BC-2 & BC-4 Include Headwall Weights **Weights May Vary									
Name	Qty	Length	Vol (CY)	Wt (lbs)**	Name	Qty	Length	Vol (CY)	Wt (lbs)**
BC-1	1	7'-7 1/2"	4.01	16,050	BC-3	6	6'-9 1/2"	9.02	36,065
BC-2*	1	7'-7 1/2"	7.50	30,000	BC-4*	1	7'-7 1/2"	7.50	30,000
					BC-5	1	7'-7 1/2"	4.01	16,050
					CW-1	1	11'-8"	1.80	7,200
					CW-2	1	11'-8"	1.80	7,200

1 09/26/13 - Revised Per Vermont Agency of Transportation Review

PRECAST CONCRETE BOX CULVERT SHOP DRAWINGS (SDI JOB #13510)
 SUPERVISOR: M. WHEELER
 DETAILER: C. DUPLANTIS
 CHECKER: M. WHEELER
 ENGINEER: ENGINEERING VENTURES

CONTRACTOR:
 193 INDUSTRIAL AVE.
 WILLISTON, VT 05495
 Ph: (802) 658-0201

FABRICATOR:
 193 INDUSTRIAL AVE.
 WILLISTON, VT 05495
 Ph: (802) 658-0201

