


BACKGROUND: ORANGE
BORDER AND LEGEND: BLACK

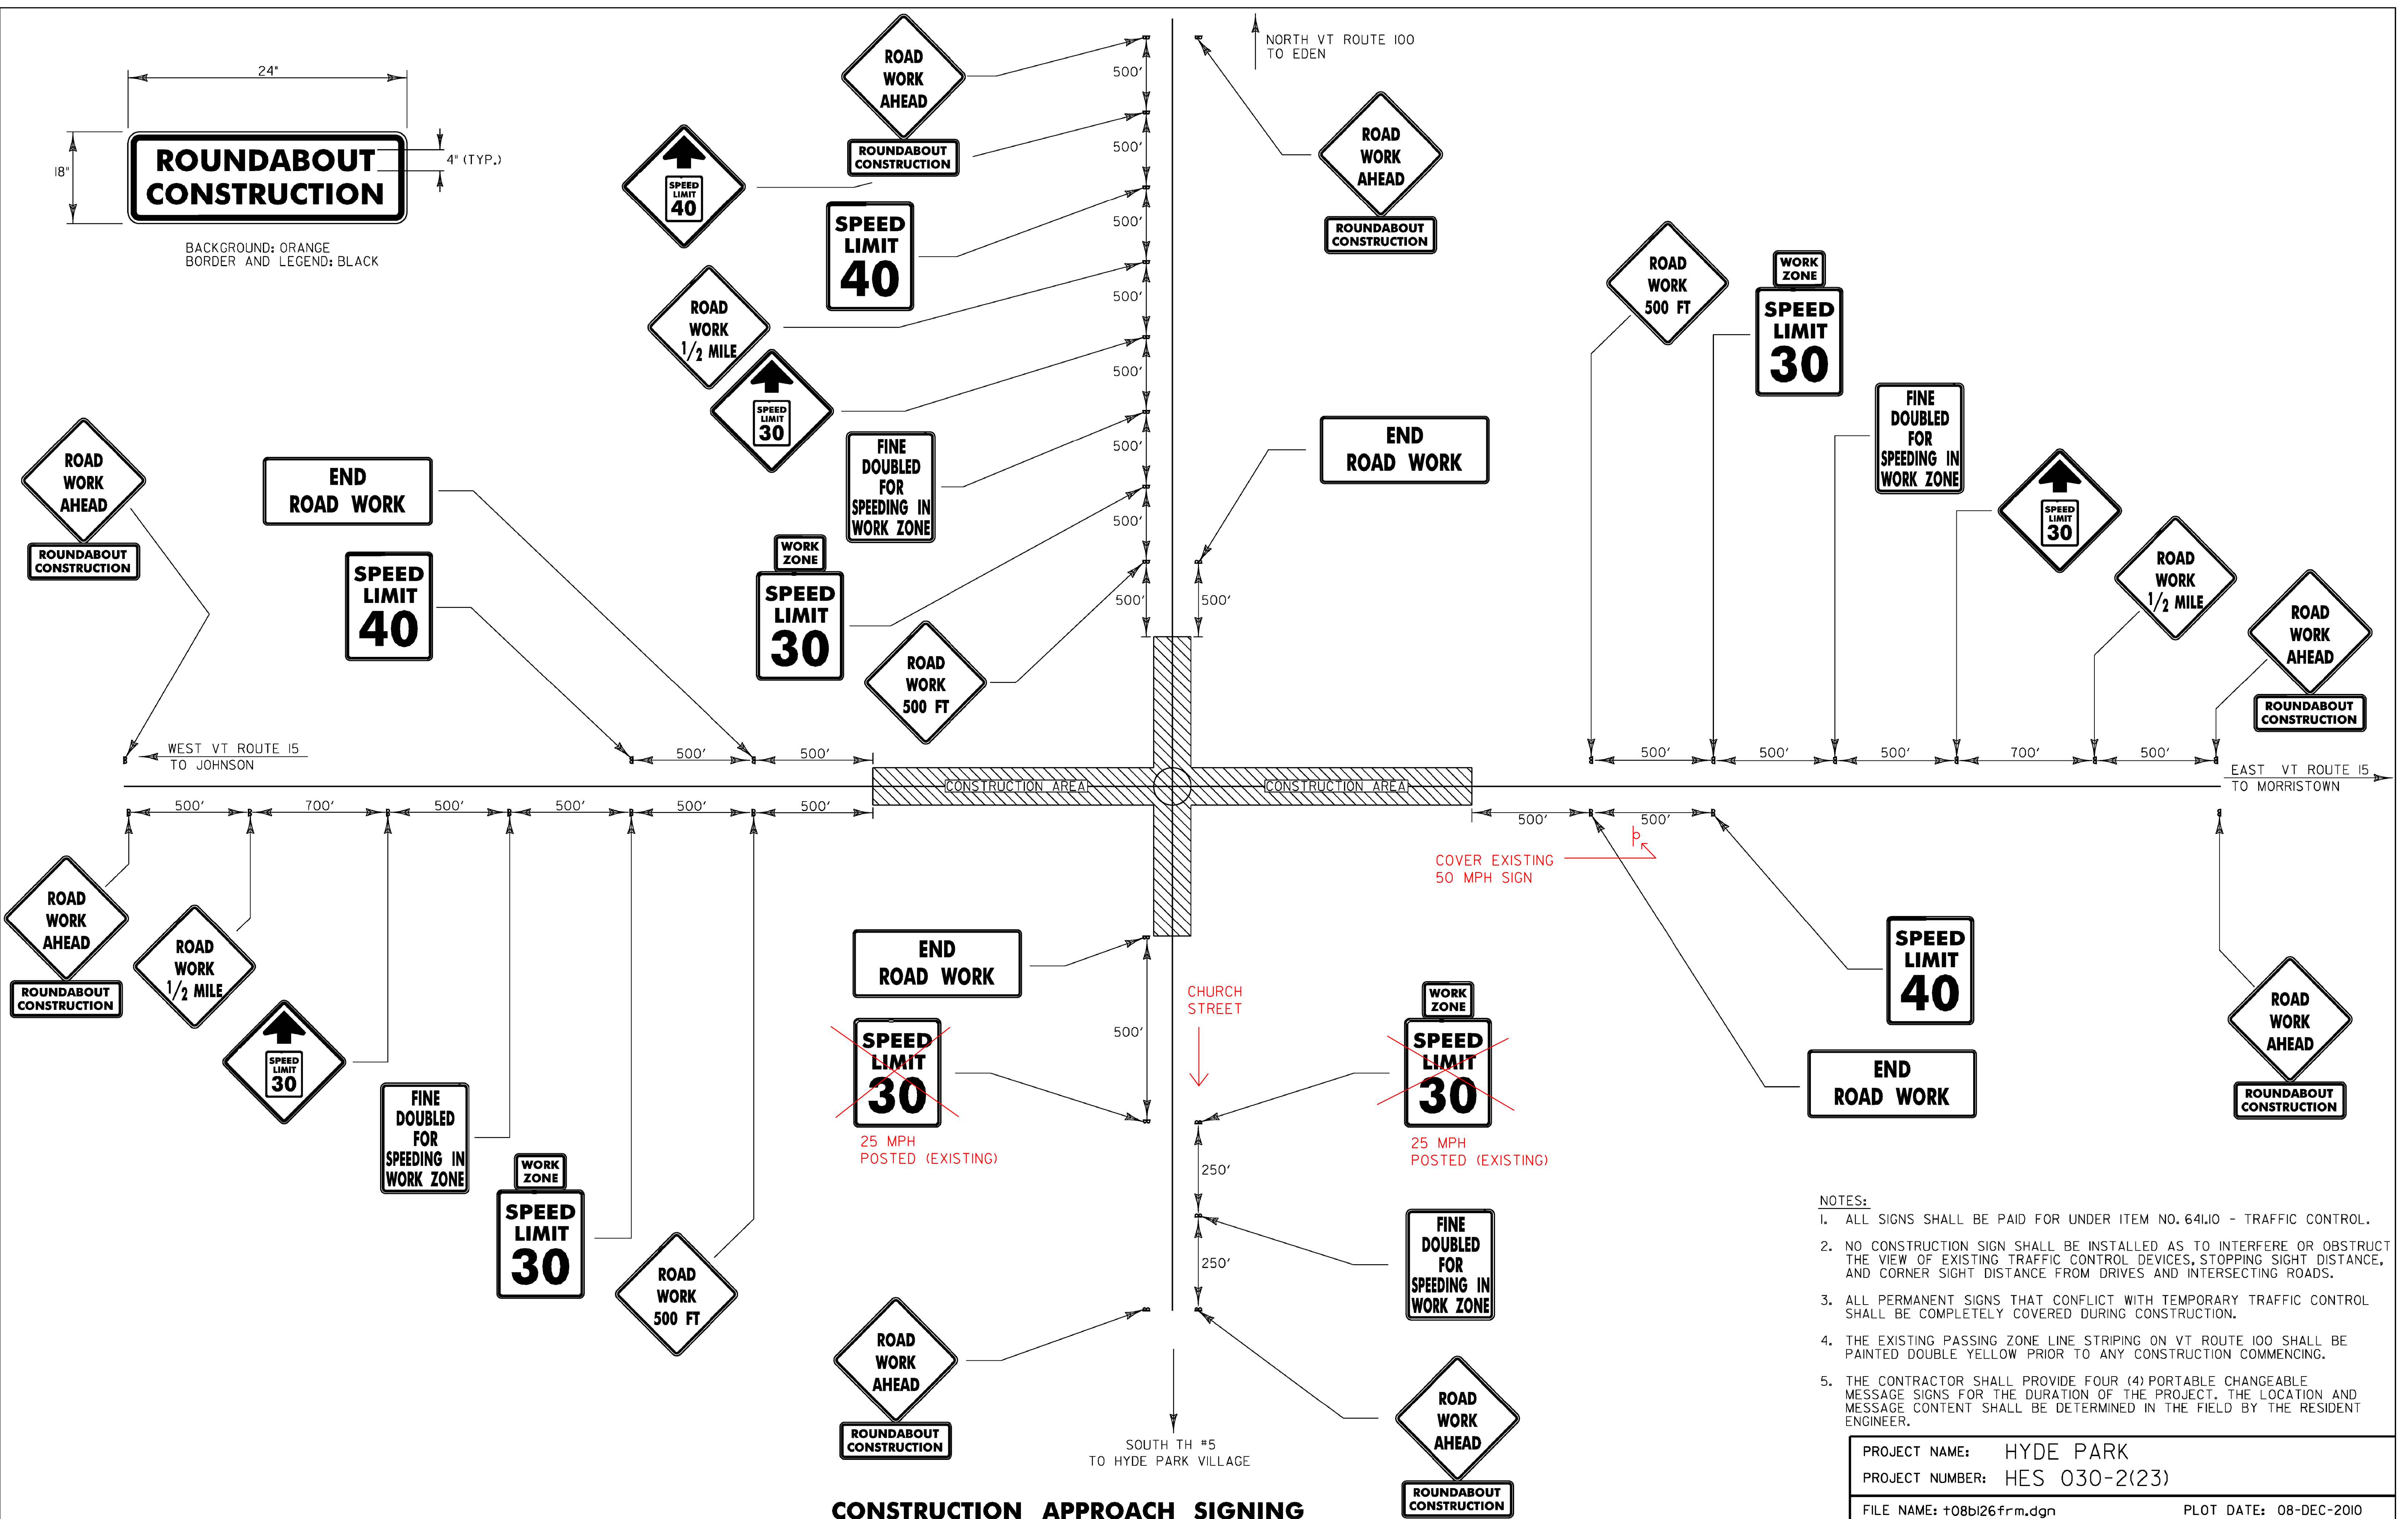

- NOTES:
1. ALL SIGNS SHALL BE PAID FOR UNDER ITEM NO. 641.10 - TRAFFIC CONTROL.
 2. NO CONSTRUCTION SIGN SHALL BE INSTALLED AS TO INTERFERE OR OBSTRUCT THE VIEW OF EXISTING TRAFFIC CONTROL DEVICES, STOPPING SIGHT DISTANCE, AND CORNER SIGHT DISTANCE FROM DRIVES AND INTERSECTING ROADS.
 3. ALL PERMANENT SIGNS THAT CONFLICT WITH TEMPORARY TRAFFIC CONTROL SHALL BE COMPLETELY COVERED DURING CONSTRUCTION.
 4. THE EXISTING PASSING ZONE LINE STRIPING ON VT ROUTE 100 SHALL BE PAINTED DOUBLE YELLOW PRIOR TO ANY CONSTRUCTION COMMENCING.
 5. THE CONTRACTOR SHALL PROVIDE FOUR (4) PORTABLE CHANGEABLE MESSAGE SIGNS FOR THE DURATION OF THE PROJECT. THE LOCATION AND MESSAGE CONTENT SHALL BE DETERMINED IN THE FIELD BY THE RESIDENT ENGINEER.

PROJECT NAME:	HYDE PARK
PROJECT NUMBER:	HES 030-2(23)
FILE NAME:	+08b126frm.dgn
PROJECT LEADER:	JLS
DESIGNED BY:	MBL
CONSTRUCTION APPROACH SIGNING SHEET	
PLOT DATE:	08-DEC-2010
DRAWN BY:	MBL
CHECKED BY:	JAD
SHEET	12 OF 100

CONSTRUCTION APPROACH SIGNING

NOT TO SCALE
SEE STD E-100 FOR SIGN PLACEMENT