


VT ROUTE 15 STA. 102+46.30
END PROJECT
HES 030-2(23)
BEGIN APPROACH


VT ROUTE 15
STA. 103+83.80
END APPROACH

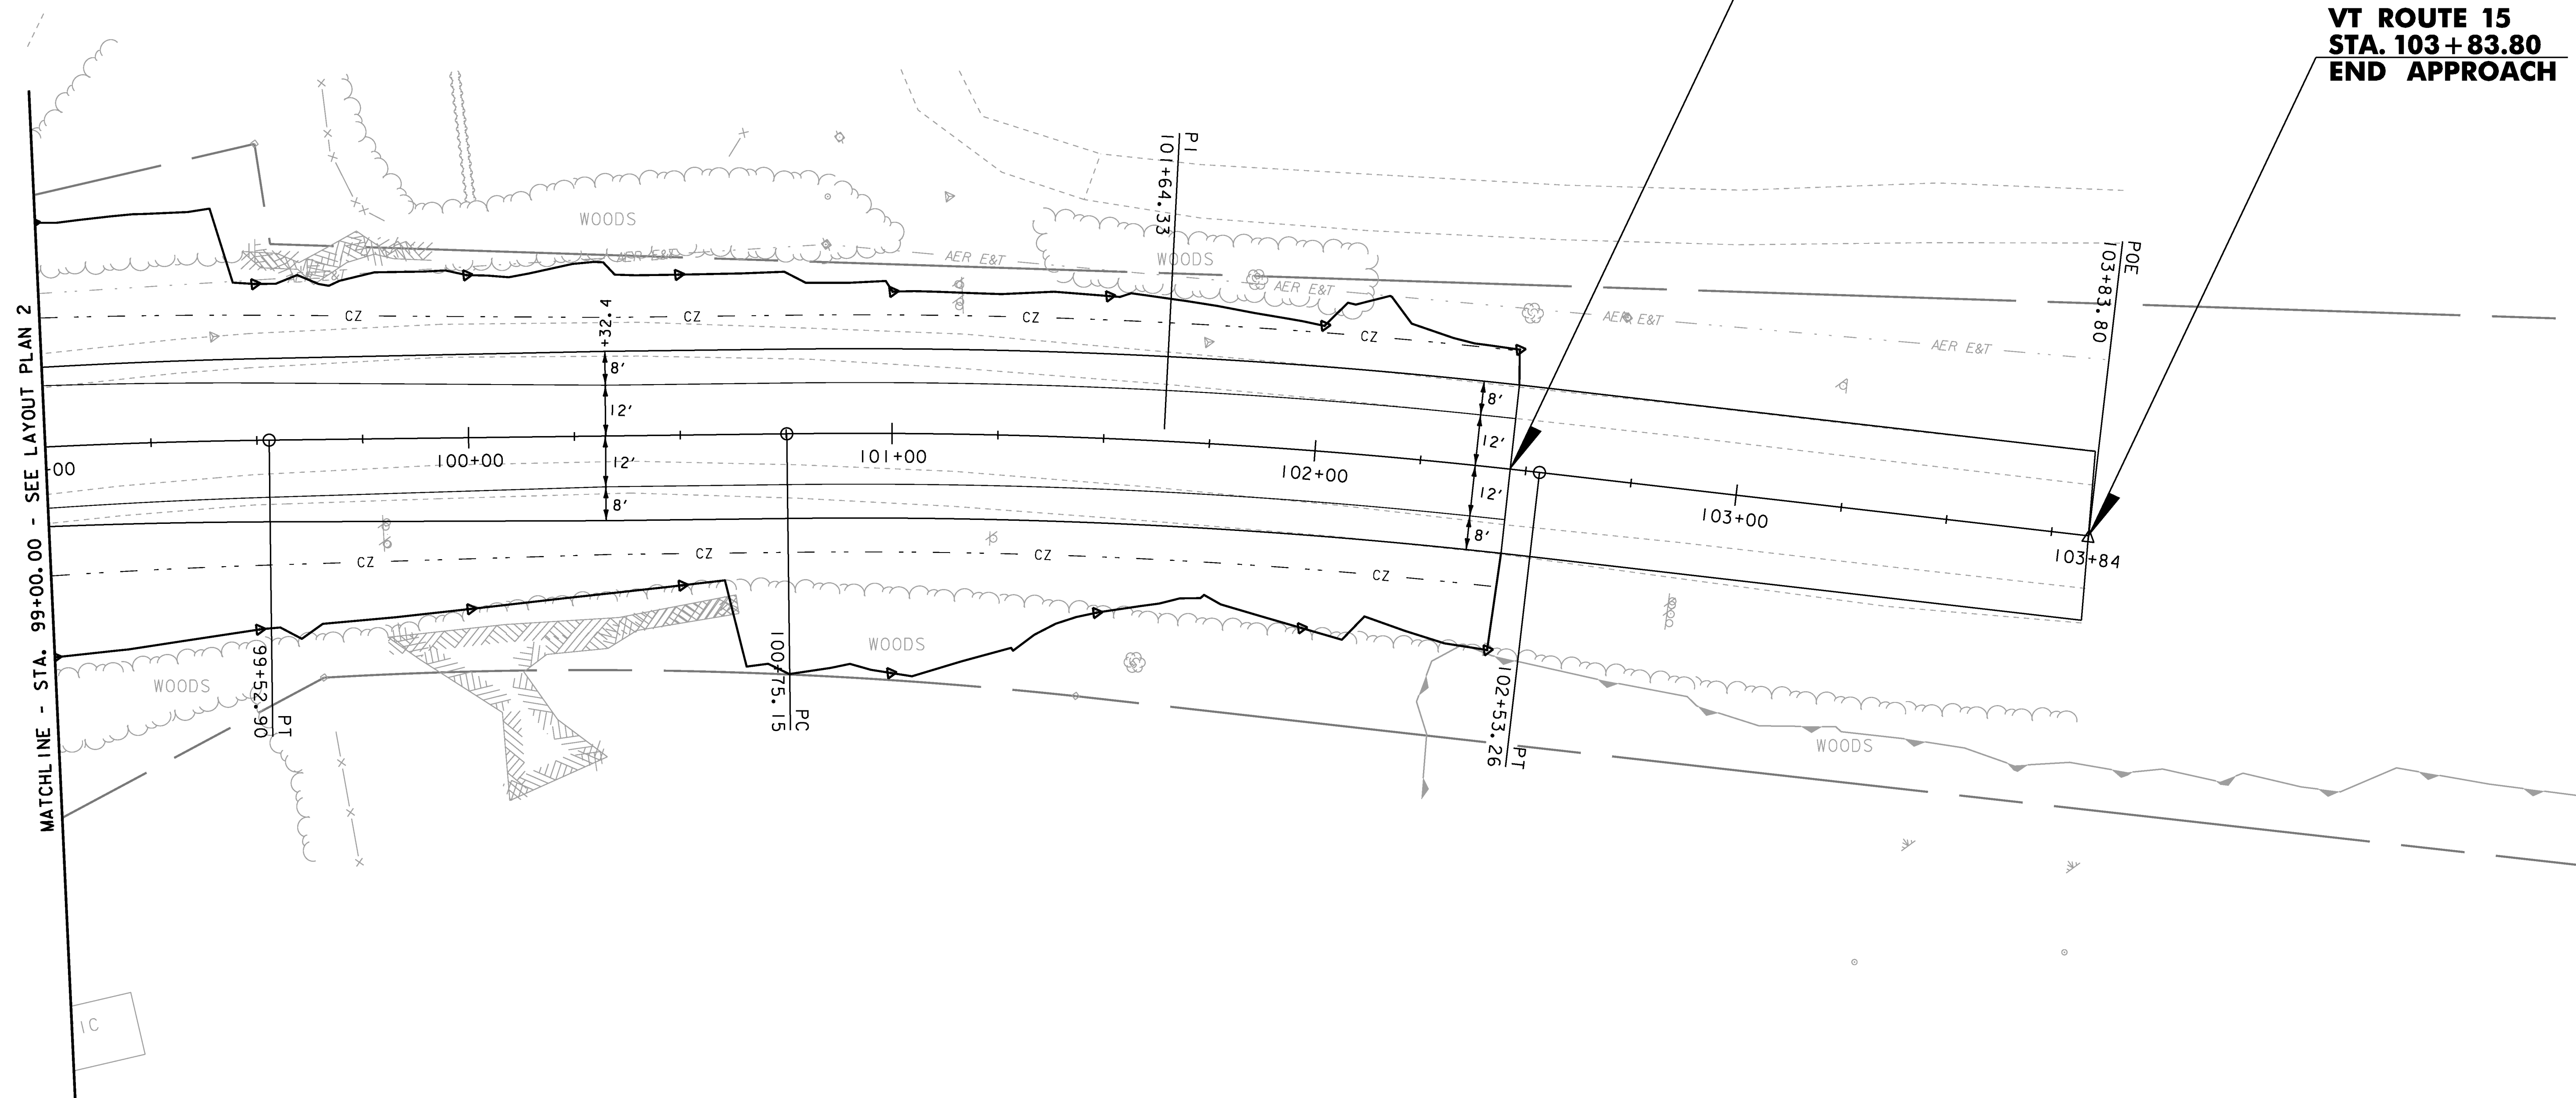

MATCHLINE - STA. 99+00.00 - SEE LAYOUT PLAN 2

IC

FUTURE SEPTIC SYSTEM

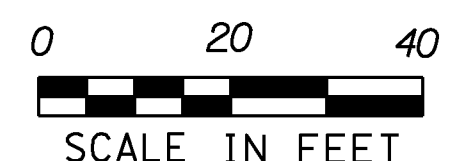

PROJECT NAME:	HYDE PARK	PLLOT DATE:	08-DEC-2010
PROJECT NUMBER:	HES 030-2(23)	DRAWN BY:	MBL
FILE NAME:	+08b126bdr.dgn	CHECKED BY:	JAD
PROJECT LEADER:	JLS	SHEET	17 OF 100
DESIGNED BY:	MBL		
LAYOUT PLAN	3		