



CONSTRUCT DRIVE
 STA. 42+13, L.T. (GRAVEL) (28')
 SPECIAL PROVISION
 (HAND-PLACED BIT. CONC.
 MATERIALS, DRIVE)
 STA. 42+13, L.T.

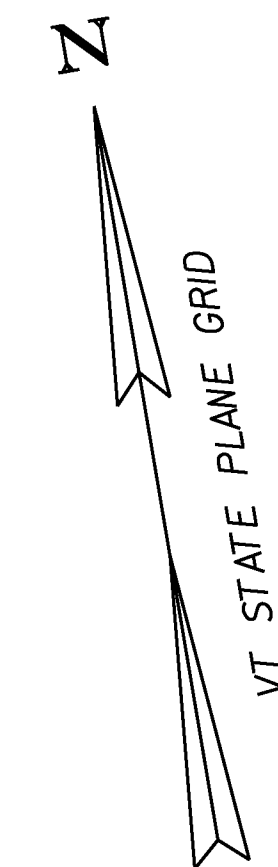

**VT ROUTE 100 STA. 42+76.83
 END PROJECT
 HES 030-2(23)
 BEGIN APPROACH**

**VT ROUTE 100
 STA. 44+14.33
 END APPROACH**

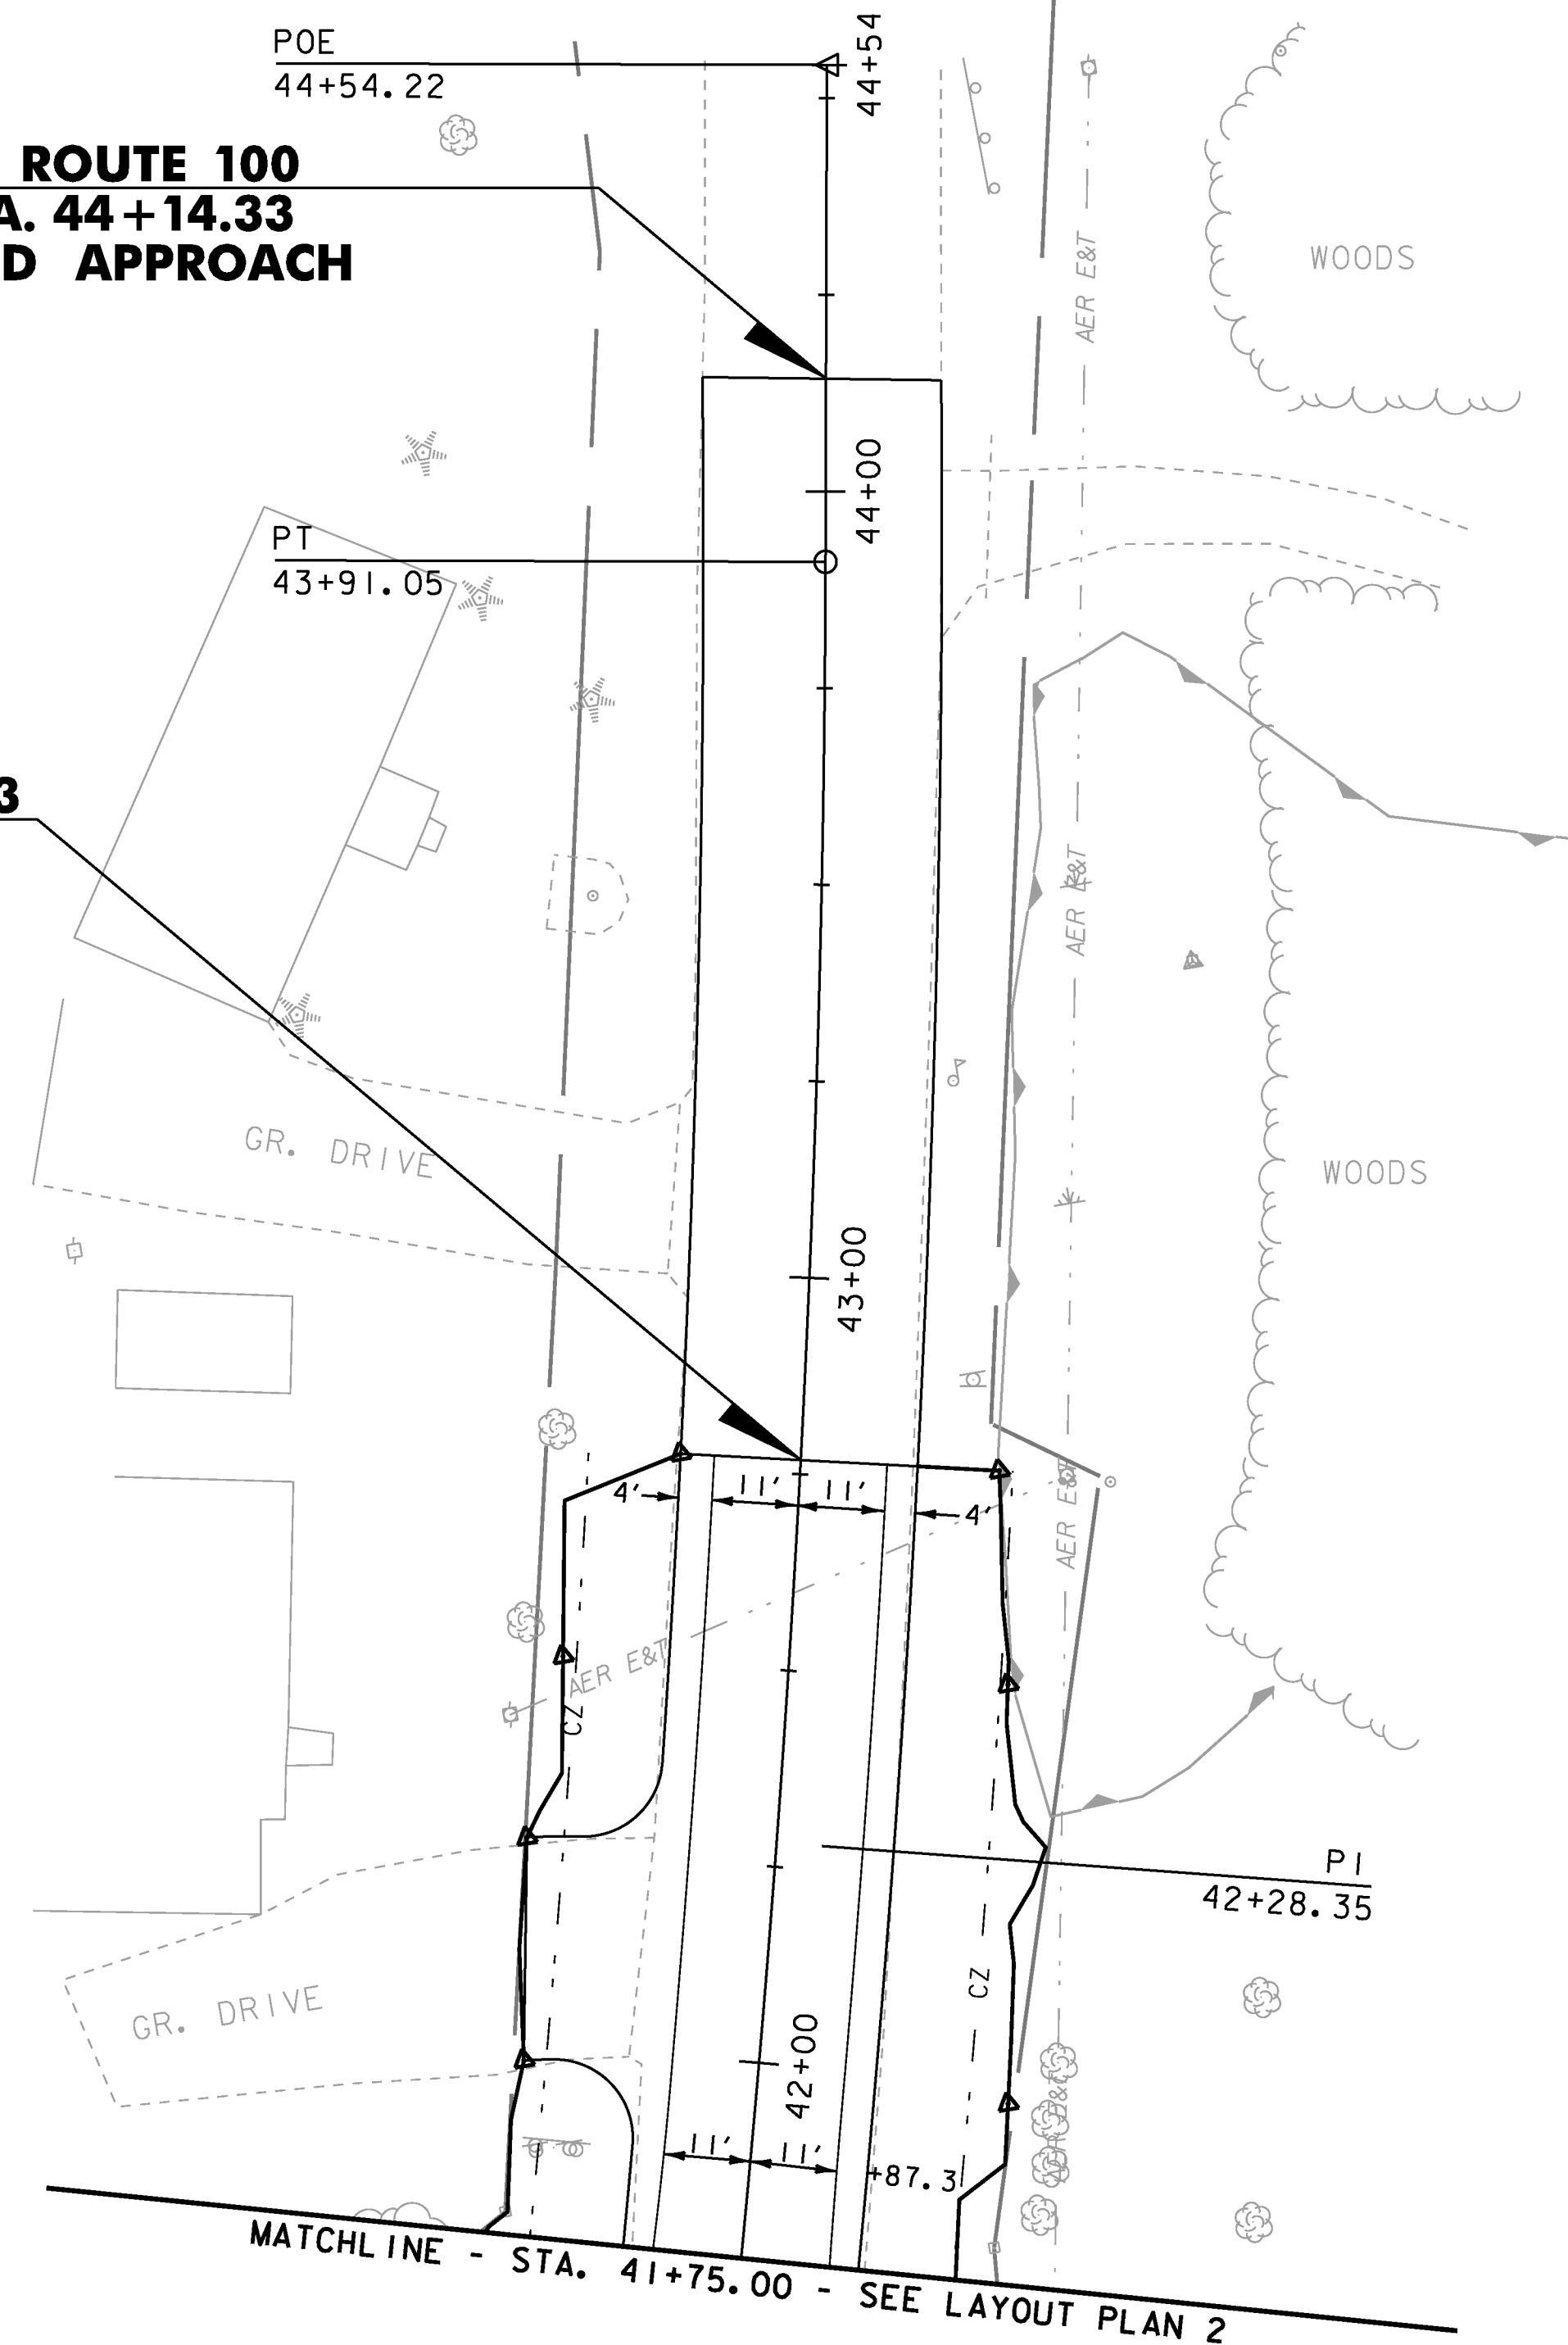

PROJECT NAME: HYDE PARK	PLOT DATE: 08-DEC-2010
PROJECT NUMBER: HES 030-2(23)	DRAWN BY: MBL
FILE NAME: +08b126bdr.dgn	CHECKED BY: JAD
PROJECT LEADER: JLS	SHEET 18 OF 100
DESIGNED BY: MBL	
LAYOUT PLAN 4	