



VT ROUTE 100 PROFILE

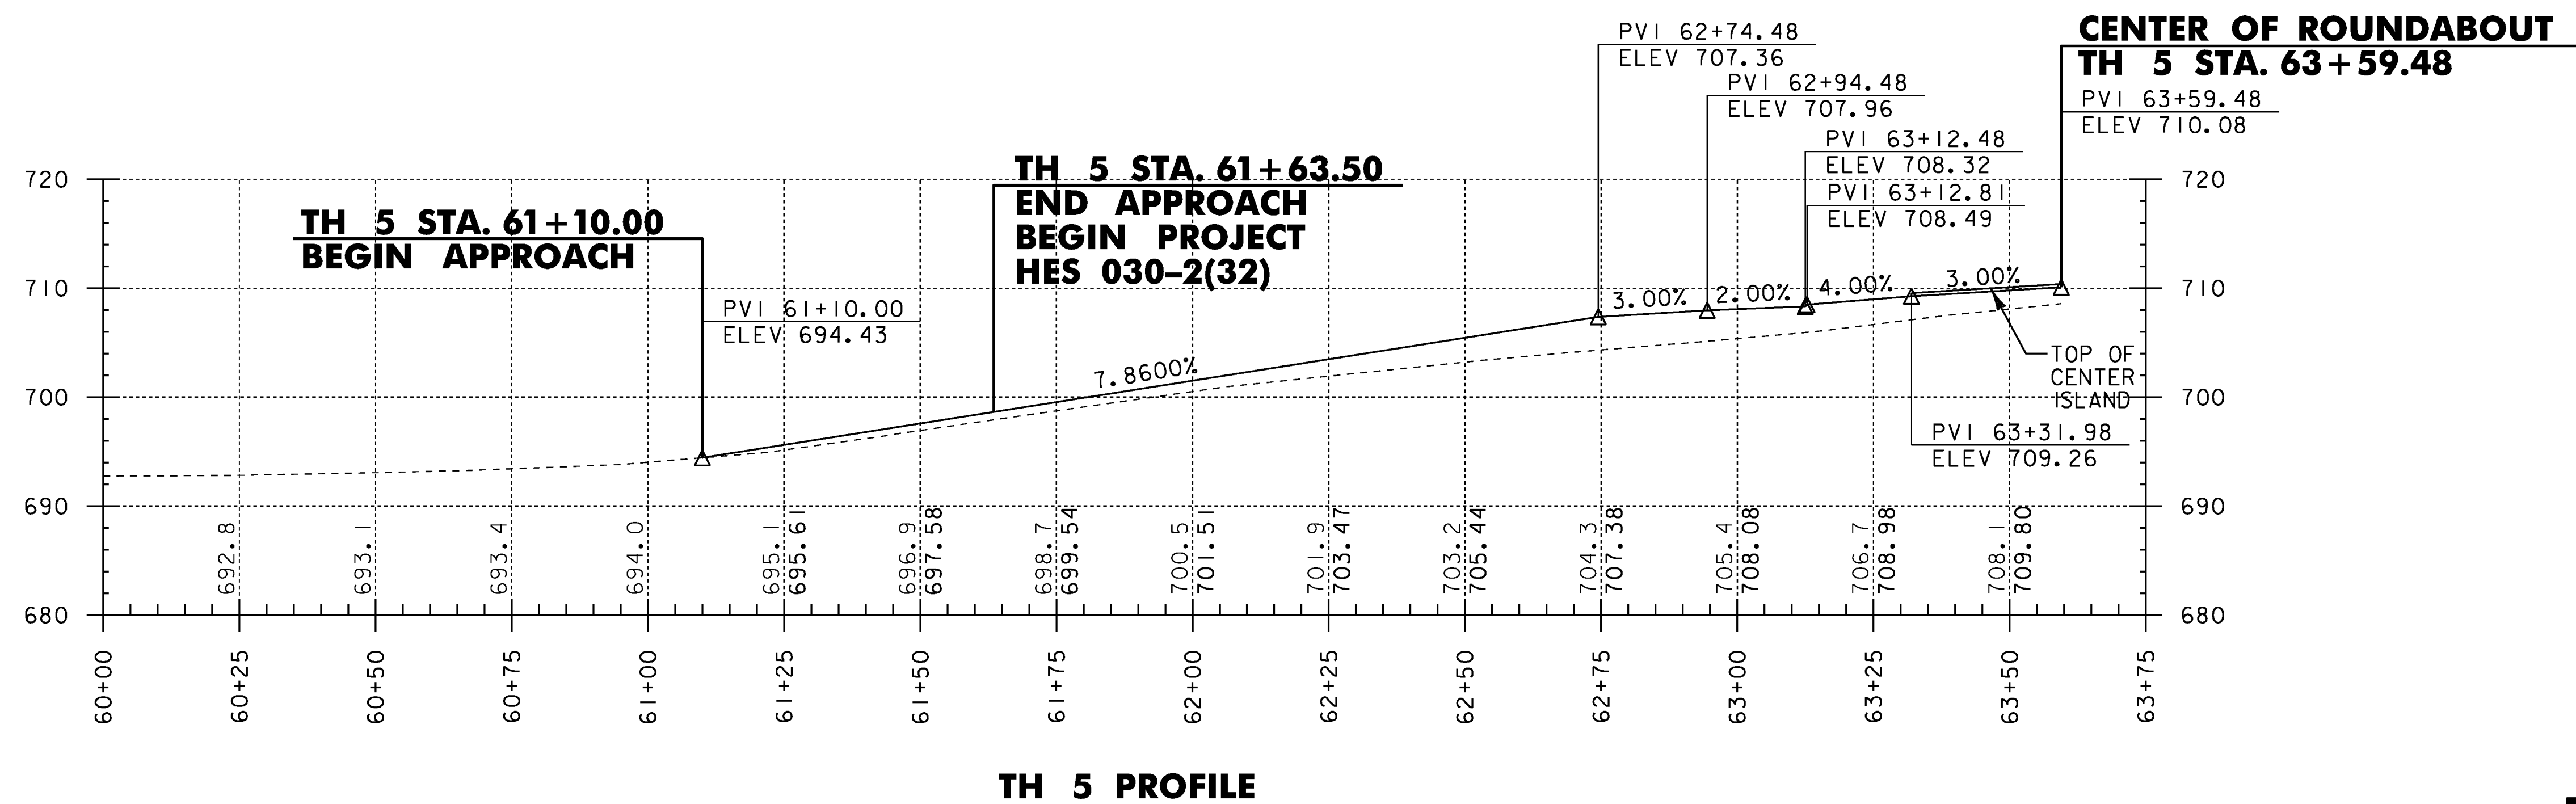

TH 5 PROFILE

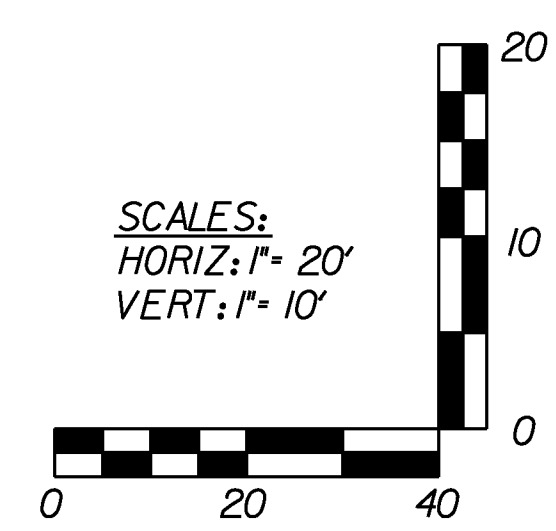

NOTE:
 GRADES SHOWN TO THE NEAREST TENTH
 ARE AT EXISTING GROUND ALONG CENTERLINE.
 GRADES SHOWN TO THE NEAREST HUNDREDTH
 ARE AT FINISHED GRADE ALONG CENTERLINE.

PROJECT NAME:	HYDE PARK	FILE NAME:	+08b126pro.dgn	PLOT DATE:	08-DEC-2010
PROJECT NUMBER:	HES 030-2(23)	PROJECT LEADER:	JLS	DRAWN BY:	MBL
		DESIGNED BY:	MBL	CHECKED BY:	JAD
		PROFILE SHEET	3	SHEET	22 OF 100