
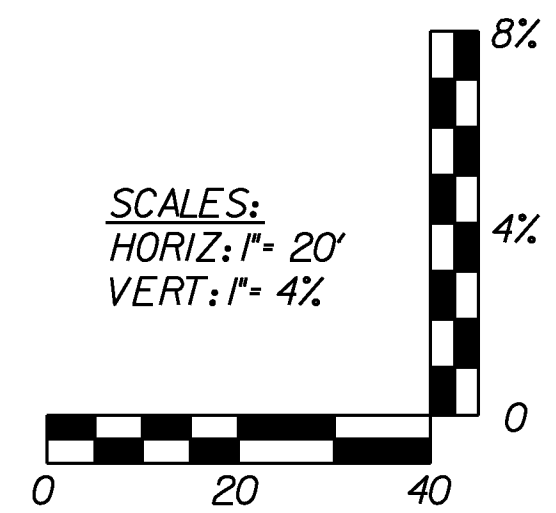


VT ROUTE 100
BANKING DIAGRAM

VT ROUTE 15 BANKING DIAGRAMS

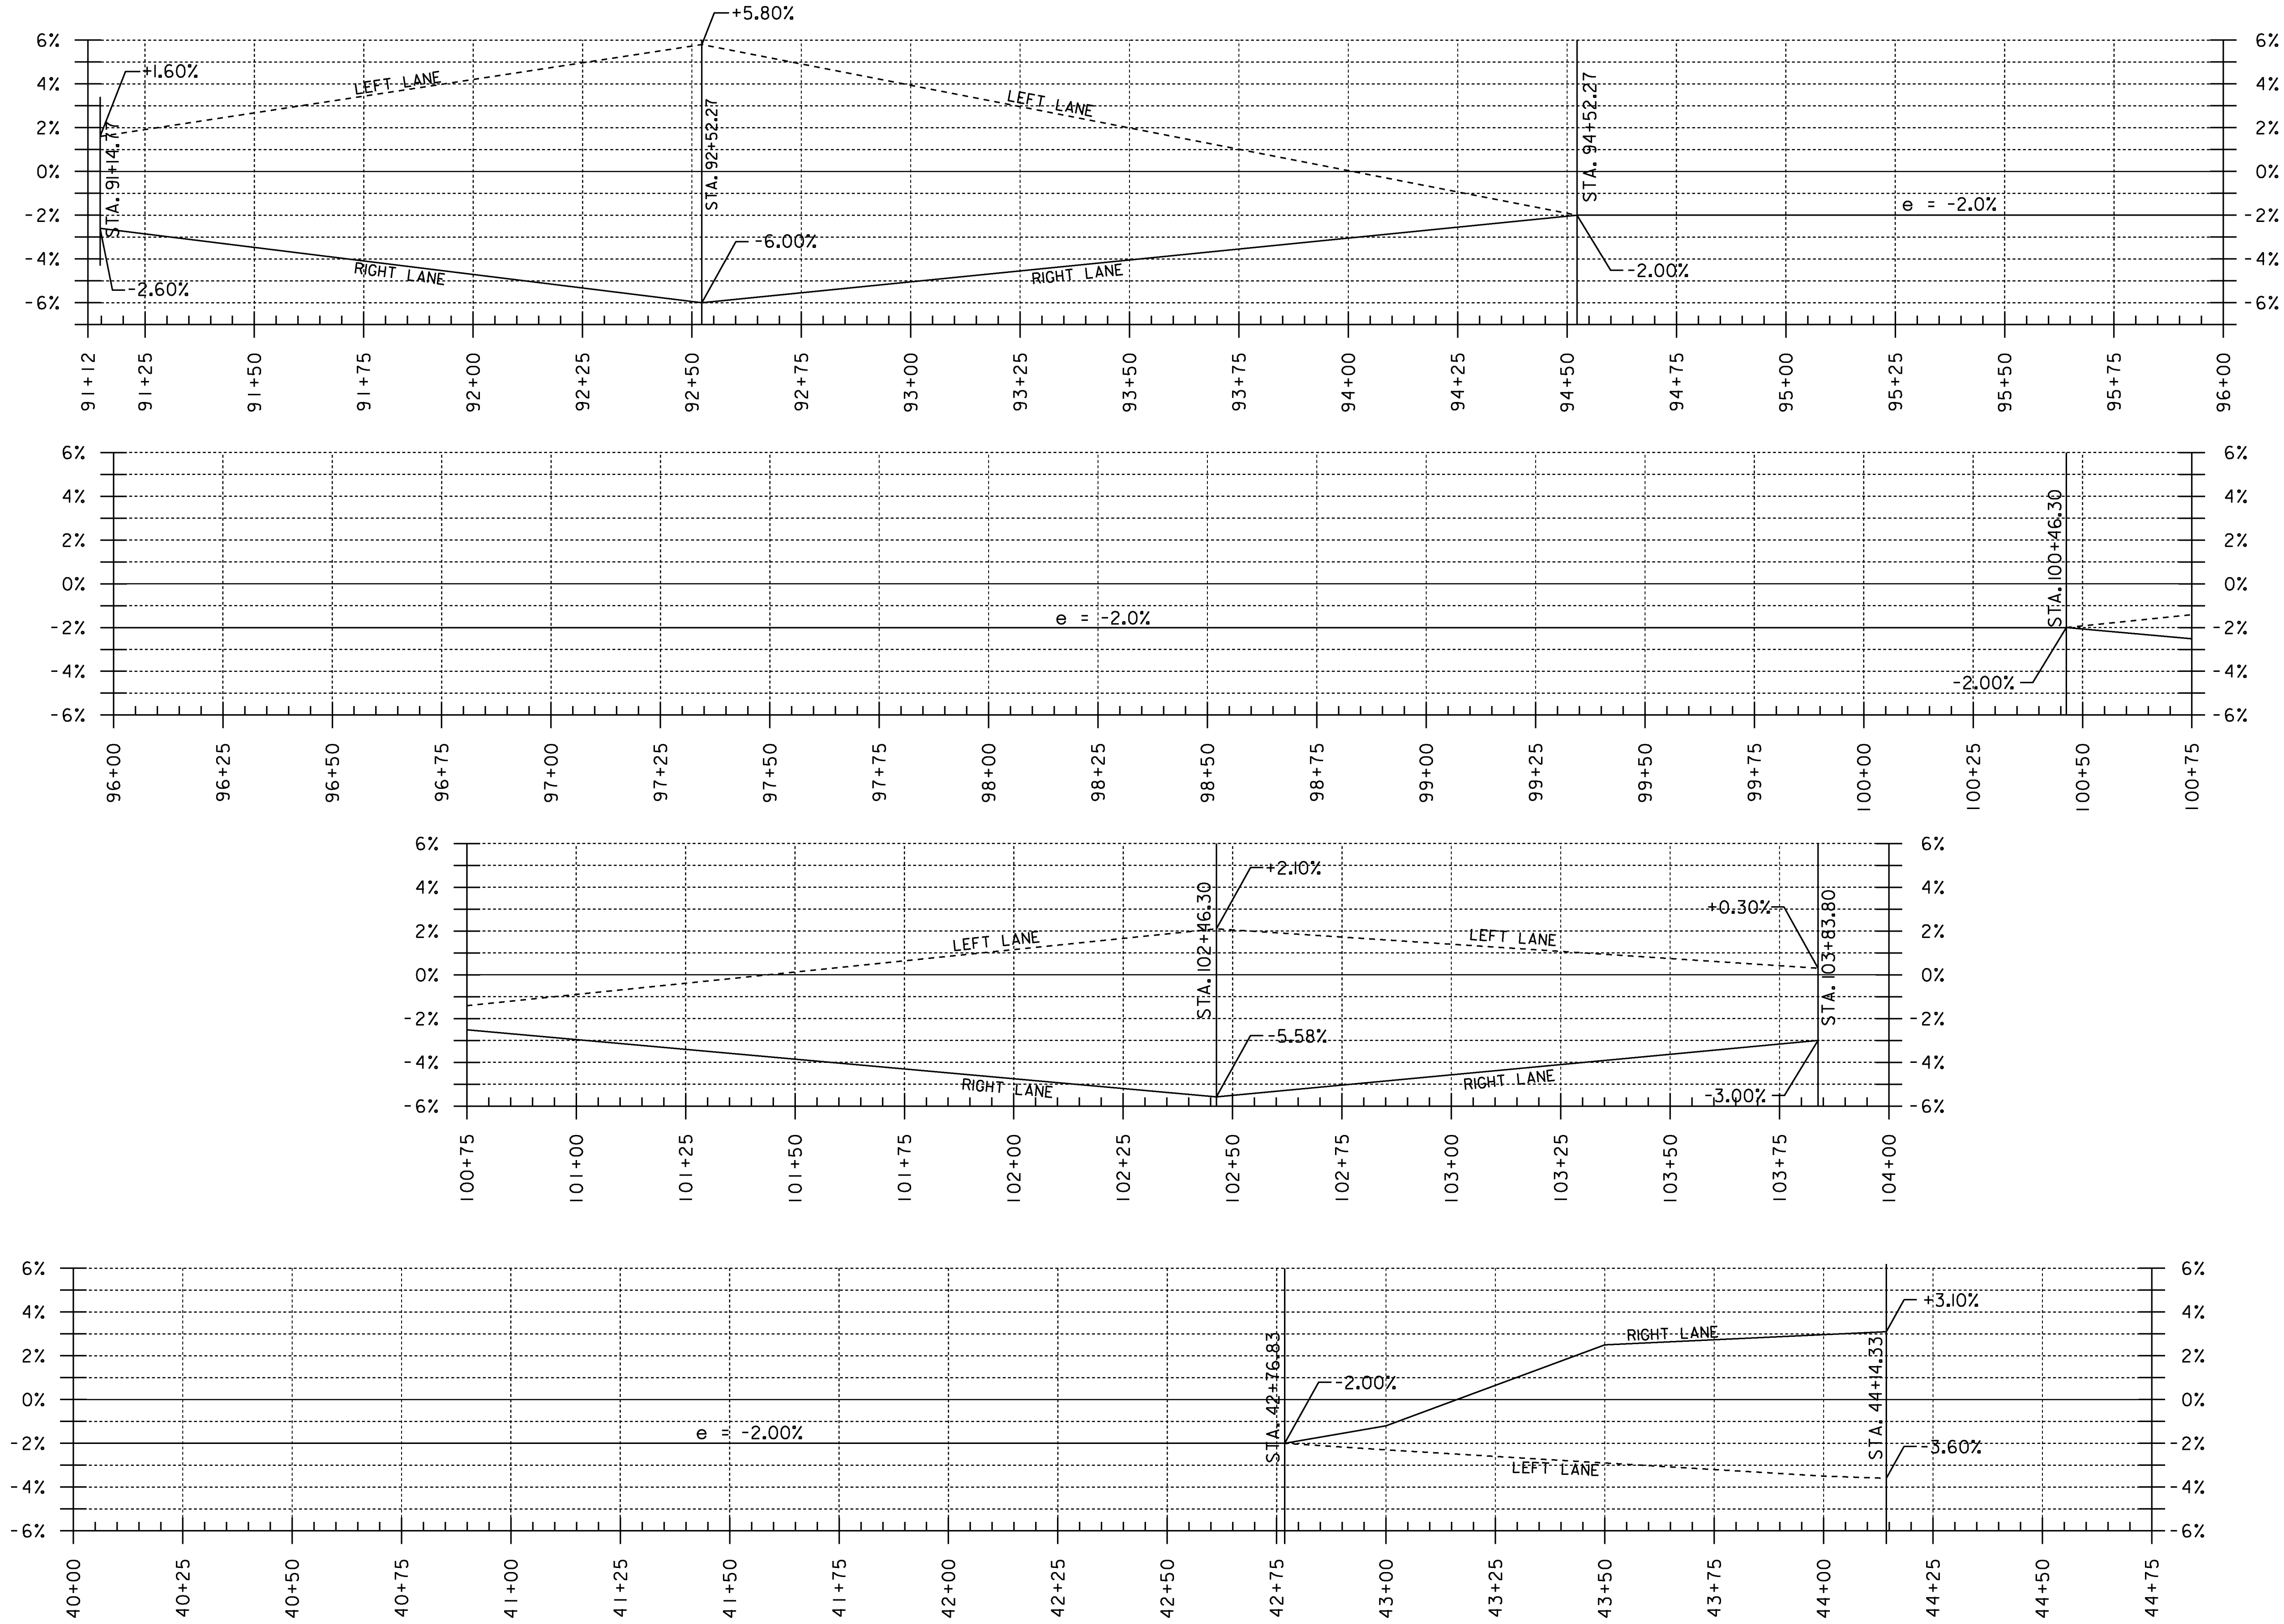

PROJECT NAME:	HYDE PARK	PLOT DATE:	08-DEC-2010
PROJECT NUMBER:	HES 030-2(23)	DRAWN BY:	MBL
FILE NAME:	+08b126bnk.dgn	CHECKED BY:	JAD
PROJECT LEADER:	JLS	BANKING DIAGRAM SHEET	SHEET 23 OF 100