


ROADWAY CURB LOCATIONS										
Curb ID	Type	Begin			End			Radius	Length	Remarks
		Station	Offset	Location	Station	Offset	Location			
Roundabout Central Island										
A-1	Vertical	-	-	-	-	-	-	27.50'	172.79'	
Roadway Curbing										
F-1	Vertical	95+30.75	17.55'	LT.	95+45.61	19.38'	LT.	STRAIGHT	15.26'	Taper to 1" reveal per Std. C-10
F-2	Vertical	95+45.61	19.38'	LT.	95+88.69	42.71'	LT.	70.00'	50.22'	-
F-3	Vertical	95+88.69	42.71'	LT.	40+50.49	40.94'	LT.	65.00'	19.69'	-
F-4	Vertical	40+50.49	40.94'	LT.	40+87.50	19.42'	LT.	60.00'	43.54'	-
F-5	Vertical	40+87.50	19.42'	LT.	41+02.14	16.83'	LT.	STRAIGHT	14.76'	Taper to 1" reveal per Std. C-10
G-2	Vertical	41+06.39	16.04'	RT.	41+01.71	16.83'	RT.	STRAIGHT	4.78'	Taper to 1" reveal per Std. C-10
G-3	Vertical	41+01.71	16.83'	RT.	40+92.84	18.00'	RT.	STRAIGHT	9.00'	-
G-4	Vertical	40+92.84	18.00'	RT.	40+49.66	41.94'	RT.	70.00'	50.75'	-
G-5	Vertical	40+49.66	41.94'	RT.	96+88.08	40.99'	RT.	65.00'	20.22'	-
G-6	Vertical	96+88.08	40.99'	RT.	97+24.83	20.09'	RT.	60.00'	43.93'	-
G-7	Vertical	97+24.83	20.09'	RT.	97+44.50	17.38'	RT.	STRAIGHT	20.10'	Taper to 1" reveal per Std. C-10
H-1	Vertical	62+48.71	16.23'	RT.	62+76.82	20.18'	RT.	STRAIGHT	28.36'	Taper to 1" reveal per Std. C-10
H-2	Vertical	62+76.82	20.18'	RT.	63+06.94	38.26'	RT.	45.00'	36.08'	-
H-3	Vertical	63+06.94	38.26'	RT.	96+90.30	38.32'	RT.	STRAIGHT	2.89'	-
H-4	Vertical	96+90.30	38.32'	RT.	97+22.26	19.67'	RT.	45.00'	37.54'	-
H-5	Vertical	97+22.26	19.67'	RT.	97+44.26	17.35'	RT.	STRAIGHT	21.83'	Taper to 1" reveal per Std. C-10
J-1	Vertical	95+29.91	17.39'	RT.	95+47.00	19.41'	RT.	STRAIGHT	16.88'	Taper to 1" reveal per Std. C-10
J-2	Vertical	95+47.00	19.41'	RT.	95+87.37	41.14'	RT.	60.00'	46.90'	-
J-3	Vertical	95+87.37	41.14'	RT.	63+10.64	42.88'	LT.	65.00'	11.51'	-
J-4	Vertical	63+10.64	42.88'	LT.	62+65.36	19.45'	LT.	70.00'	52.18'	-
J-5	Vertical	62+65.36	19.45'	LT.	61+86.78	12.00'	LT.	STRAIGHT	79.32'	-
J-6	Vertical	61+86.78	12.00'	LT.	61+19.69	12.00'	LT.	STRAIGHT	67.42'	Taper to 1" reveal per Std. C-10

*All Station & Offsets are at the face of curb.

SPLITTER ISLAND CURB LOCATIONS										
Curb ID	Type	Begin			End			Radius	Length	Remarks
		Station	Offset	Location	Station	Offset	Location			
Splitter Island Curbing										
B-1	Vertical	95+32.04	1.46'	LT.	95+31.97	1.52'	RT.	1.50'	4.40'	-
B-2	Vertical	95+32.04	1.46'	LT.	95+51.13	3.21'	LT.	STRAIGHT	19.22'	-
B-3	Vertical	95+51.13	3.21'	LT.	95+66.65	6.38'	LT.	81.50'	15.87'	-
B-4	Vertical	95+66.65	6.38'	LT.	95+70.52	3.84'	LT.	3.00'	5.28'	-
B-5	Vertical	95+70.52	3.84'	LT.	95+71.84	8.05'	RT.	STRAIGHT	11.97'	-
B-6	Vertical	95+71.84	8.05'	RT.	95+70.45	9.09'	RT.	1.00'	2.08'	-
B-7	Vertical	95+70.45	9.09'	RT.	95+48.78	3.51'	RT.	76.00'	22.45'	-
B-8	Vertical	95+48.78	3.51'	RT.	95+31.97	1.52'	RT.	STRAIGHT	16.88'	-
C-1	Vertical	40+99.66	1.02'	LT.	40+99.66	0.96'	RT.	1.00'	2.86'	-
C-2	Vertical	40+99.66	0.96'	RT.	40+73.26	4.56'	RT.	STRAIGHT	26.67'	-
C-3	Vertical	40+73.26	4.56'	RT.	40+71.25	5.09'	RT.	9.00'	2.04'	-
C-4	Vertical	40+71.25	5.09'	RT.	40+67.19	2.65'	RT.	3.00'	5.46'	-
C-5	Vertical	40+67.19	2.65'	RT.	40+65.94	7.76'	LT.	STRAIGHT	10.48'	-
C-6	Vertical	40+65.94	7.76'	LT.	40+67.33	8.80'	LT.	1.00'	2.09'	-
C-7	Vertical	40+67.33	8.80'	LT.	40+84.73	3.66'	LT.	76.00'	18.15'	-
C-8	Vertical	40+84.73	3.66'	LT.	40+99.66	1.02'	LT.	STRAIGHT	15.16'	-
D-1	Vertical	97+42.46	1.52'	RT.	97+42.43	1.46'	RT.	1.50'	4.35'	-
D-2	Vertical	97+42.43	1.46'	RT.	97+20.17	3.81'	RT.	STRAIGHT	22.35'	-
D-3	Vertical	97+20.17	3.81'	RT.	97+08.85	6.34'	RT.	81.00'	11.57'	-
D-4	Vertical	97+08.85	6.34'	RT.	97+04.95	3.86'	RT.	3.00'	5.27'	-
D-5	Vertical	97+04.95	3.86'	RT.	97+03.48	7.97'	LT.	STRAIGHT	11.91'	-
D-6	Vertical	97+03.48	7.97'	LT.	97+04.84	9.01'	LT.	1.00'	2.08'	-
D-7	Vertical	97+04.84	9.01'	LT.	97+22.58	4.25'	LT.	76.00'	18.68'	-
D-8	Vertical	97+22.58	4.25'	LT.	97+42.46	1.52'	LT.	STRAIGHT	20.10'	-
E-1	Vertical	62+51.76	2.07'	RT.	62+51.85	1.92'	LT.	2.00'	5.91'	-
E-2	Vertical	62+51.85	1.92'	LT.	62+70.48	3.24'	LT.	N/A	18.68'	-
E-3	Vertical	62+70.48	3.24'	LT.	62+88.46	6.57'	LT.	81.50'	18.33'	-
E-4	Vertical	62+88.46	6.57'	LT.	62+92.32	4.03'	LT.	3.00'	5.28'	-
E-5	Vertical	62+92.32	4.03'	LT.	62+93.60	7.76'	RT.	STRAIGHT	11.86'	-
E-6	Vertical	62+93.60	7.76'	RT.	62+92.24	8.80'	RT.	1.00'	2.05'	-
E-7	Vertical	62+92.24	8.80'	RT.	62+78.91	5.33'	RT.	60.00'	13.81'	-
E-8	Vertical	62+78.91	5.33'	RT.	62+51.76	2.07'	RT.	STRAIGHT	27.34'	-

*All Station & Offsets are at the face of curb.

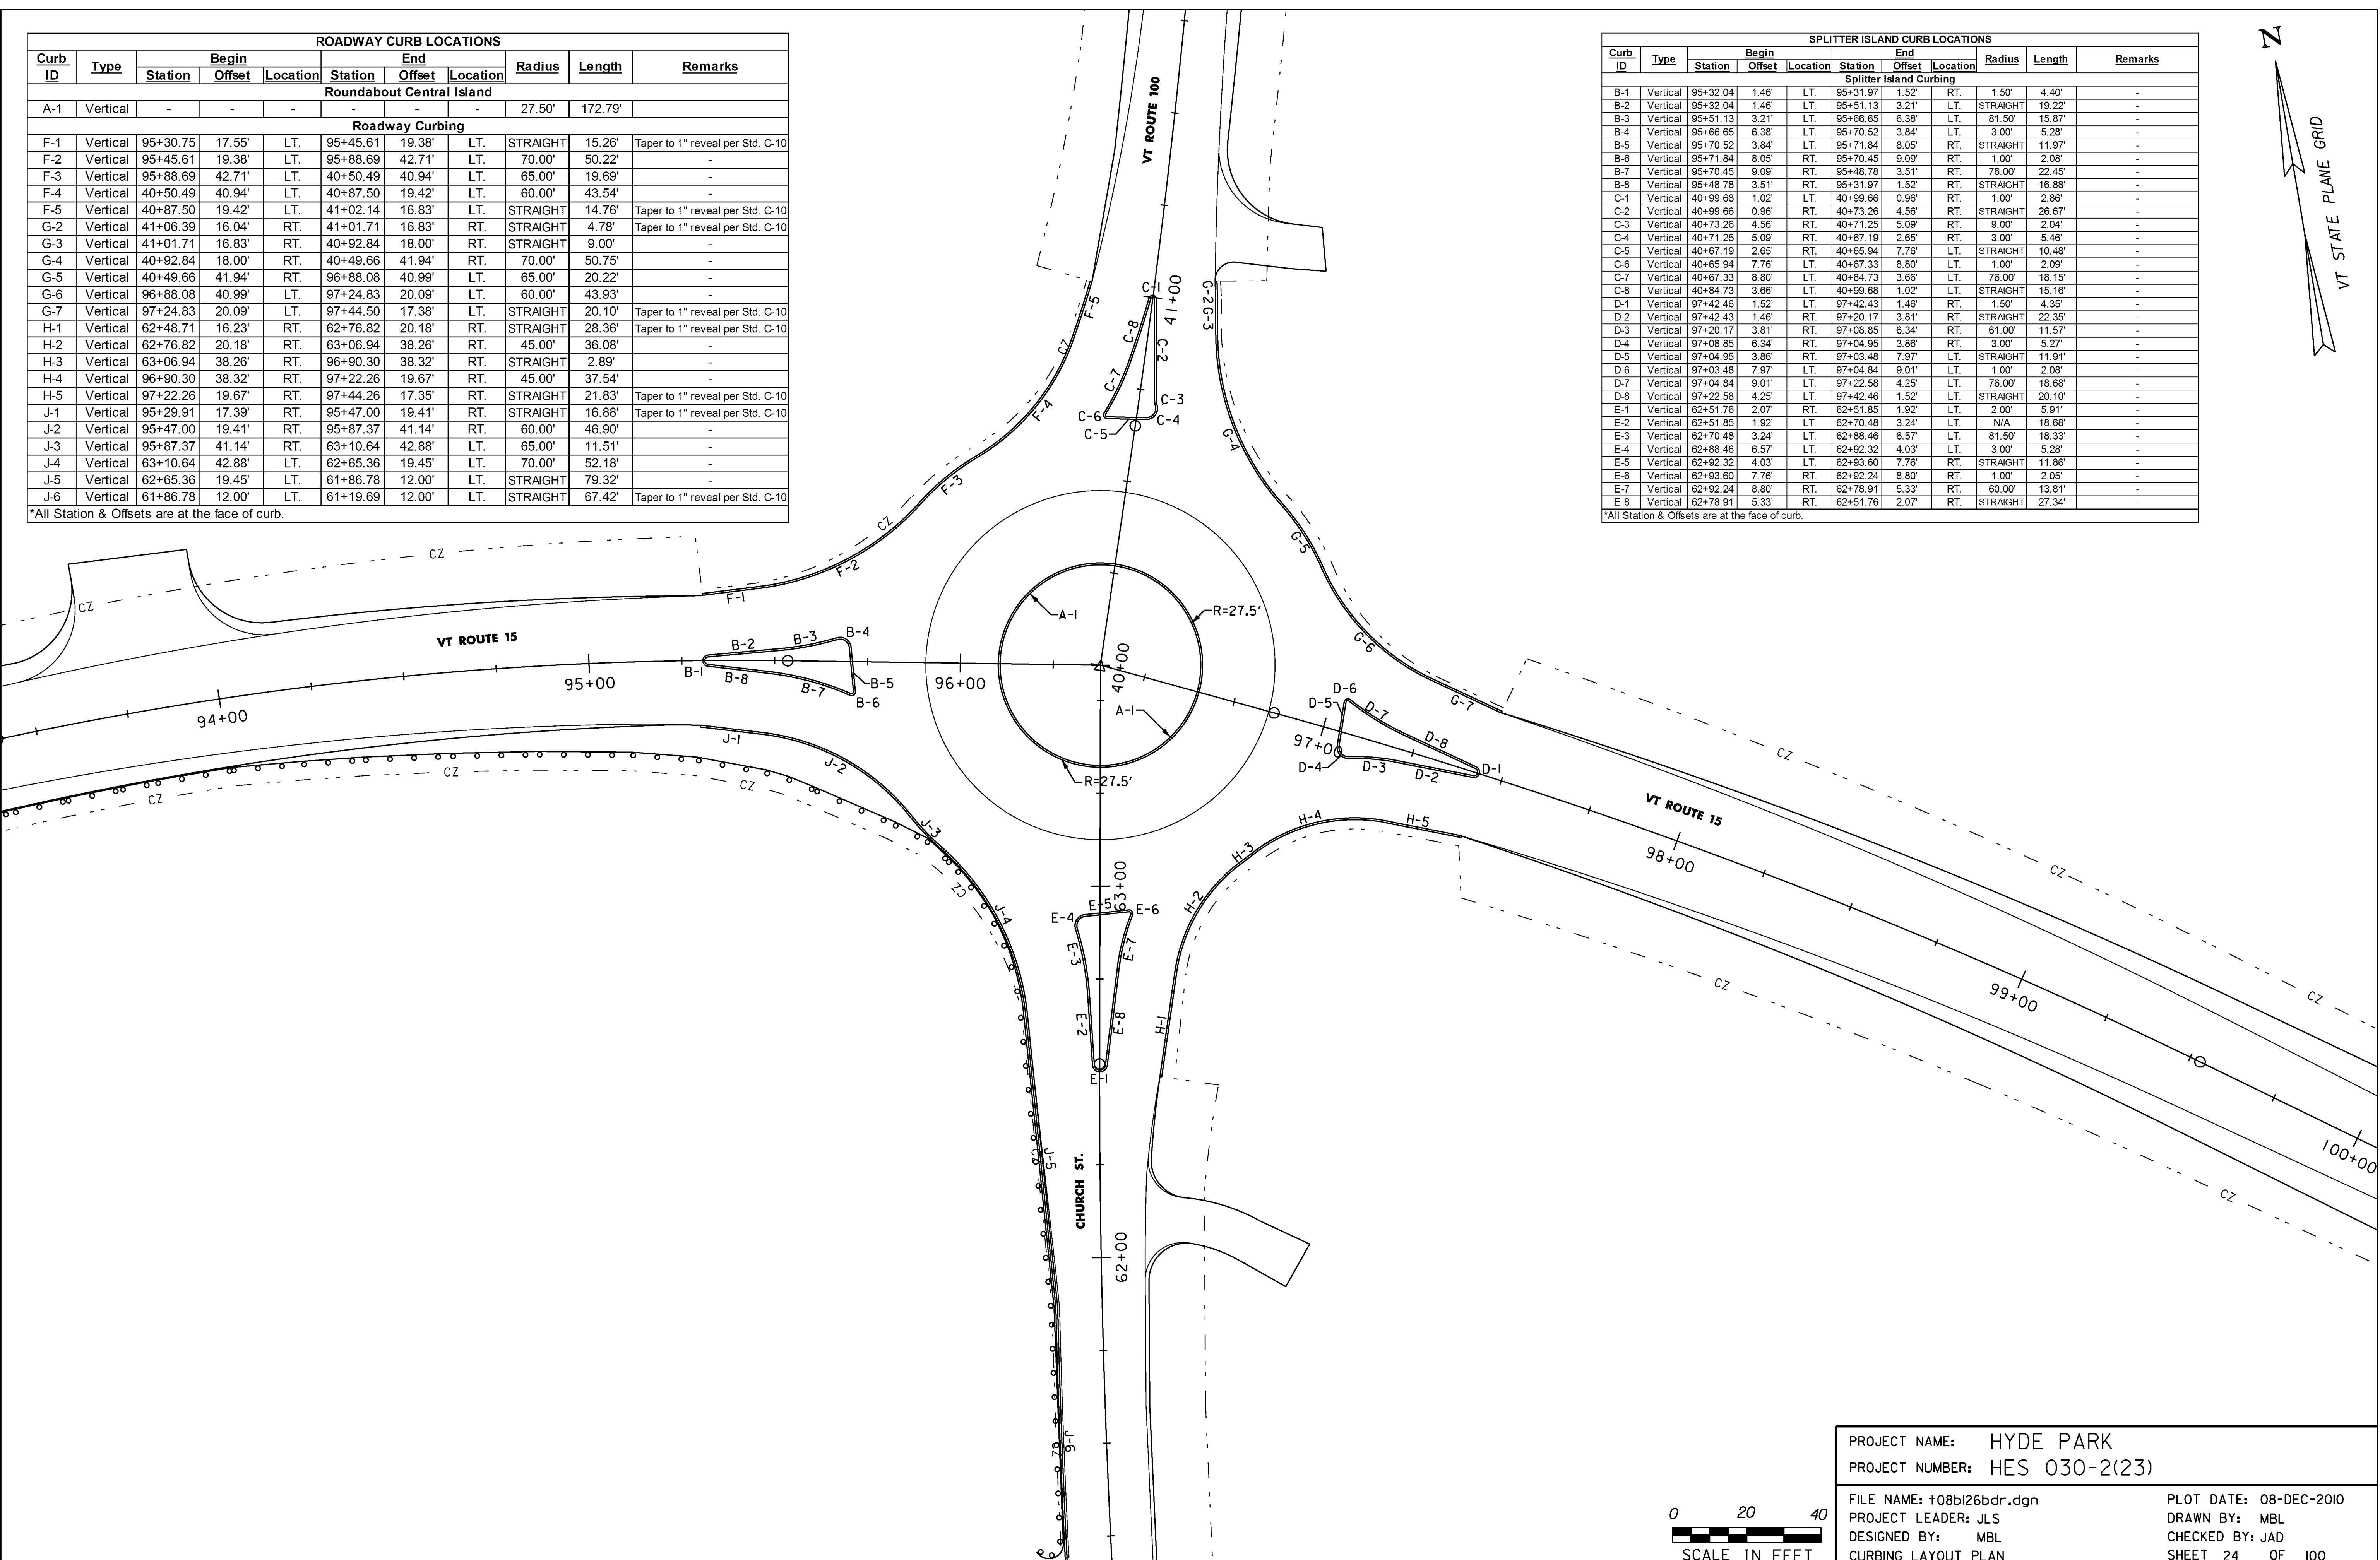

PROJECT NAME: HYDE PARK
 PROJECT NUMBER: HES 030-2(23)
 FILE NAME: +08b126bdr.dgn
 PROJECT LEADER: JLS
 DESIGNED BY: MBL
 CURBING LAYOUT PLAN

PLOT DATE: 08-DEC-2010
 DRAWN BY: MBL
 CHECKED BY: JAD
 SHEET 24 OF 100

