
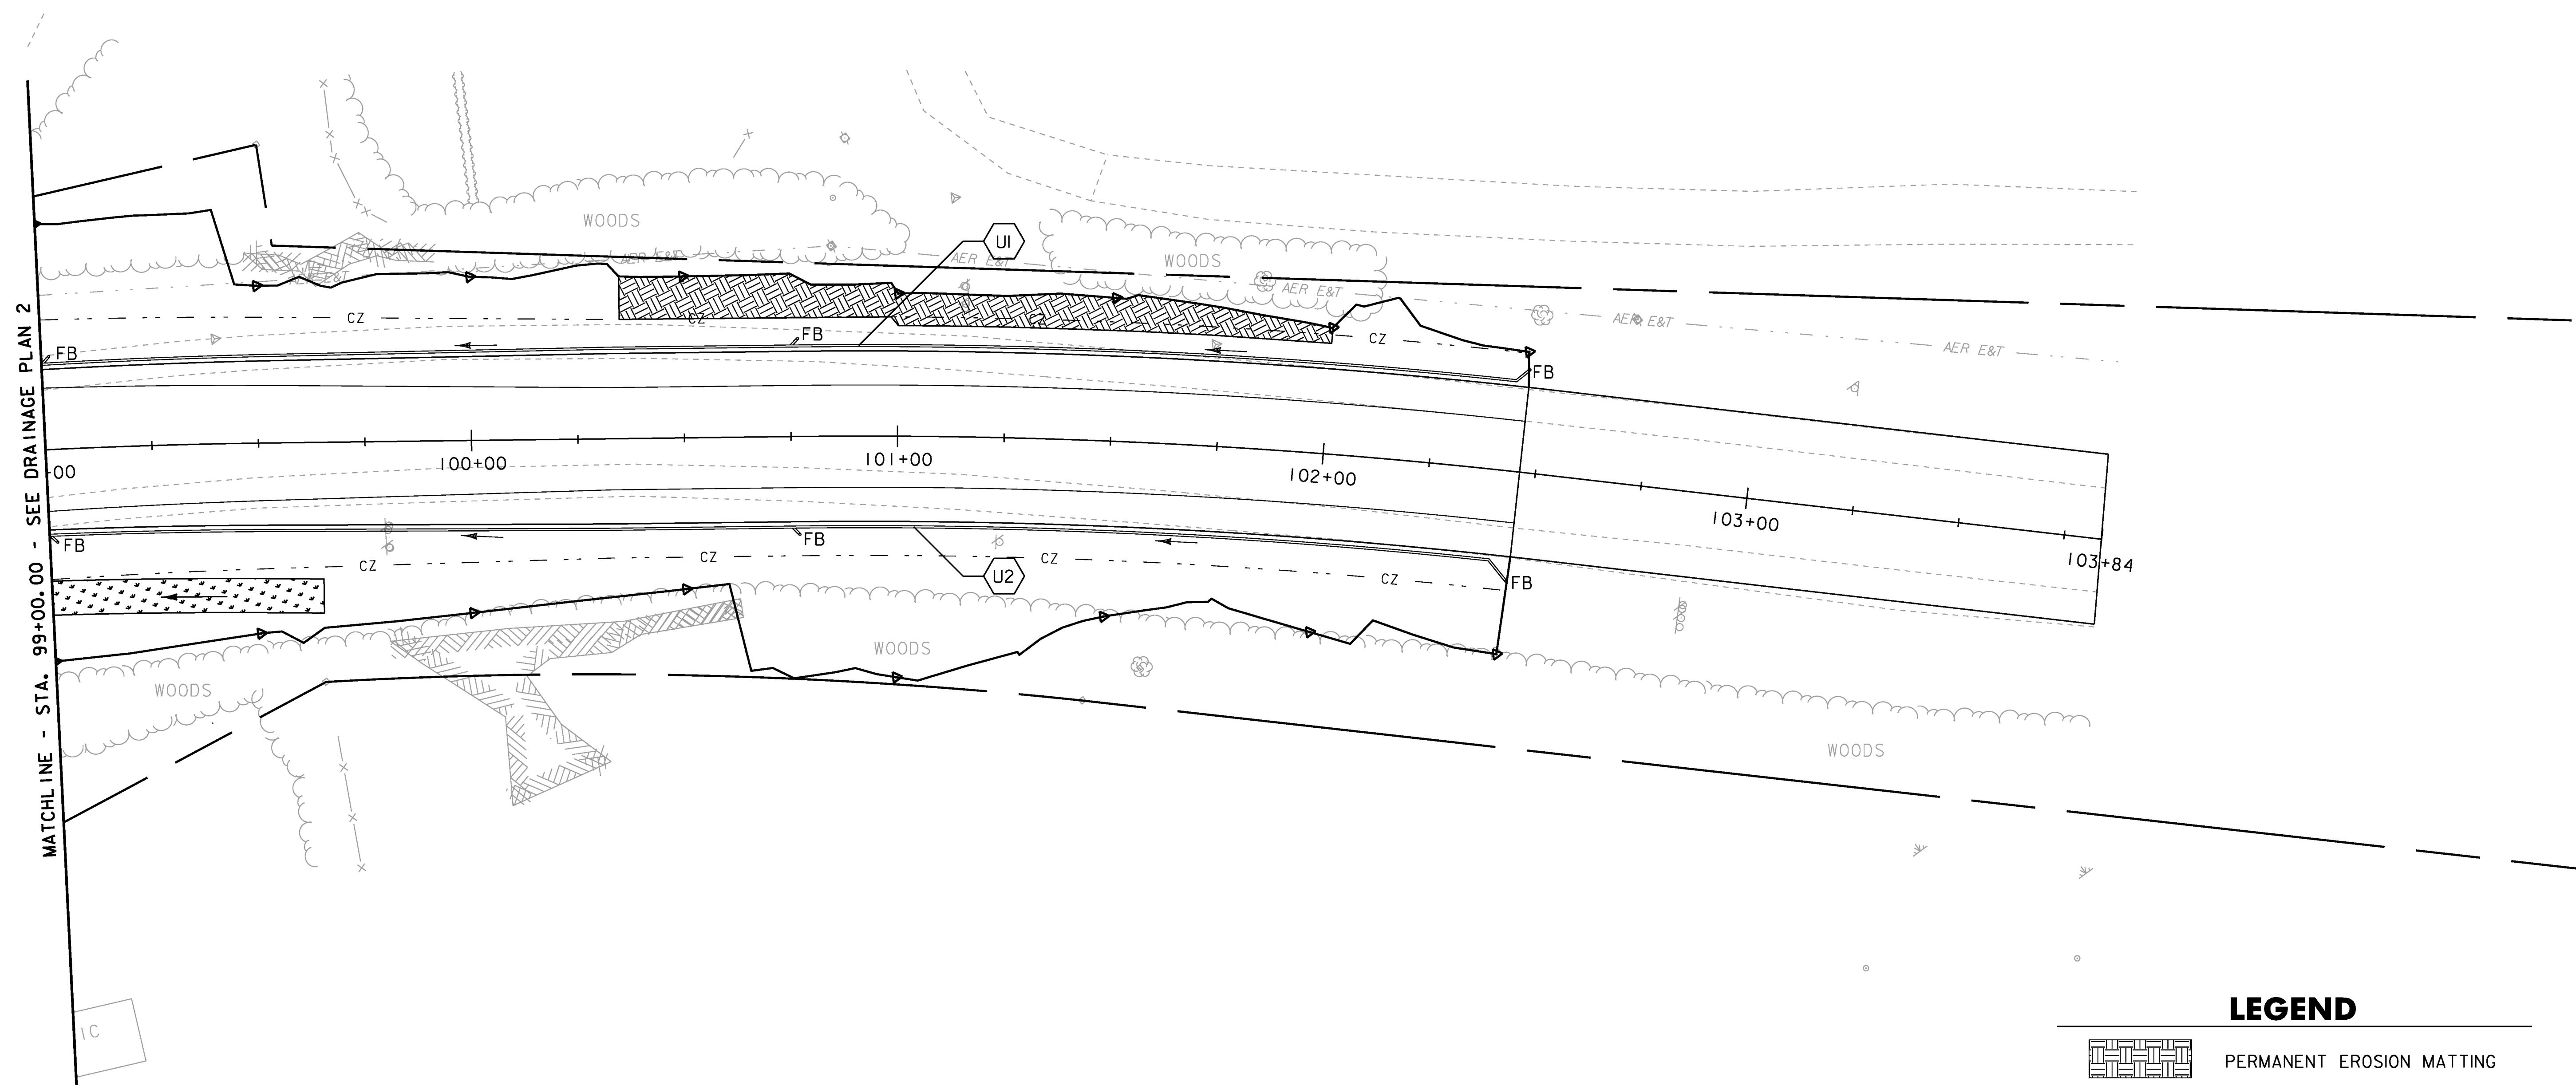




PERMANENT EROSION MATTING
STA. 100+35.0 - STA. 102+00.0, LT.

U1 SEE CONSTRUCTION NOTE ON DRAINAGE PLAN 6


U2 SEE CONSTRUCTION NOTE ON DRAINAGE PLAN 6

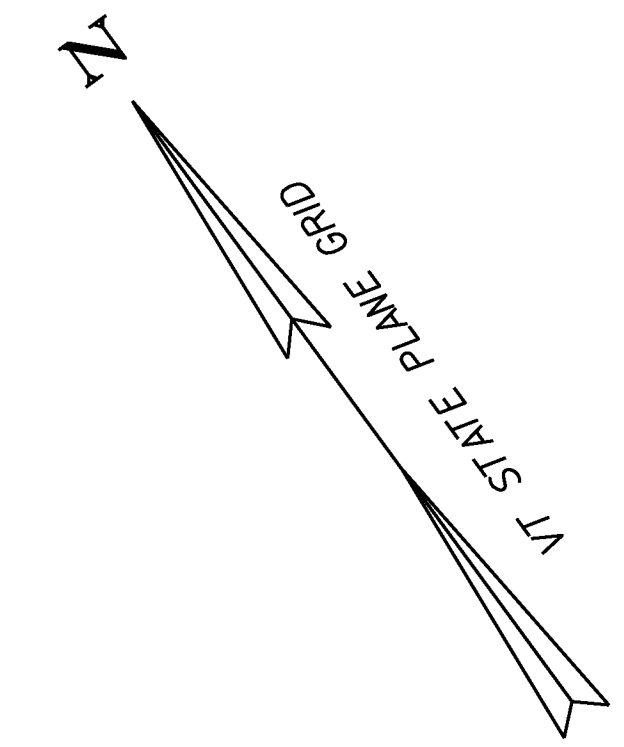

LEGEND

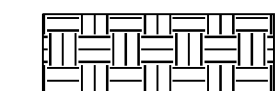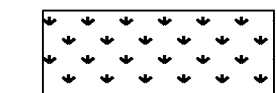-  PERMANENT EROSION MATTING
-  GRASS LINED CHANNEL

PROJECT NAME: HYDE PARK	PLOT DATE: 08-DEC-2010
PROJECT NUMBER: HES 030-2(23)	DRAWN BY: MBL
FILE NAME: +08b126bdr.dgn	CHECKED BY: JAD
DESIGNED BY: MBL	SHEET 27 OF 100
DRAINAGE PLAN 3	

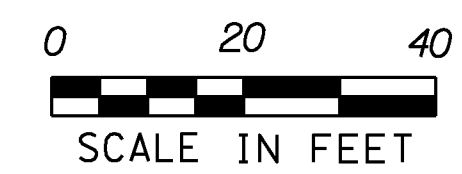

FUTURE SEPTIC SYSTEM