



P6

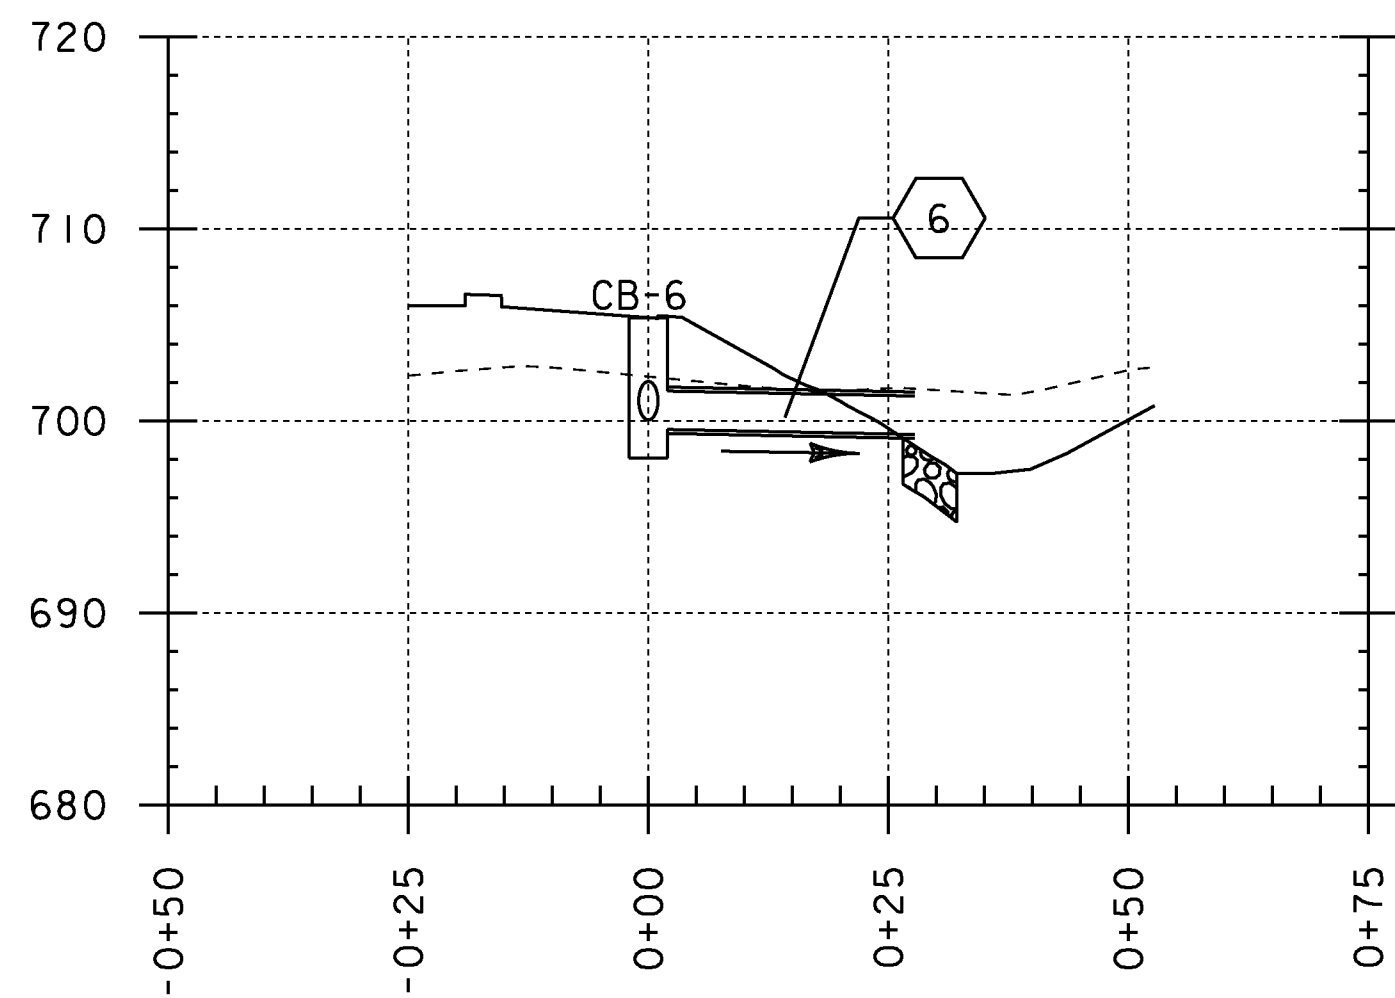


6
 SLOPE = 1.00%
 NEW PIPE
 TYPE: OPTION PIPE
 LENGTH = 27.72'
 DIAMETER = 24.00"
 INV. IN = 699.55'
 INV. OUT = 699.29'
CB-6
 GRATE: TYPE D
 RIM EL = 705.37'
 DEPTH = 7.32'

P7

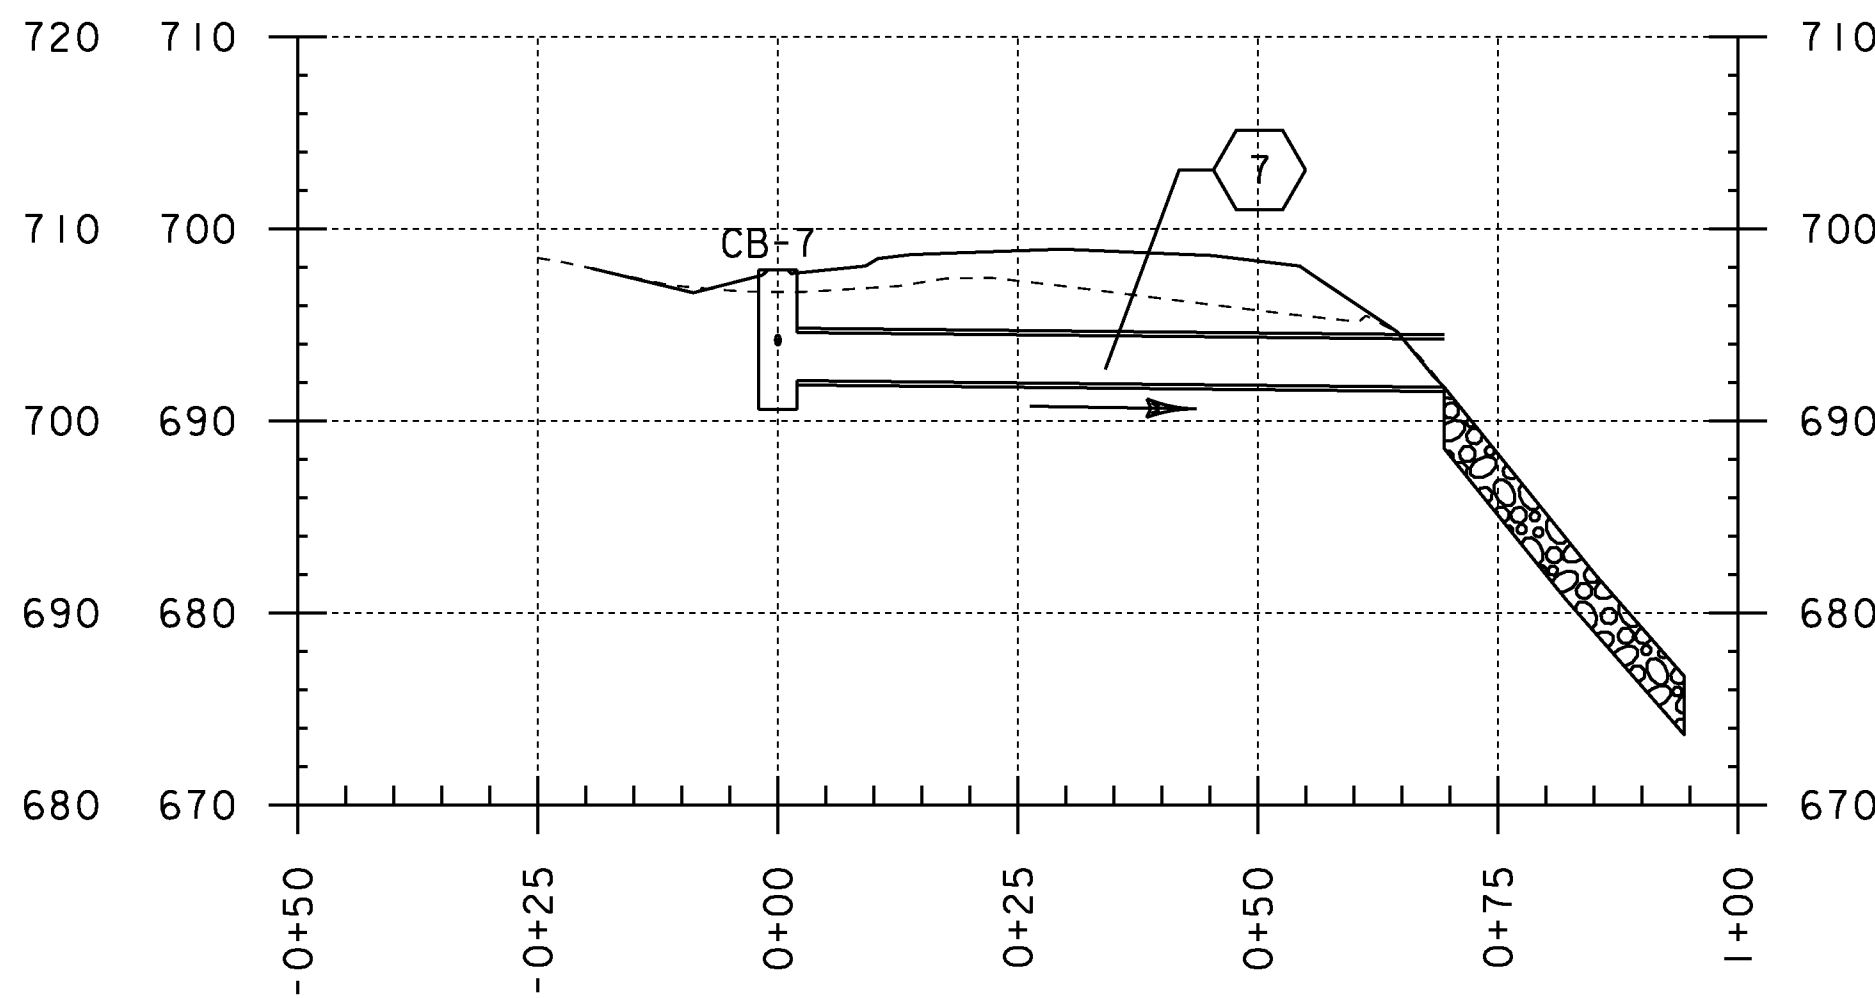


7
 SLOPE = 0.50%
 NEW PIPE
 TYPE: OPTION PIPE
 LENGTH = 69.41'
 DIAMETER = 30.00"
 INV. IN = 692.10'
 INV. OUT = 691.75'
CB-7
 GRATE: TYPE A
 RIM EL = 697.85'
 DEPTH = 7.25'

P8

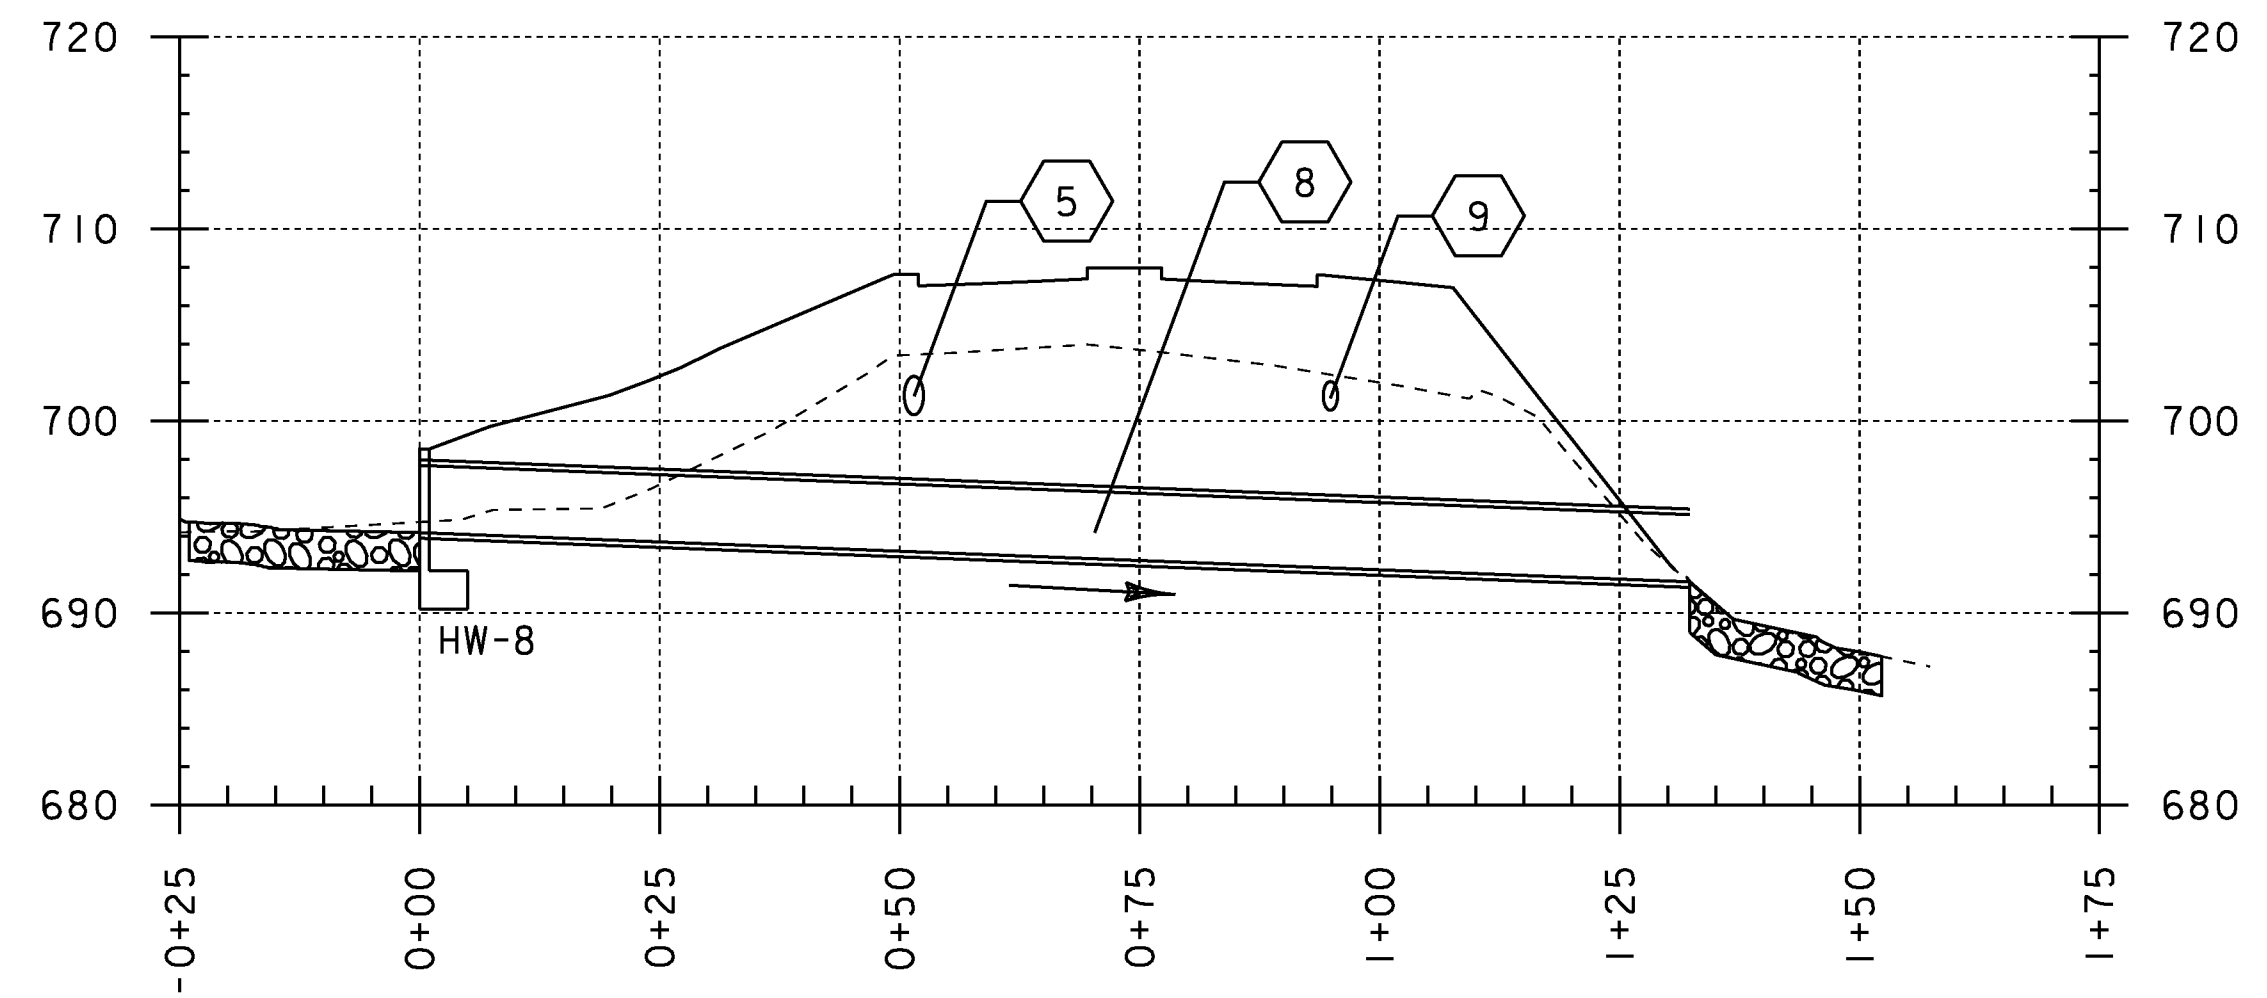


8
 SLOPE = 1.94%
 NEW PIPE
 TYPE: OPTION PIPE
 LENGTH = 132.35'
 DIAMETER = 42.00"
 INV. IN = 694.18'
 INV. OUT = 691.61'
CB-8
 GRATE: TYPE D
 RIM EL = 707.85'
 DEPTH = 8.67'

P9

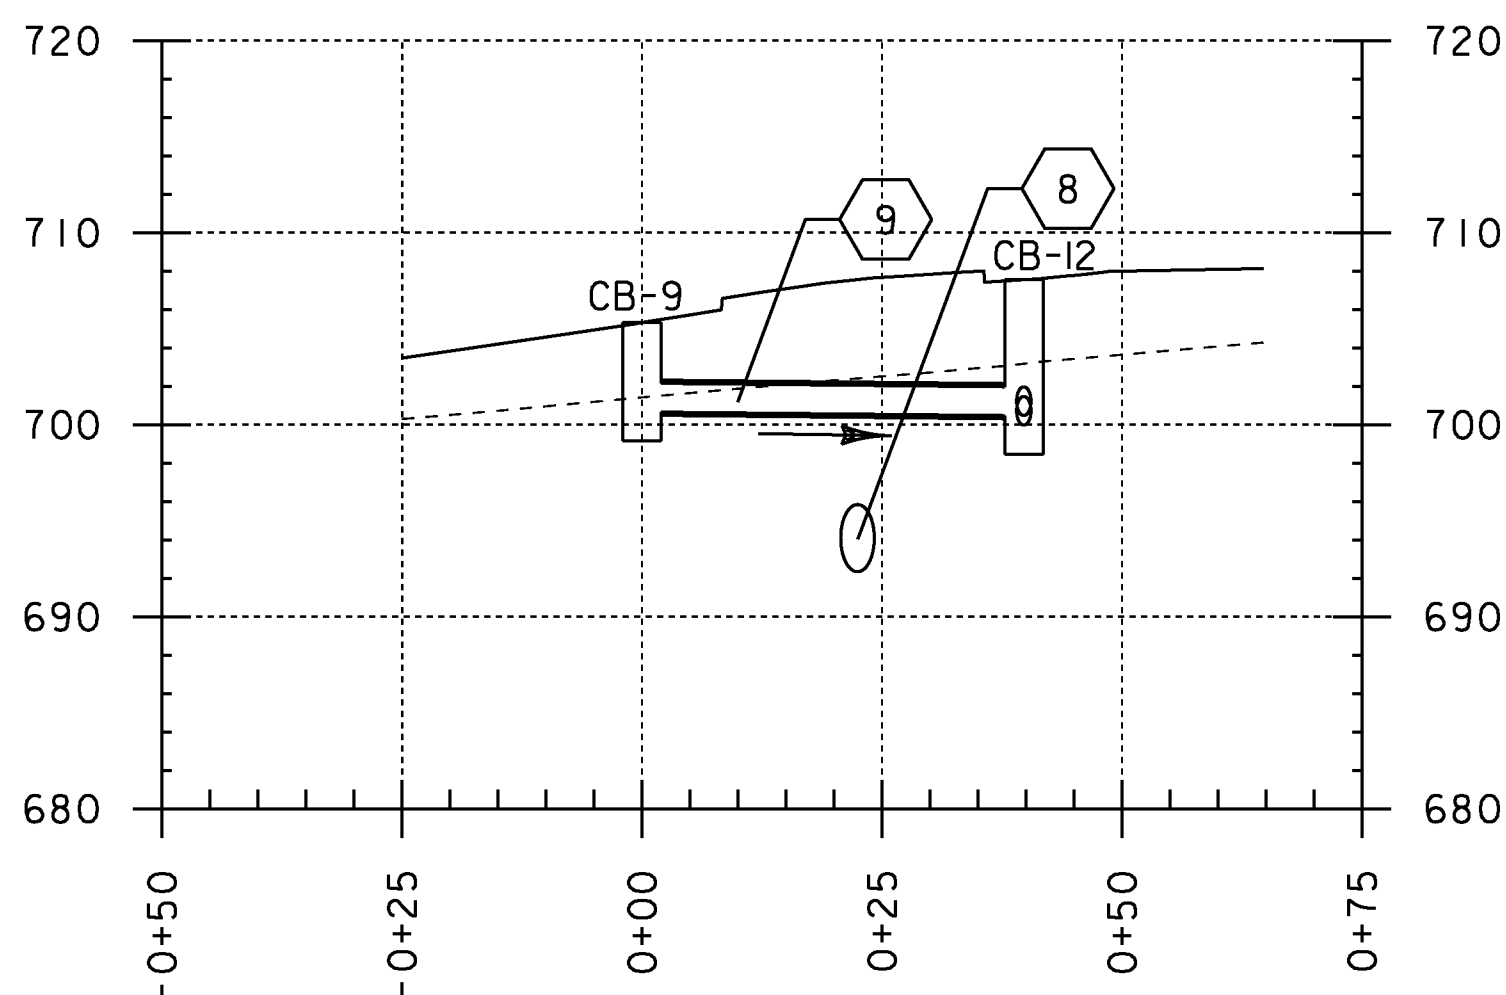


9
 SLOPE = 0.50%
 NEW PIPE
 TYPE: OPTION PIPE
 LENGTH = 39.76'
 DIAMETER = 18.00"
 INV. IN = 700.65'
 INV. OUT = 700.47'
CB-9
 GRATE: TYPE D
 RIM EL = 705.32'
 DEPTH = 6.17'

P10

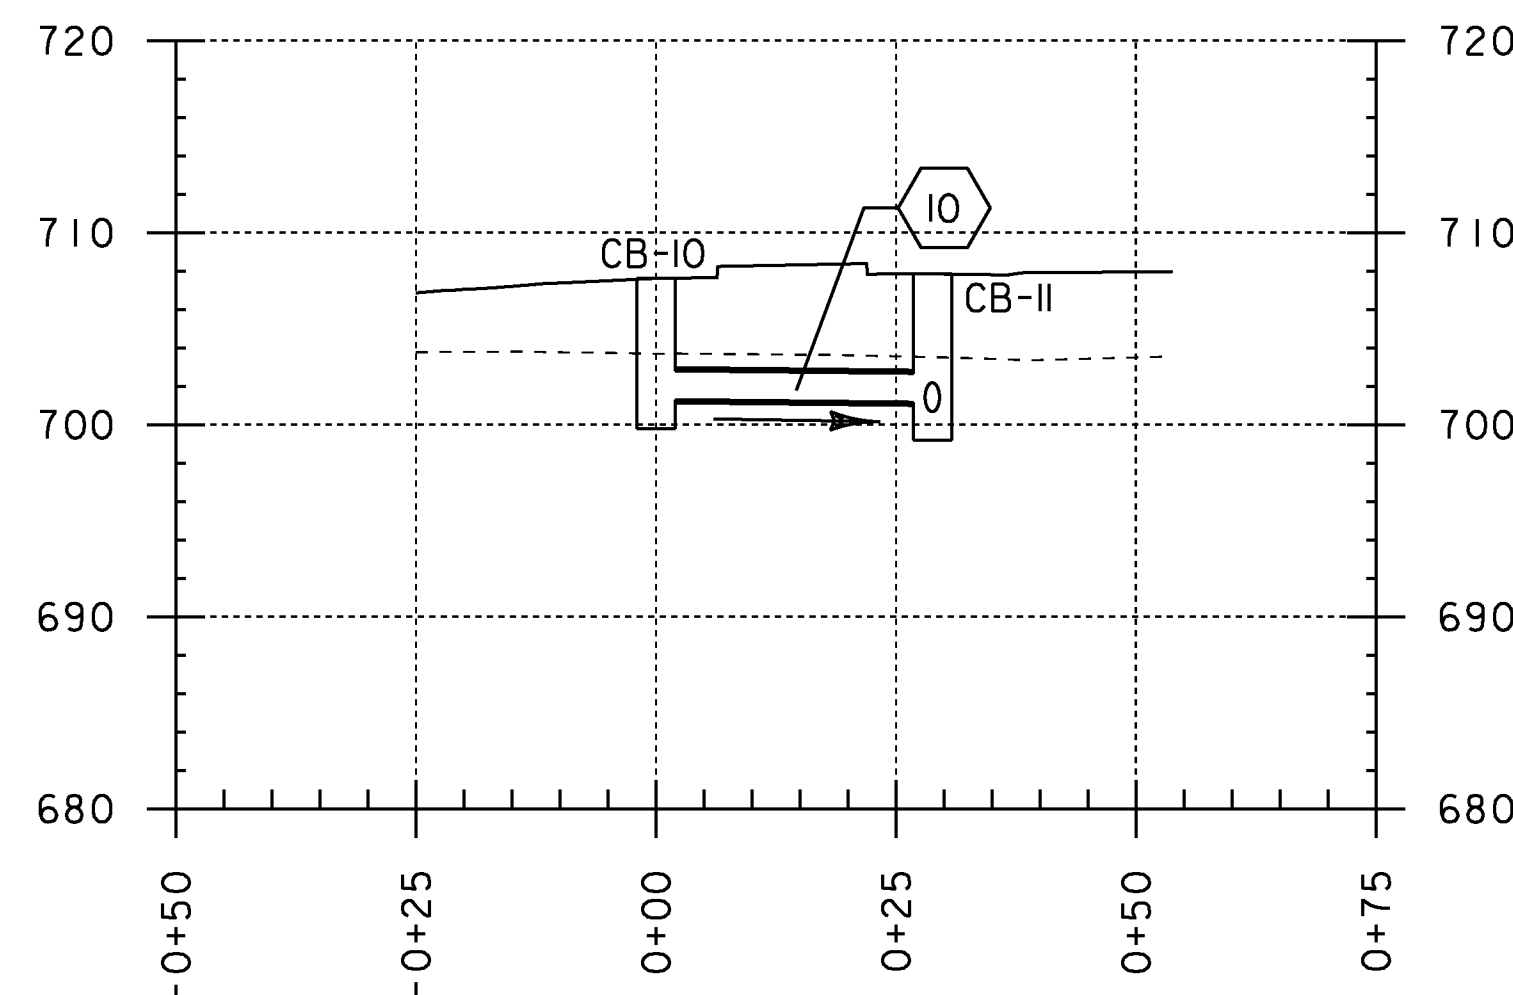


10
 SLOPE = 0.50%
 NEW PIPE
 TYPE: OPTION PIPE
 LENGTH = 28.79'
 DIAMETER = 18.00"
 INV. IN = 701.30'
 INV. OUT = 701.17'
CB-10
 GRATE: TYPE D
 RIM EL = 707.61'
 DEPTH = 7.81'

P11

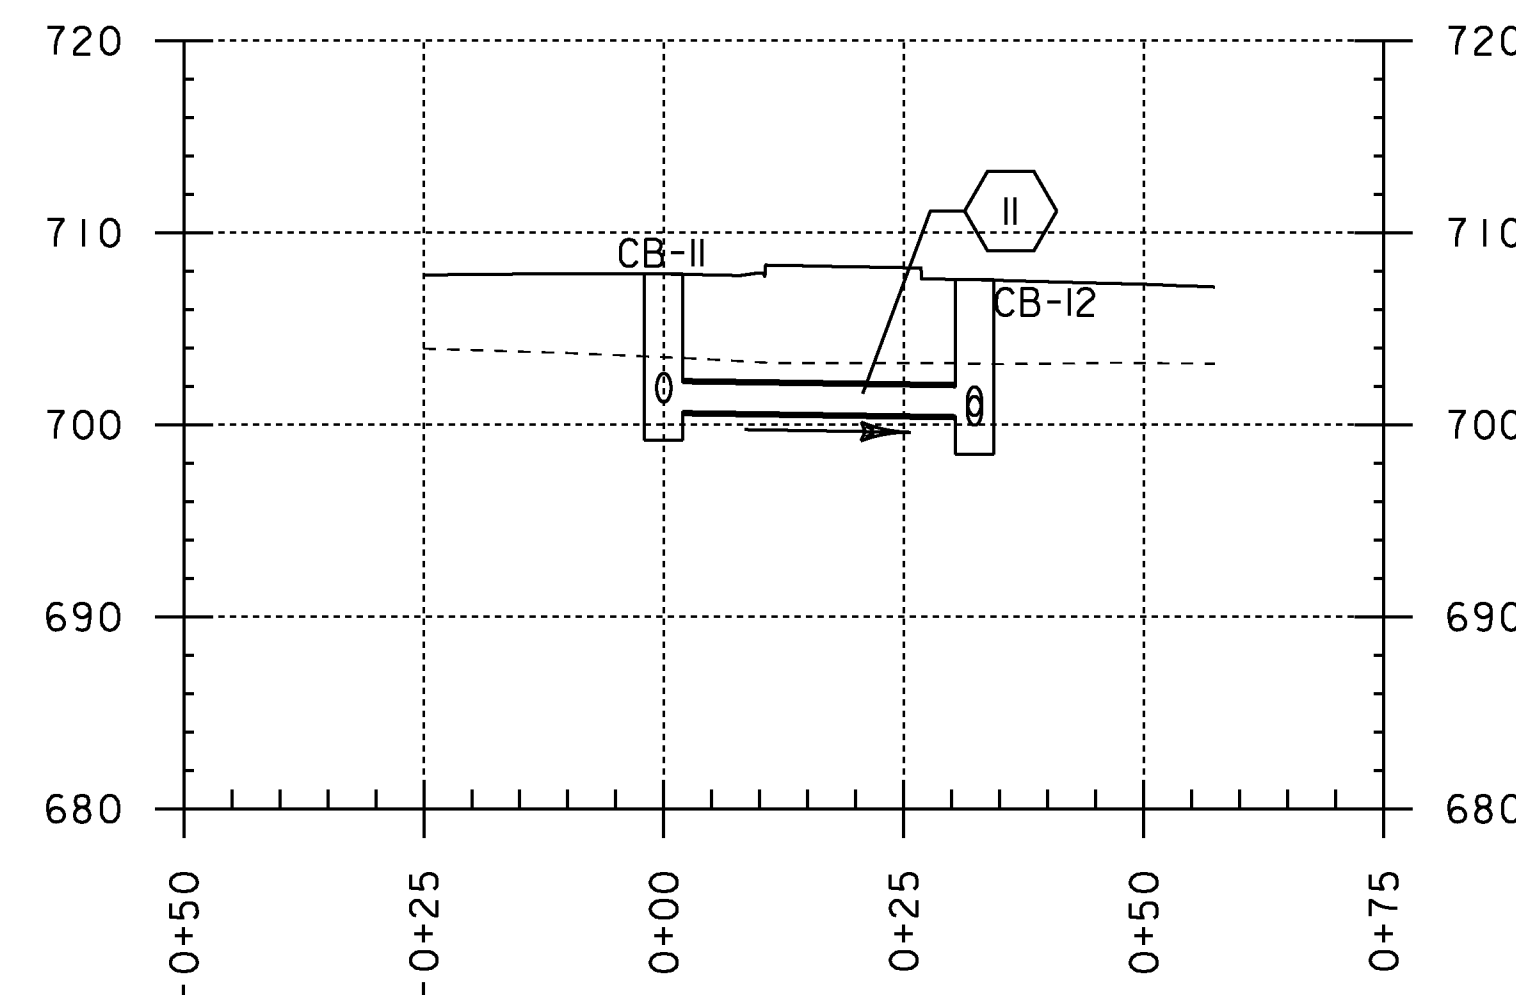

11
 SLOPE = 0.73%
 NEW PIPE
 TYPE: OPTION PIPE
 LENGTH = 32.37'
 DIAMETER = 18.00"
 INV. IN = 700.68'
 INV. OUT = 700.47'
CB-11
 GRATE: TYPE D
 RIM EL = 707.85'
 DEPTH = 8.67'

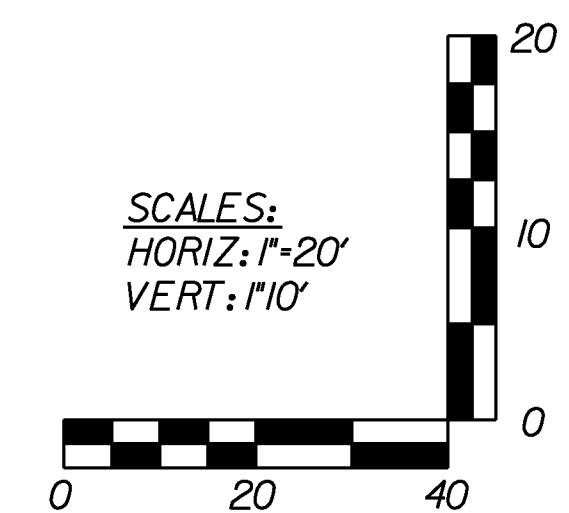

PROJECT NAME:	HYDE PARK
PROJECT NUMBER:	HES 030-2(23)
FILE NAME: +08b126pro-drn.dgn	PLOT DATE: 08-DEC-2010
PROJECT LEADER: JLS	DRAWN BY: MBL
DESIGNED BY: MBL	CHECKED BY: JAD
DRAINAGE PROFILE 2	SHEET 32 OF 100