


BOOTHBAY SILT LOAM
 8% TO 15% SLOPES
 K = 0.32
 HYDRO. GROUP = C

PERU VERY STONY FINE SANDY LOAM
 8% TO 15% SLOPES
 K = 0.24
 HYDRO. GROUP = C

ADAMS LOAMY FINE SAND
 8% TO 15% SLOPES
 K = 0.17
 HYDRO. GROUP = A

MATCHLINE - STA. 41+75.00 - SEE EPSC EXISTING PLAN 2

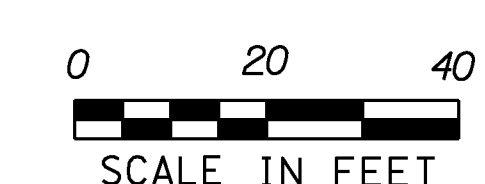

PROJECT NAME:	HYDE PARK	FILE NAME:	+08b126bdr.dgn	PLOT DATE:	08-DEC-2010
PROJECT NUMBER:	HES 030-2(23)	PROJECT LEADER:	JLS	DRAWN BY:	MBL
		DESIGNED BY:	MBL	CHECKED BY:	JAD
		EPSC EXISTING CONDITIONS SITE PLAN 4		SHEET 54	OF 100