



MATCHLINE - STA. 61+75.00 - SEE EPSC FINAL CONDITIONS PLAN 2

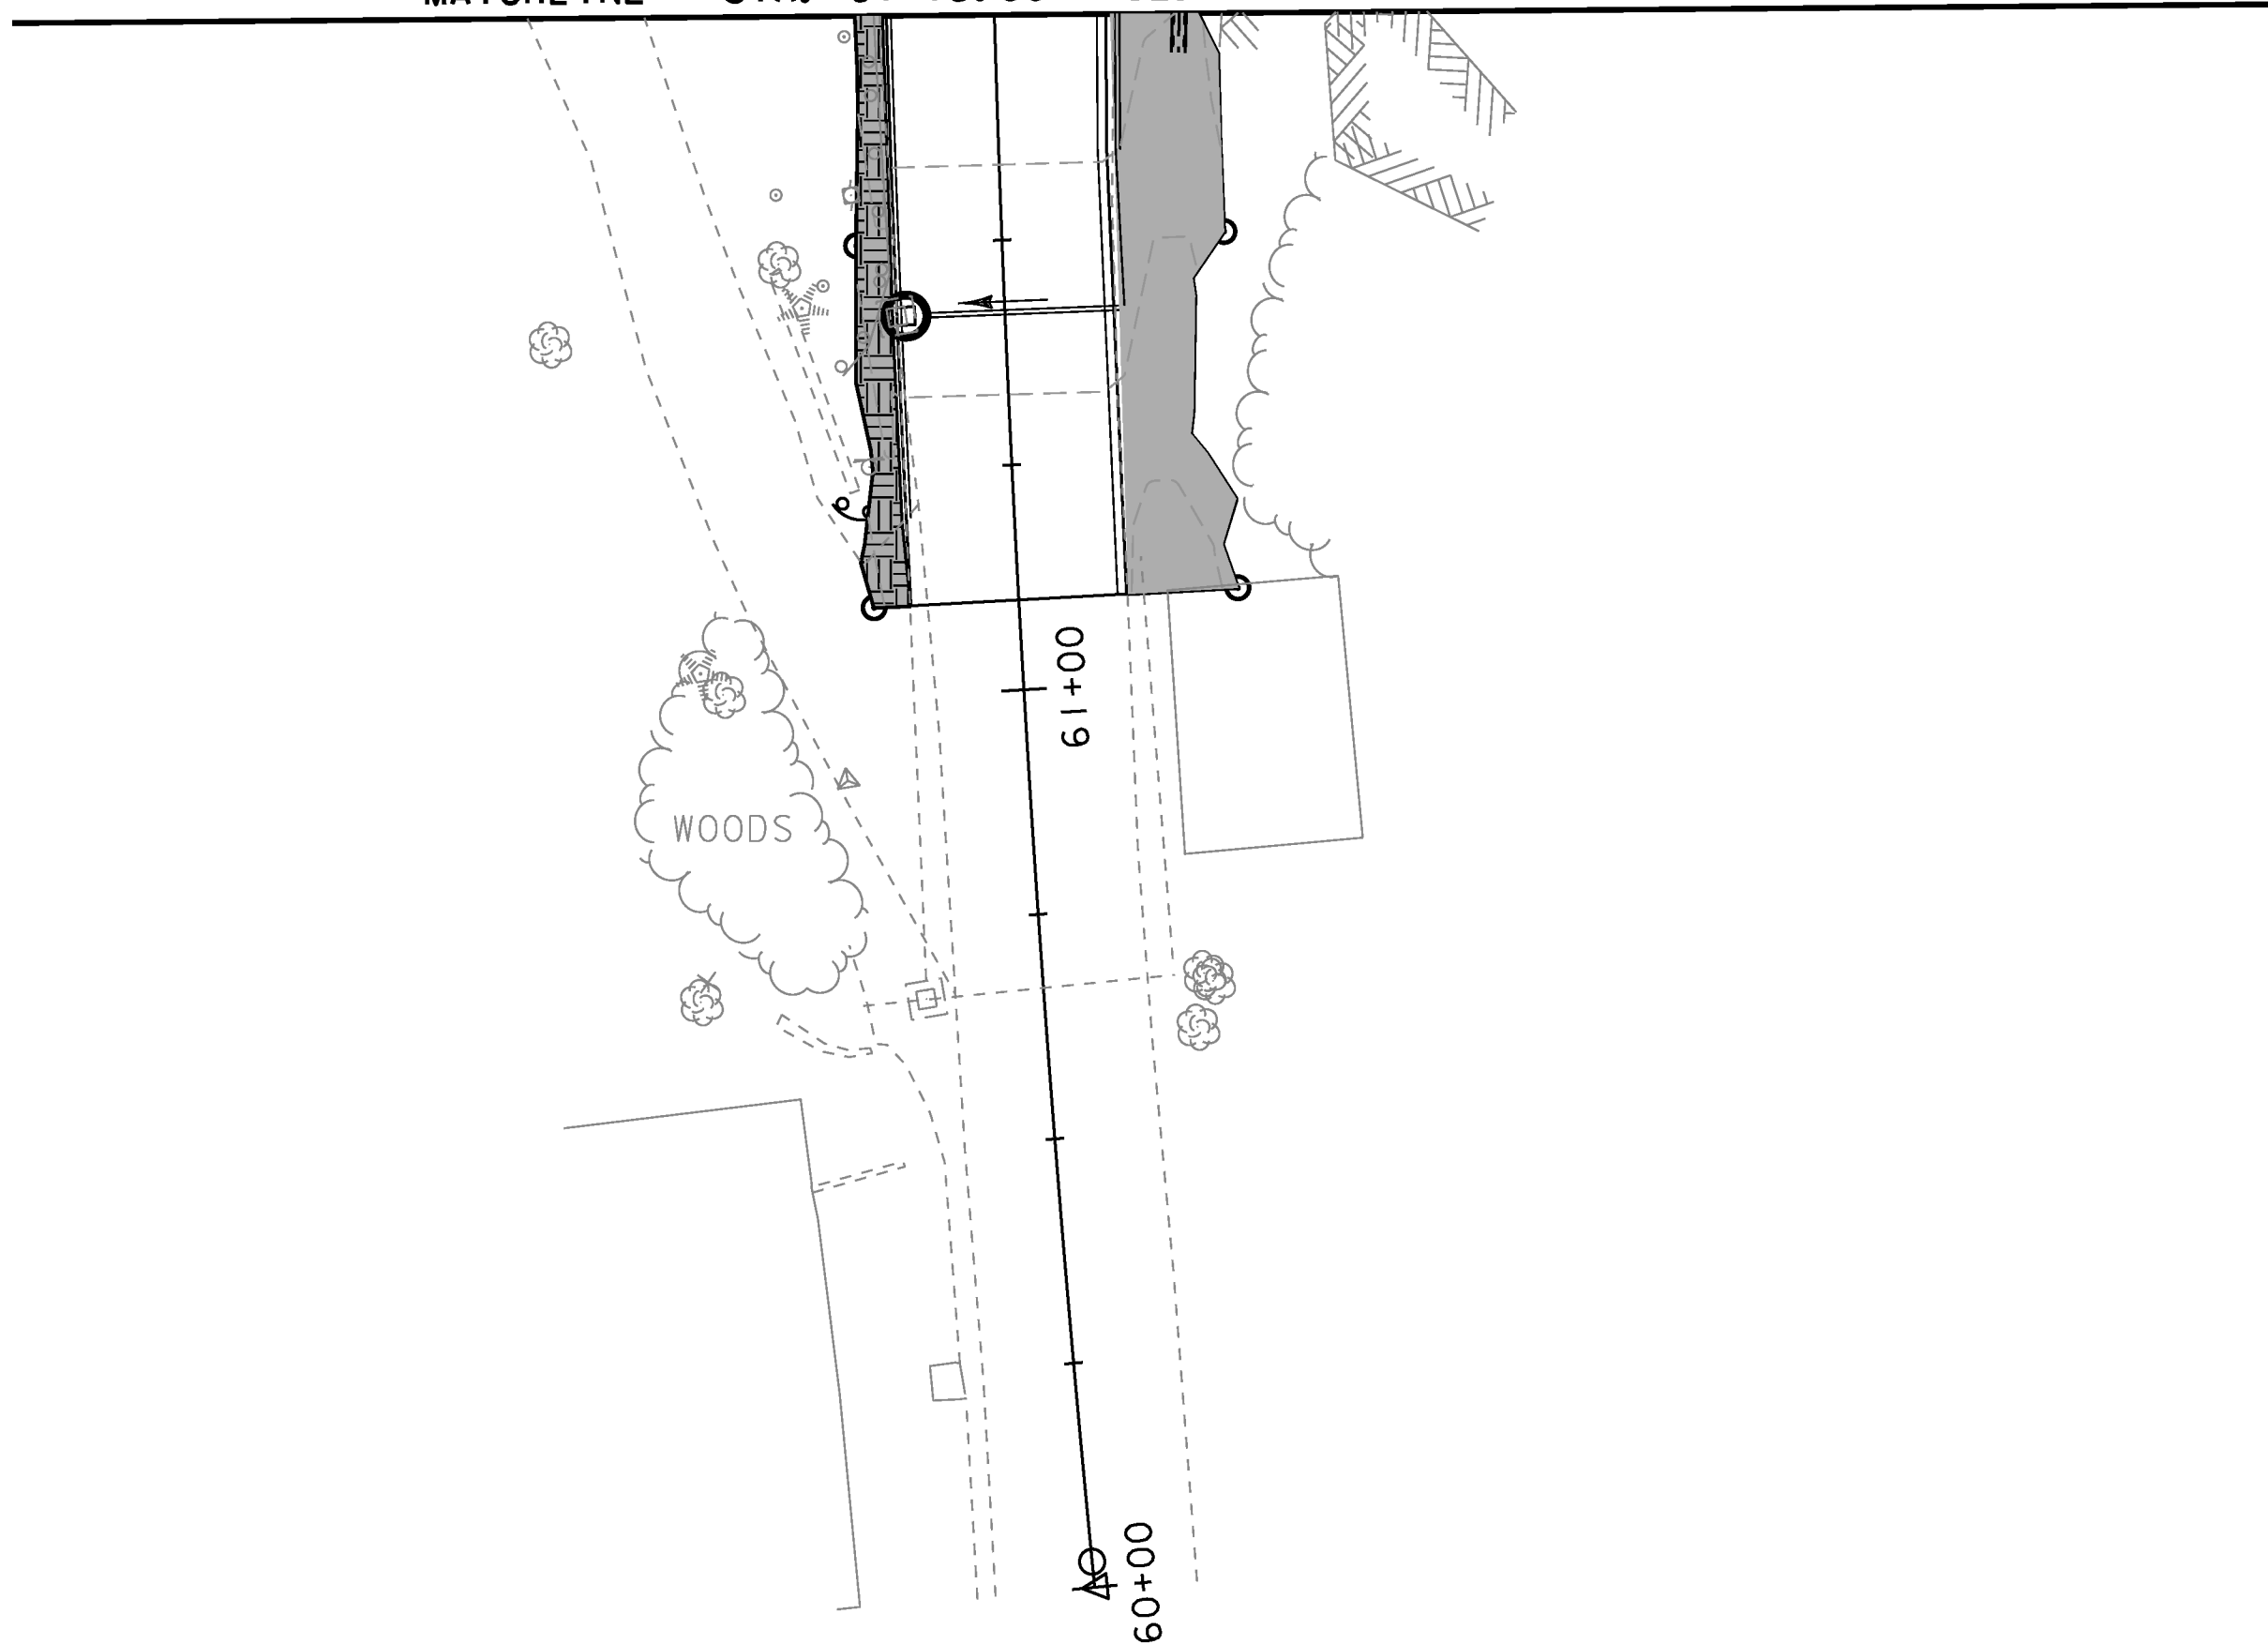

EPSC LEGEND

- AER E&T — AERIAL ELECTRIC & TELEPHONE
- Δ ○ — LIMITS OF SOIL DISTURBANCE
- DISTURBED AREAS REQUIRING RE-VEGETATION
- ▨ PERMANENT EROSION MATTING

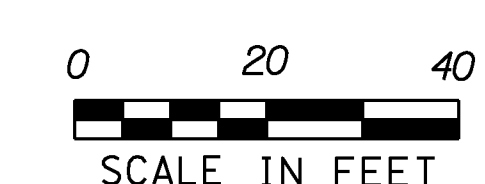

PROJECT NAME: HYDE PARK	PLLOT DATE: 08-DEC-2010
PROJECT NUMBER: HES 030-2(23)	DRAWN BY: MBL
FILE NAME: +08b126bdr.dgn	CHECKED BY: JAD
DESIGNED BY: MBL	SHEET 65 OF 100
EPSC FINAL CONDITIONS SITE PLAN 5	