



91+50

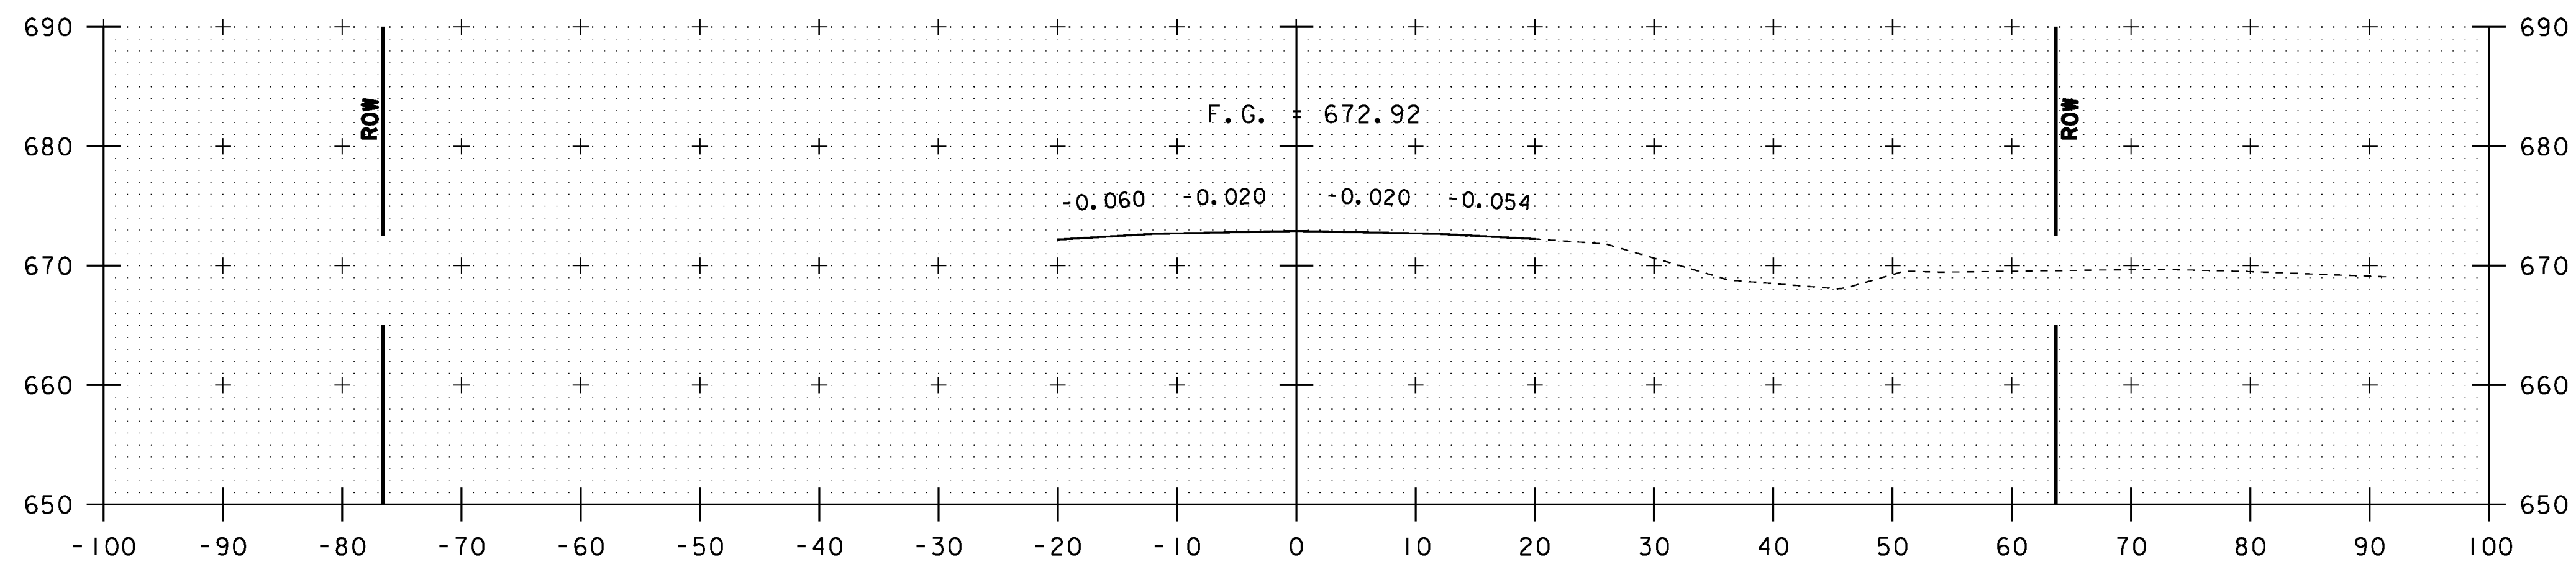

91+14.77

BEGIN APPROACH
MATCH EXISTING

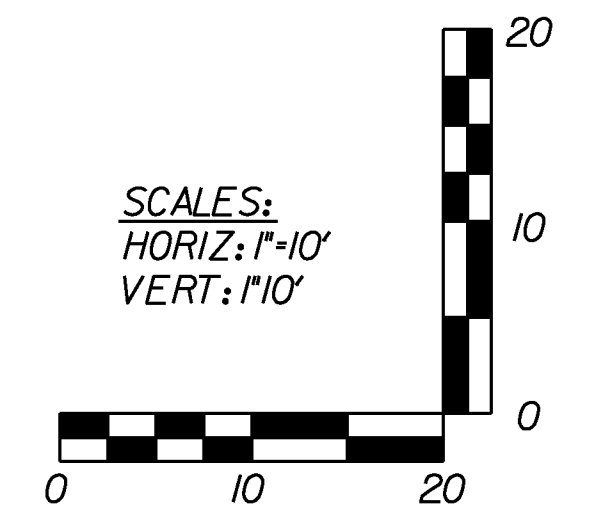

VT ROUTE 15	
STA. 91+14.77 TO STA. 91+50	
PROJECT NAME:	HYDE PARK
PROJECT NUMBER:	HES 030-2(23)
FILE NAME:	+08b126xs.dgn
PROJECT LEADER:	JLS
DESIGNED BY:	MBL
CROSS SECTION SHEET	1
PLOT DATE:	08-DEC-2010
DRAWN BY:	MBL
CHECKED BY:	JAD
SHEET	78 OF 100