



93+00

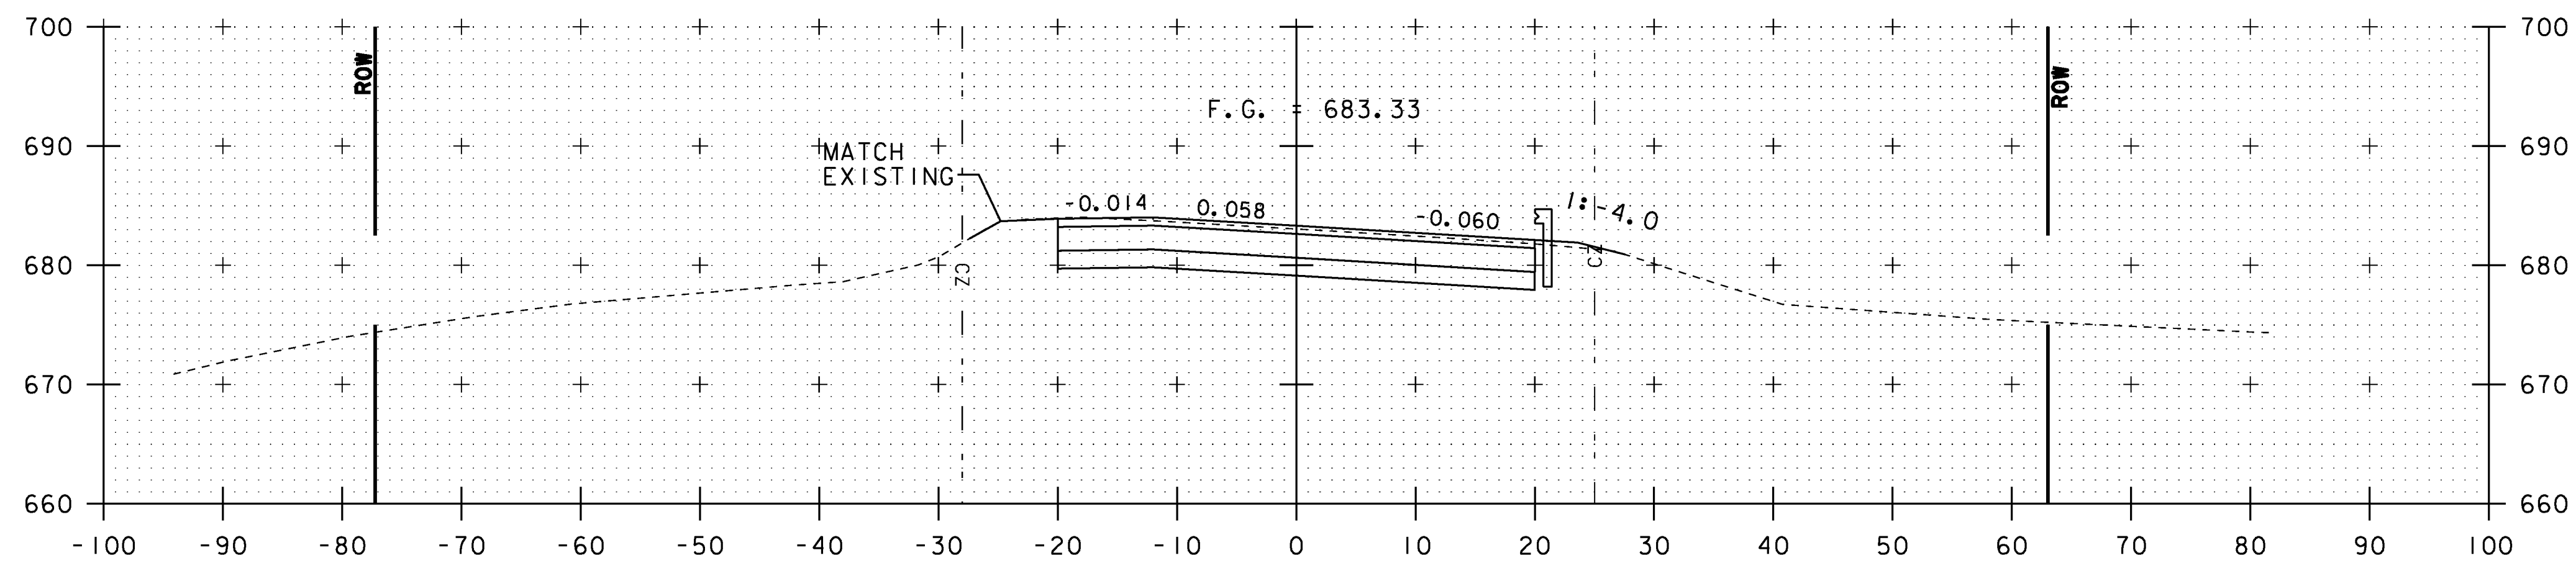

92+52.27

END APPROACH
BEGIN PROJECT
HES 030-2 (23)

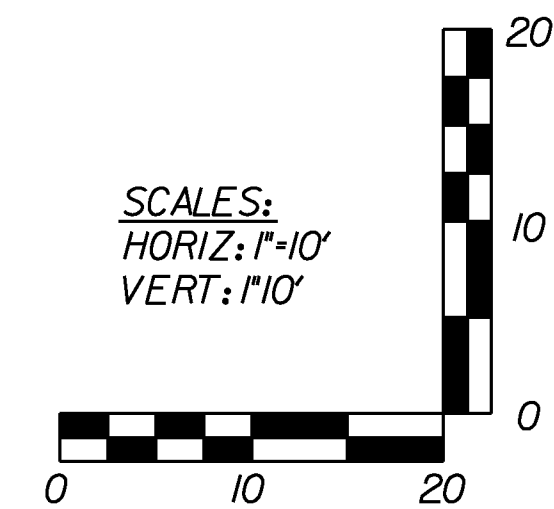

VT ROUTE 15	
STA. 92+52.27 TO STA. 93+00	
PROJECT NAME:	HYDE PARK
PROJECT NUMBER:	HES 030-2(23)
FILE NAME: +08b126xs.dgn	PLOT DATE: 08-DEC-2010
PROJECT LEADER: JLS	DRAWN BY: MBL
DESIGNED BY: MBL	CHECKED BY: JAD
CROSS SECTION SHEET 3	SHEET 80 OF 100