




93+82
GRAVEL DRIVE, LT.

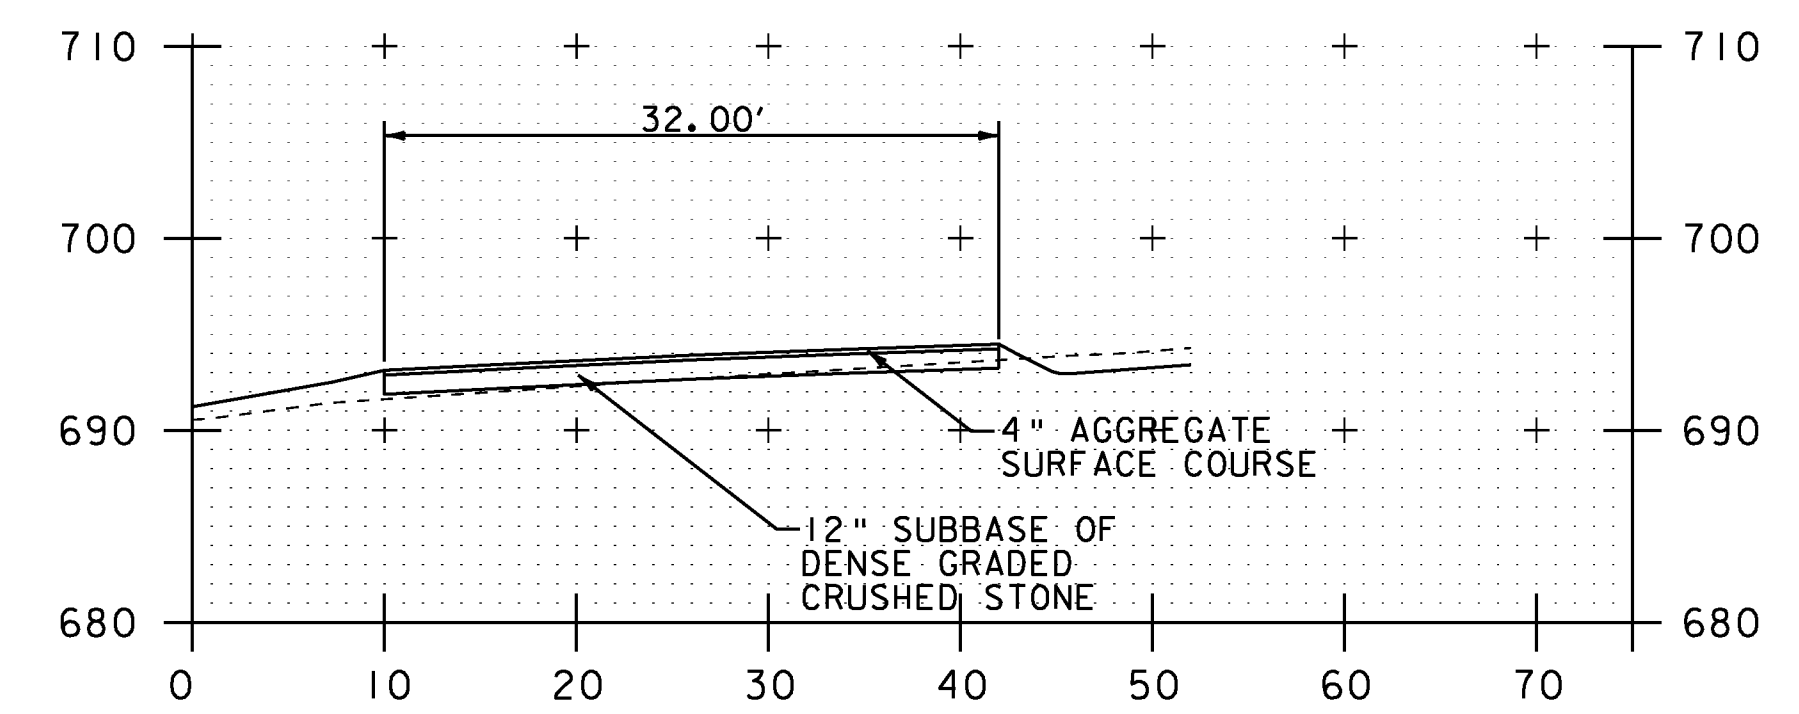

93+82 A-A

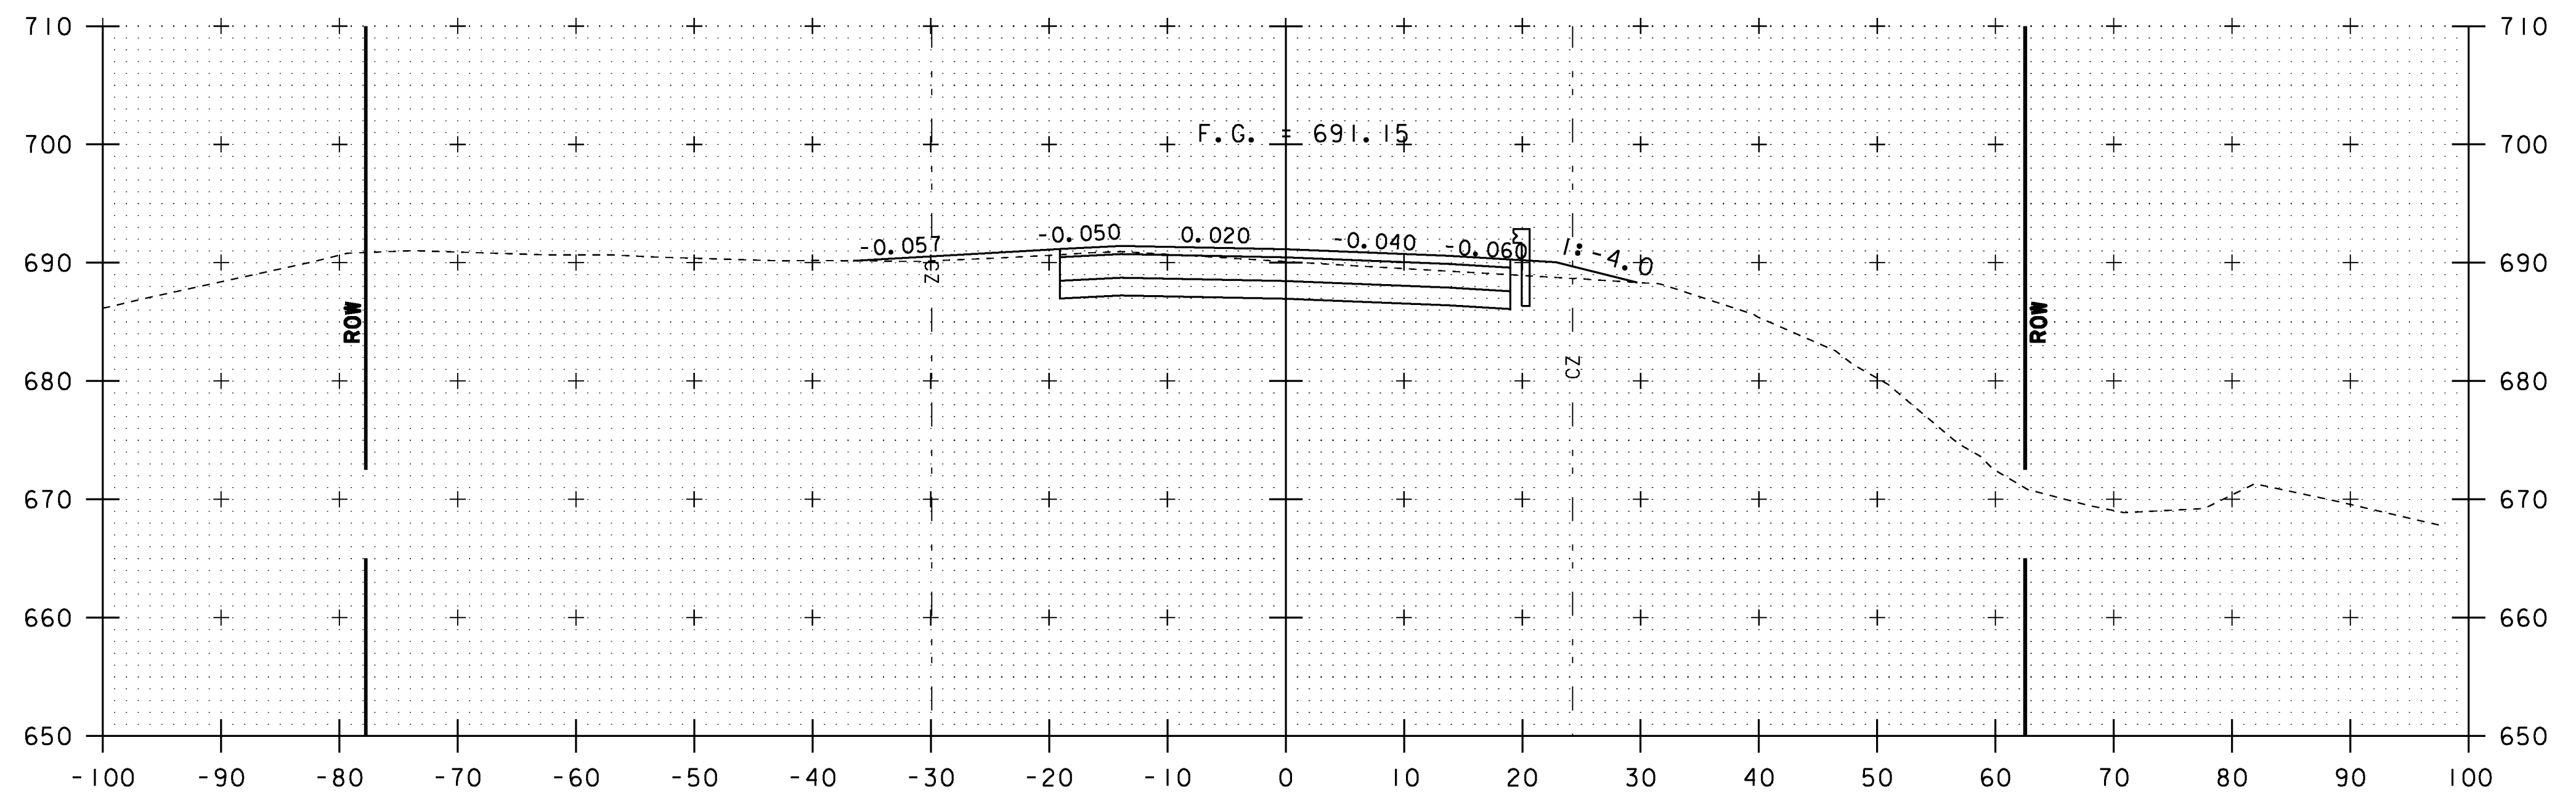

93+50

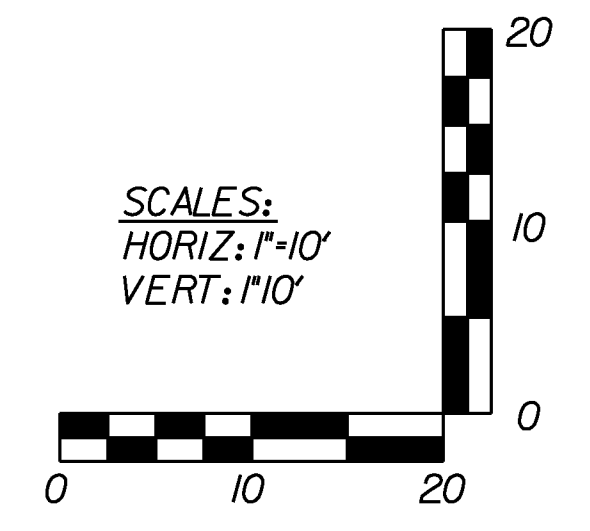

VT ROUTE 15	
STA. 93+50 TO STA. 93+82	
PROJECT NAME:	HYDE PARK
PROJECT NUMBER:	HES 030-2(23)
FILE NAME: +08b126xs.dgn	PLOT DATE: 08-DEC-2010
PROJECT LEADER: JLS	DRAWN BY: MBL
DESIGNED BY: MBL	CHECKED BY: JAD
CROSS SECTION SHEET 4	SHEET 81 OF 100