



102+46.30

END PROJECT  
HES 030-2 (23)  
BEGIN APPROACH

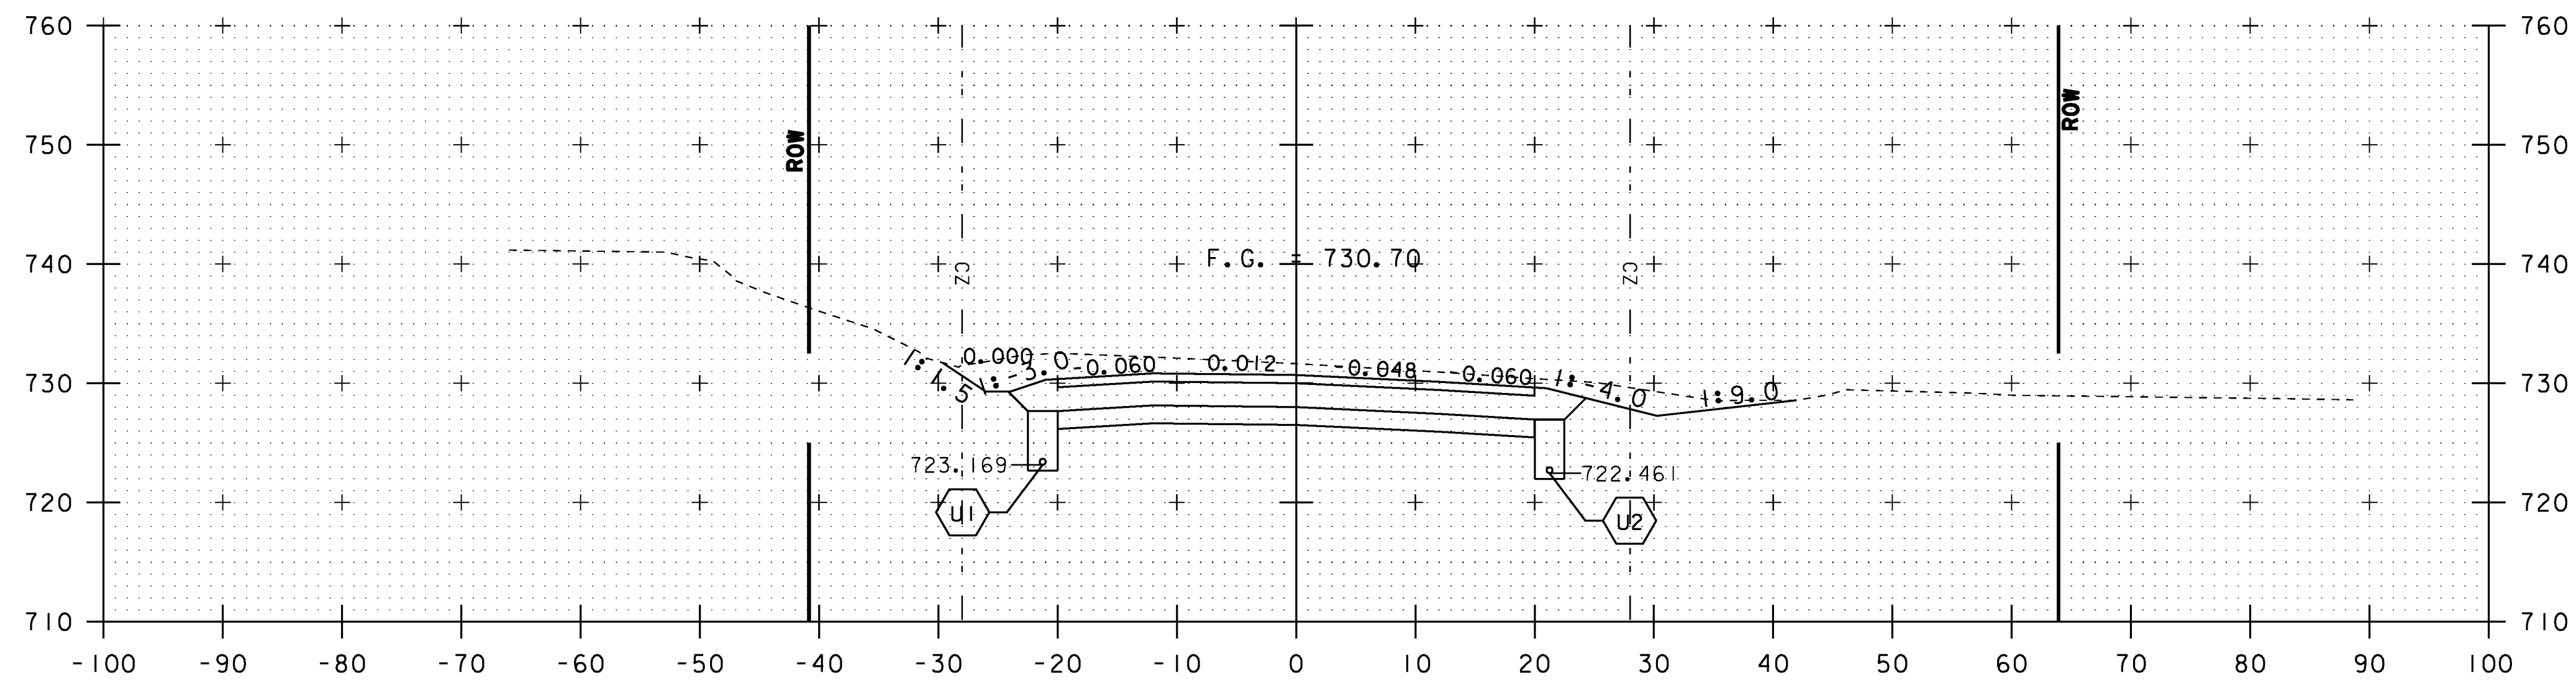

102+00

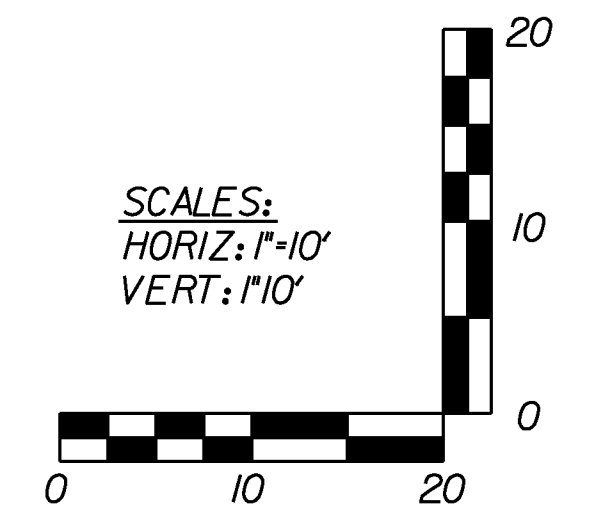

VT ROUTE 15	
STA. 102+00 TO STA. 102+46.30	
PROJECT NAME:	HYDE PARK
PROJECT NUMBER:	HES 030-2(23)
FILE NAME: +08b126xs.dgn	PLOT DATE: 08-DEC-2010
PROJECT LEADER: JLS	DRAWN BY: MBL
DESIGNED BY: MBL	CHECKED BY: JAD
CROSS SECTION SHEET 12	SHEET 89 OF 100