


103+83.80

END APPROACH  
MATCH EXISTING

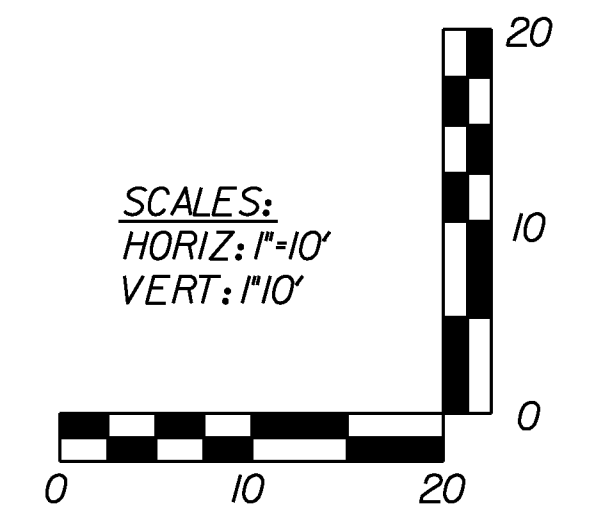

VT ROUTE 15	
STA. 103+84 TO STA. 103+83.80	
PROJECT NAME:	HYDE PARK
PROJECT NUMBER:	HES 030-2(23)
FILE NAME: +08b126xs.dgn	PLOT DATE: 08-DEC-2010
PROJECT LEADER: JLS	DRAWN BY: MBL
DESIGNED BY: MBL	CHECKED BY: JAD
CROSS SECTION SHEET 14	SHEET 91 OF 100