



41+50

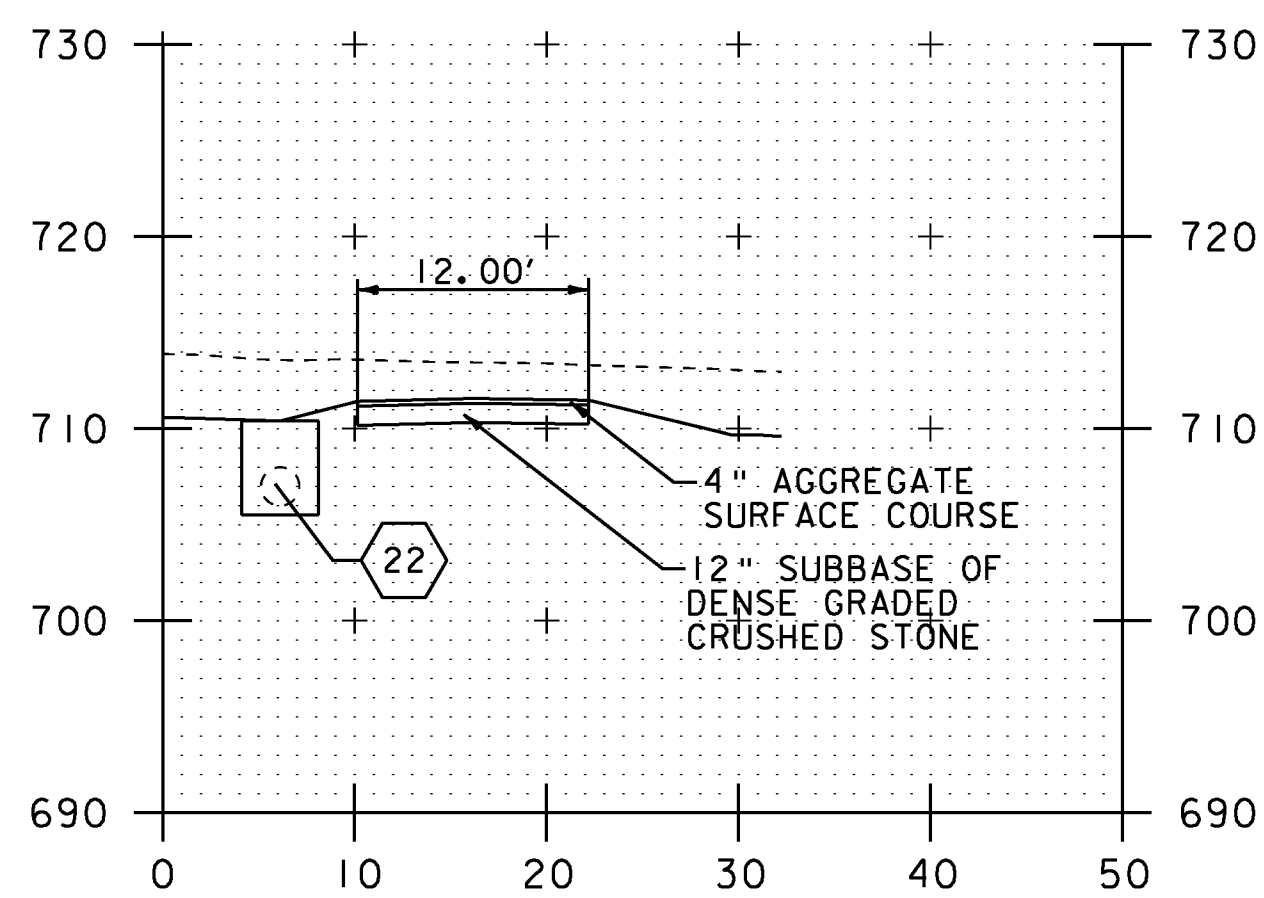


41+18 A-A

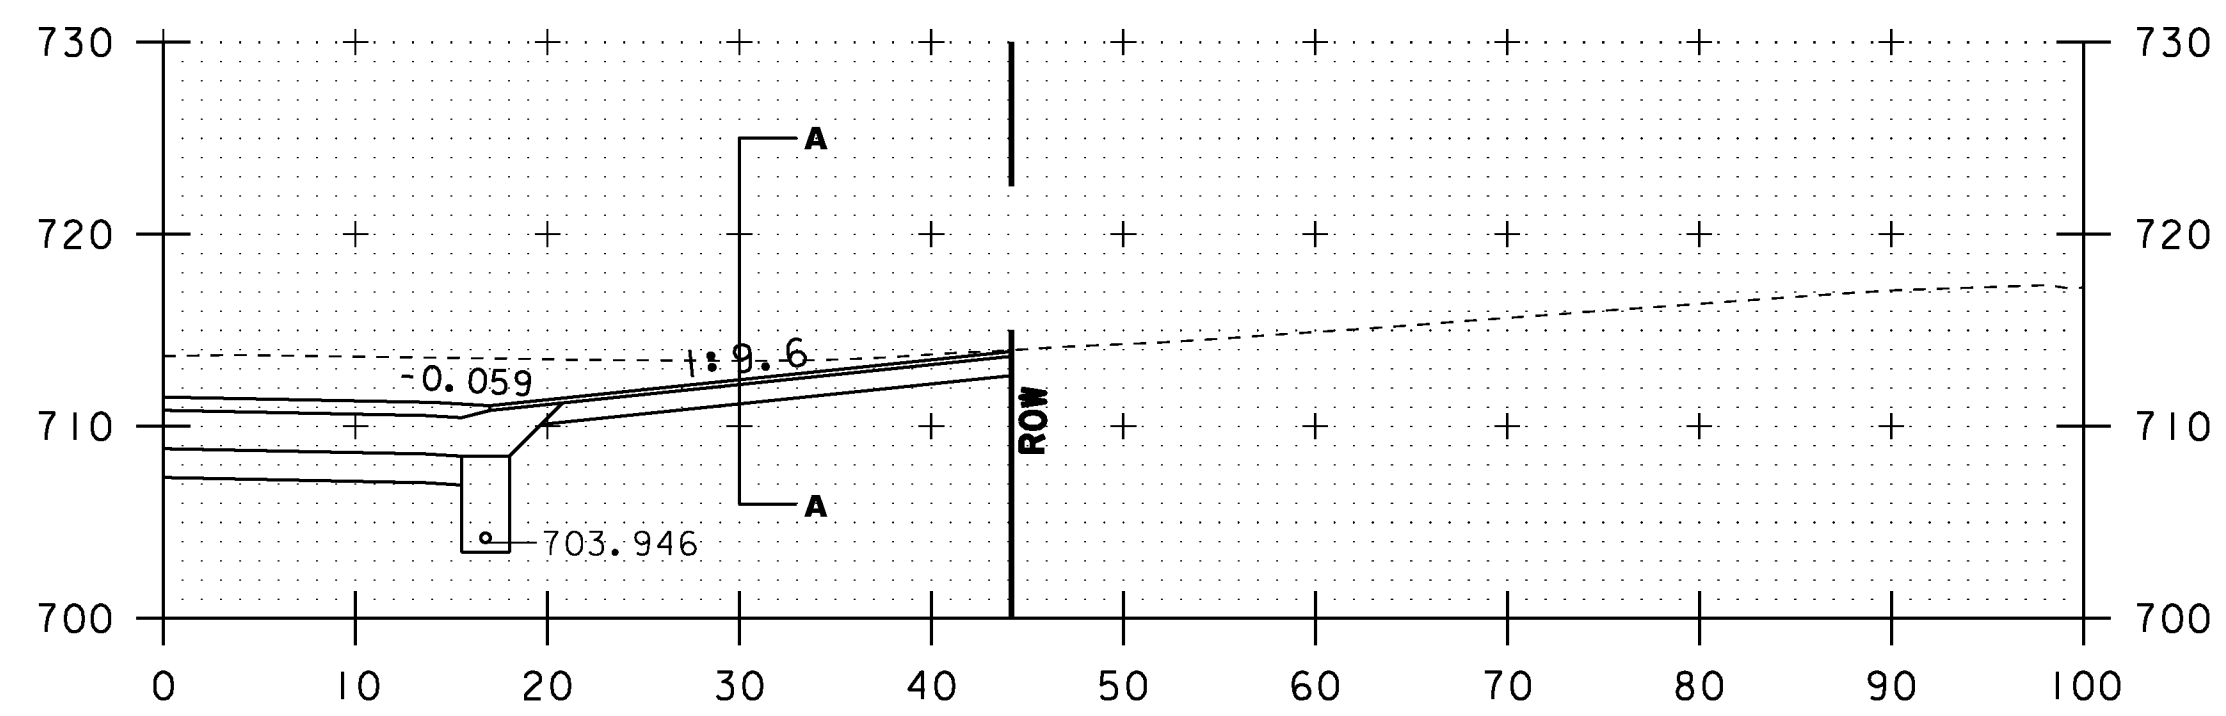

41+18

GRAVEL DRIVE RT.

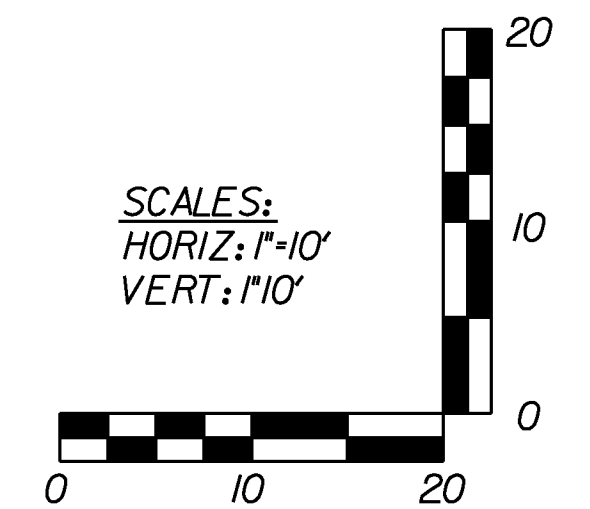

VT ROUTE 100	
STA. 41+18 TO STA. 41+50	
PROJECT NAME:	HYDE PARK
PROJECT NUMBER:	HES 030-2(23)
FILE NAME: +08b126xs.dgn	PLOT DATE: 08-DEC-2010
PROJECT LEADER: JLS	DRAWN BY: MBL
DESIGNED BY: MBL	CHECKED BY: JAD
CROSS SECTION SHEET 16	SHEET 93 OF 100