



43+50

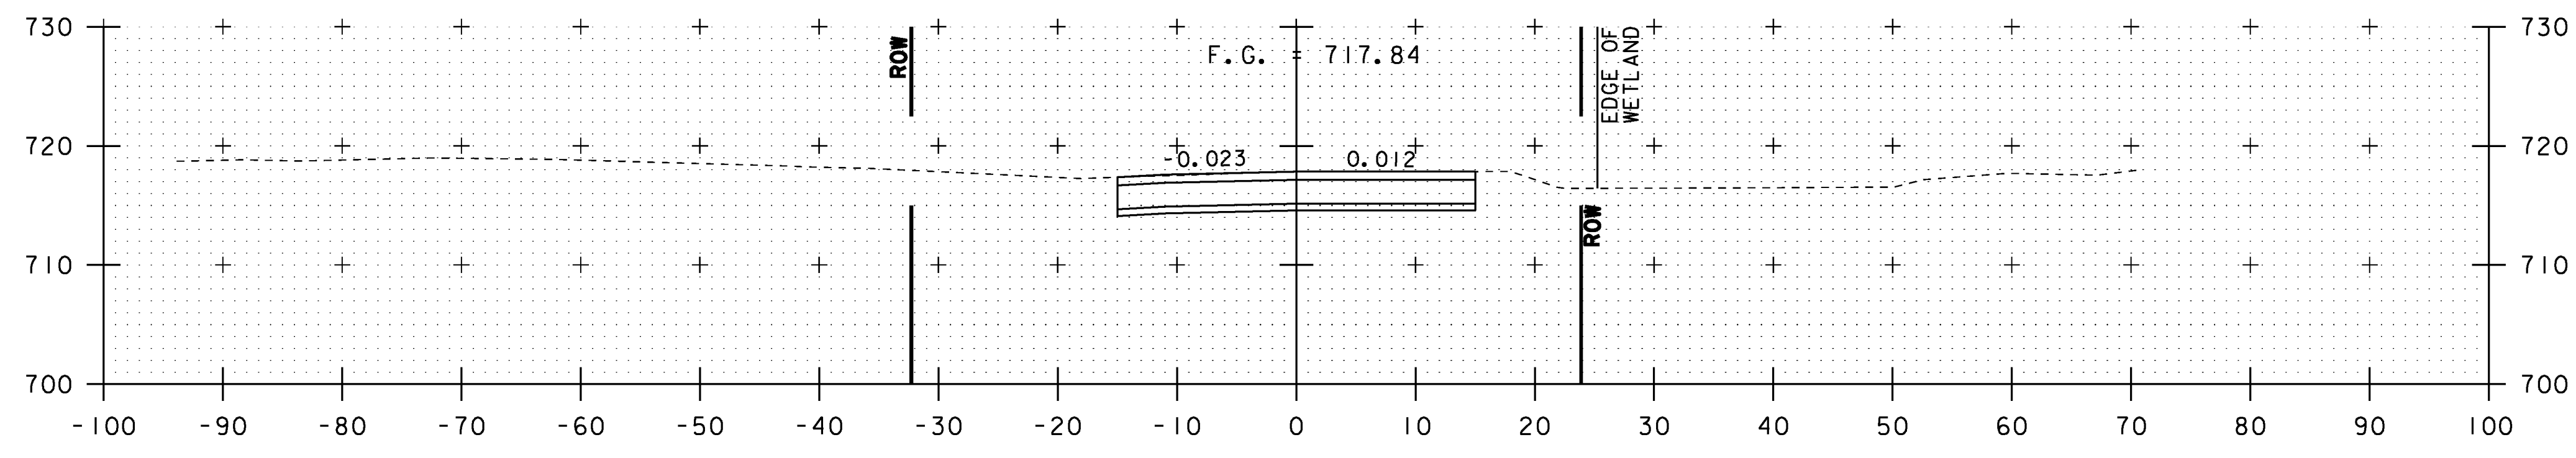


43+00

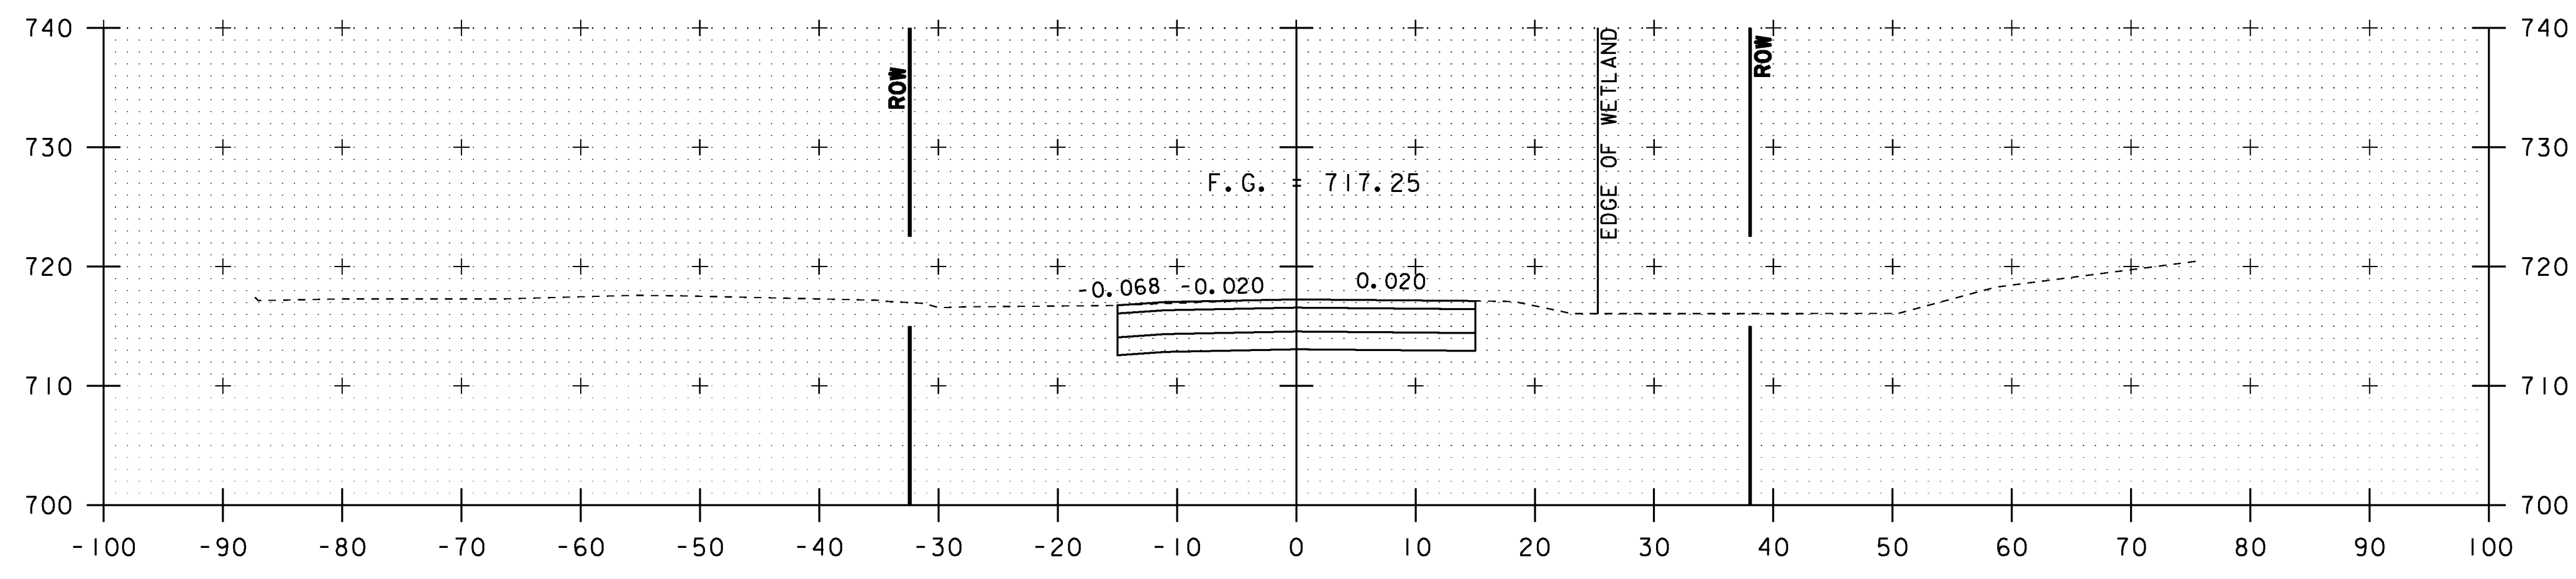

42+76.83

END PROJECT  
HES 030-2(23)  
BEGIN APPROACH

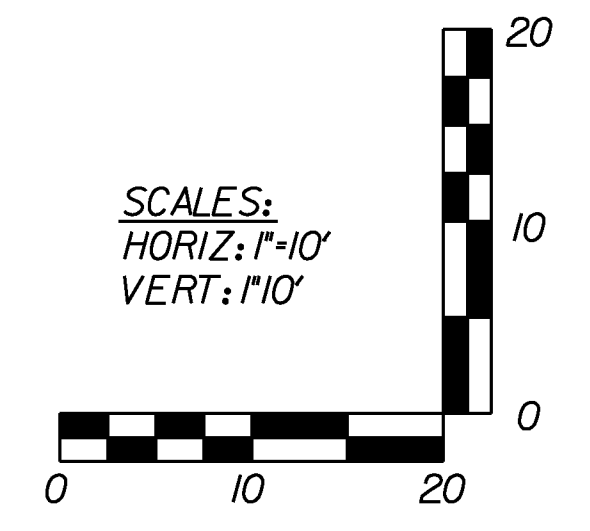

VT ROUTE 100	
STA. 42+76.83 TO STA. 43+50	
PROJECT NAME:	HYDE PARK
PROJECT NUMBER:	HES 030-2(23)
FILE NAME: +08b126xs.dgn	PLOT DATE: 08-DEC-2010
PROJECT LEADER: JLS	DRAWN BY: MBL
DESIGNED BY: MBL	CHECKED BY: JAD
CROSS SECTION SHEET 18	SHEET 95 OF 100