


61+10

BEGIN APPROACH
MATCH EXISTING

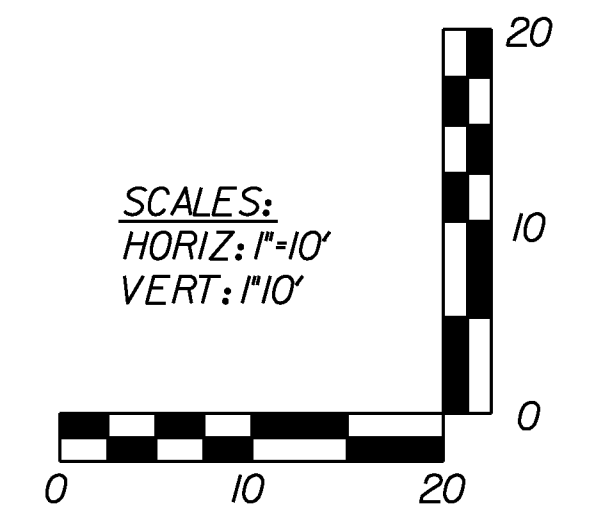

T.H. 5 CHURCH ST.	
STA. 61+10 TO STA. 61+10	
PROJECT NAME:	HYDE PARK
PROJECT NUMBER:	HES 030-2(23)
FILE NAME: +08b126xs.dgn	PLOT DATE: 08-DEC-2010
PROJECT LEADER: JLS	DRAWN BY: MBL
DESIGNED BY: MBL	CHECKED BY: JAD
CROSS SECTION SHEET 20	SHEET 97 OF 100