

DURABLE 4 INCH WHITE LINE (SEE OPTION ITEMS)
 STA. 126+45.60 - STA. 129+25 (SOLID LT & RT)

DURABLE 4 INCH YELLOW LINE (SEE OPTION ITEMS)
 STA. 126+45.60 - STA. 129+25 (SOLID LT & RT)

TEMPORARY 4 INCH WHITE LINE, PAINT
 STA. 126+45.60 - STA. 129+25 (SOLID LT & RT)

TEMPORARY 4 INCH YELLOW LINE, PAINT
 STA. 126+45.60 - STA. 129+25 (SOLID LT & RT)

REMOVING SIGNS
 AS SHOWN - 1

CURVE #1
 DELTA = 3°28'51"
 D = 1°25'57"
 R = 4000.00'
 T = 121.54'
 L = 243.01'


- LEGEND**
- MAILBOX
 - BORING
 - SIGN
 - HYDRANT
 - MANHOLE
 - WATER SHUT OFF (WSO)
 - GAS PIPELINE MARKER
 - CATCH BASIN / DROP INLET
 - CURB INLET
 - TRAFFIC CONTROL BOX
 - PARKING METER
 - UTILITY POLE

- SIGN LEGEND**
- R = REMOVE
 - R&S = REMOVE AND SALVAGE
 - RET = RETAIN
 - S = SALVAGE
 - N = NEW
 - B-B = BACK TO BACK

DATUM

VERTICAL NAVD 88

HORIZONTAL NAD 83

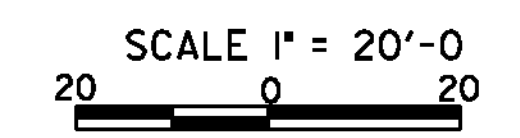

PROJECT LAYOUT SHEET 1	PROJECT NAME: NEWPORT-COVENTRY-NEWPORT
	PROJECT NUMBER: STP 2802(I)
	FILE NAME: 08b158.dgn
	PLOT FILE: 08b158-28.1
	PLOT DATE: 8/3/2011
	DRAWN BY: BMB
	CHECKED BY: EPD
	SHEET 28 OF 134