

6 INCH UNDERDRAIN PIPE
~~STA. 165+35 LT & RT~~
~~STA. 165+35 - STA. 168+15 LT~~

6 INCH UNDERDRAIN CARRIER PIPE
~~STA. 168+15 LT~~

UNDERDRAIN FLUSHING BASIN
~~STA. 168+15 LT~~



STONE FILL TYPE I
 164 + 85 LT
 165 + 25 LT

DURABLE 4 INCH WHITE LINE (SEE OPTION ITEMS)
 STA. 162+75 - STA. 168+50 (SOLID LT & RT)

DURABLE 4 INCH YELLOW LINE (SEE OPTION ITEMS)
 STA. 162+75 - STA. 165+25 (DASHED LT)
 STA. 162+75 - STA. 165+25 (SOLID RT)
 STA. 165+25 - STA. 168+50 (SOLID LT & RT)

TEMPORARY 4 INCH WHITE LINE, PAINT
 STA. 162+75 - STA. 168+50 (SOLID LT & RT)

TEMPORARY 4 INCH YELLOW LINE, PAINT
 STA. 162+75 - STA. 165+25 (DASHED LT)
 STA. 162+75 - STA. 165+25 (SOLID RT)
 STA. 165+25 - STA. 168+50 (SOLID LT & RT)

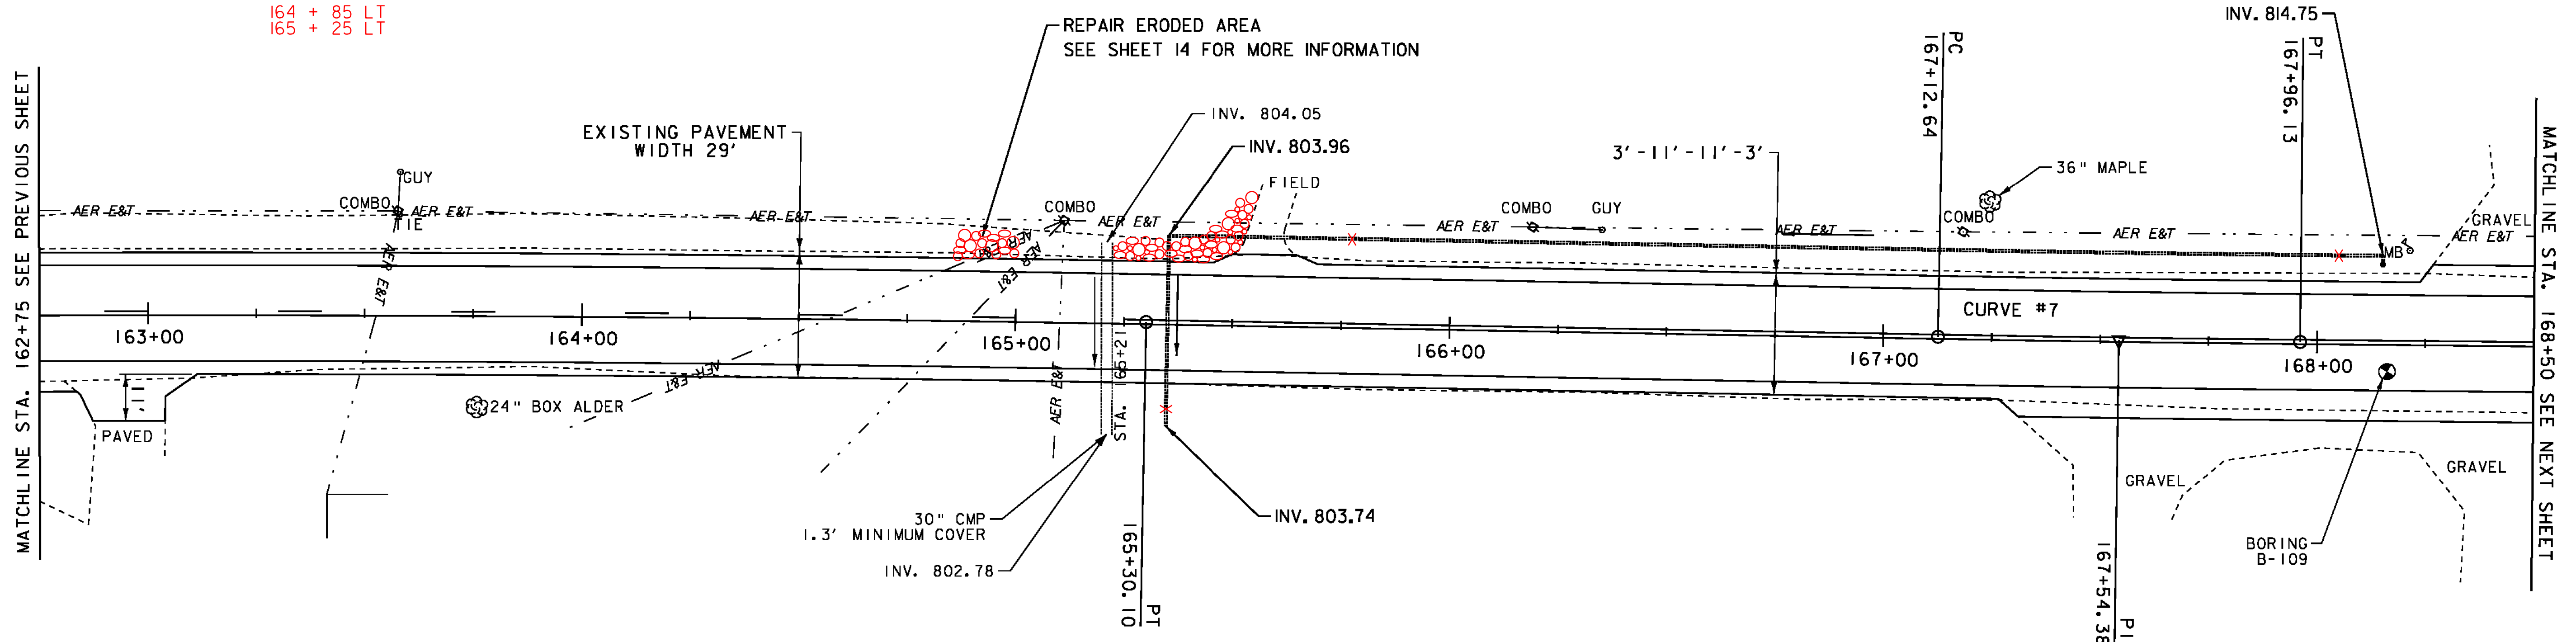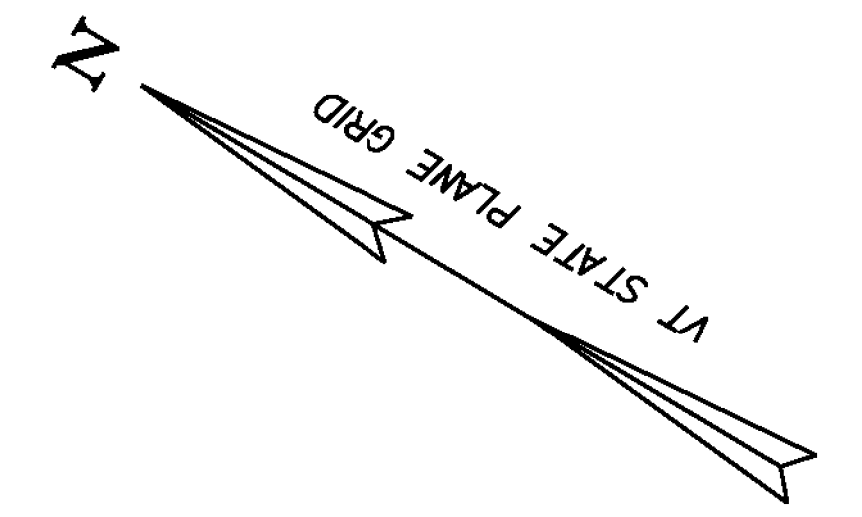


CURVE #7
 DELTA = 0° 28' 42"
 D = 0° 34' 23"
 R = 10000.00'
 T = 41.75'
 L = 83.49'
 NORMAL CROWN (50 MPH)

- LEGEND**
- MAILBOX
 - BORING
 - SIGN
 - HYDRANT
 - MANHOLE
 - WATER SHUT OFF (WSO)
 - GAS PIPELINE MARKER
 - CATCH BASIN / DROP INLET
 - CURB INLET
 - ⊗ TRAFFIC CONTROL BOX
 - ⊕ PARKING METER
 - ⊖ UTILITY POLE

- SIGN LEGEND**
- R = REMOVE
 - R&S = REMOVE AND SALVAGE
 - RET = RETAIN
 - S = SALVAGE
 - N = NEW
 - B-B = BACK TO BACK

DATUM
 NAVD 88
 NAD 83

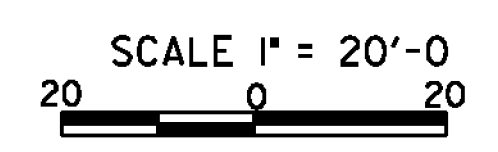

PROJECT LAYOUT SHEET 8

PROJECT NAME: NEWPORT-COVENTRY-NEWPORT	FILE NAME: 08b158.dgn	PLOT DATE: 8/3/2011
PROJECT NUMBER: STP 2802(1)	PROJECT LEADER: CDL	DRAWN BY: BMB
	DESIGNED BY: BMB	CHECKED BY: EPD
	PLOT FILE: 08b158-35.1	SHEET 35 OF 134