

DURABLE 4 INCH WHITE LINE (SEE OPTION ITEMS)  
 STA. 185+50 - STA. 191+25 (SOLID LT & RT)


DURABLE 4 INCH YELLOW LINE (SEE OPTION ITEMS)  
 STA. 185+50 - STA. 188+00 (SOLID LT & RT)  
 STA. 188+00 - STA. 191+25 (SOLID LT)  
 STA. 188+00 - STA. 191+25 (DASHED RT)

TEMPORARY 4 INCH WHITE LINE, PAINT  
 STA. 185+50 - STA. 191+25 (SOLID LT & RT)

TEMPORARY 4 INCH YELLOW LINE, PAINT  
 STA. 185+50 - STA. 188+00 (SOLID LT & RT)  
 STA. 188+00 - STA. 191+25 (SOLID LT)  
 STA. 188+00 - STA. 191+25 (DASHED RT)

REMOVING SIGNS  
 AS SHOWN - 1

RELOCATE MAILBOX, SINGLE SUPPORT  
~~STA. 186+17 LT~~

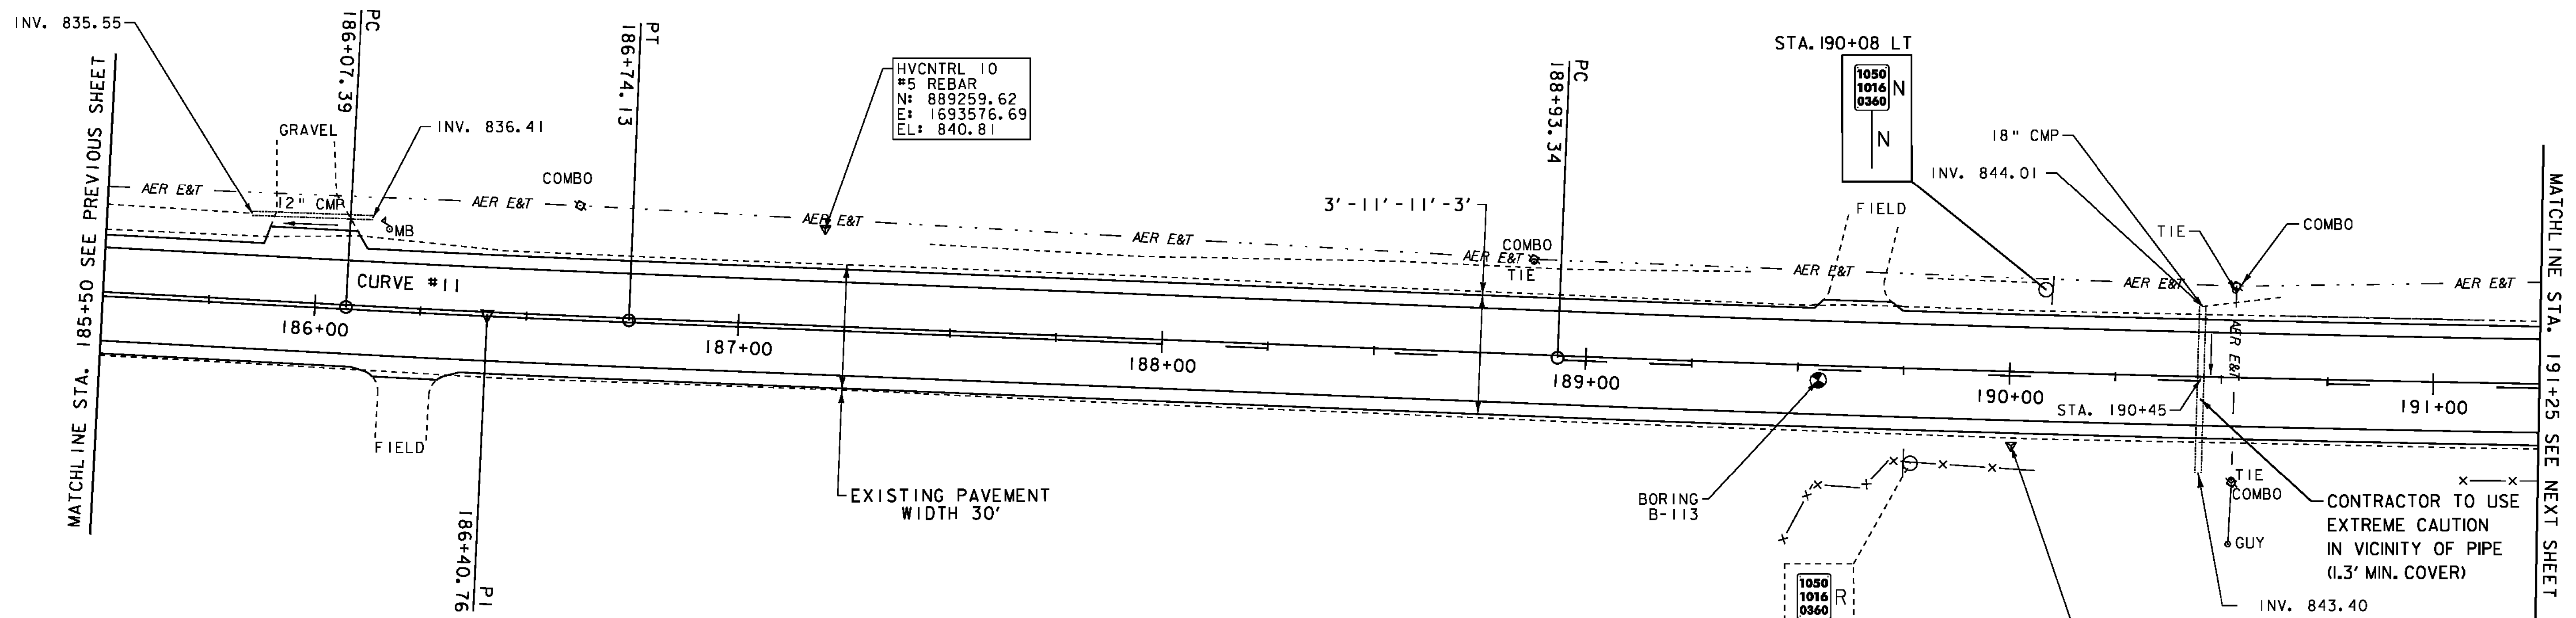

CURVE #11  
 DELTA = 0°45'53"  
 D = 1°08'45"  
 R = 5000.00'  
 T = 33.37'  
 L = 66.74'  
 BANKING 0.024 FT/FT  
 150' RUNOFF (50 MPH)

- LEGEND**
- MAILBOX
  - BORING
  - SIGN
  - HYDRANT
  - MANHOLE
  - WATER SHUT OFF (WSO)
  - GAS PIPELINE MARKER
  - CATCH BASIN / DROP INLET
  - CURB INLET
  - TRAFFIC CONTROL BOX
  - ⊕ PARKING METER
  - ⊖ UTILITY POLE

- SIGN LEGEND**
- R = REMOVE
  - R&S = REMOVE AND SALVAGE
  - RET = RETAIN
  - S = SALVAGE
  - N = NEW
  - B-B = BACK TO BACK

DATUM  
 NAVD 88  
 NAD 83

SCALE 1" = 20'-0"  
 20 0 20

<b>PROJECT LAYOUT SHEET 12</b>	PROJECT NAME: NEWPORT-COVENTRY-NEWPORT	PLOT DATE: 8/3/2011
	PROJECT NUMBER: STP 2802(1)	DRAWN BY: BMB
	FILE NAME: 08b158.dgn	CHECKED BY: EPD
	DESIGNED BY: BMB	SHEET 39 OF 134
	PLOT FILE: 08b158-39.1	