

STEEL BEAM GUARDRAIL, GALVANIZED
 STA. 213+75.00 - STA. 214+94.00 LT
~~STA. 213+77.50 - STA. 213+92.00 RT~~

STEEL BEAM GUARDRAIL,
 GALVANIZED WITH 8 FT POSTS
 STA. 213+75.00 - STA. ~~213+77.50~~ RT
 213+94

ANCHOR FOR STEEL BEAM RAIL
 STA. ~~213+92~~ RT 213+94
 STA. 214+94 LT

REMOVAL AND DISPOSAL OF GUARDRAIL
 STA. 213+75 - STA. 214+94 LT
 STA. 213+75 - STA. 213+89 RT

DURABLE 4 INCH WHITE LINE (SEE OPTION ITEMS)

STA. 213+75 - STA. 219+50 (SOLID LT & RT)

DURABLE 4 INCH YELLOW LINE (SEE OPTION ITEMS)

STA. 213+75 - STA. 219+50 (SOLID LT & RT)

DURABLE LETTER OR SYMBOL (SEE OPTION ITEMS)

STA. 216+32 RT "STOP"

STA. 216+72 RT "AHEAD"

TEMPORARY 4 INCH WHITE LINE, PAINT

STA. 213+75 - STA. 219+50 (SOLID LT & RT)

TEMPORARY 4 INCH YELLOW LINE, PAINT

STA. 213+75 - STA. 219+50 (SOLID LT & RT)

TEMPORARY LETTER OR SYMBOL, PAINT

STA. 216+32 RT "STOP"

STA. 216+72 RT "AHEAD"



REMOVING SIGNS

AS SHOWN - 10

DELINEATOR WITH STEEL POST

STA. 213+92 RT

STA. 214+94 LT

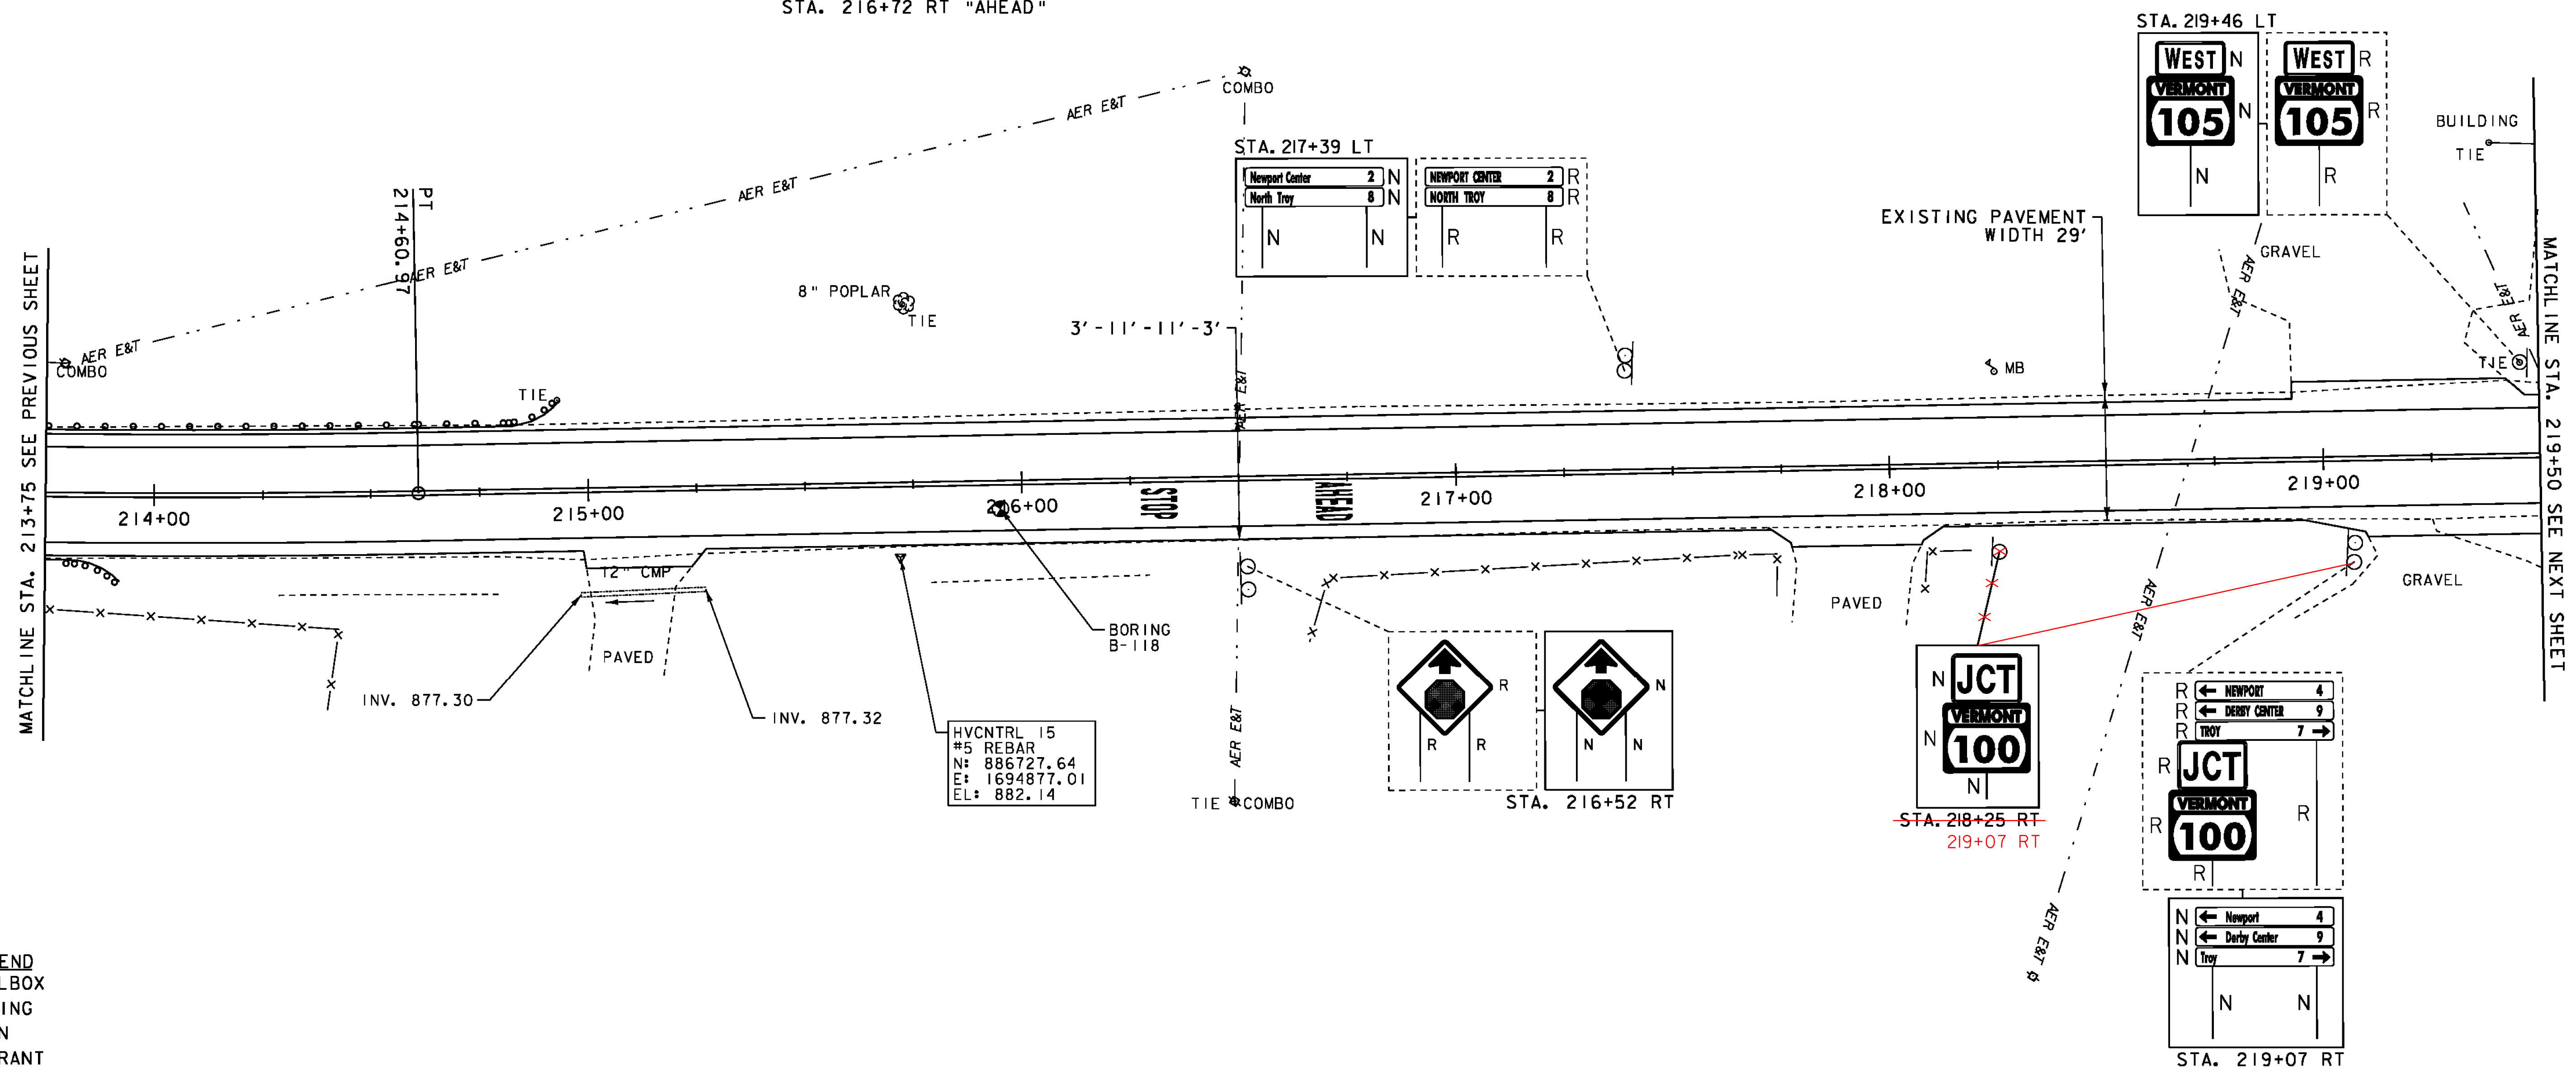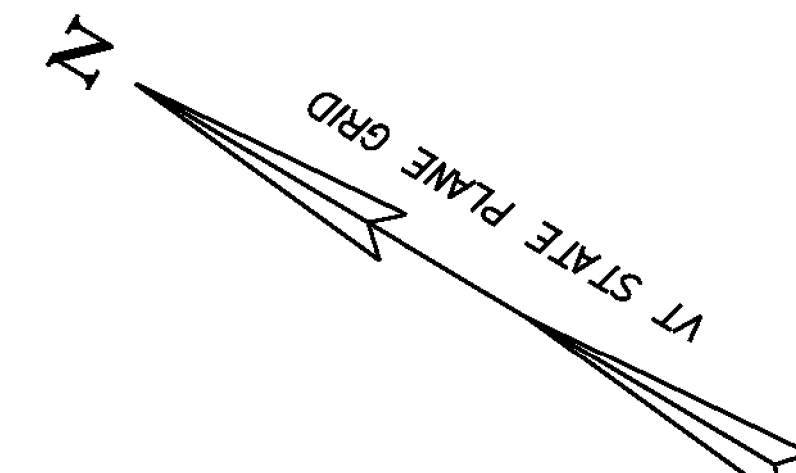

- LEGEND**
- MAILBOX
 - BORING
 - SIGN
 - HYDRANT
 - MANHOLE
 - WATER SHUT OFF (WSO)
 - GAS PIPELINE MARKER
 - CATCH BASIN / DROP INLET
 - CURB INLET
 - ⊠ TRAFFIC CONTROL BOX
 - ⊕ PARKING METER
 - ⊖ UTILITY POLE

- SIGN LEGEND**
- R = REMOVE
 - R&S = REMOVE AND SALVAGE
 - RET = RETAIN
 - S = SALVAGE
 - N = NEW
 - B-B = BACK TO BACK

DATUM
 NAVD 88
 NAD 83

SCALE 1" = 20'-0"
 20 0 20

PROJECT LAYOUT SHEET 17	PROJECT NAME: NEWPORT-COVENTRY-NEWPORT
	PROJECT NUMBER: STP 2802(1)
	FILE NAME: 08b158.dgn
	PLOT DATE: 8/3/2011
PROJECT LEADER: CDL	DRAWN BY: BMB
DESIGNED BY: BMB	CHECKED BY: EPD
PLOT FILE: 08b158-44.1	SHEET 44 OF 134