

COMMON EXCAVATION
 STA. 234+25 - STA. 239+75 RT

SOLID ROCK EXCAVATION
 STA. 237+37 RT
 STA. 237+37 RT



**STEEL BEAM GUARDRAIL,
 GALVANIZED W/8 FEET POSTS**
 STA. 234+25.00 - STA. 239+75.00 LT

REMOVAL AND DISPOSAL OF GUARDRAIL
 STA. 234+25 - STA. 239+75 LT

CURVE #21
 DELTA = 17°26'17"
 D = 4°10'01"
 R = 1375.00'
 T = 210.87'
 L = 418.49'
 E = 16.08'
 0.071 FT/FT
 150' RUNOFF (50 MPH)
 STA. 238+40 LT

HVCNTRL 20
 #5 REBAR
 N: 886498.16
 E: 1696587.33
 EL: 1011.34

HVCNTRL 19
 #5 REBAR
 N: 886452.37
 E: 1696148.58
 EL: 970.63

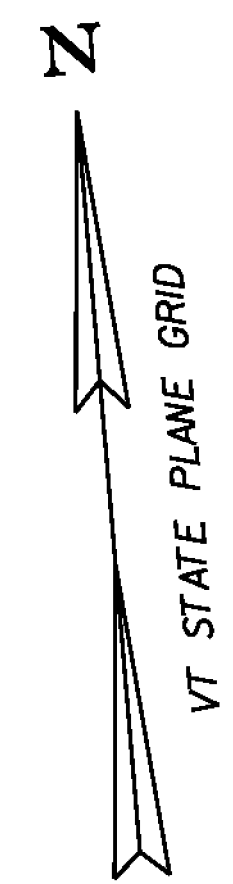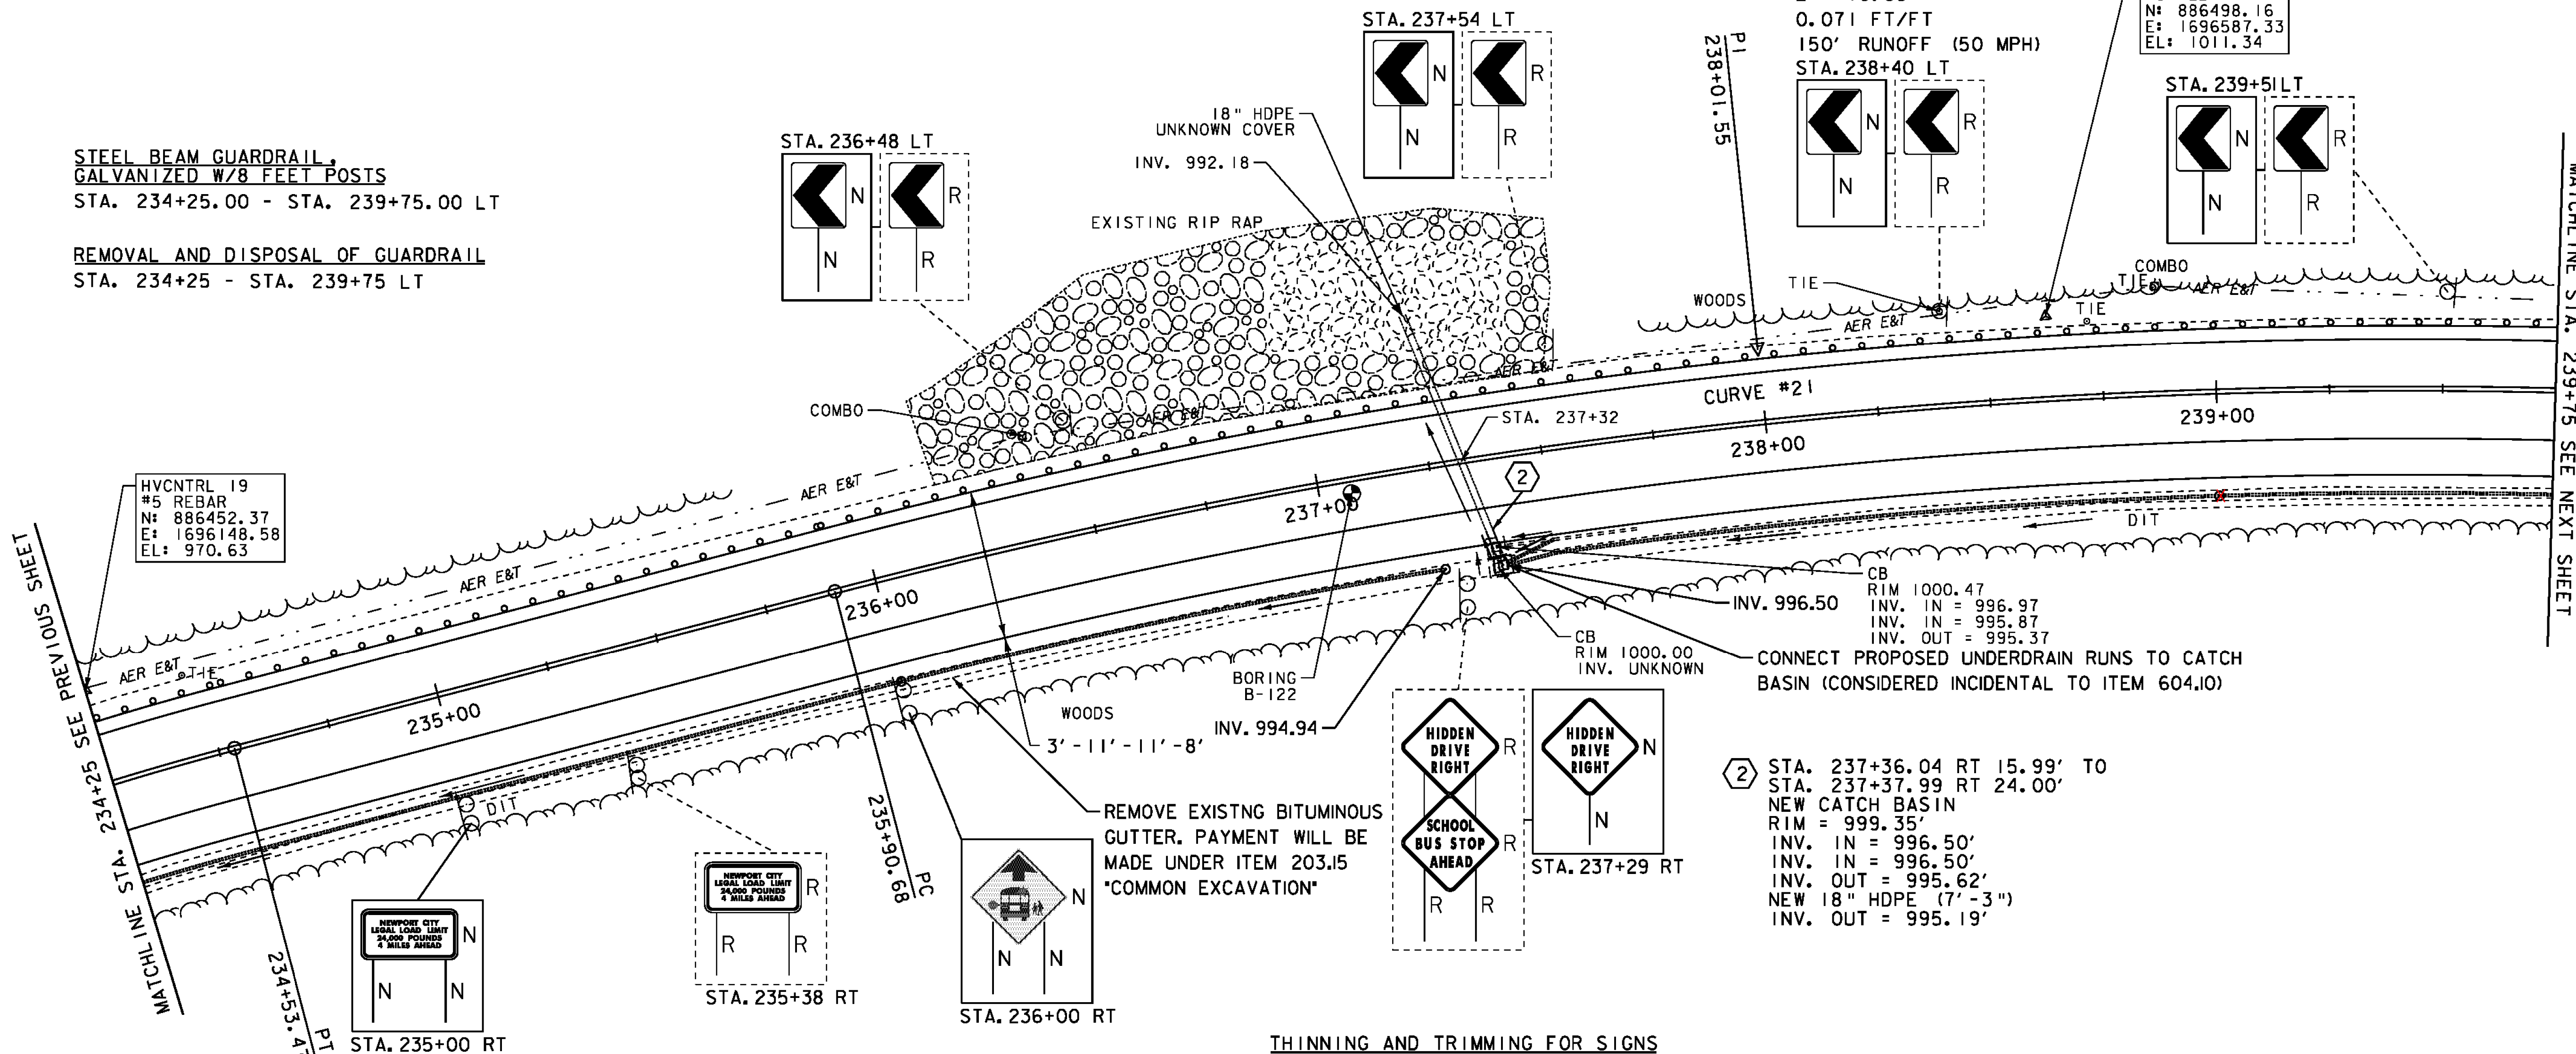

MATCHLINE STA. 239+75 SEE NEXT SHEET

THINNING AND TRIMMING FOR SIGNS
 STA. ~~237+29~~ RT

DURABLE 4 INCH WHITE LINE (SEE OPTION ITEMS)
 STA. 234+25 - STA. 239+75 (SOLID LT & RT)

DURABLE 4 INCH YELLOW LINE (SEE OPTION ITEMS)
 STA. 234+25 - STA. 239+75 (SOLID LT & RT)

TEMPORARY 4 INCH WHITE LINE, PAINT
 STA. 234+25 - STA. 239+75 (SOLID LT & RT)

TEMPORARY 4 INCH YELLOW LINE, PAINT
 STA. 234+25 - STA. 239+75 (SOLID LT & RT)

REMOVING SIGNS
 AS SHOWN - 7

STONE FILL TYPE I
 234+25 ~ 237+25 RT
 237+50 ~ 239+75 RT
 236+40 ~ 237+55 LT

**CONCRETE CATCH BASINS WITH
 CAST IRON GRATE**
 STA. 237+37 RT "CAST IRON COVER"
 STA. 237+37 RT "TYPE E GRATE"

6 INCH UNDERDRAIN PIPE
 STA. 234+25 - STA. 237+25 RT 237+08
 STA. 237+37 - STA. 239+75 RT 238+03 (CONNECTED TO EXISTING)
 STA. 237+37 - STA. 237+50 RT (CONNECT TO EXISTING)


6 INCH UNDERDRAIN CARRIER PIPE
 STA. ~~236+00~~ RT 234+27
 STA. ~~237+25~~ RT 237+08
 STA. ~~239+00~~ RT

UNDERDRAIN FLUSHING BASIN
 STA. 236+00 RT
 STA. 237+25 RT 237+08
 STA. 239+00 RT

- LEGEND**
- MAILBOX
 - BORING
 - SIGN
 - HYDRANT
 - MANHOLE
 - WATER SHUT OFF (WSO)
 - GAS PIPELINE MARKER
 - CATCH BASIN / DROP INLET
 - CURB INLET
 - ⊠ TRAFFIC CONTROL BOX
 - ⊕ PARKING METER
 - ⊖ UTILITY POLE

- SIGN LEGEND**
- R = REMOVE
 - R&S = REMOVE AND SALVAGE
 - RET = RETAIN
 - S = SALVAGE
 - N = NEW
 - B-B = BACK TO BACK

DATUM
 NAVD 88
 NAD 83

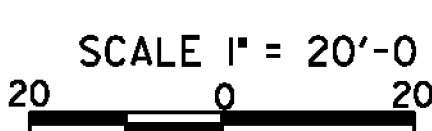

PROJECT LAYOUT SHEET 21

PROJECT NAME: NEWPORT-COVENTRY-NEWPORT	PLOT DATE: 8/3/2011
PROJECT NUMBER: STP 2802(1)	DRAWN BY: BMB
FILE NAME: 08b158.dgn	CHECKED BY: EPD
PROJECT LEADER: CDL	SHEET 48 OF 134
DESIGNED BY: BMB	
PLOT FILE: 08b158-48.1	