
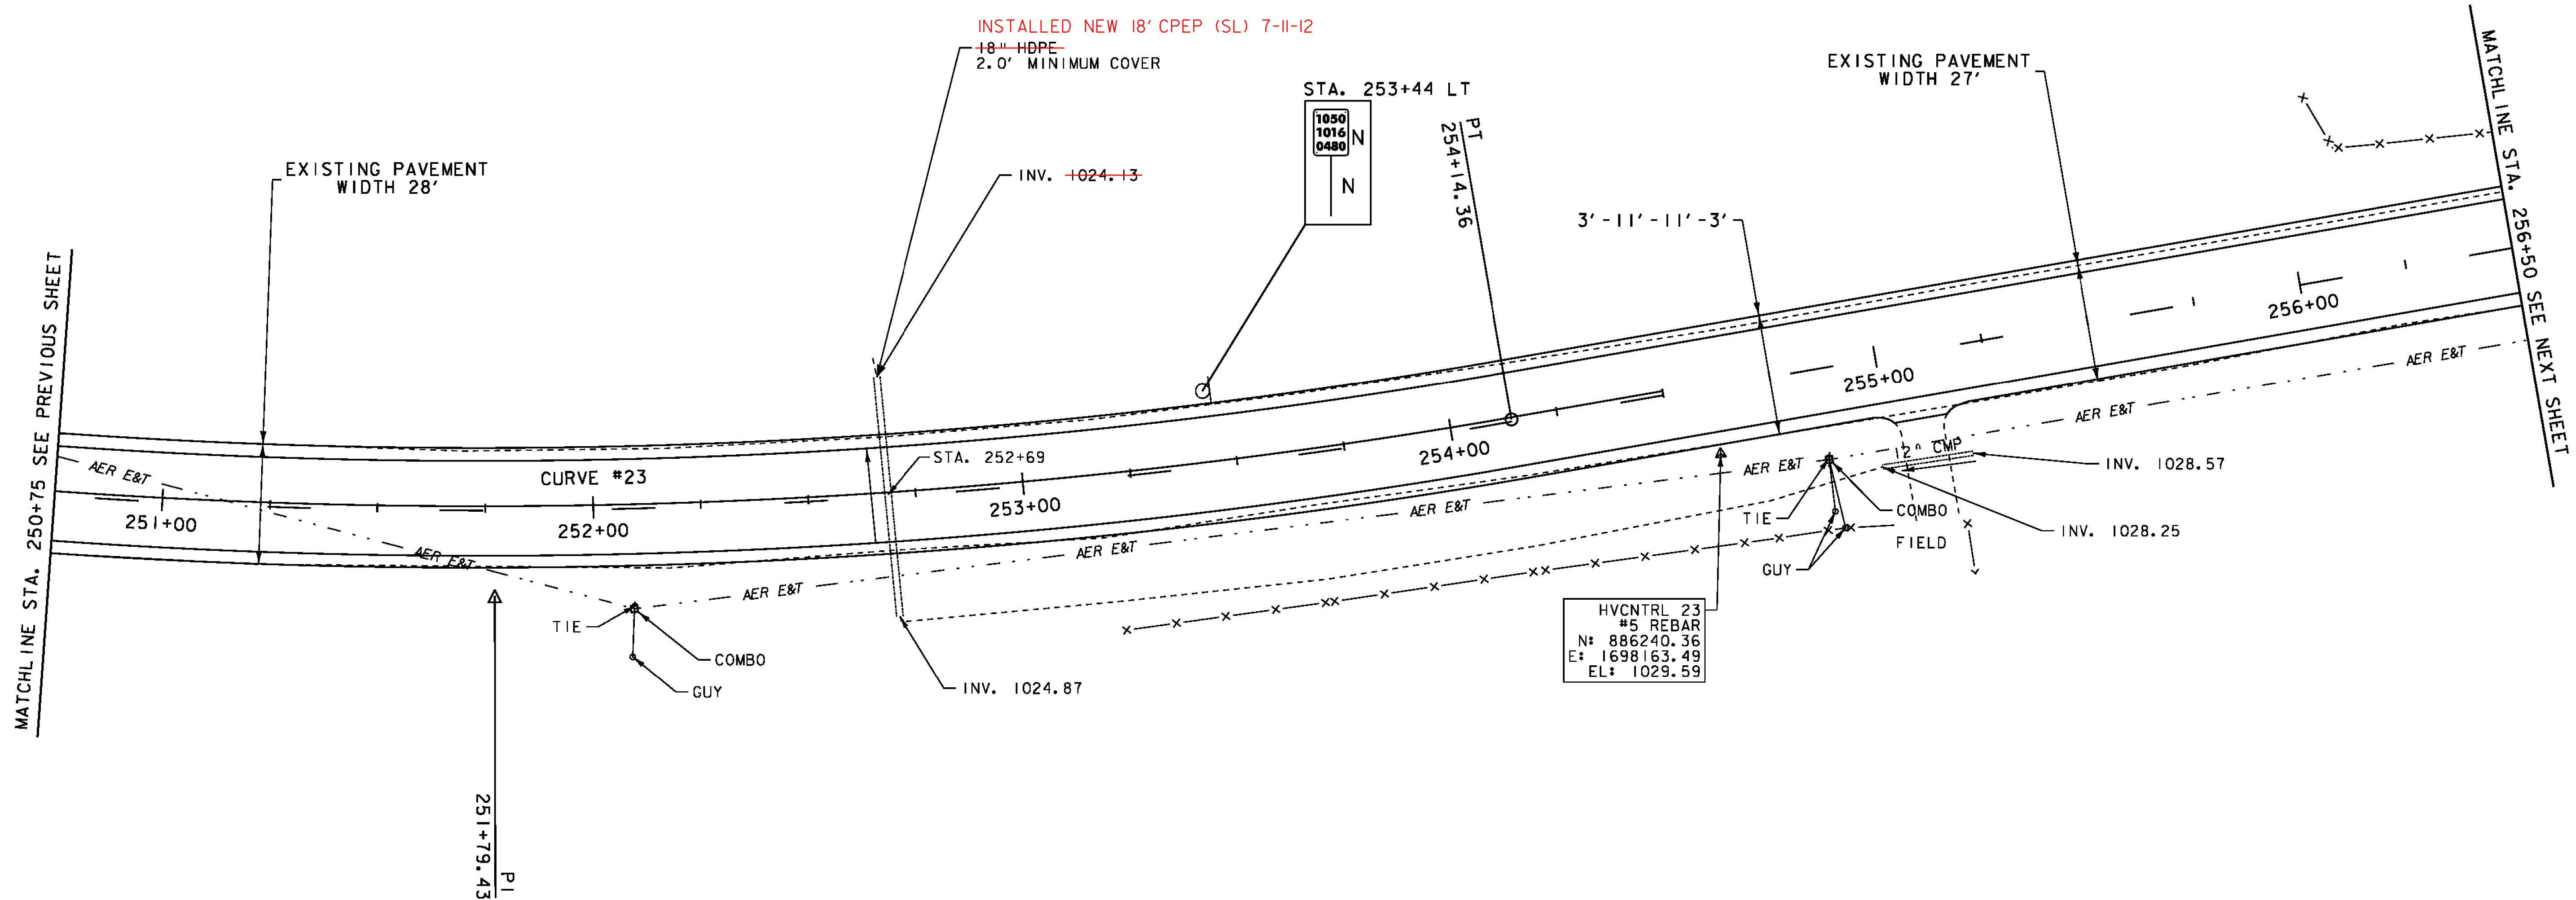


DURABLE 4 INCH WHITE LINE (SEE OPTION ITEMS)
 STA. 250+75 - STA. 256+50 (SOLID LT & RT)

DURABLE 4 INCH YELLOW LINE (SEE OPTION ITEMS)
 STA. 250+75 - STA. 254+50 (SOLID LT)
 STA. 250+75 - STA. 256+50 (DASHED RT)

TEMPORARY 4 INCH WHITE LINE, PAINT
 STA. 250+75 - STA. 256+50 (SOLID LT & RT)

TEMPORARY 4 INCH YELLOW LINE, PAINT
 STA. 250+75 - STA. 254+50 (SOLID LT)
 STA. 250+75 - STA. 256+50 (DASHED RT)

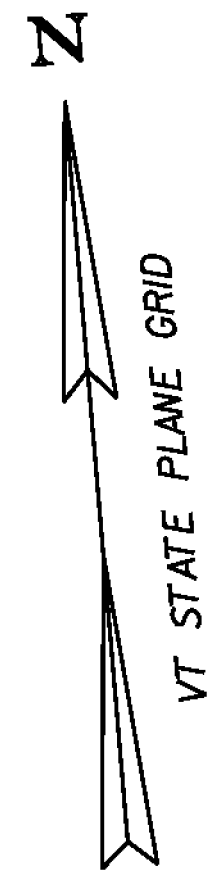

- LEGEND**
- MAILBOX
 - BORING
 - SIGN
 - HYDRANT
 - MANHOLE
 - WATER SHUT OFF (WSO)
 - GAS PIPELINE MARKER
 - CATCH BASIN / DROP INLET
 - CURB INLET
 - ⊗ TRAFFIC CONTROL BOX
 - ⊕ PARKING METER
 - ⊖ UTILITY POLE

CURVE #23
 DELTA = 19°25'01"
 D = 4°05'33"
 R = 1400.00'
 T = 239.52'
 L = 474.45'
 E = 20.34'
 0.064 FT/FT
 150' RUNOFF (50 MPH)

SIGN LEGEND

- R = REMOVE
- R&S = REMOVE AND SALVAGE
- RET = RETAIN
- S = SALVAGE
- N = NEW
- B-B = BACK TO BACK

DATUM

NAVD 88
 NAD 83

SCALE 1" = 20'-0"

PROJECT LAYOUT SHEET 24

PROJECT NAME: NEWPORT-COVENTRY-NEWPORT
 PROJECT NUMBER: STP 2802(1)

FILE NAME: 08b158.dgn
 PROJECT LEADER: CDL
 DESIGNED BY: BMB
 PLOT FILE: 08b158-51.l

PLOT DATE: 8/3/2011
 DRAWN BY: BMB
 CHECKED BY: EPD
 SHEET 51 OF 134