

DURABLE 4 INCH WHITE LINE (SEE OPTION ITEMS)
 STA. 256+50 - STA. 262+25 (SOLID LT & RT)

TEMPORARY 4 INCH WHITE LINE, PAINT
 STA. 256+50 - STA. 262+25 (SOLID LT & RT)

REMOVING SIGNS
 AS SHOWN - I

DURABLE 4 INCH YELLOW LINE (SEE OPTION ITEMS)
 STA. 256+50 - STA. 261+50 (DASHED RT)
 STA. 261+50 - STA. 262+25 (DASHED LT)
 STA. 261+50 - STA. 262+25 (SOLID RT)



TEMPORARY 4 INCH YELLOW LINE, PAINT
 STA. 256+50 - STA. 261+50 (DASHED RT)
 STA. 261+50 - STA. 262+25 (DASHED LT)
 STA. 261+50 - STA. 262+25 (SOLID RT)

6 INCH UNDERDRAIN PIPE
 STA. 260+07 - STA. 262+25 LT
 259+18

~~6 INCH UNDERDRAIN CARRIER PIPE~~
~~STA. 262+25 LT~~

~~UNDERDRAIN FLUSHING BASIN~~
~~STA. 262+25 LT~~

SEE NOTE ON SHEET 50

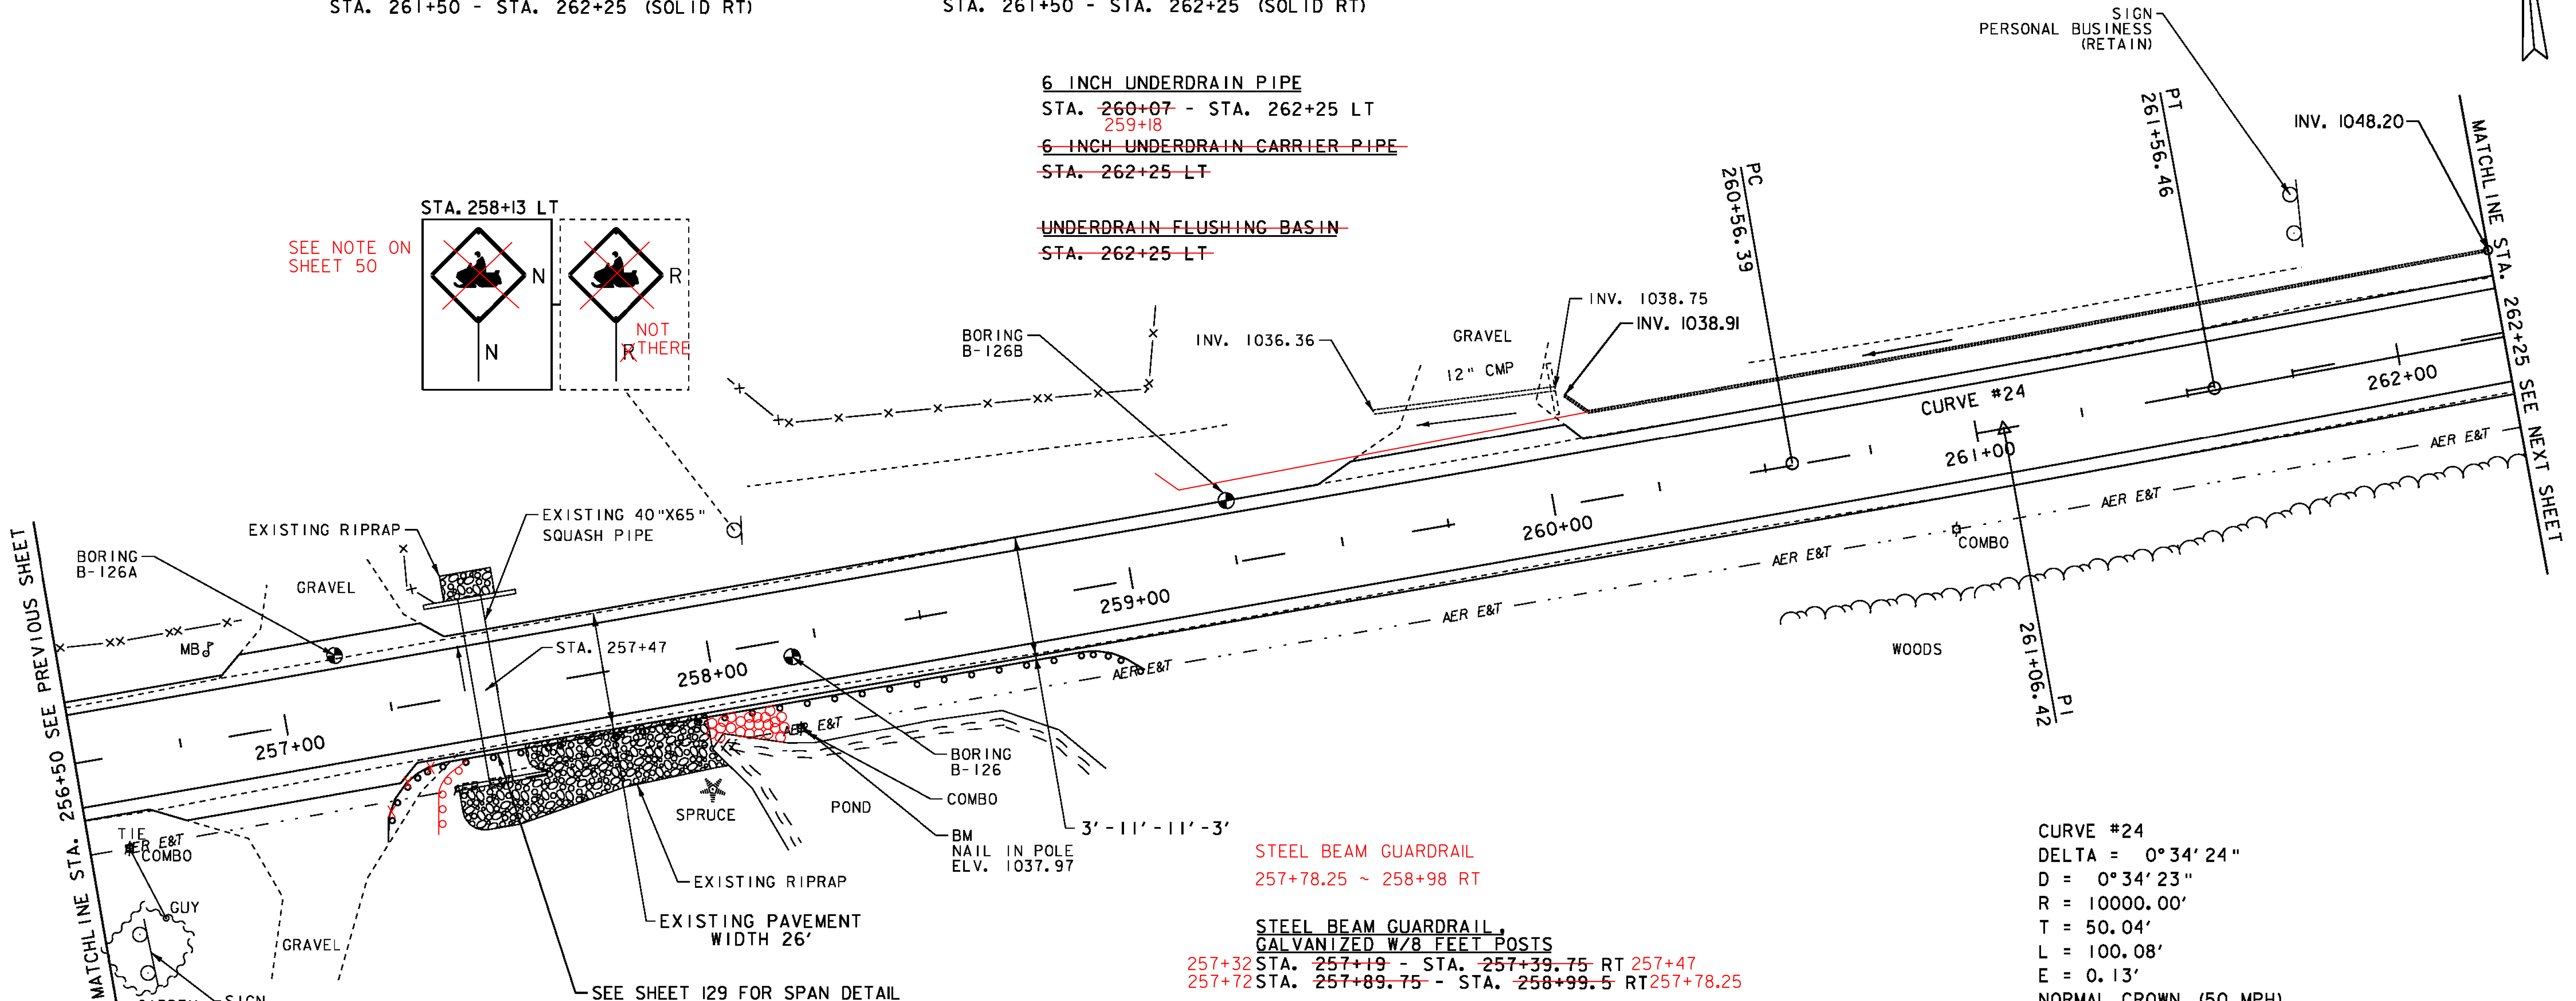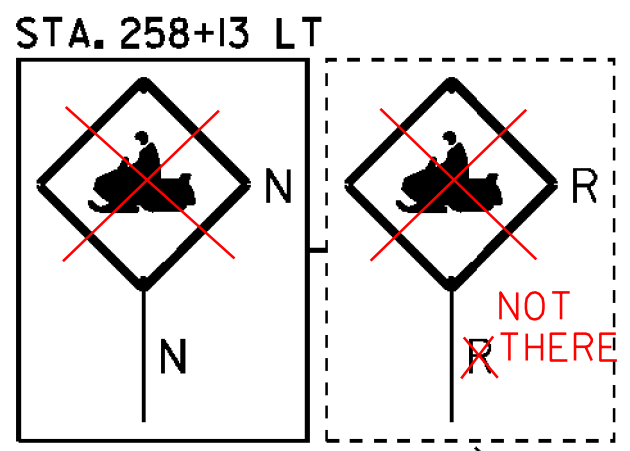

SIGN
 PERSONAL BUSINESS
 (RETAIN)

PI
 261+56.46

INV. 1048.20

BORING
 B-126B

INV. 1036.36

GRAVEL
 12" CMP

INV. 1038.75
 INV. 1038.91

PC
 260+56.39

CURVE #24

262+00

MATCHLINE STA. 262+25
 SEE NEXT SHEET

MATCHLINE STA. 256+50
 SEE PREVIOUS SHEET

BORING
 B-126A

EXISTING RIPRAP

EXISTING 40"X65"
 SQUASH PIPE

GRAVEL

MB

STA. 257+47

258+00

259+00

260+00

WOODS

PI
 261+06.42

TIE
 E&T
 COMBO

GUY

GRAVEL

SIGN
 PERSONAL BUSINESS
 (RETAIN)

SEE SHEET I29 FOR SPAN DETAIL

SPRUCE

POND

BORING
 B-126

COMBO

BM
 NAIL IN POLE
 ELV. 1037.97

3'-11' - 11' - 3'

STEEL BEAM GUARDRAIL
 GALVANIZED W/8 FEET POSTS
 257+78.25 ~ 258+98 RT

STEEL BEAM GUARDRAIL
GALVANIZED/NESTED W/8 FEET POSTS
 257+32 STA. 257+19 - STA. 257+39.75 RT 257+47
 257+72 STA. 257+89.75 - STA. 258+99.5 RT 257+78.25

HD STEEL BEAM GUARDRAIL
GALVANIZED/NESTED W/8 FEET POSTS
 STA. 257+39.75 - STA. 257+89.75 RT
 257+47 257+72

ANCHOR FOR STEEL BEAM RAIL
 STA. 257+19 RT 257+32
 STA. 259+00 RT
 258+98

DELINEATOR WITH STEEL POST
 STA. 257+19 RT
 STA. 259+00 RT

CURVE #24
 DELTA = 0°34'24"
 D = 0°34'23"
 R = 10000.00'
 T = 50.04'
 L = 100.08'
 E = 0.13'
 NORMAL CROWN (50 MPH)

- LEGEND**
- MAILBOX
 - BORING
 - SIGN
 - HYDRANT
 - MANHOLE
 - WATER SHUT OFF (WSO)
 - GAS PIPELINE MARKER
 - CATCH BASIN / DROP INLET
 - CURB INLET
 - ⊠ TRAFFIC CONTROL BOX
 - ⊕ PARKING METER
 - ⊔ UTILITY POLE

- SIGN LEGEND**
- R = REMOVE
 - R&S = REMOVE AND SALVAGE
 - RET = RETAIN
 - S = SALVAGE
 - N = NEW
 - B-B = BACK TO BACK

DATUM
 NAVD 88
 NAD 83

SCALE 1" = 20'-0"
 20 0 20

PROJECT LAYOUT SHEET 25

PROJECT NAME: NEWPORT-COVENTRY-NEWPORT
 PROJECT NUMBER: STP 2802(I)
 FILE NAME: 08b158.dgn
 PROJECT LEADER: CDL
 DESIGNED BY: BMB
 PLOT FILE: 08b158-52.I
 PLOT DATE: 8/3/2011
 DRAWN BY: BMB
 CHECKED BY: EPD
 SHEET 52 OF 134