

DURABLE 4 INCH WHITE LINE (SEE OPTION ITEMS)
 STA. 273+75 - STA. 276+66.00 (SOLID LT & RT)
 STA. 0+00 - STA. 2+75 (SOLID LT & RT)

TEMPORARY 4 INCH WHITE LINE, PAINT
 STA. 273+75 - STA. 276+66.00 (SOLID LT & RT)
 STA. 0+00 - STA. 2+75 (SOLID LT & RT)

REMOVING SIGNS
 AS SHOWN - 2

DURABLE 4 INCH YELLOW LINE (SEE OPTION ITEMS)
 STA. 273+75 - STA. 275+75 (SOLID LT & RT)
 STA. 275+75 - STA. 276+66.00 (SOLID LT)
 STA. 275+75 - STA. 276+66.00 (DASHED RT)
 STA. 0+00 - STA. 2+75 (SOLID LT)
 STA. 0+00 - STA. 2+75 (DASHED RT)

TEMPORARY 4 INCH YELLOW LINE, PAINT
 STA. 273+75 - STA. 275+75 (SOLID LT & RT)
 STA. 275+75 - STA. 276+66.00 (SOLID LT)
 STA. 275+75 - STA. 276+66.00 (DASHED RT)
 STA. 0+00 - STA. 2+75 (SOLID LT)
 STA. 0+00 - STA. 2+75 (DASHED RT)

CURVE #1
 DELTA = 1°45'49"
 D = 0°54'34"
 R = 6300.00'
 T = 96.96'
 L = 193.91'
 BANKING 0.020 FT/FT
 150' RUNOFF (50 MPH)

CURVE #26
 DELTA = 2°01'38"
 D = 0°54'34"
 R = 6300.00'
 T = 111.47'
 L = 222.91'
 E = 0.99'
 BANKING 0.020 FT/FT
 150' RUNOFF (50 MPH)

RELOCATE MAILBOX, SINGLE SUPPORT
 STA. ++73 LT
 STA. ++76 LT
 I+75 LT


STONE FILL TYPE I
 2+50 LT

6 INCH UNDERDRAIN PIPE
 276+09 STA. 273+75 - STA. 276+66.00 LT
 STA. 0+00.00 - STA. ++33 LT 2+69 LT


605.20 UNDERDRAIN CARRIER PIPE
 STA. 273+75 LT 276+09 LT
 STA. 275+75 LT
 STA. 0+25 LT 0+57 LT

UNDERDRAIN FLUSHING BASIN
 STA. 273+75 LT
 STA. 275+75 LT 276+09 LT
 STA. 0+25 LT 0+57 LT

STA. 0+79.2
 CONTRACTOR SHALL PAY PARTICULAR ATTENTION TO EROSION PREVENTION AND SEDIMENTATION CONTROLS (STREAM CROSSING)

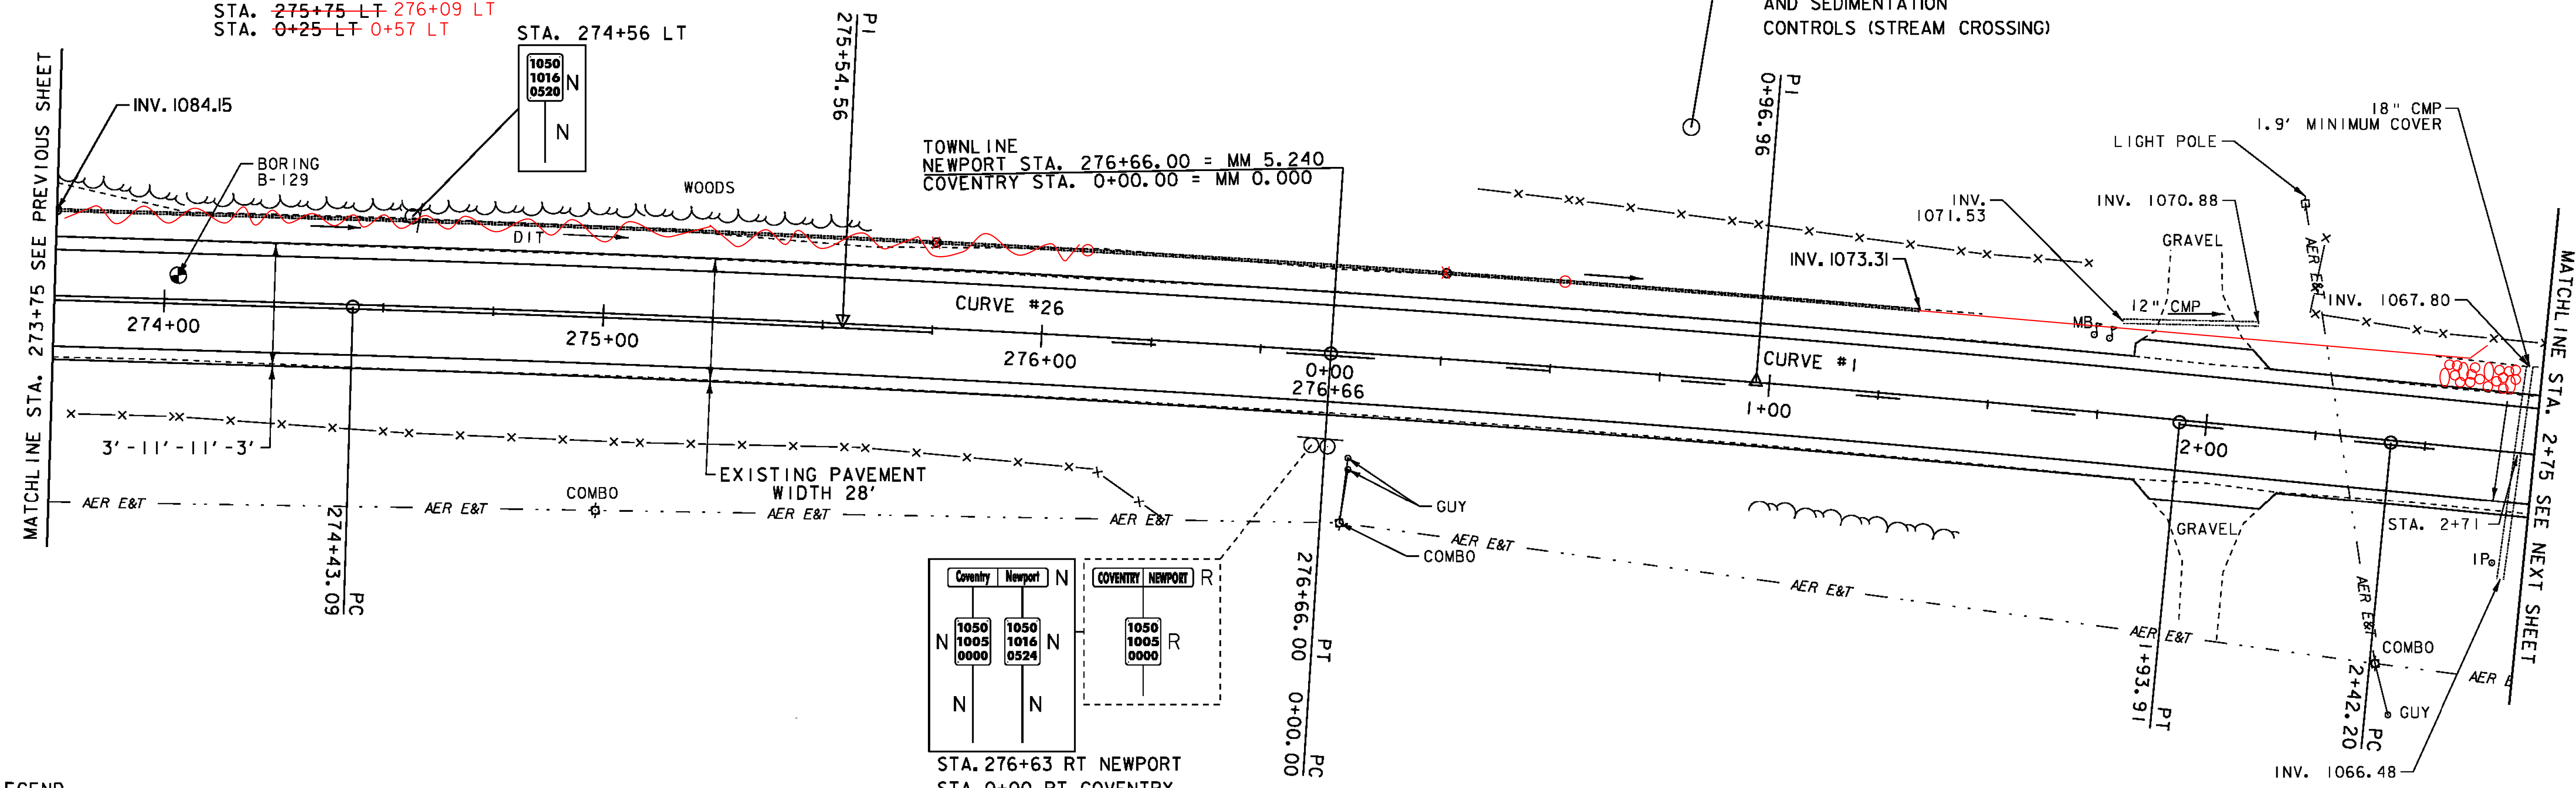

TOWNLINE
 NEWPORT STA. 276+66.00 = MM 5.240
 COVENTRY STA. 0+00.00 = MM 0.000

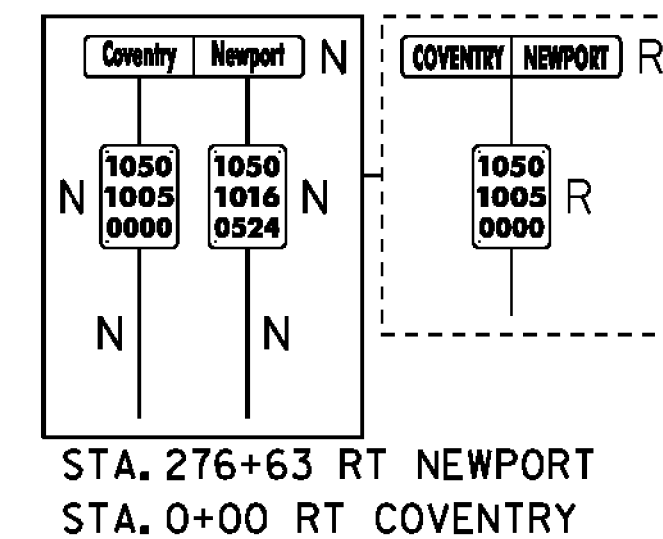

- LEGEND**
- MAILBOX
 - BORING
 - SIGN
 - HYDRANT
 - MANHOLE
 - WATER SHUT OFF (WSO)
 - GAS PIPELINE MARKER
 - CATCH BASIN / DROP INLET
 - CURB INLET
 - ⊠ TRAFFIC CONTROL BOX
 - ⊕ PARKING METER
 - ⊖ UTILITY POLE

- SIGN LEGEND**
- R = REMOVE
 - R&S = REMOVE AND SALVAGE
 - RET = RETAIN
 - S = SALVAGE
 - N = NEW
 - B-B = BACK TO BACK

DATUM
 NAVD 88
 NAD 83

SCALE 1" = 20'-0"
 20 0 20

PROJECT LAYOUT SHEET 28	PROJECT NAME: NEWPORT-COVENTRY-NEWPORT
	PROJECT NUMBER: STP 2802(I)
	FILE NAME: 08b158.dgn
	PLOT DATE: 8/3/2011
PROJECT LEADER: CDL	DRAWN BY: BMB
DESIGNED BY: BMB	CHECKED BY: EPD
PLOT FILE: 08b158-55.1	SHEET 55 OF 134