

DURABLE 4 INCH WHITE LINE (SEE OPTION ITEMS)  
 STA. 2+75 - STA. 8+50 (SOLID LT & RT)

TEMPORARY 4 INCH WHITE LINE, PAINT  
 STA. 2+75 - STA. 8+50 (SOLID LT & RT)

DURABLE 4 INCH YELLOW LINE (SEE OPTION ITEMS)  
 STA. 2+75 - STA. 6+25 (SOLID LT)  
 STA. 2+75 - STA. 6+25 (DASHED RT)  
 STA. 6+25 - STA. 8+50 (DASHED LT)  
 STA. 6+25 - STA. 8+50 (SOLID RT)

TEMPORARY 4 INCH YELLOW LINE, PAINT  
 STA. 2+75 - STA. 6+25 (SOLID LT)  
 STA. 2+75 - STA. 6+25 (DASHED RT)  
 STA. 6+25 - STA. 8+50 (DASHED LT)  
 STA. 6+25 - STA. 8+50 (SOLID RT)

CURVE #2  
 DELTA = 0°37'26"  
 D = 0°34'23"  
 R = 10000.00'  
 T = 54.46'  
 L = 108.91'  
 NORMAL CROWN

HVCNTRL 26  
 #5 REBAR  
 N: 886243.47  
 E: 1700692.40  
 EL: 1070.16

6 INCH UNDERDRAIN PIPE

STA. ~~3+60~~ - STA. ~~5+58~~ LT 3+58 ~ 5+54 LT  
 STA. 5+70 - STA. 7+00 LT 7+06 LT

6 INCH UNDERDRAIN CARRIER PIPE


STA. ~~3+60~~ LT 3+58 LT  
 STA. 7+00 LT

UNDERDRAIN FLUSHING BASIN

STA. ~~3+60~~ LT 3+58 LT  
 STA. 7+00 LT 7+06 LT

STONE FILL, TYPE I

STA. ~~7+75~~ - STA. ~~8+50~~ RT  
 5+60 LT

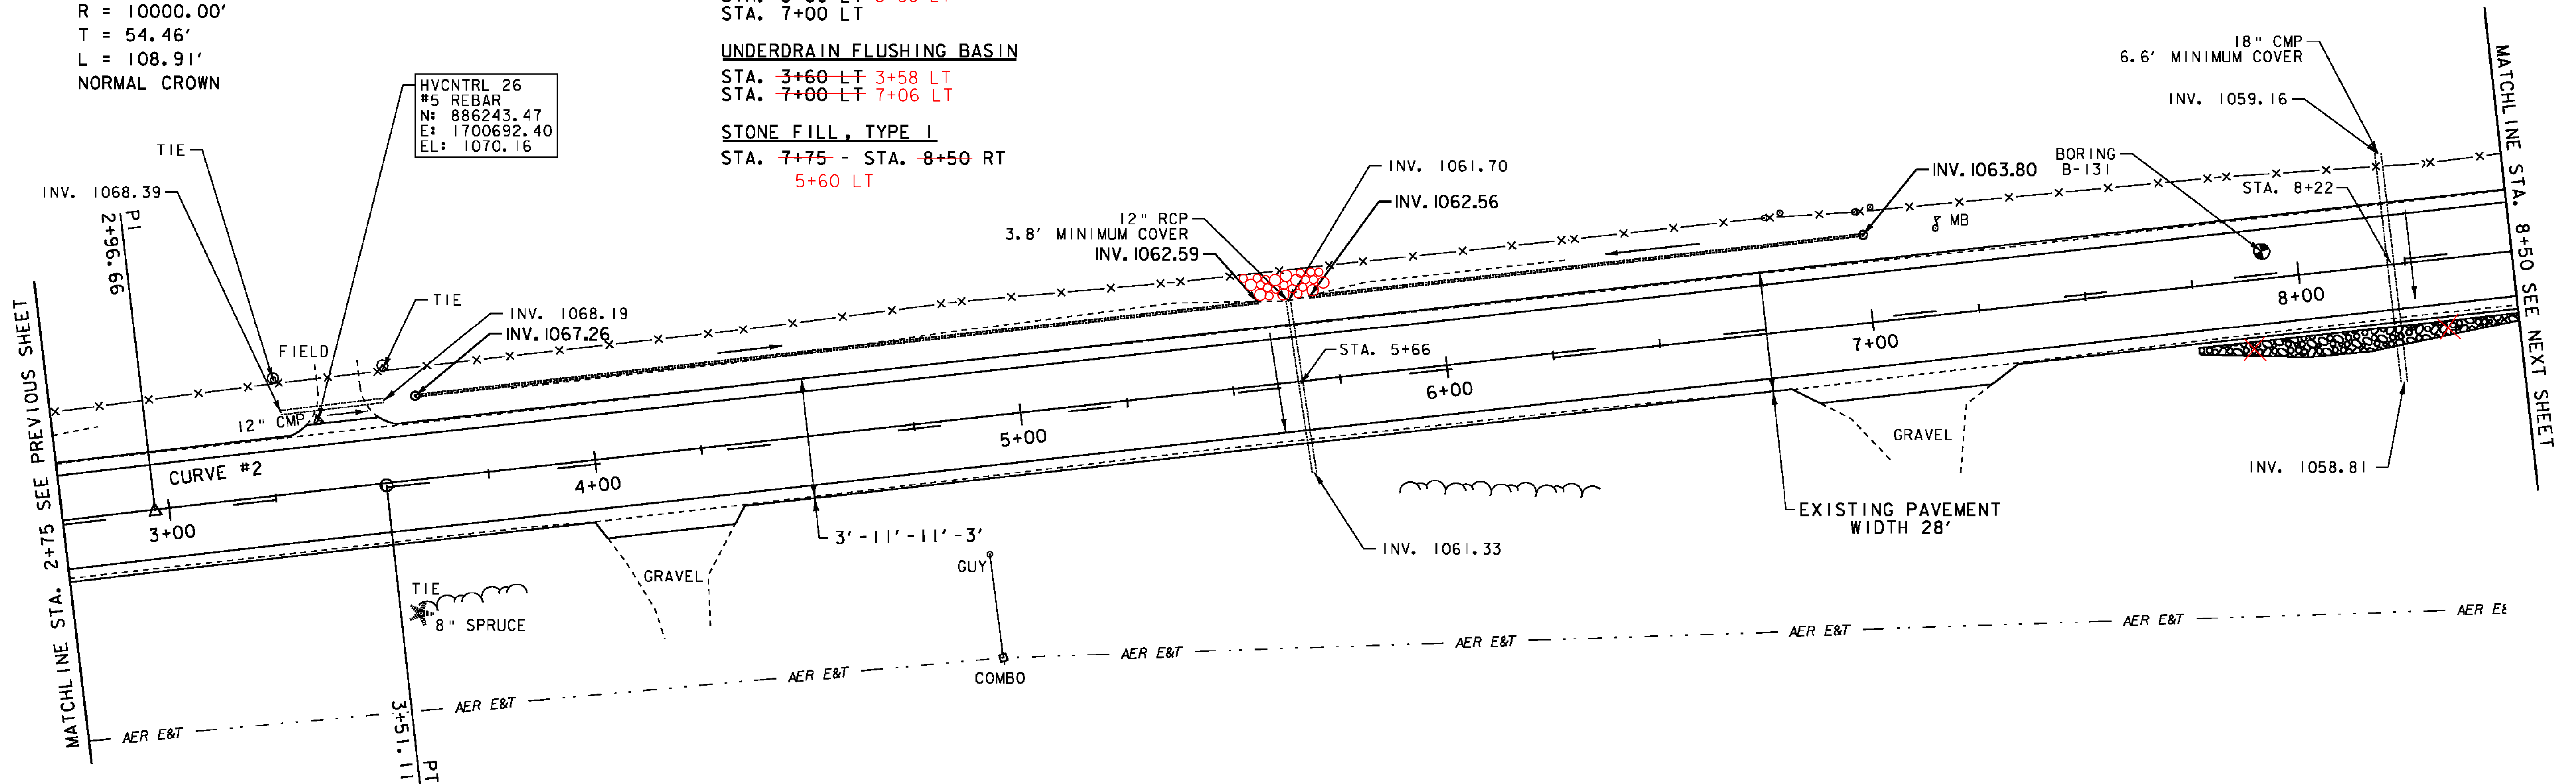

- LEGEND**
- MAILBOX
  - BORING
  - SIGN
  - HYDRANT
  - MANHOLE
  - WATER SHUT OFF (WSO)
  - GAS PIPELINE MARKER
  - CATCH BASIN / DROP INLET
  - CURB INLET
  - ⊠ TRAFFIC CONTROL BOX
  - ⊕ PARKING METER
  - ⊖ UTILITY POLE

- SIGN LEGEND**
- R = REMOVE
  - R&S = REMOVE AND SALVAGE
  - RET = RETAIN
  - S = SALVAGE
  - N = NEW
  - B-B = BACK TO BACK

DATUM  
 NAVD 88  
 NAD 83

SCALE 1" = 20'-0"  
 20 0 20

**PROJECT LAYOUT SHEET 29**

PROJECT NAME: NEWPORT-COVENTRY-NEWPORT  
 PROJECT NUMBER: STP 2802(1)  
 FILE NAME: 08b158.dgn  
 PROJECT LEADER: CDL  
 DESIGNED BY: BMB  
 PLOT FILE: 08b158-56.1  
 PLOT DATE: 8/3/2011  
 DRAWN BY: BMB  
 CHECKED BY: EPD  
 SHEET 56 OF 134