

DURABLE 4 INCH WHITE LINE (SEE OPTION ITEMS)  
 STA. 20+25 - STA. 25+75 (SOLID LT & RT)

DURABLE 4 INCH YELLOW LINE (SEE OPTION ITEMS)  
 STA. 20+25 - STA. 25+75 (SOLID LT & RT)


TEMPORARY 4 INCH WHITE LINE, PAINT  
 STA. 20+25 - STA. 25+75 (SOLID LT & RT)

TEMPORARY 4 INCH YELLOW LINE, PAINT  
 STA. 20+25 - STA. 25+75 (SOLID LT & RT)

6 INCH UNDERDRAIN PIPE  
 STA. 24+55 - STA. 25+75 LT  
 23+95

STONE FILL, TYPE I  
 STA. 21+50 - STA. 24+25 LT

RELOCATE MAILBOX, SINGLE SUPPORT  
~~STA. 24+94 LT~~  
~~STA. 24+96 LT~~

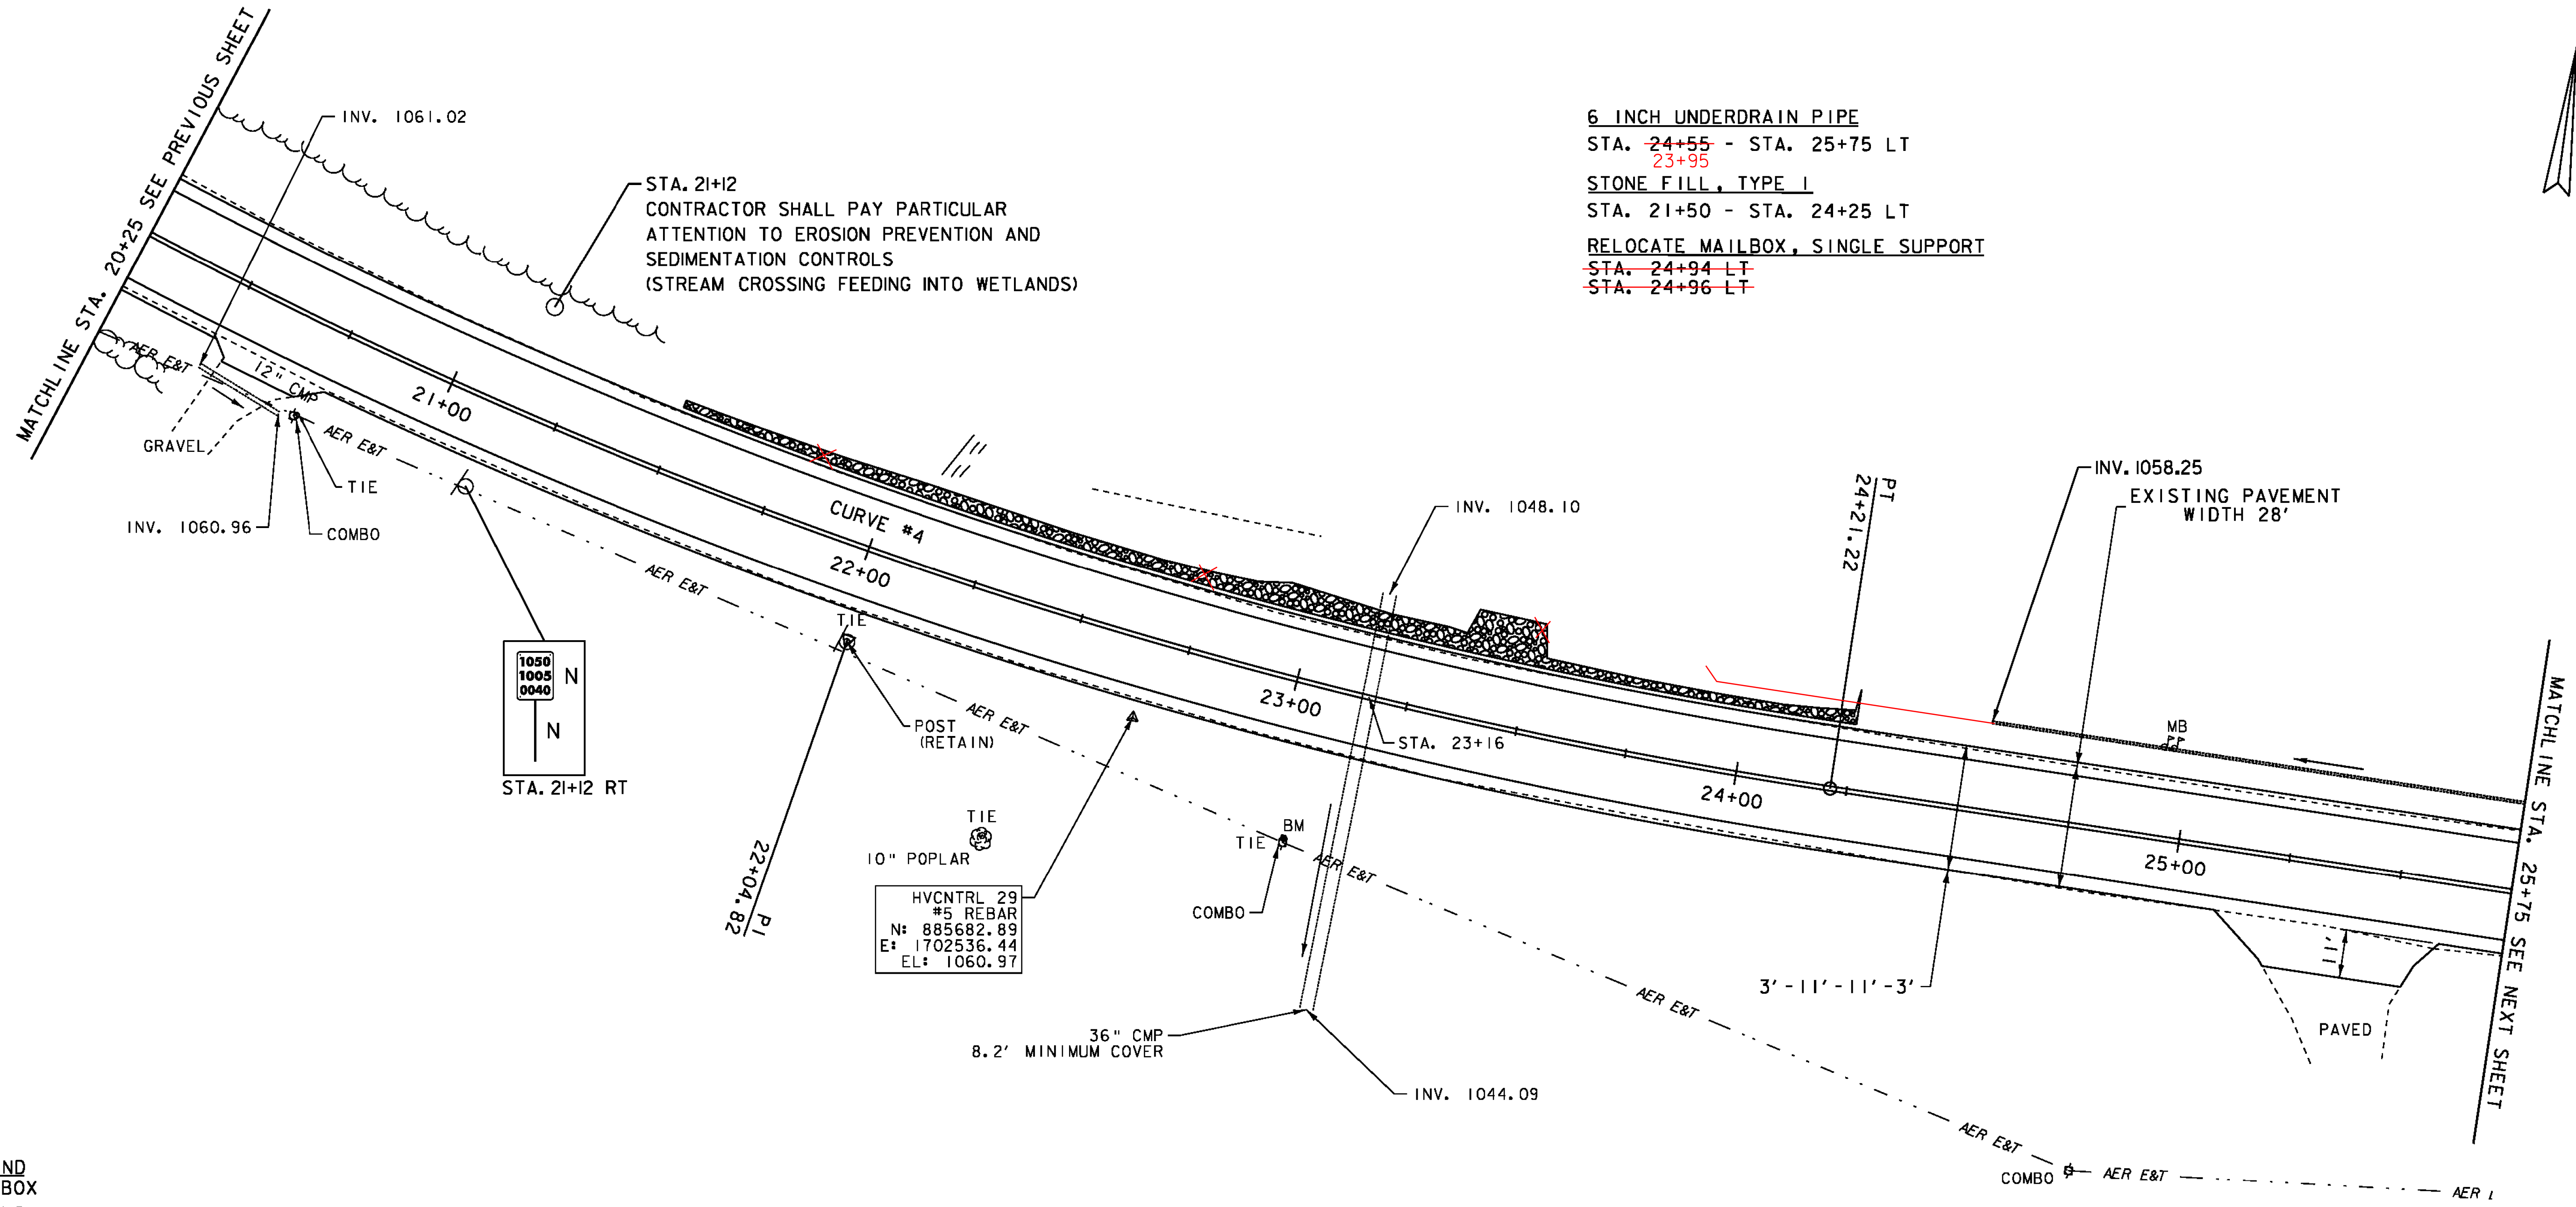

STA. 21+12  
 CONTRACTOR SHALL PAY PARTICULAR  
 ATTENTION TO EROSION PREVENTION AND  
 SEDIMENTATION CONTROLS  
 (STREAM CROSSING FEEDING INTO WETLANDS)

HVCNTRL 29  
 #5 REBAR  
 N: 885682.89  
 E: 1702536.44  
 EL: 1060.97

1050  
 1005  
 0040  
 N  
 N  
 STA. 21+12 RT

CURVE #4  
 DELTA = 21°21'17"  
 D = 4°52'34"  
 R = 1175.00'  
 T = 221.54'  
 L = 437.93'  
 BANKING 0.070 FT/FT  
 170' RUNOFF (50 MPH)

- LEGEND**
- MAILBOX
  - BORING
  - SIGN
  - HYDRANT
  - MANHOLE
  - WATER SHUT OFF (WSO)
  - GAS PIPELINE MARKER
  - CATCH BASIN / DROP INLET
  - CURB INLET
  - TRAFFIC CONTROL BOX
  - ⊕ PARKING METER
  - UTILITY POLE

- SIGN LEGEND**
- R = REMOVE
  - R&S = REMOVE AND SALVAGE
  - RET = RETAIN
  - S = SALVAGE
  - N = NEW
  - B-B = BACK TO BACK

DATUM  
 NAVD 88  
 NAD 83

SCALE 1" = 20'-0"  
 20 0 20

<b>PROJECT LAYOUT SHEET 32</b>	PROJECT NAME: NEWPORT-COVENTRY-NEWPORT	PLOT DATE: 8/3/2011
	PROJECT NUMBER: STP 2802(I)	DRAWN BY: BMB
	FILE NAME: 08b158.dgn	CHECKED BY: EPD
	DESIGNED BY: BMB	SHEET 59 OF 134
	PLOT FILE: 08b158-59.I	