


DURABLE 4 INCH WHITE LINE (SEE OPTION ITEMS)  
 STA. 31+50 - STA. 37+25 (SOLID LT & RT)  
DURABLE 4 INCH YELLOW LINE (SEE OPTION ITEMS)  
 STA. 31+50 - STA. 37+25 (SOLID LT & RT)

TEMPORARY 4 INCH WHITE LINE, PAINT  
 STA. 31+50 - STA. 37+25 (SOLID LT & RT)  
TEMPORARY 4 INCH YELLOW LINE, PAINT  
 STA. 31+50 - STA. 37+25 (SOLID LT & RT)

REMOVING SIGNS  
 AS SHOWN - 3

STONE FILL, TYPE I  
 STA. ~~34+75~~ - STA. ~~35+25~~ LT  
 35+00 LT

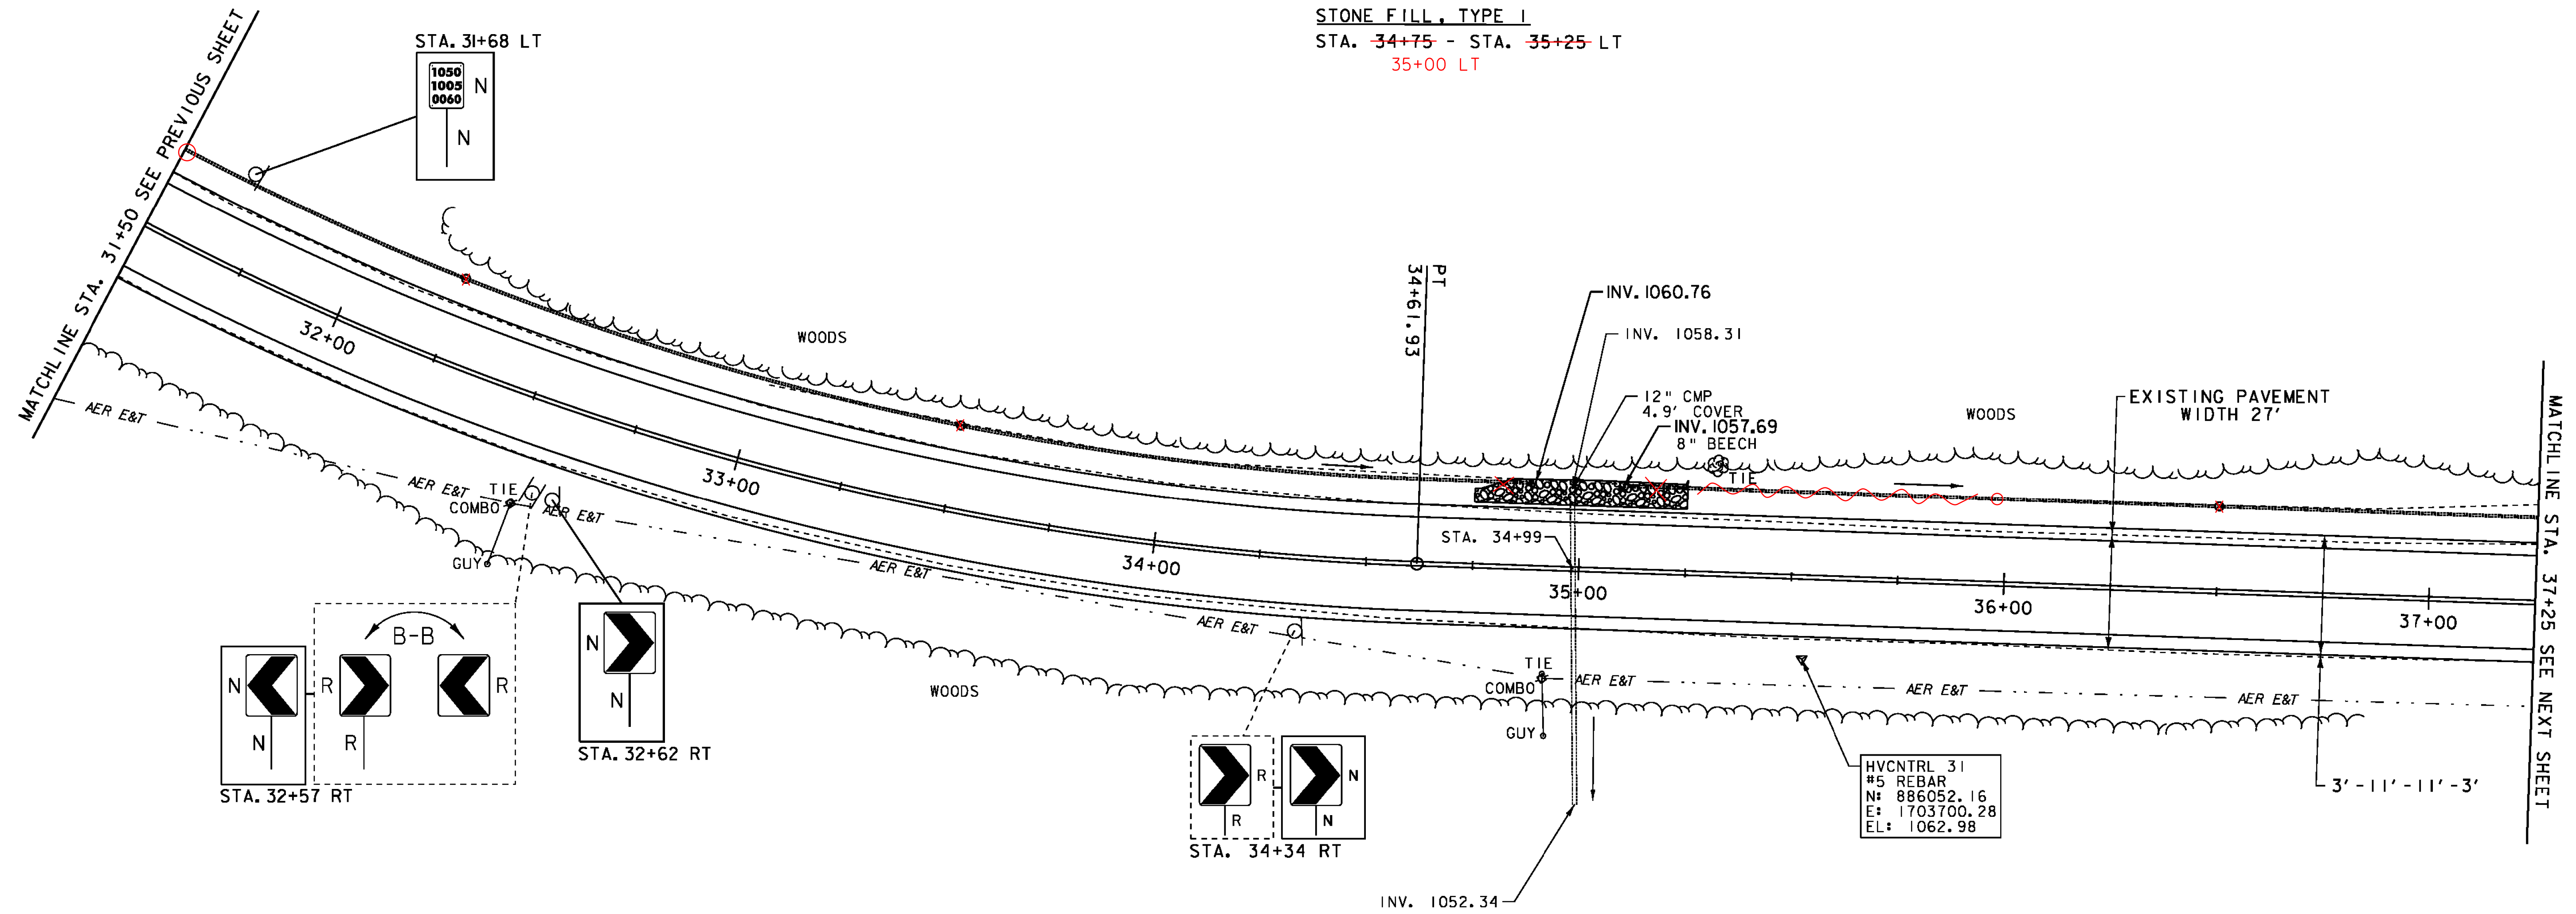

6 INCH UNDERDRAIN PIPE  
 STA. 31+50 - STA. ~~34+89~~ LT 34+78 LT  
 STA. ~~35+10~~ - STA. 37+25 LT  
 35+98

6 INCH UNDERDRAIN CARRIER PIPE  
 STA. ~~32+25~~ LT 31+50 LT  
 STA. ~~33+50~~ LT  
 STA. ~~35+10~~ LT 35+98 LT  
 STA. ~~36+50~~ LT

UNDERDRAIN FLUSHING BASIN  
 STA. ~~32+25~~ LT 31+50 LT  
 STA. ~~33+50~~ LT  
 STA. ~~35+10~~ LT 35+98 LT  
 STA. ~~36+50~~ LT

- LEGEND**
- MAILBOX
  - BORING
  - SIGN
  - HYDRANT
  - MANHOLE
  - WATER SHUT OFF (WSO)
  - GAS PIPELINE MARKER
  - CATCH BASIN / DROP INLET
  - CURB INLET
  - TRAFFIC CONTROL BOX
  - PARKING METER
  - UTILITY POLE

- SIGN LEGEND**
- R = REMOVE
  - R&S = REMOVE AND SALVAGE
  - RET = RETAIN
  - S = SALVAGE
  - N = NEW
  - B-B = BACK TO BACK

DATUM  
 NAVD 88  
 NAD 83

SCALE 1" = 20'-0"  
 20 0 20

**PROJECT LAYOUT SHEET 34**

PROJECT NAME: NEWPORT-COVENTRY-NEWPORT  
 PROJECT NUMBER: STP 2802(1)  
 FILE NAME: 08b158.dgn  
 PROJECT LEADER: CDL  
 DESIGNED BY: BMB  
 PLOT FILE: 08b158-61.I  
 PLOT DATE: 8/3/2011  
 DRAWN BY: BMB  
 CHECKED BY: EPD  
 SHEET 61 OF 134