

DURABLE 4 INCH WHITE LINE (SEE OPTION ITEMS)
 STA. 37+25 - STA. 42+75 (SOLID LT & RT)
DURABLE 4 INCH YELLOW LINE (SEE OPTION ITEMS)
 STA. 37+25 - STA. 42+75 (SOLID LT & RT)

TEMPORARY 4 INCH WHITE LINE, PAINT
 STA. 37+25 - STA. 42+75 (SOLID LT & RT)
TEMPORARY 4 INCH YELLOW LINE, PAINT
 STA. 37+25 - STA. 42+75 (SOLID LT & RT)

REMOVING SIGNS
 AS SHOWN - 1


6 INCH UNDERDRAIN PIPE
 STA. 37+25 - STA. ~~42+60~~ LT 42+20 LT

6 INCH UNDERDRAIN CARRIER PIPE
 STA. ~~38+50~~ LT 39+49 LT
 STA. ~~40+50~~ LT

UNDERDRAIN FLUSHING BASIN
 STA. ~~38+50~~ LT 39+49 LT
 STA. ~~40+50~~ LT

STONE FILL, TYPE I
 STA. ~~39+75~~ - STA. ~~40+25~~ RT 38+00 ~ 42+75 LT

RELOCATE MAILBOX, SINGLE SUPPORT
 STA. ~~38+19~~ LT

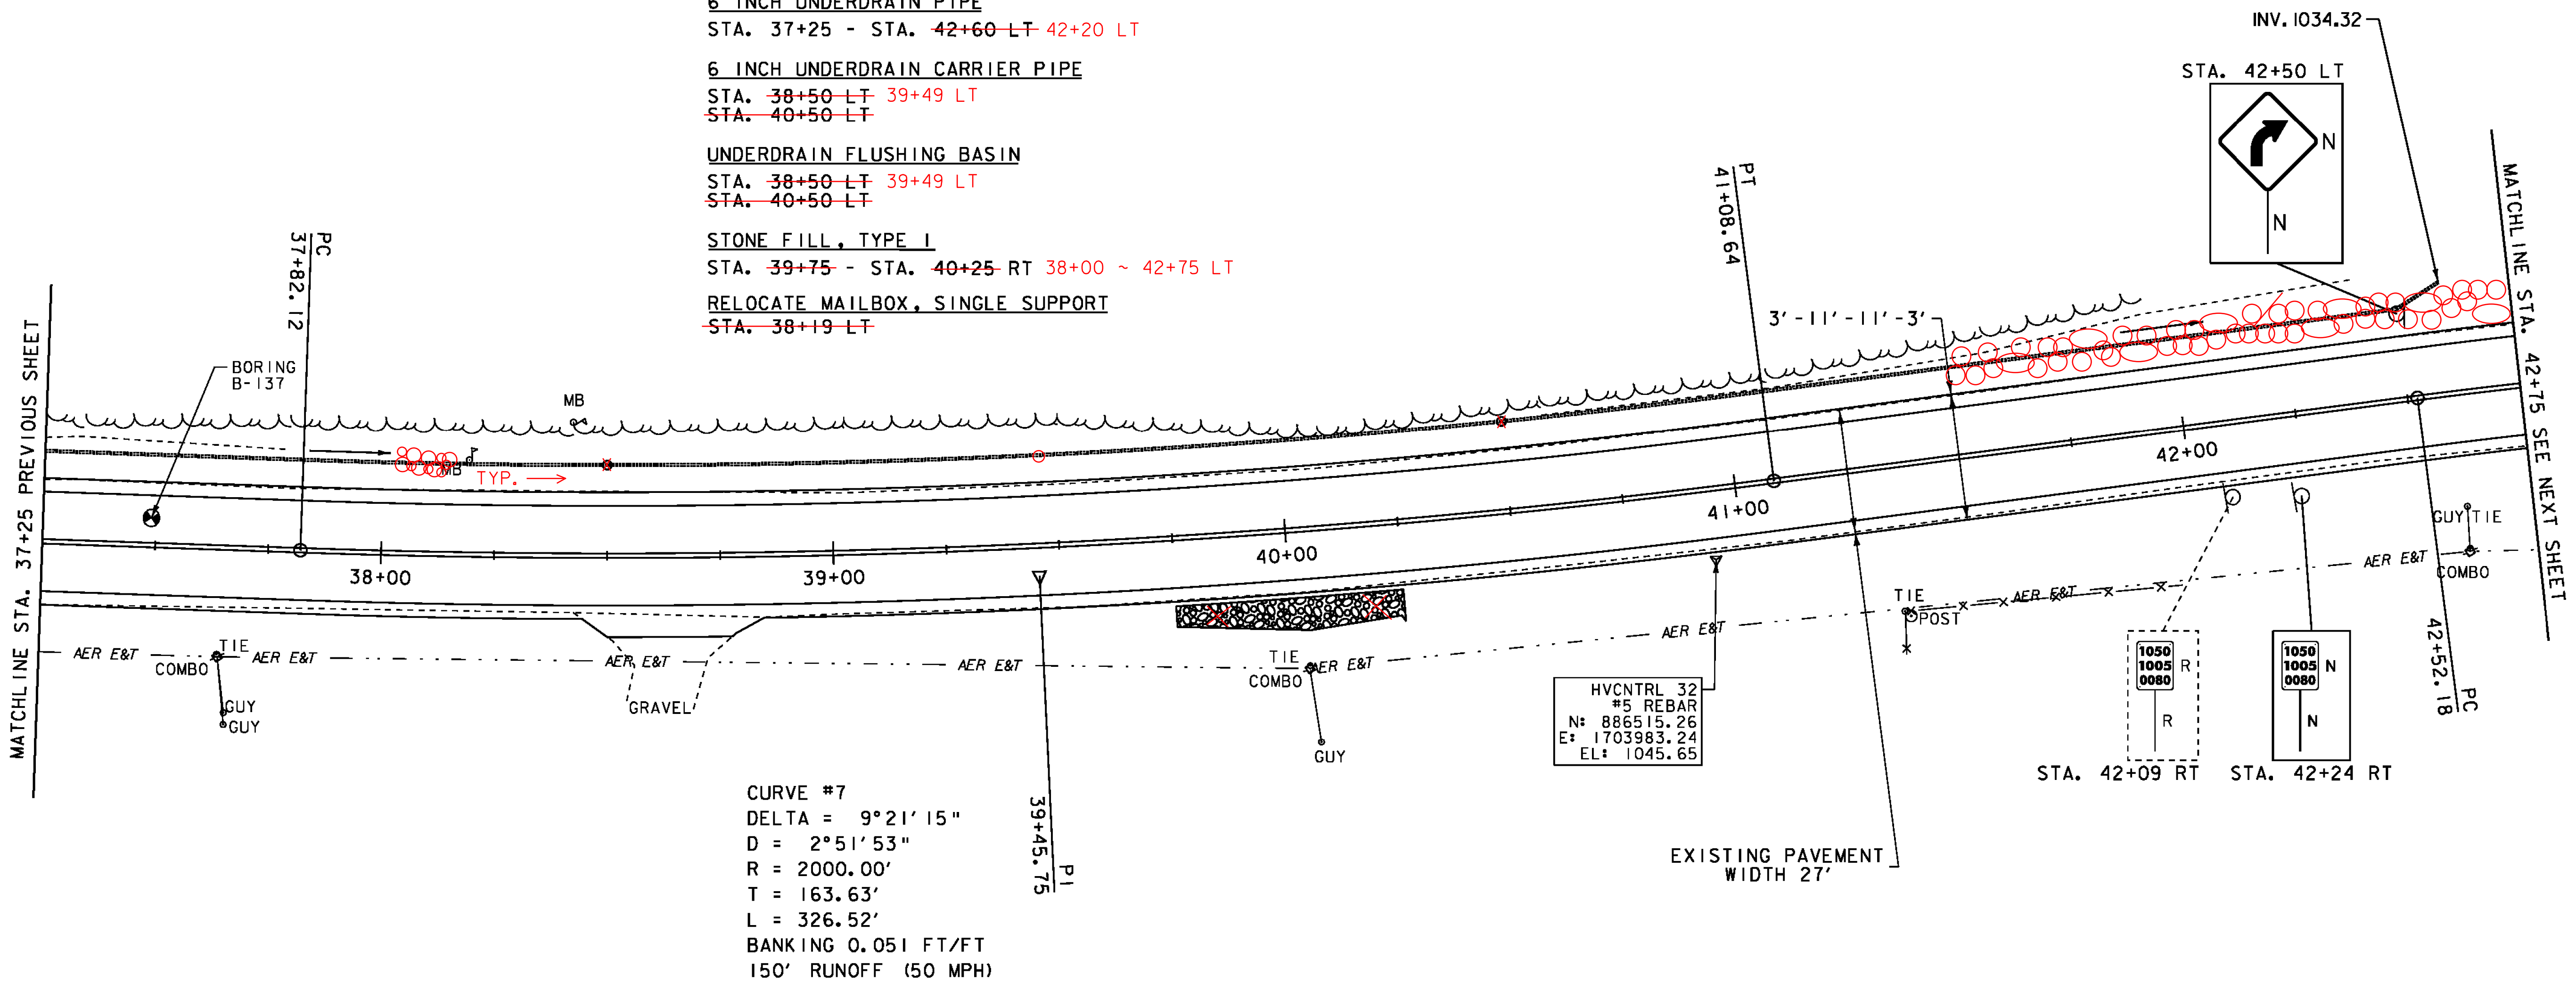

- LEGEND**
- MAILBOX
 - BORING
 - SIGN
 - HYDRANT
 - MANHOLE
 - WATER SHUT OFF (WSO)
 - GAS PIPELINE MARKER
 - CATCH BASIN / DROP INLET
 - CURB INLET
 - TRAFFIC CONTROL BOX
 - PARKING METER
 - UTILITY POLE

- SIGN LEGEND**
- R = REMOVE
 - R&S = REMOVE AND SALVAGE
 - RET = RETAIN
 - S = SALVAGE
 - N = NEW
 - B-B = BACK TO BACK

DATUM
 NAVD 88
 NAD 83

SCALE 1" = 20'-0"
 20 0 20

PROJECT LAYOUT SHEET 35	PROJECT NAME: NEWPORT-COVENTRY-NEWPORT
	PROJECT NUMBER: STP 2802(I)
	FILE NAME: 08b158.dgn
PROJECT LEADER: CDL	PLOT DATE: 8/3/2011
DESIGNED BY: BMB	DRAWN BY: BMB
PLOT FILE: 08b158-62.1	CHECKED BY: EPD
	SHEET 62 OF 134