


DURABLE 4 INCH WHITE LINE (SEE OPTION ITEMS)
 STA. 42+75 - STA. 48+50 (SOLID LT & RT)
 DURABLE 4 INCH YELLOW LINE (SEE OPTION ITEMS)
 STA. 42+75 - STA. 48+50 (SOLID LT & RT)


TEMPORARY 4 INCH WHITE LINE, PAINT
 STA. 42+75 - STA. 48+50 (SOLID LT & RT)
 TEMPORARY 4 INCH YELLOW LINE, PAINT
 STA. 42+75 - STA. 48+50 (SOLID LT & RT)

REMOVING SIGNS
 AS SHOWN - 1

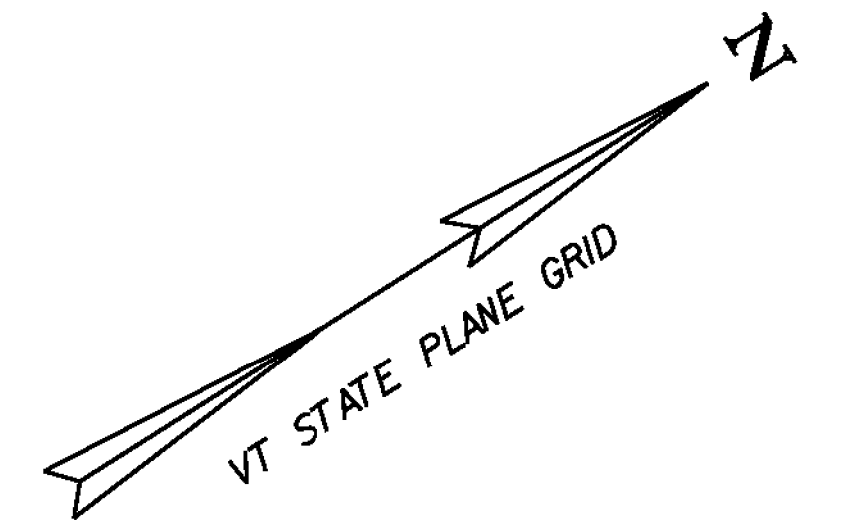

CURVE #8
 DELTA = 12°28'56"
 D = 4°05'33"
 R = 1400.00'
 T = 153.10'
 L = 305.00'
 BANKING 0.064 FT/FT
 150' RUNOFF (50 MPH)

RELOCATE MAILBOX, SINGLE SUPPORT
 STA. 47+46 LT

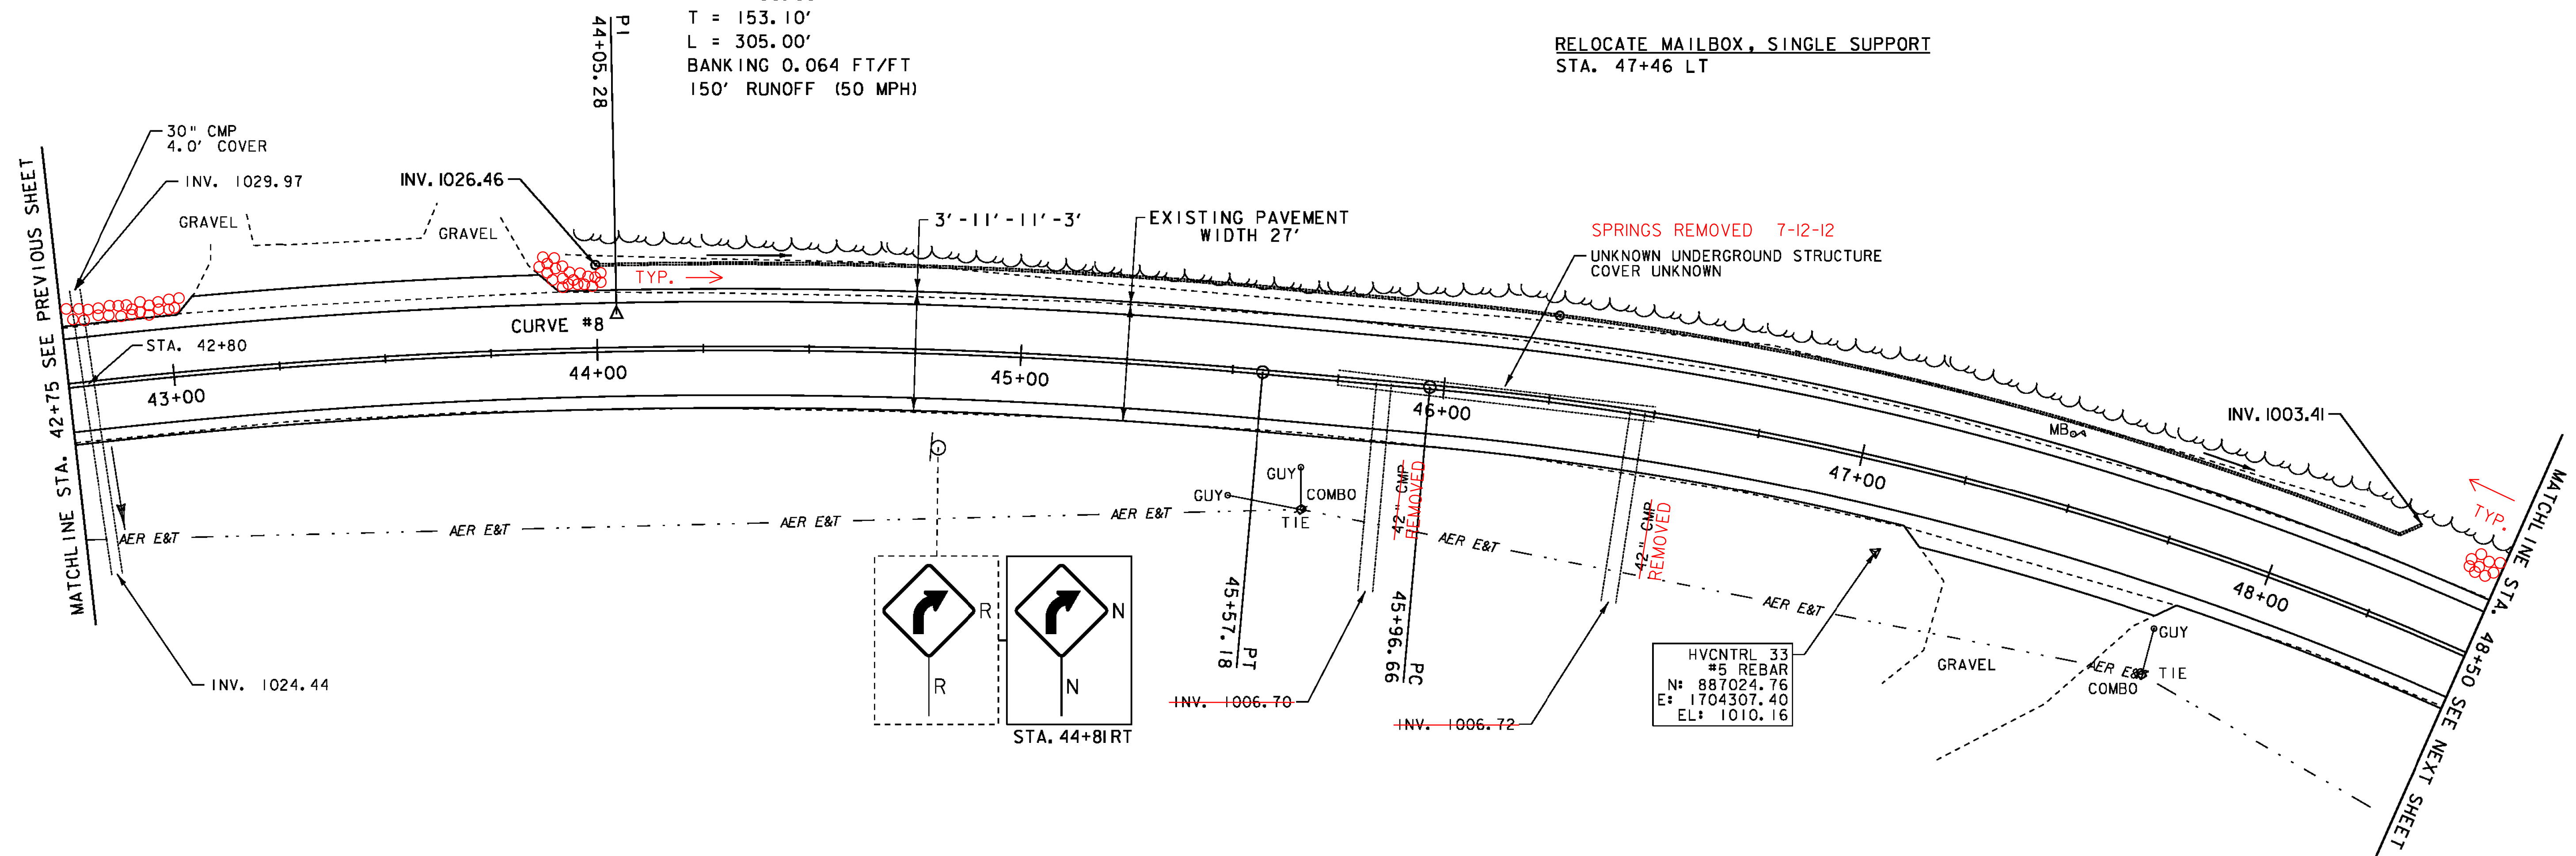

6 INCH UNDERDRAIN PIPE
 STA. ~~44+00~~ - STA. ~~48+29~~ LT
 43+95 49+01

6 INCH UNDERDRAIN CARRIER PIPE
 STA. 44+00 LT
 STA. 46+25 LT

UNDERDRAIN FLUSHING BASIN
 STA. ~~44+00~~ LT 43+95
 STA. 46+25 LT

STONE FILL TYPE I
 42+75 ~ 48+50 LT

- LEGEND**
- MAILBOX
 - BORING
 - SIGN
 - HYDRANT
 - MANHOLE
 - WATER SHUT OFF (WSO)
 - GAS PIPELINE MARKER
 - CATCH BASIN / DROP INLET
 - CURB INLET
 - TRAFFIC CONTROL BOX
 - PARKING METER
 - UTILITY POLE

- SIGN LEGEND**
- R = REMOVE
 - R&S = REMOVE AND SALVAGE
 - RET = RETAIN
 - S = SALVAGE
 - N = NEW
 - B-B = BACK TO BACK

DATUM
 NAVD 88
 NAD 83

SCALE 1" = 20'-0"
 20 0 20

PROJECT LAYOUT SHEET 36

PROJECT NAME: NEWPORT-COVENTRY-NEWPORT

PROJECT NUMBER: STP 2802(1)

FILE NAME: 08b158.dgn

PROJECT LEADER: CDL

DESIGNED BY: BMB

PLOT FILE: 08b158-63.1

PLOT DATE: 8/3/2011

DRAWN BY: BMB

CHECKED BY: EPD

SHEET 63 OF 134