

DURABLE 4 INCH WHITE LINE (SEE OPTION ITEMS)
 STA. 48+50 - STA. 54+25 (SOLID LT & RT)
 (WITH EDGELINE BREAKS AT TOWN ROADS)

DURABLE 4 INCH YELLOW LINE (SEE OPTION ITEMS)
 STA. 48+50 - STA. 54+25 (SOLID LT & RT)

TEMPORARY 4 INCH WHITE LINE, PAINT
 STA. 48+50 - STA. 54+25 (SOLID LT & RT)
 (WITH EDGELINE BREAKS AT TOWN ROADS)


TEMPORARY 4 INCH YELLOW LINE, PAINT
 STA. 48+50 - STA. 54+25 (SOLID LT & RT)

REMOVING SIGNS
 AS SHOWN - 1

CURVE #9
 DELTA = 54°01'08"
 D = 7°23'35"
 R = 775.00'
 T = 395.04'
 L = 730.67'
 BANKING 0.080 FT/FT
 190' RUNOFF (50 MPH)

STONE FILL, TYPE 1
 STA. 53+25 - STA. 53+75 LT 48+50 ~ 51+75 LT

RELOCATE MAILBOX, SINGLE SUPPORT
 STA. 52+97 LT
 53+00

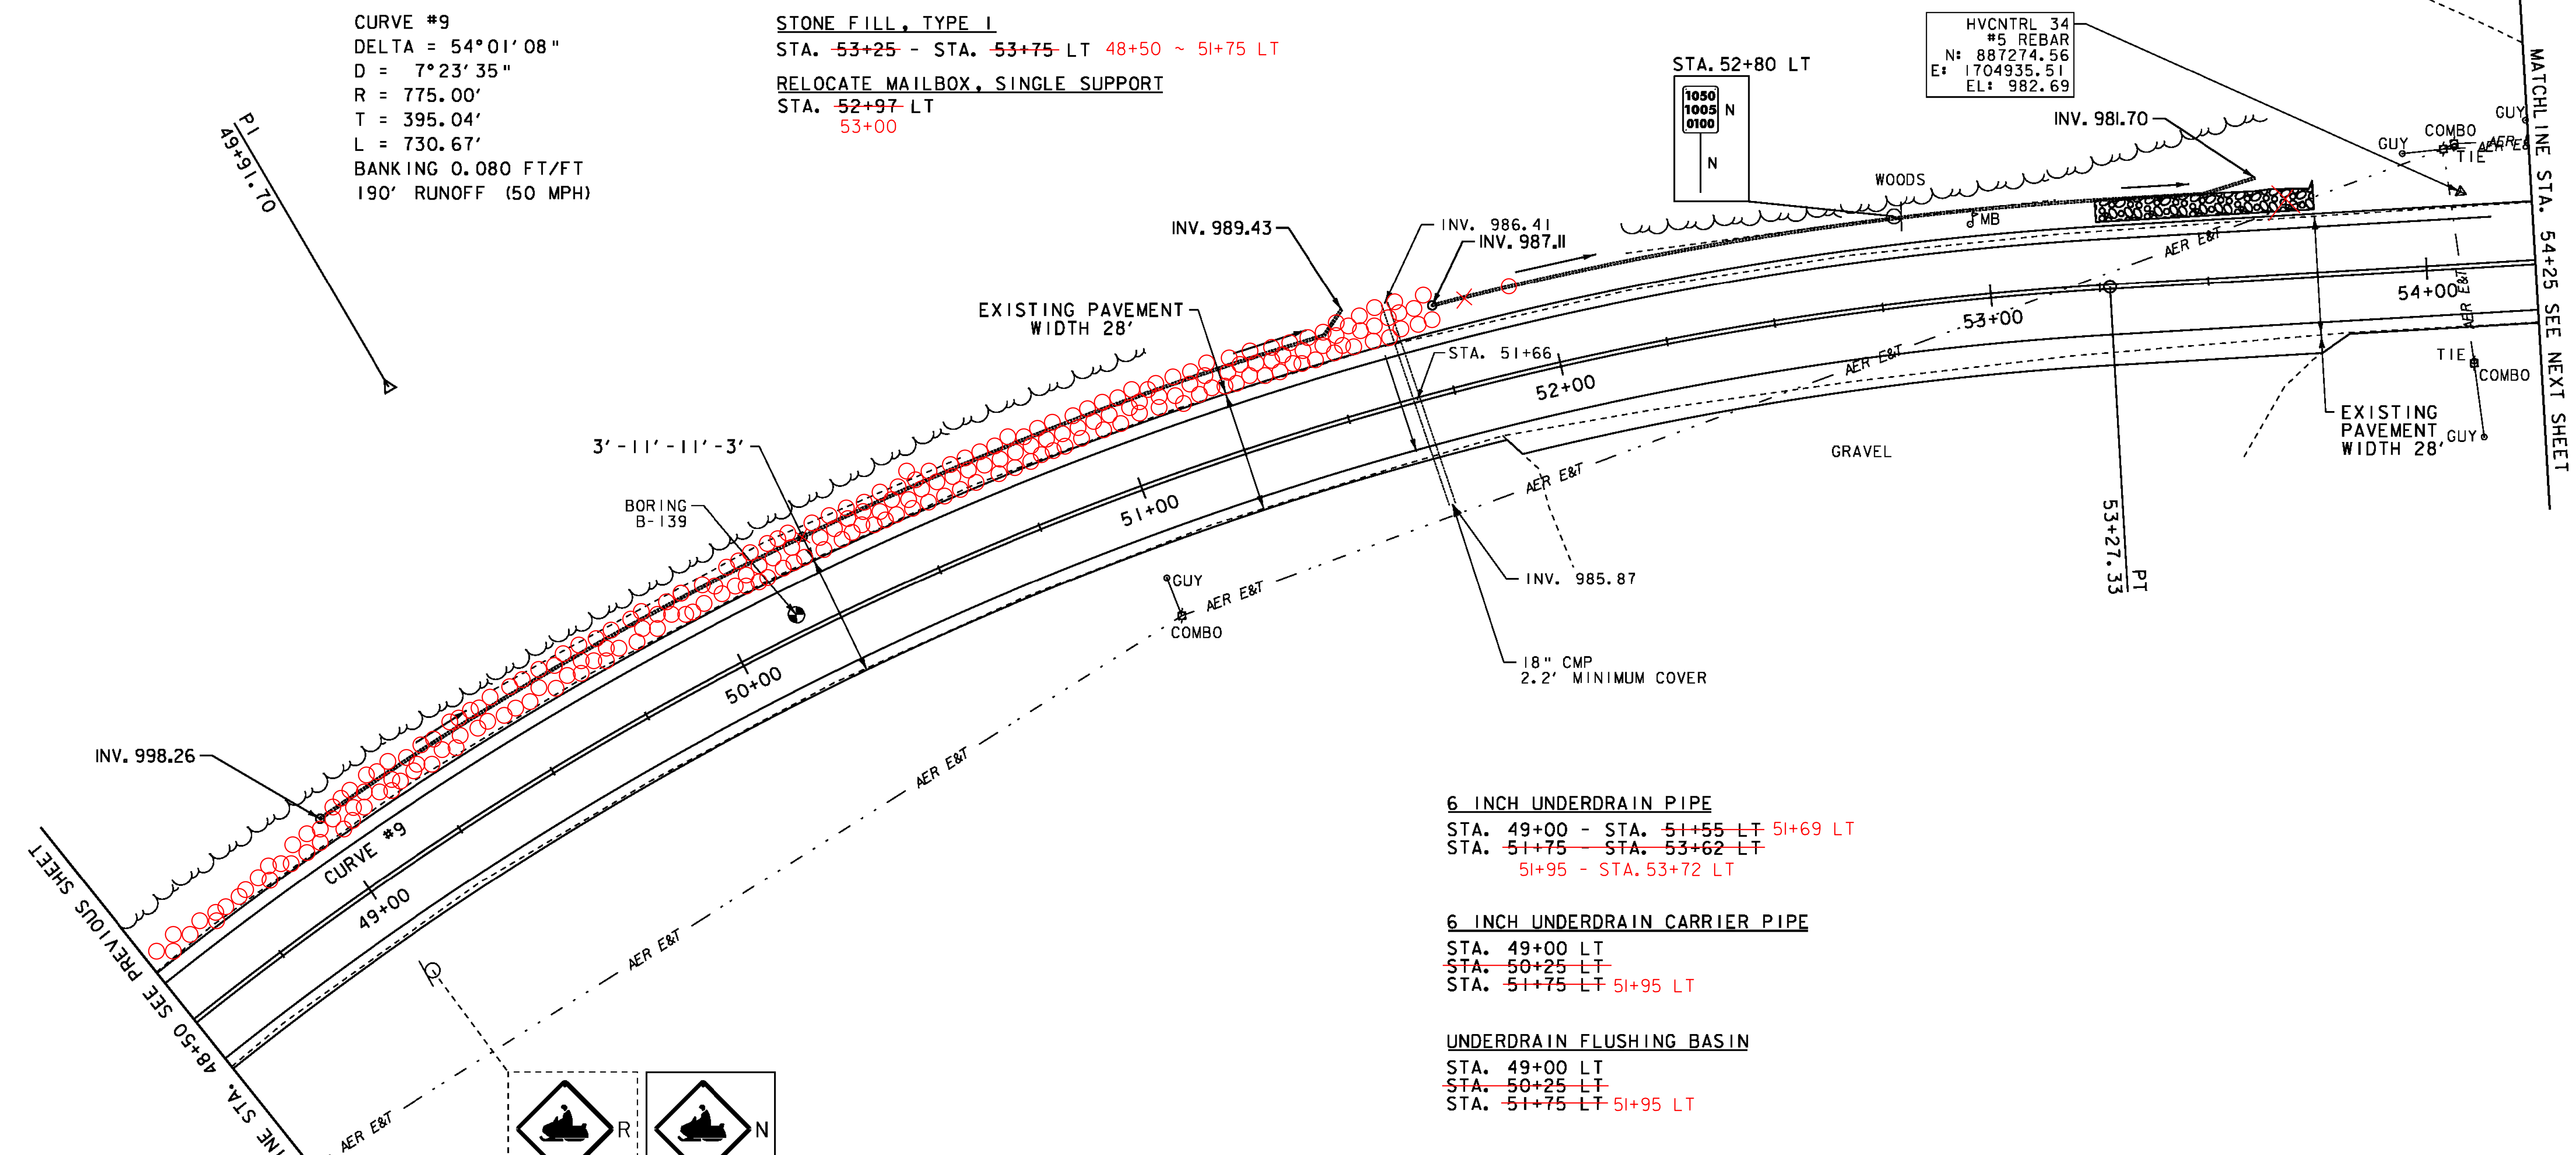

HVCNTRL 34
 #5 REBAR
 N: 887274.56
 E: 1704935.51
 EL: 982.69


1050
 1003
 0100
 N
 N

6 INCH UNDERDRAIN PIPE
 STA. 49+00 - STA. 51+55 LT 51+69 LT
 STA. 51+75 - STA. 53+62 LT
 51+95 - STA. 53+72 LT

6 INCH UNDERDRAIN CARRIER PIPE
 STA. 49+00 LT
 STA. 50+25 LT
 STA. 51+75 LT 51+95 LT

UNDERDRAIN FLUSHING BASIN
 STA. 49+00 LT
 STA. 50+25 LT
 STA. 51+75 LT 51+95 LT

- LEGEND**
- MAILBOX
 - BORING
 - SIGN
 - HYDRANT
 - MANHOLE
 - WATER SHUT OFF (WSO)
 - GAS PIPELINE MARKER
 - CATCH BASIN / DROP INLET
 - CURB INLET
 - TRAFFIC CONTROL BOX
 - PARKING METER
 - UTILITY POLE

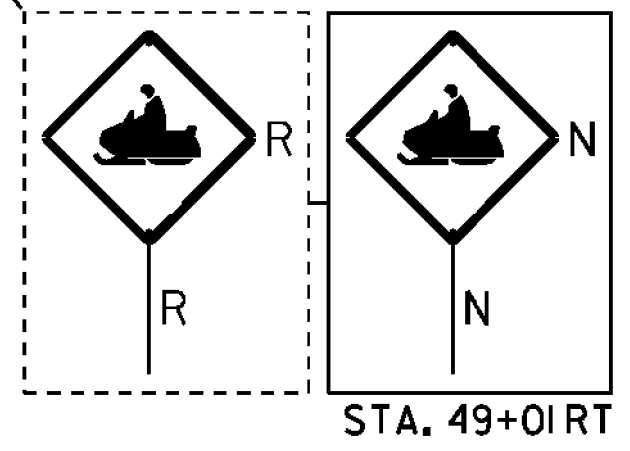


SIGN LEGEND

- R = REMOVE
- R&S = REMOVE AND SALVAGE
- RET = RETAIN
- S = SALVAGE
- N = NEW
- B-B = BACK TO BACK

DATUM

NAVD 88
 NAD 83

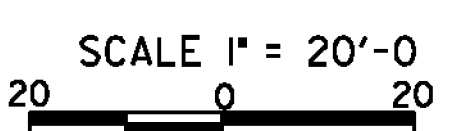

PROJECT LAYOUT SHEET 37

PROJECT NAME: NEWPORT-COVENTRY-NEWPORT
 PROJECT NUMBER: STP 2802(1)

FILE NAME: 08b158.dgn
 PROJECT LEADER: CDL
 DESIGNED BY: BMB
 PLOT FILE: 08b158-64.1

PLOT DATE: 8/3/2011
 DRAWN BY: BMB
 CHECKED BY: EPD
 SHEET 64 OF 134