

DURABLE 4 INCH WHITE LINE (SEE OPTION ITEMS)
 STA. 277+25 - STA. 282+75 (SOLID LT & RT)

TEMPORARY 4 INCH WHITE LINE, PAINT
 STA. 277+25 - STA. 282+75 (SOLID LT & RT)



REMOVING SIGNS
 AS SHOWN - 1

DURABLE 4 INCH YELLOW LINE (SEE OPTION ITEMS)
 STA. 277+25 - STA. 282+75 (SOLID LT & RT)

TEMPORARY 4 INCH YELLOW LINE, PAINT
 STA. 277+25 - STA. 282+75 (SOLID LT & RT)

RELOCATE MAILBOX, SINGLE SUPPORT
 277+40 LT

CURVE #27
 DELTA = 1°33'44"
 D = 1°08'45"
 R = 5000.00'
 T = 68.17'
 L = 136.33'
 BANKING 0.024 FT/FT
 150' RUNOFF (50 MPH)

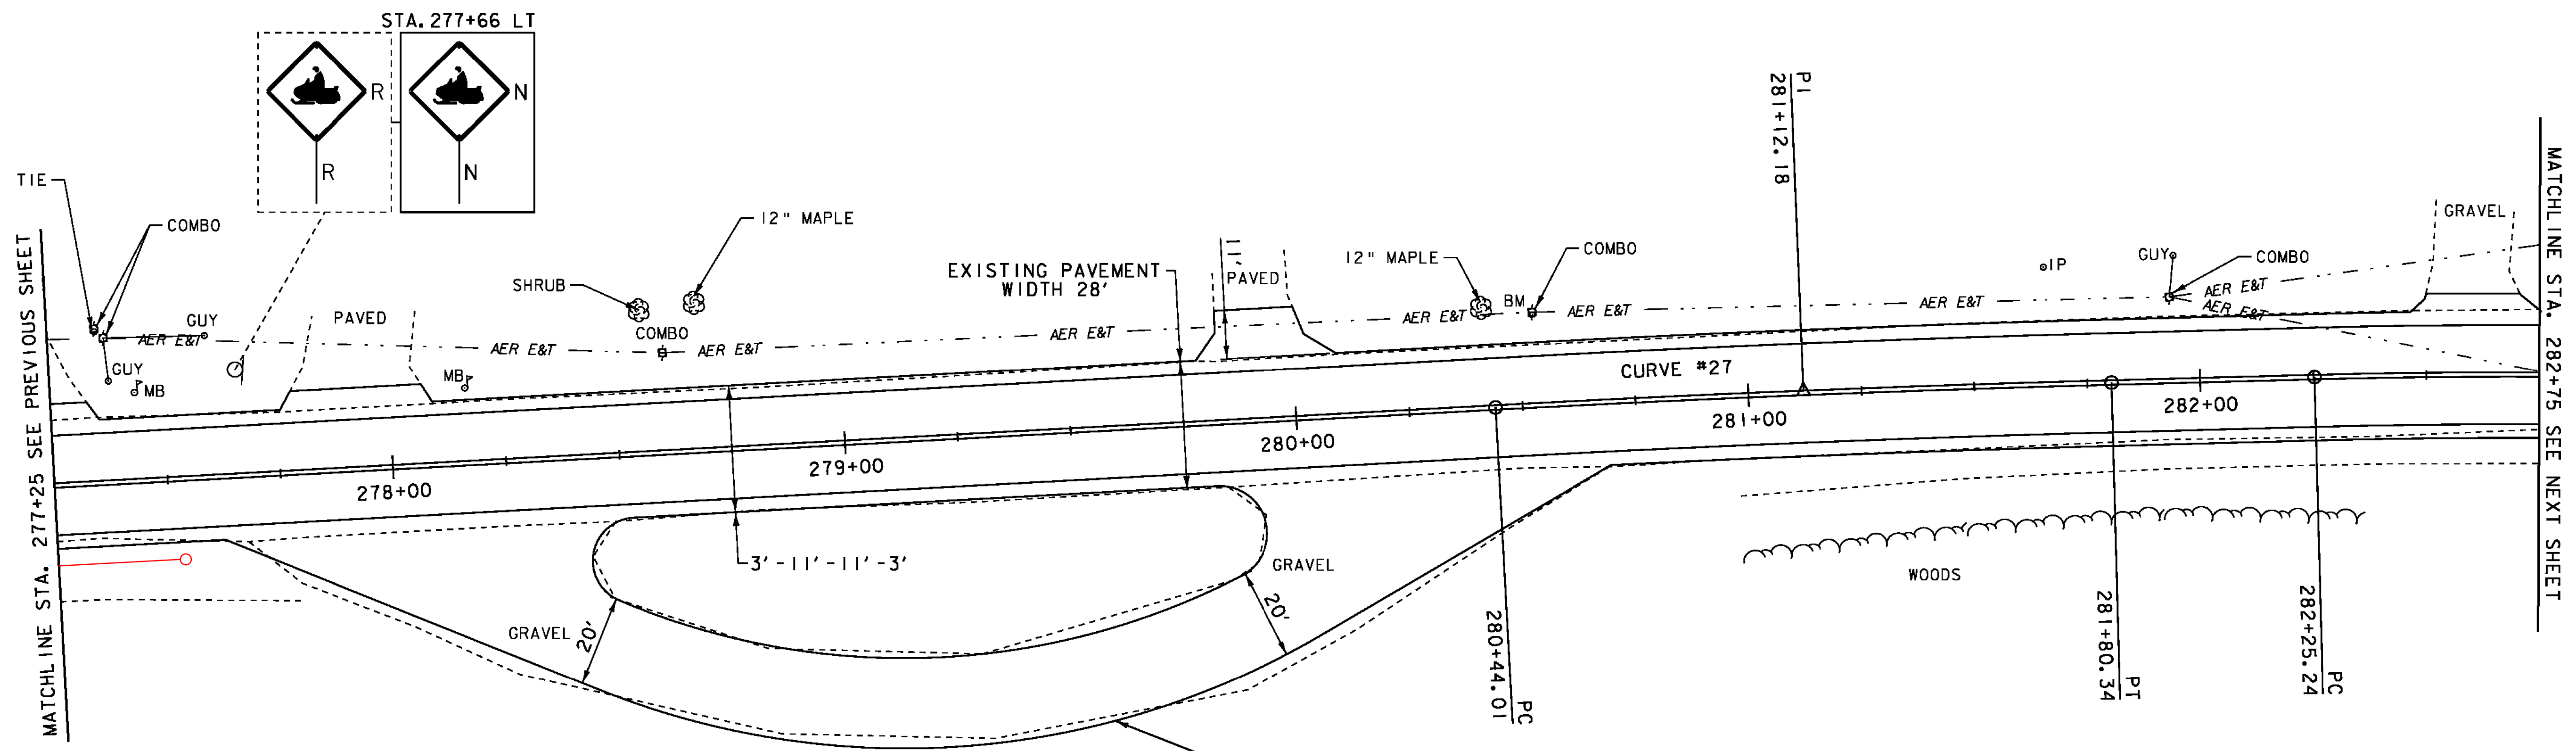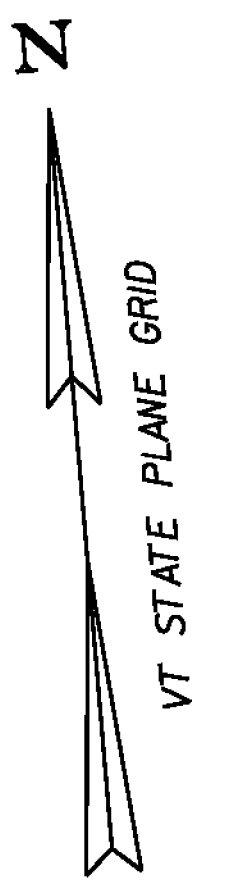

6 INCH UNDERDRAIN PIPE
 STA. 277+25 ~ 277+53 RT

6 INCH UNDERDRAIN CARRIER PIPE
 STA. 277+53 RT

UNDERDRAIN FLUSHING BASIN
 STA. 277+53 RT

PAVE EXISTING GRAVEL PULL OFF
 SEE SHEET 5 FOR DETAIL

- LEGEND**
- MAILBOX
 - BORING
 - SIGN
 - HYDRANT
 - MANHOLE
 - WATER SHUT OFF (WSO)
 - GAS PIPELINE MARKER
 - CATCH BASIN / DROP INLET
 - CURB INLET
 - ⊠ TRAFFIC CONTROL BOX
 - ⊕ PARKING METER
 - ⊖ UTILITY POLE

- SIGN LEGEND**
- R = REMOVE
 - R&S = REMOVE AND SALVAGE
 - RET = RETAIN
 - S = SALVAGE
 - N = NEW
 - B-B = BACK TO BACK

DATUM
 NAVD 88
 NAD 83



PROJECT LAYOUT SHEET 39

PROJECT NAME: NEWPORT-COVENTRY-NEWPORT	PLOT DATE: 8/3/2011
PROJECT NUMBER: STP 2802(1)	DRAWN BY: BMB
FILE NAME: 08b158.dgn	CHECKED BY: EPD
PROJECT LEADER: CDL	SHEET 66 OF 134
DESIGNED BY: BMB	
PLOT FILE: 08b158-66.1	