




148+80

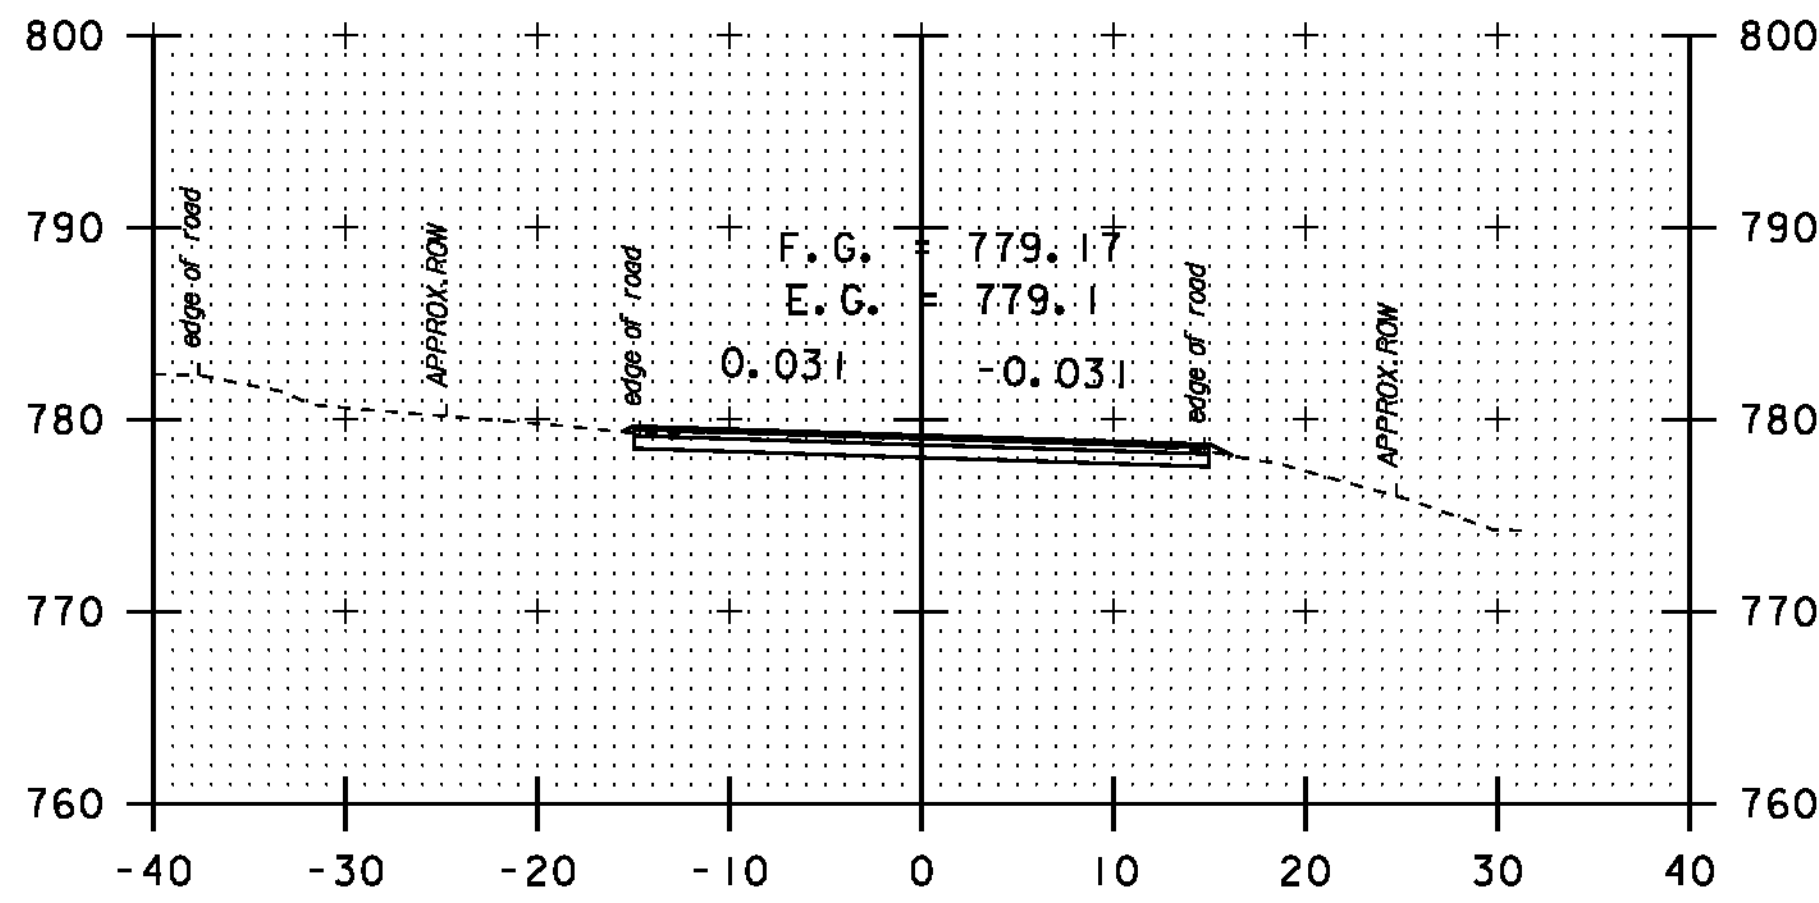


150+62

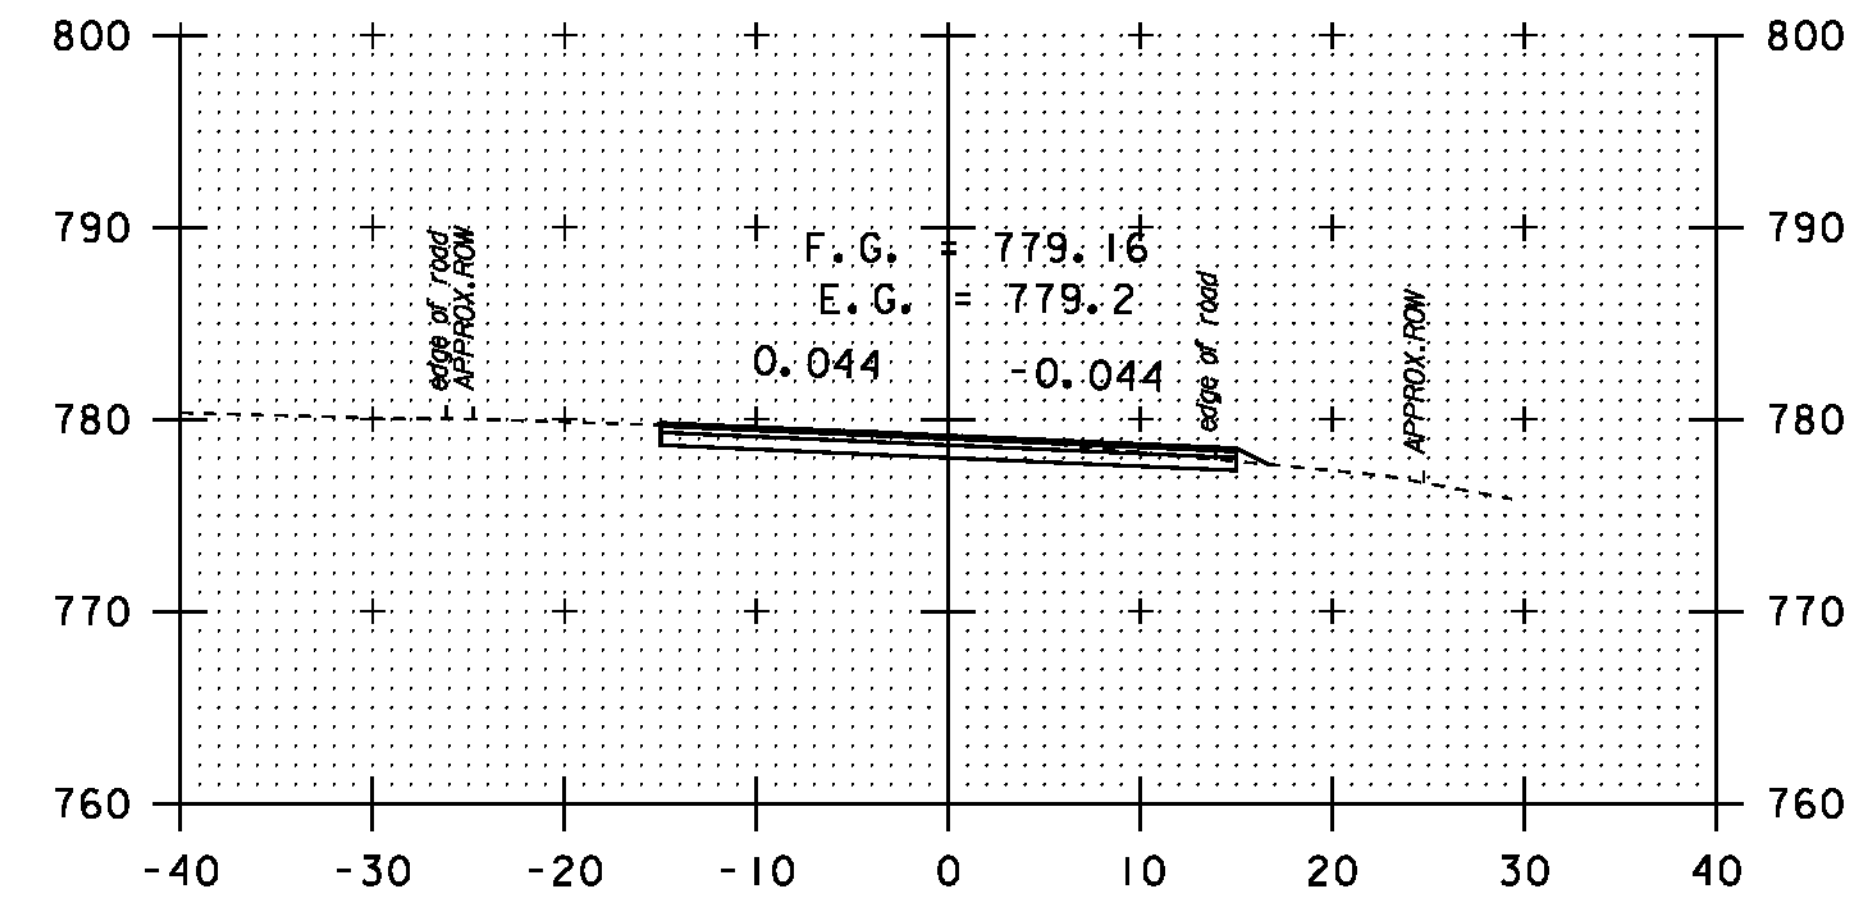


151+50

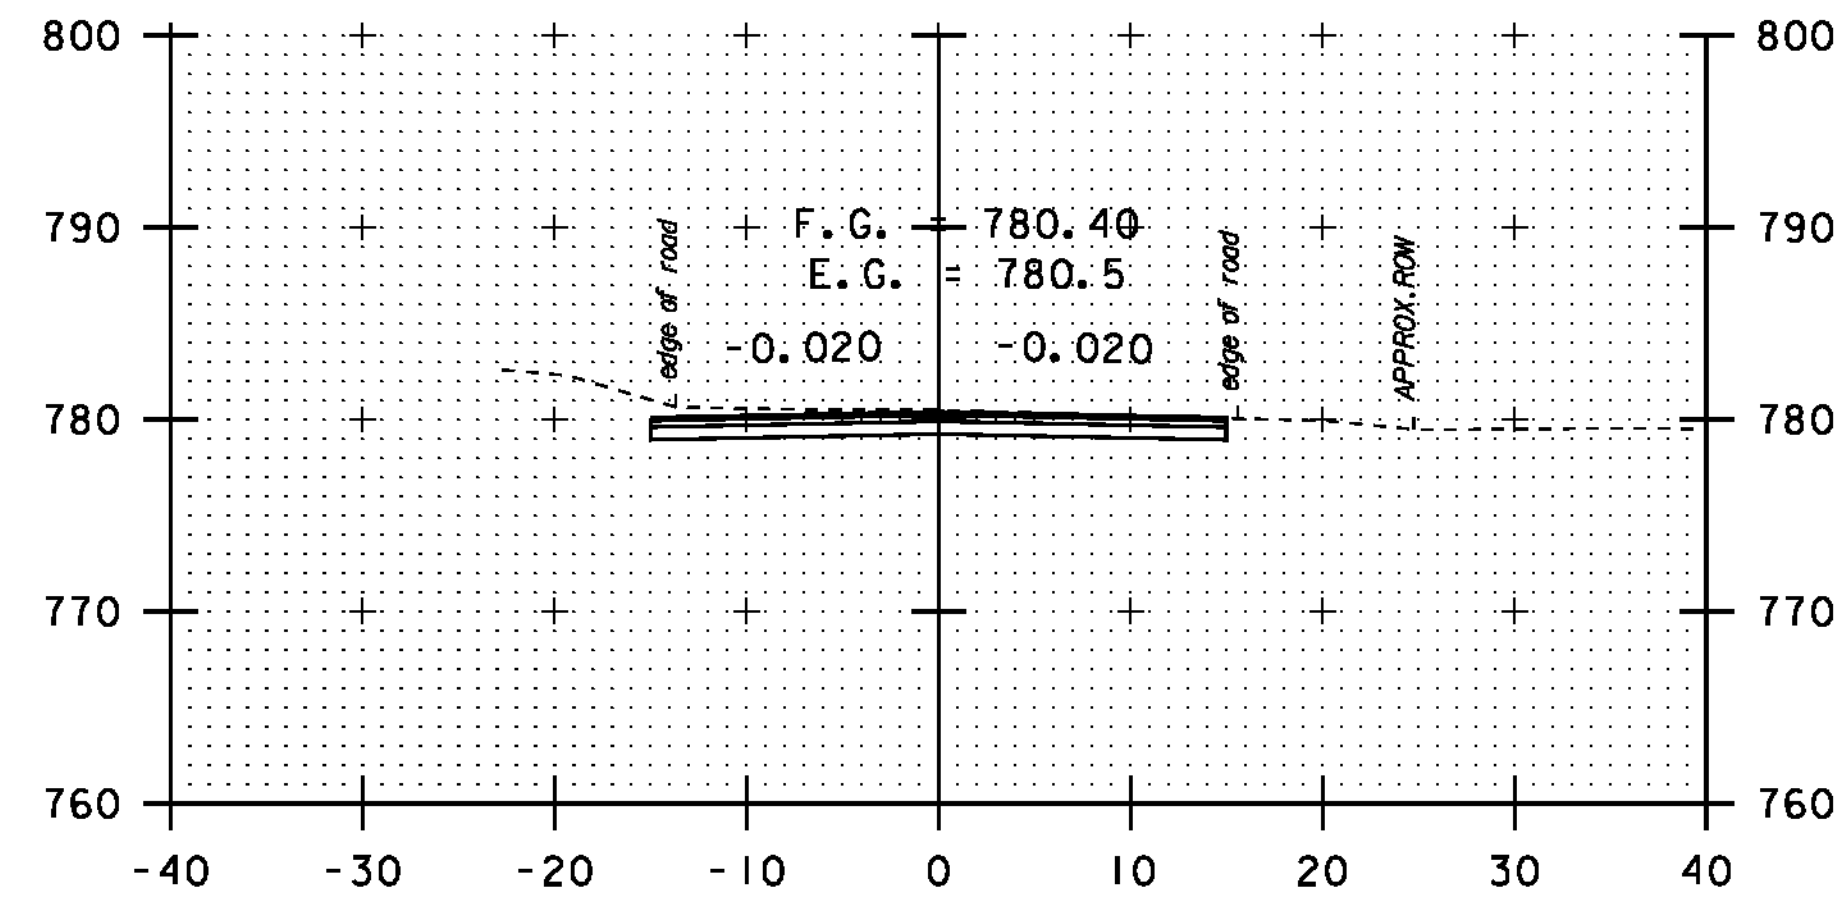


148+50

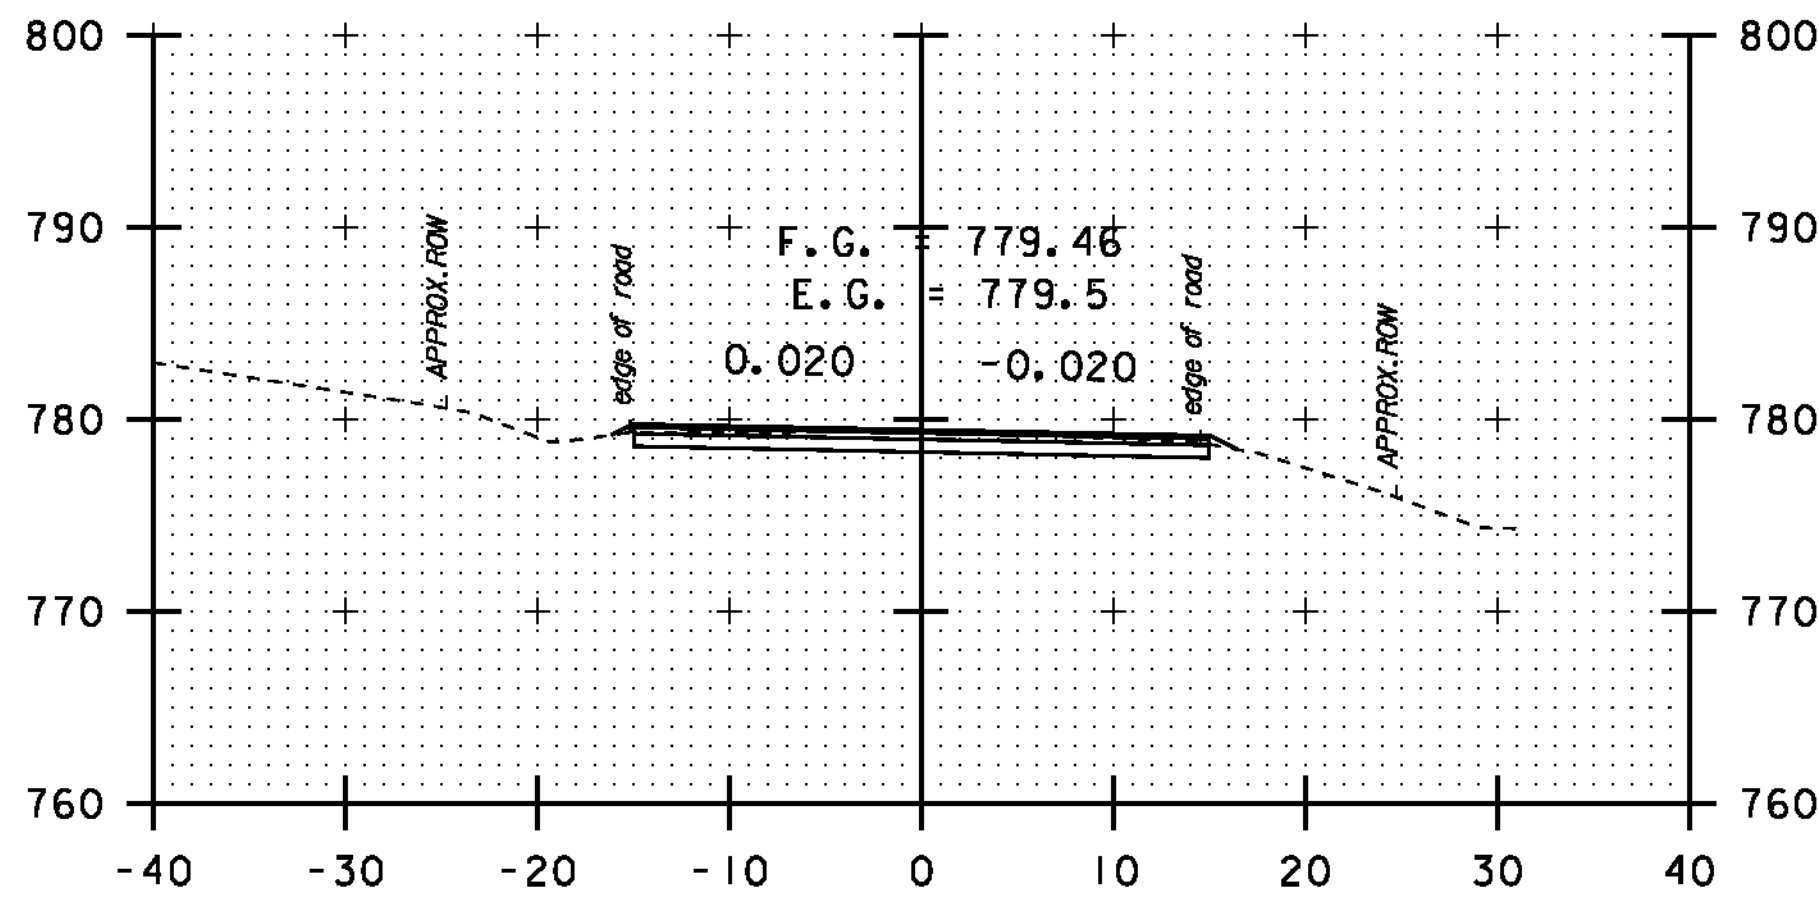

150+32

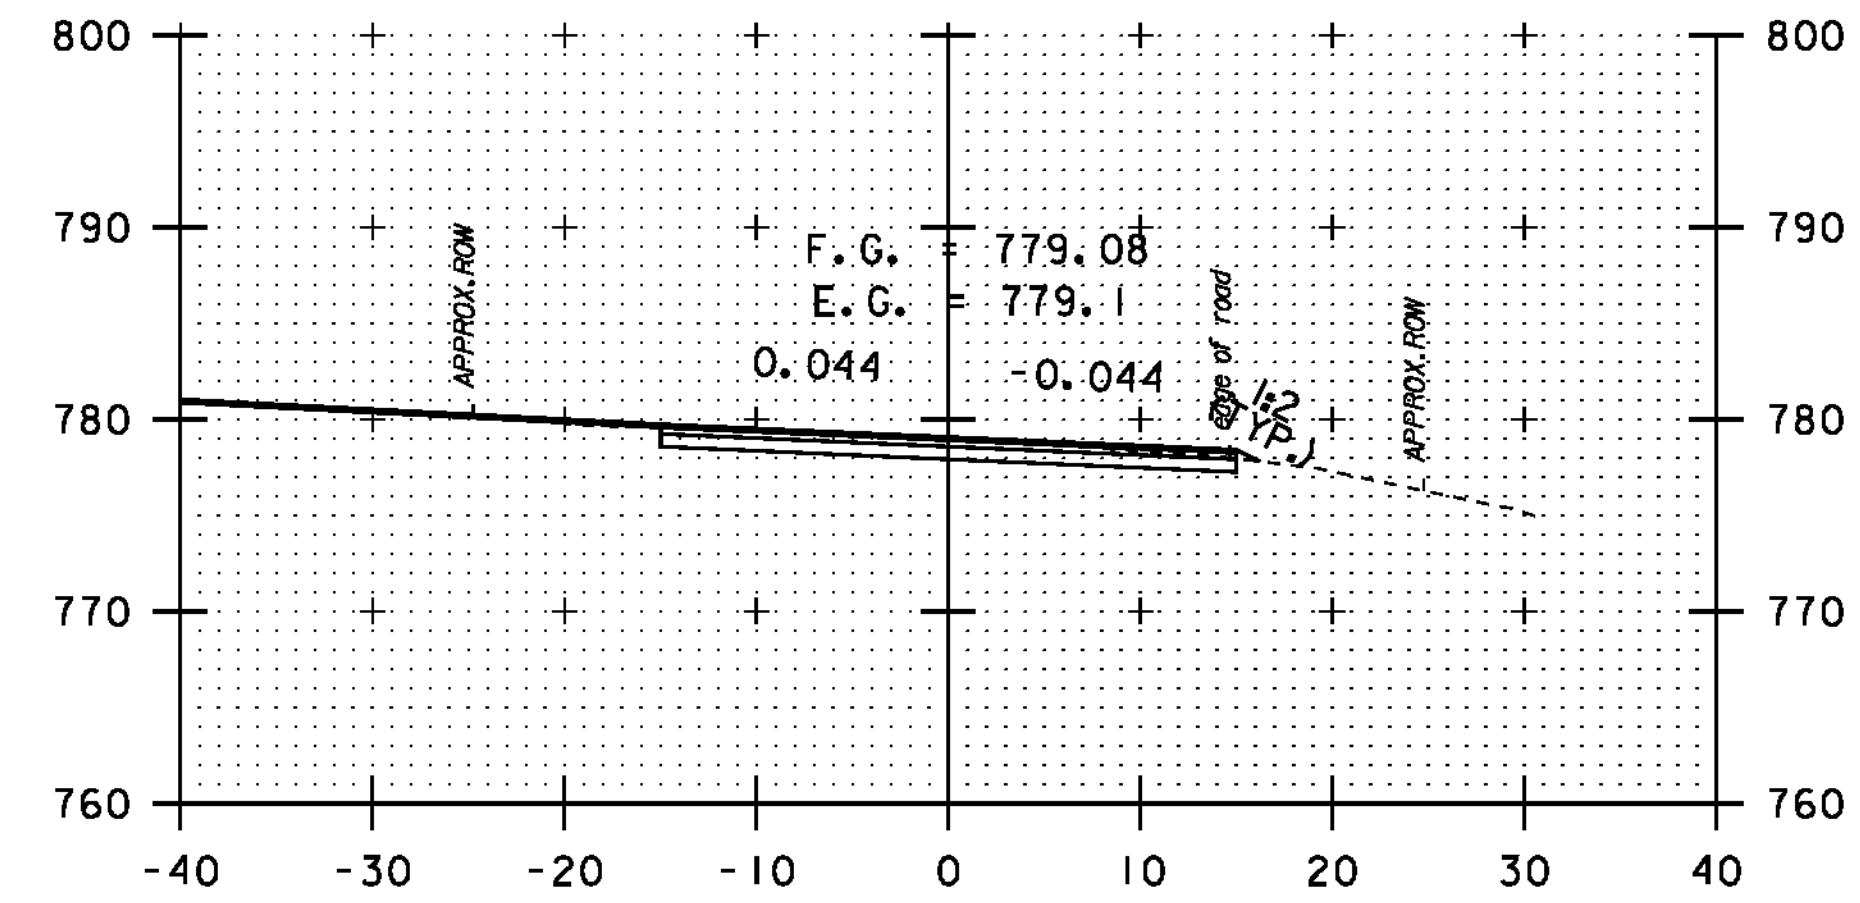


151+00

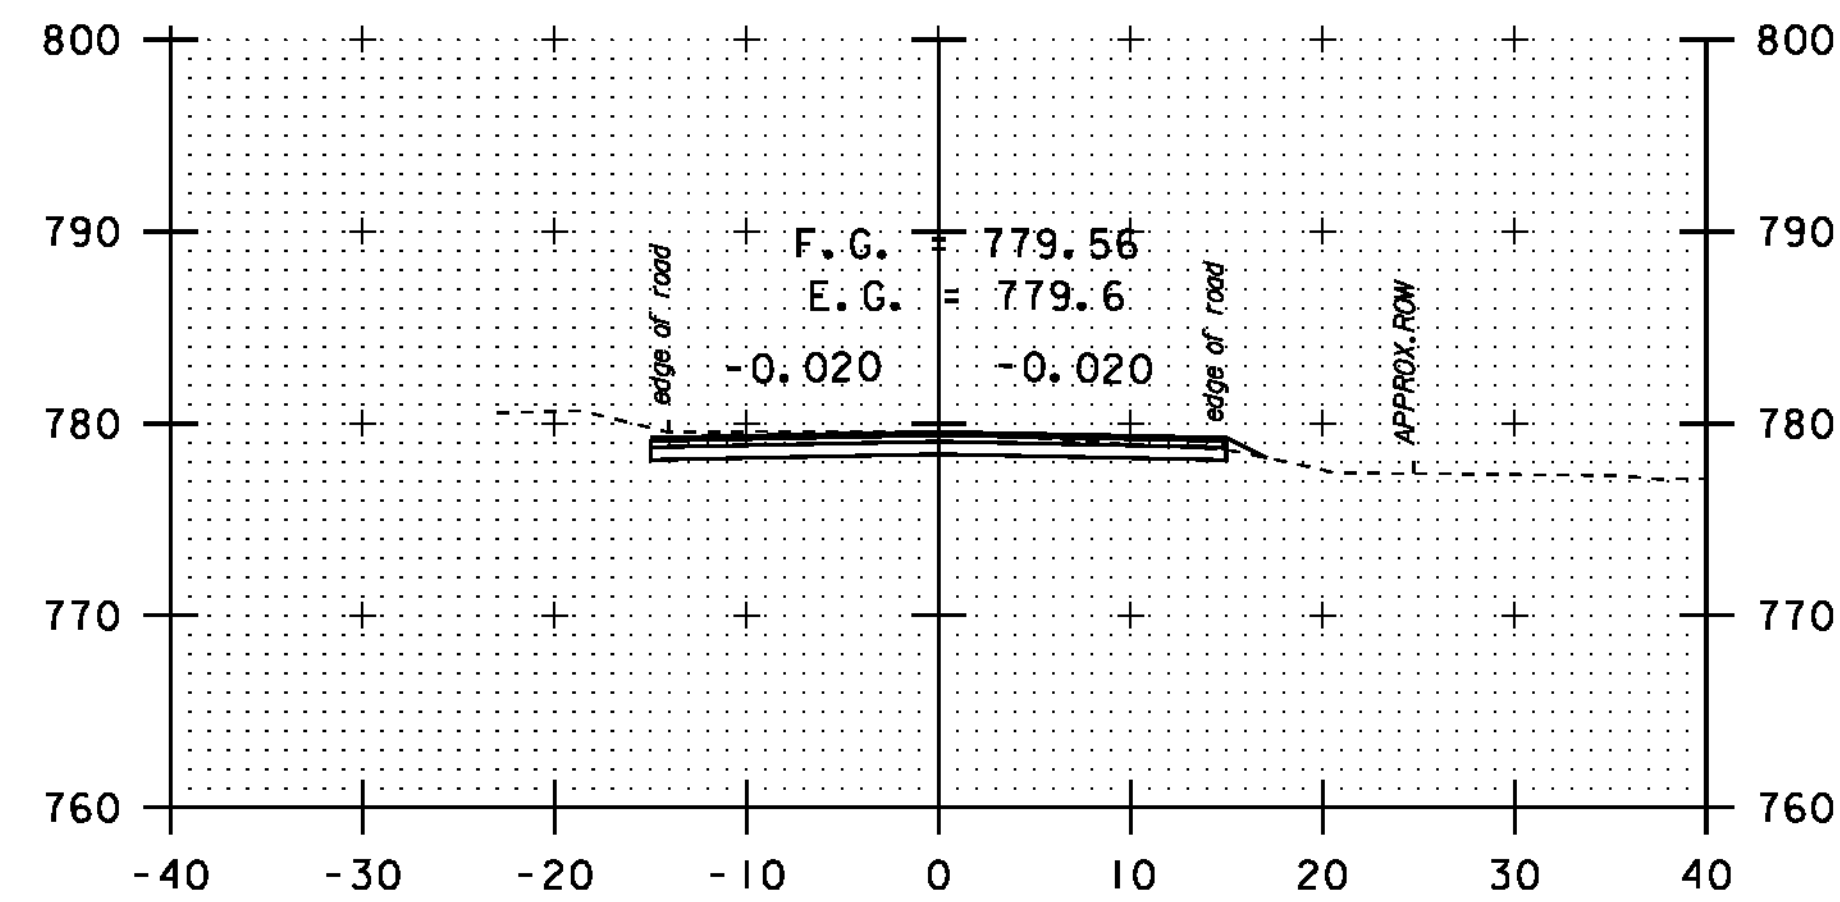


148+00

BEGIN PROJECT STA. 126+45.60

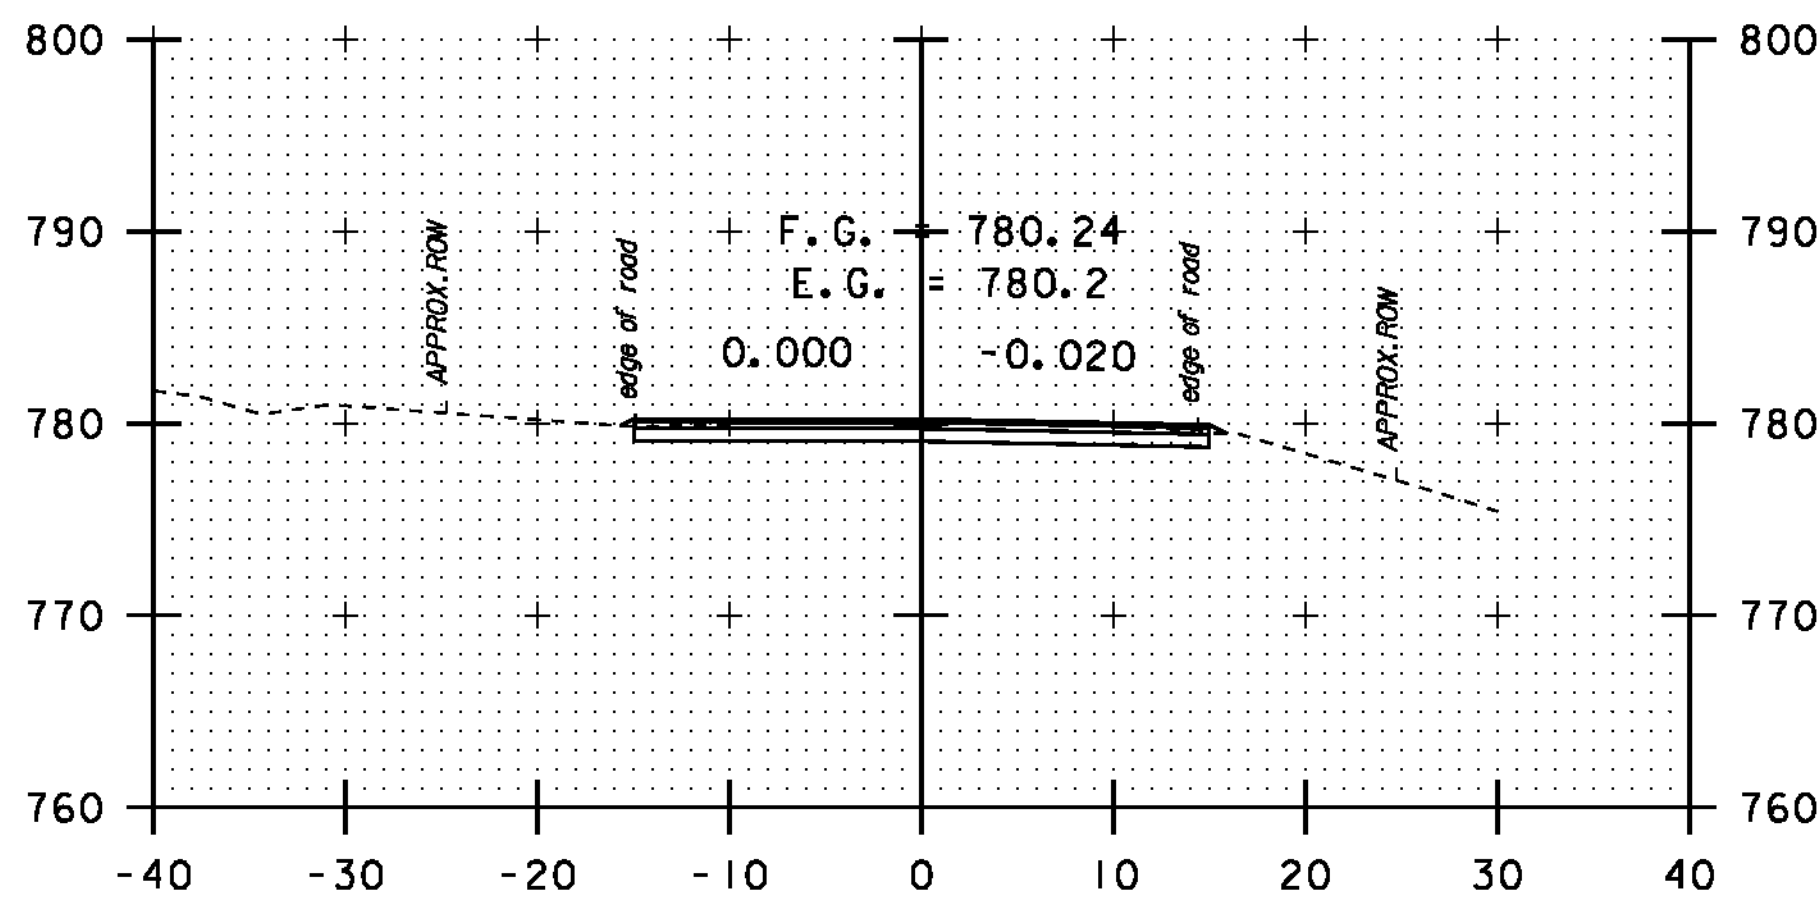

149+80

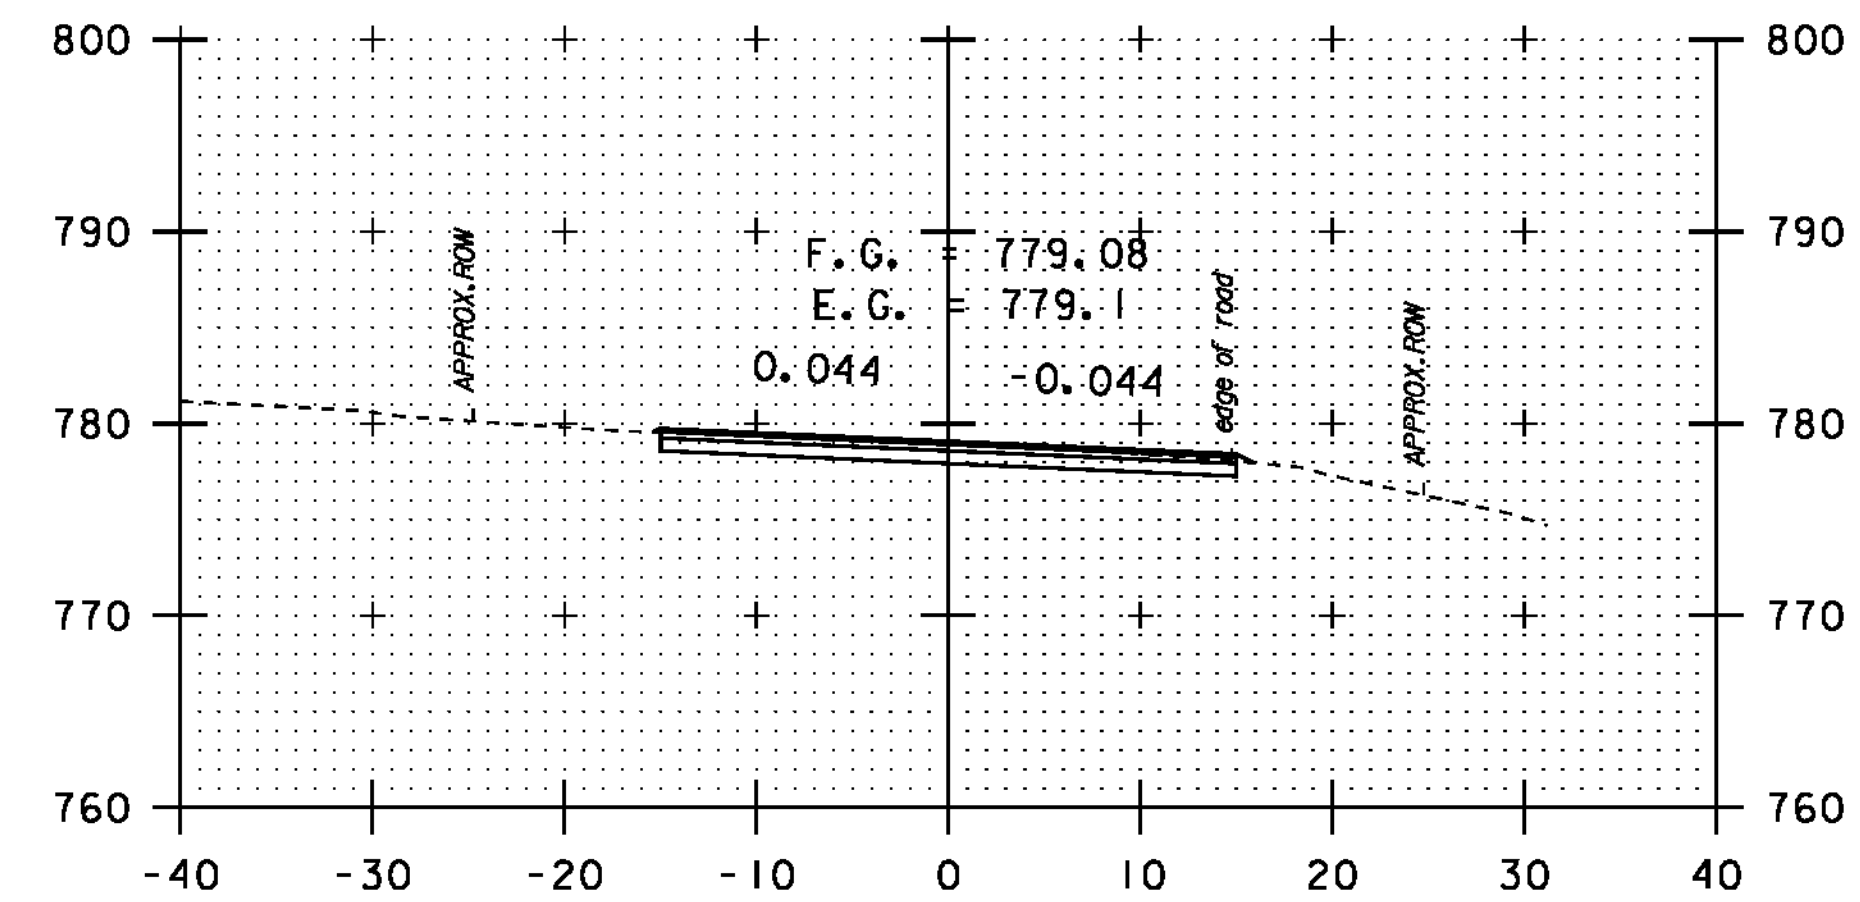

150+95

DATUM	NAVD 88
	NAD 83



STA. 148 + 00
-
STA. 151 + 50

CROSS SECTION SHEET 1

PROJECT NAME:	NEWPORT-COVENTRY-NEWPORT
PROJECT NUMBER:	STP 2802(I)
FILE NAME:	08b158.dgn
PROJECT LEADER:	CDL
DESIGNED BY:	BMB
PLOT FILE:	08b158-74.1
PLOT DATE:	8/3/2011
DRAWN BY:	BMB
CHECKED BY:	EPD
SHEET	74 OF 134