




153+00

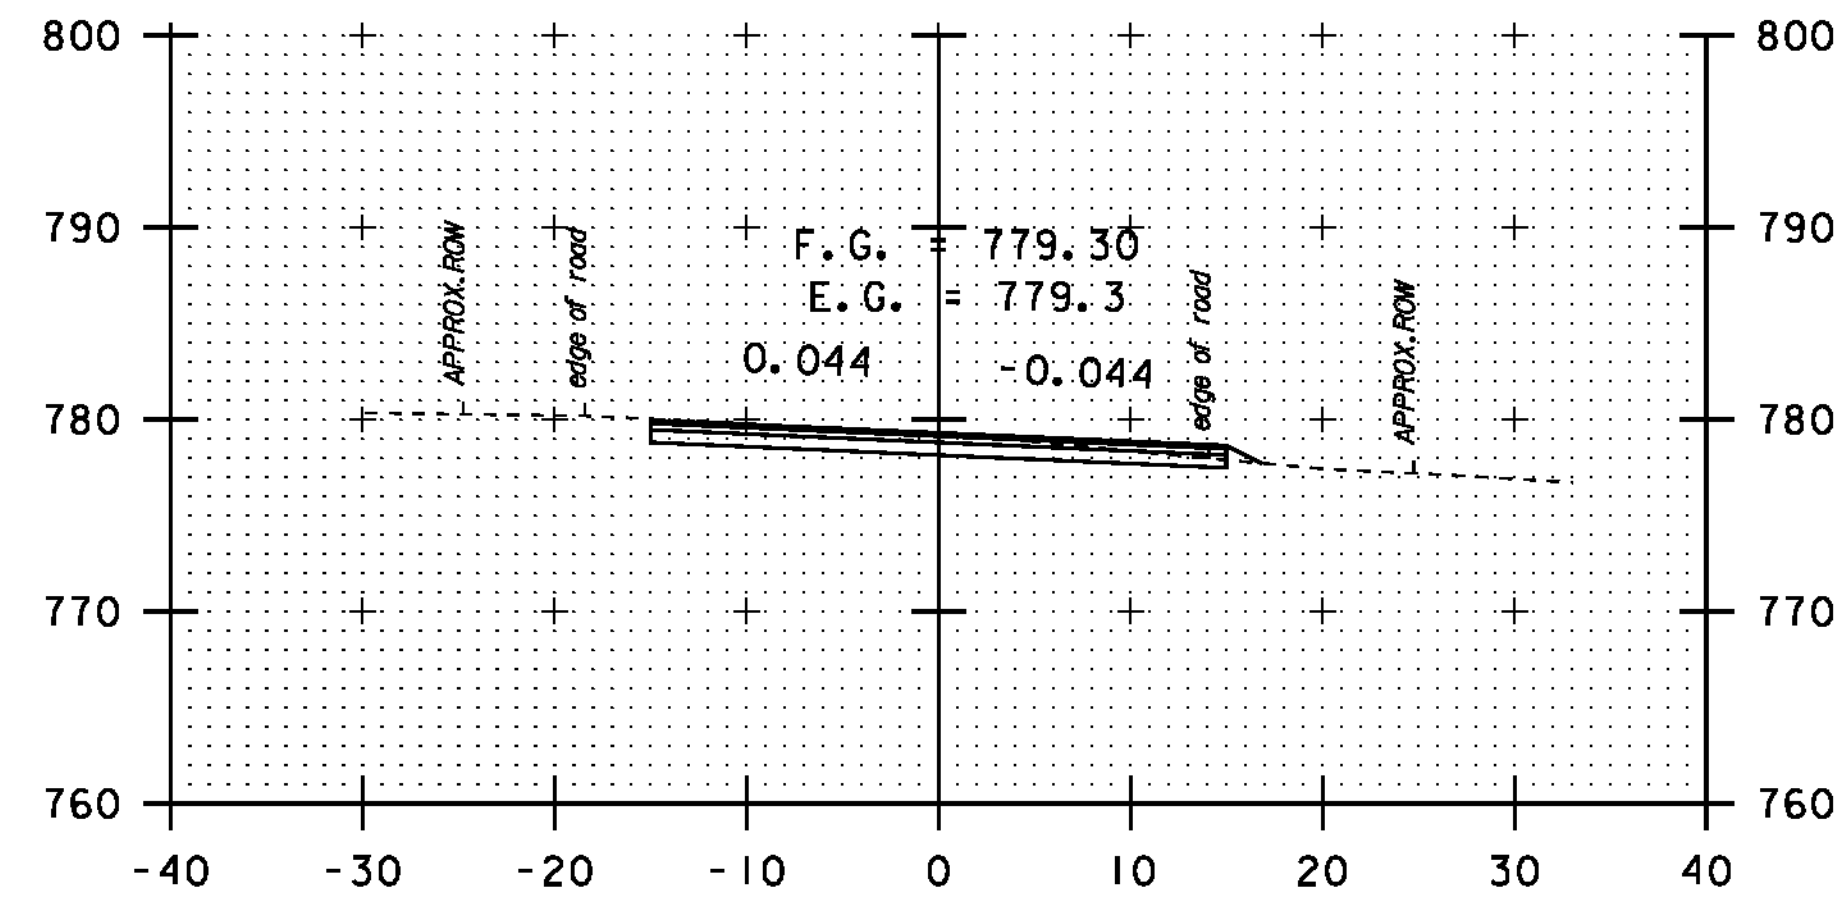


152+50

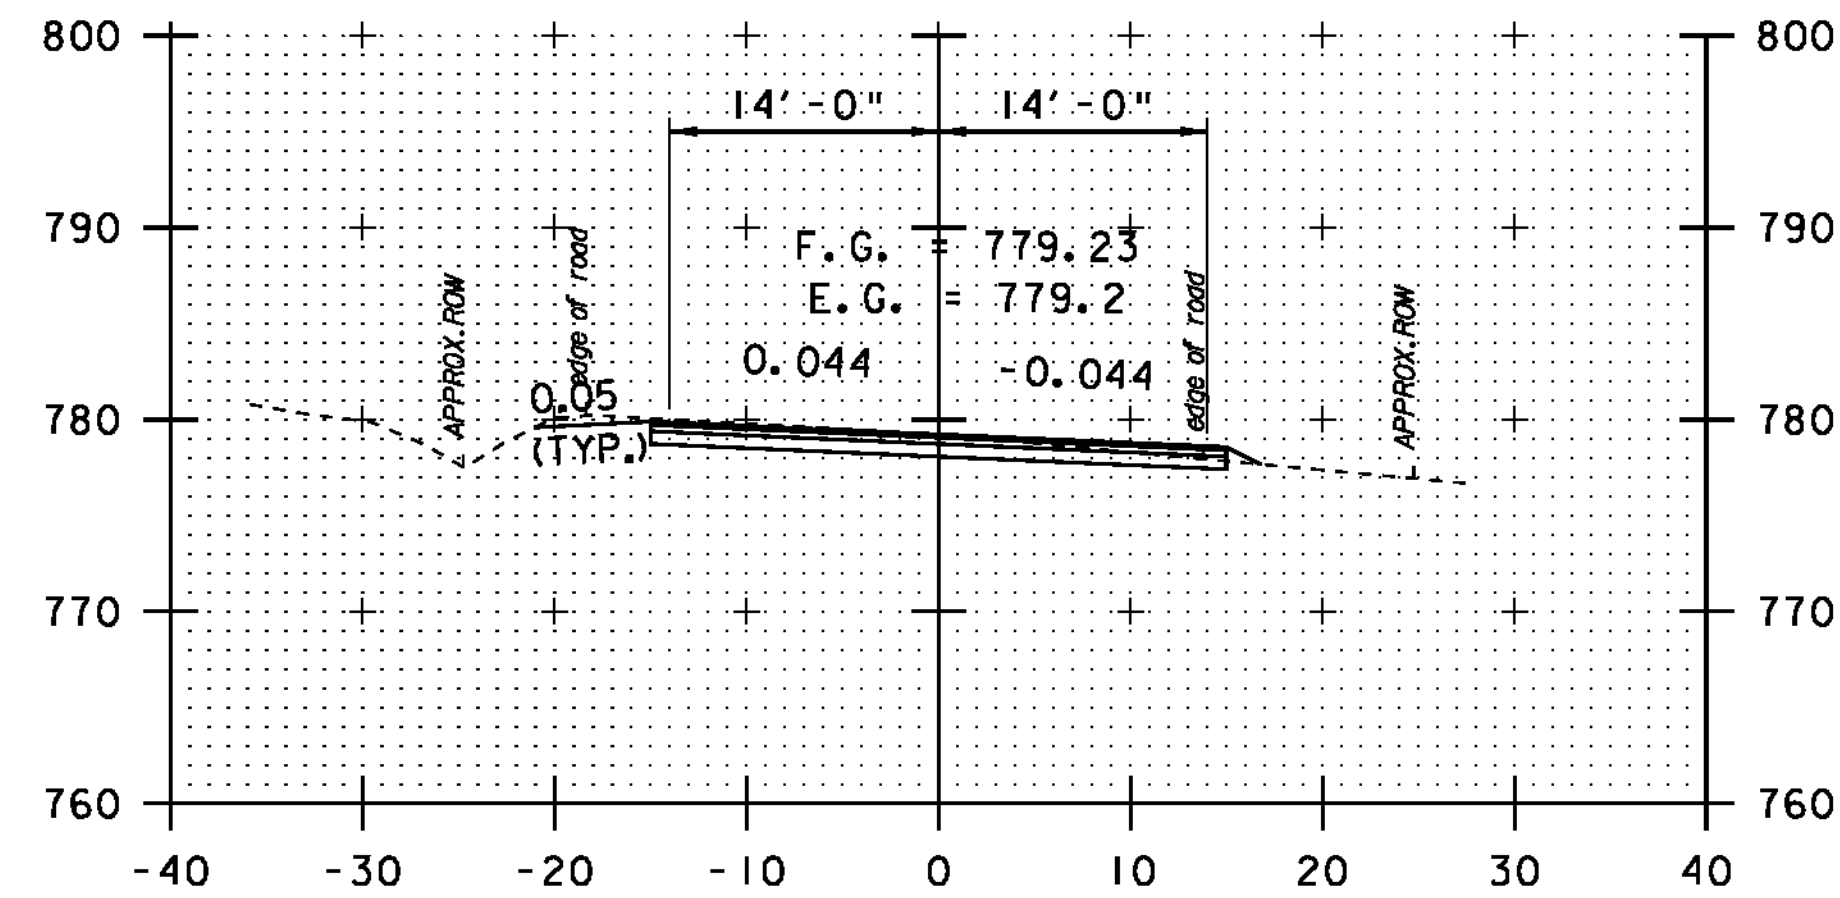


152+00

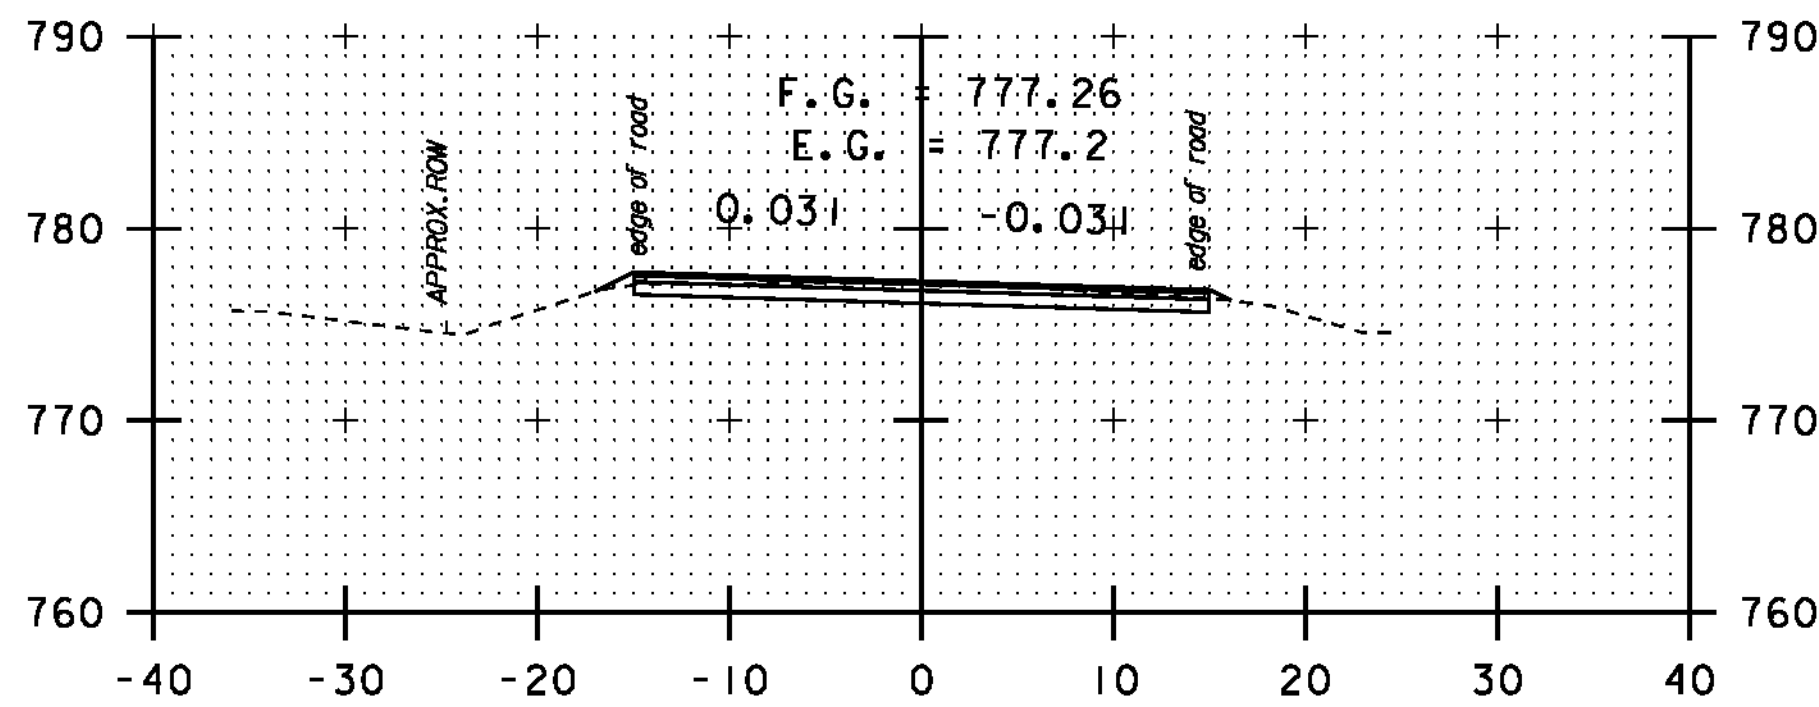


154+15

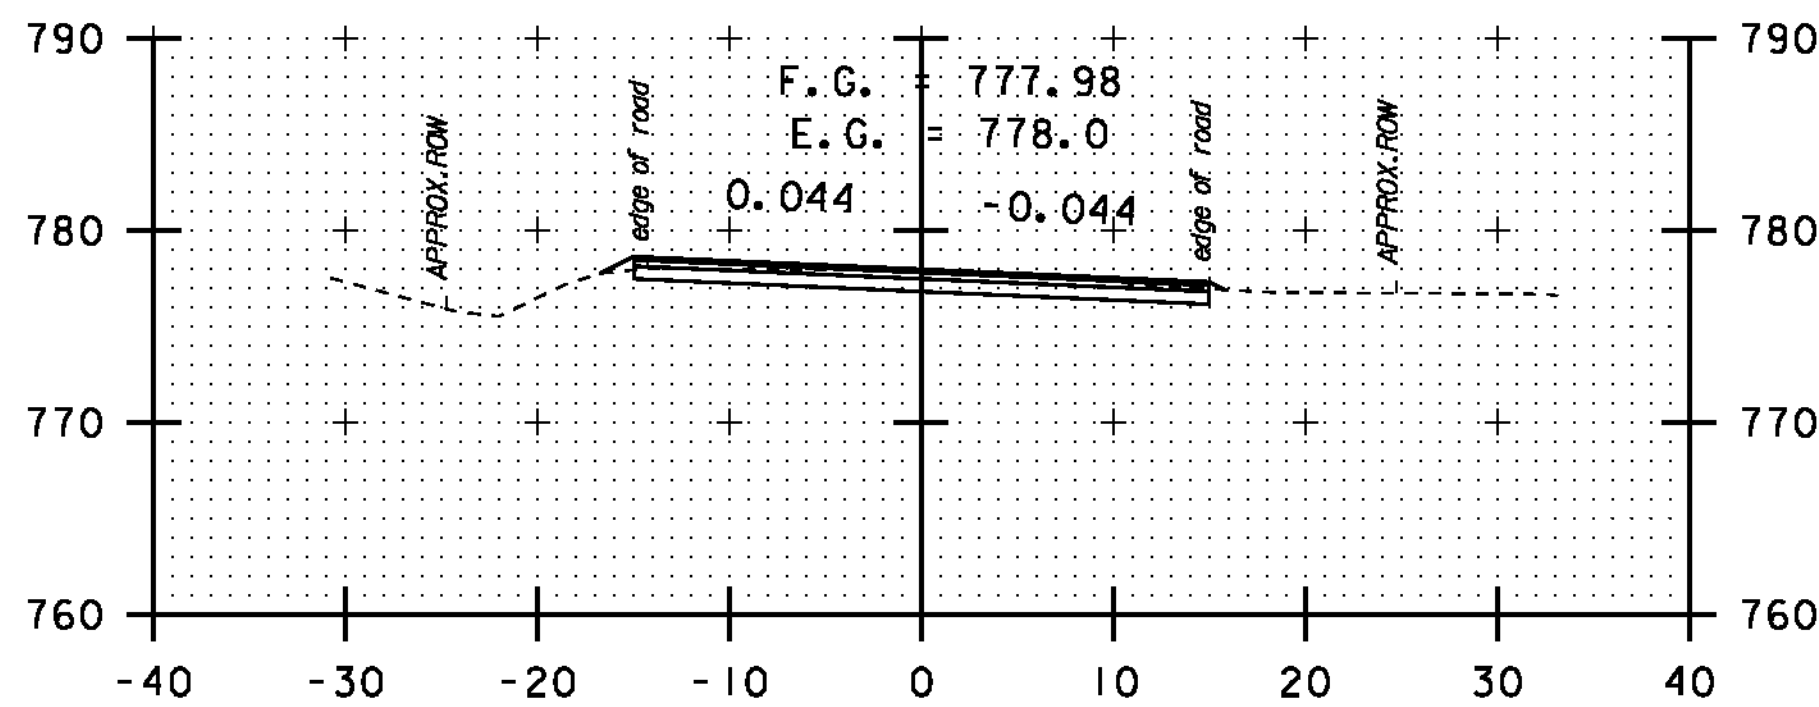


153+80

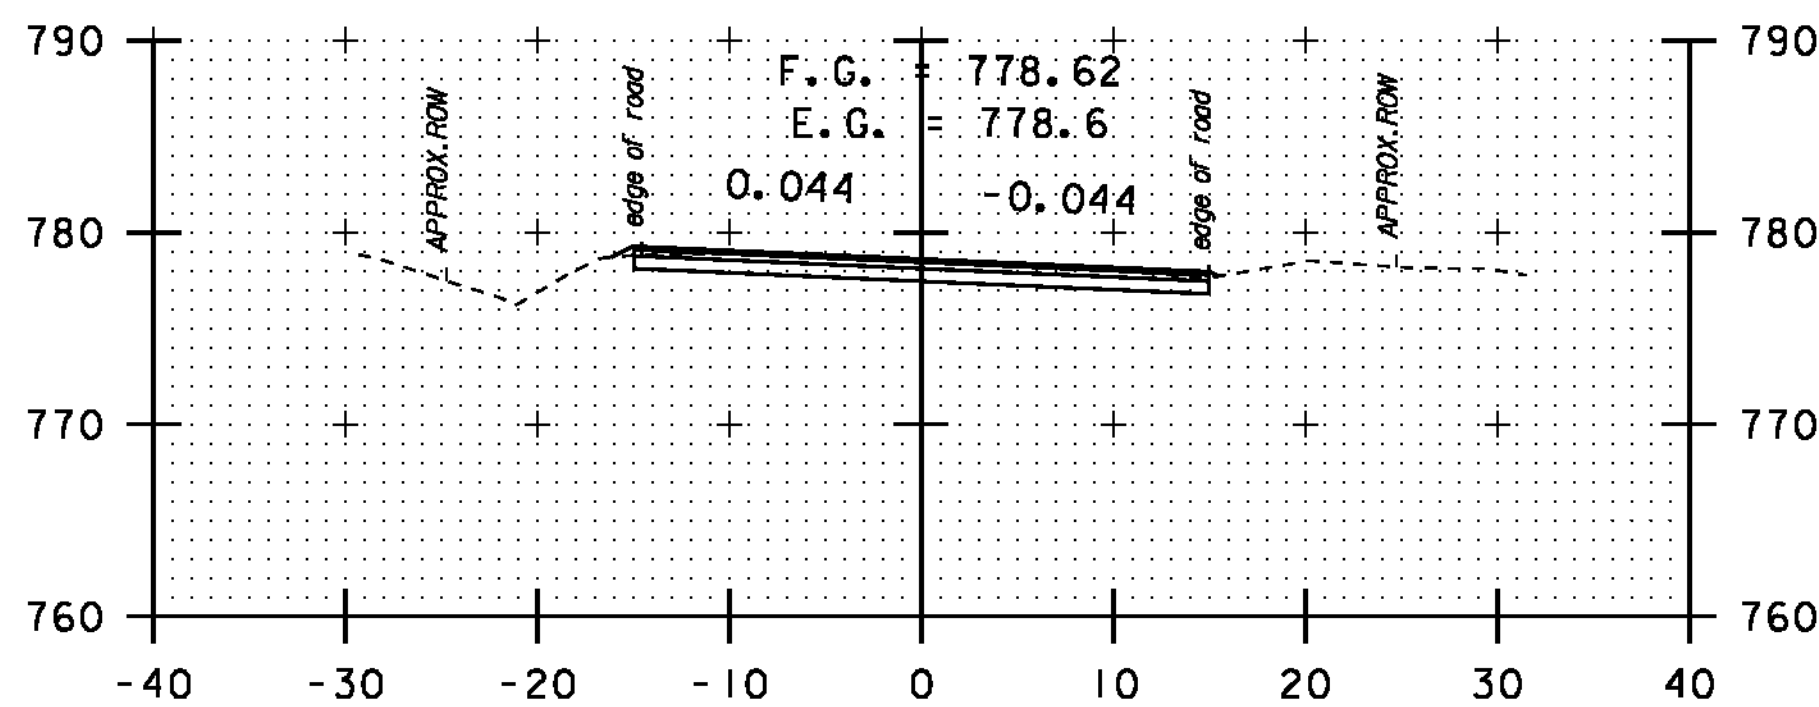


153+50

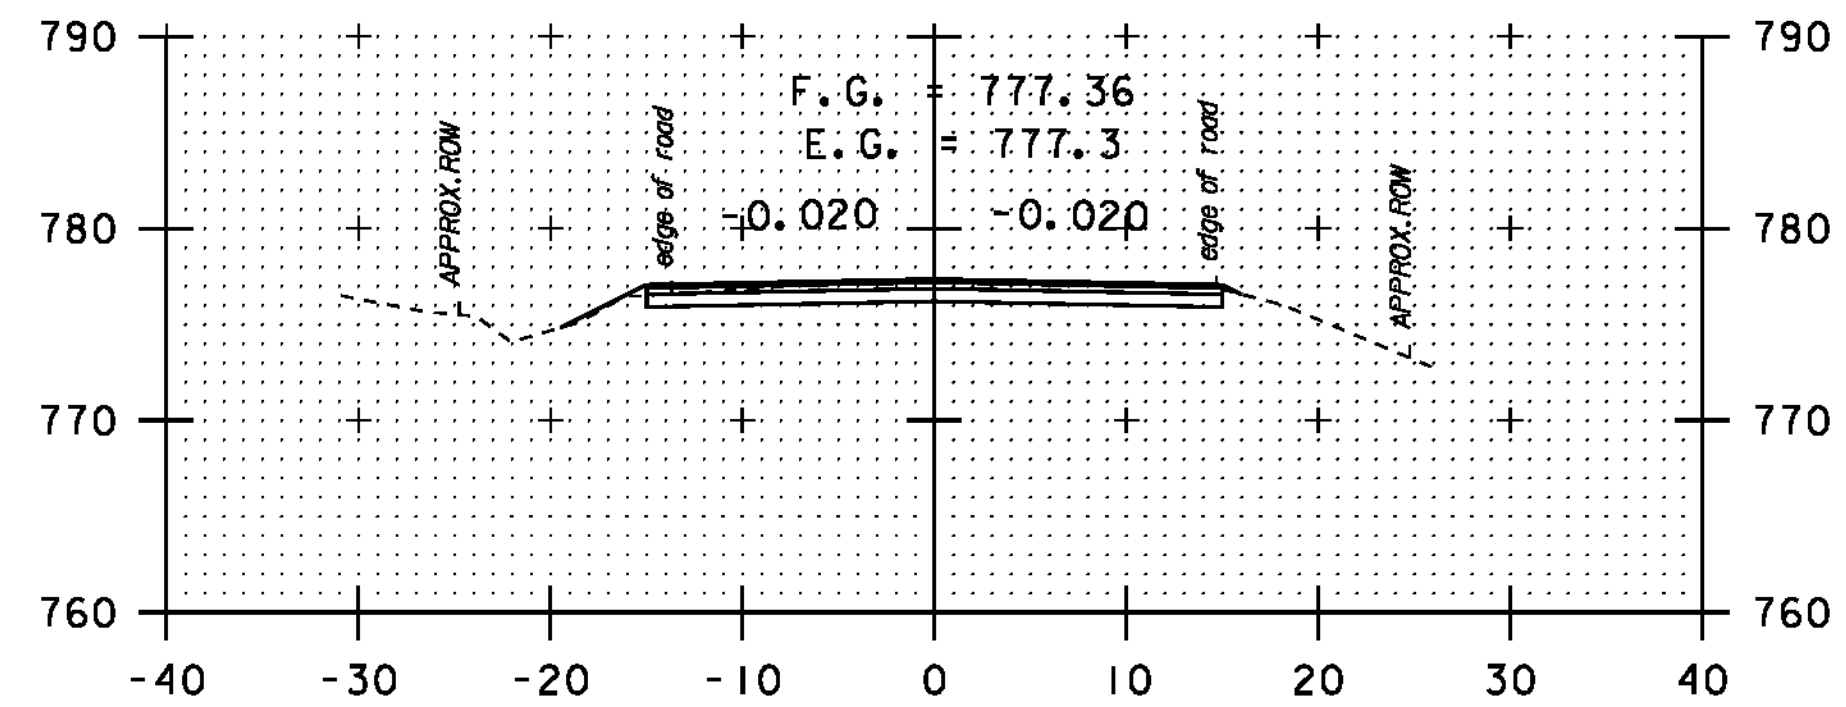

155+95

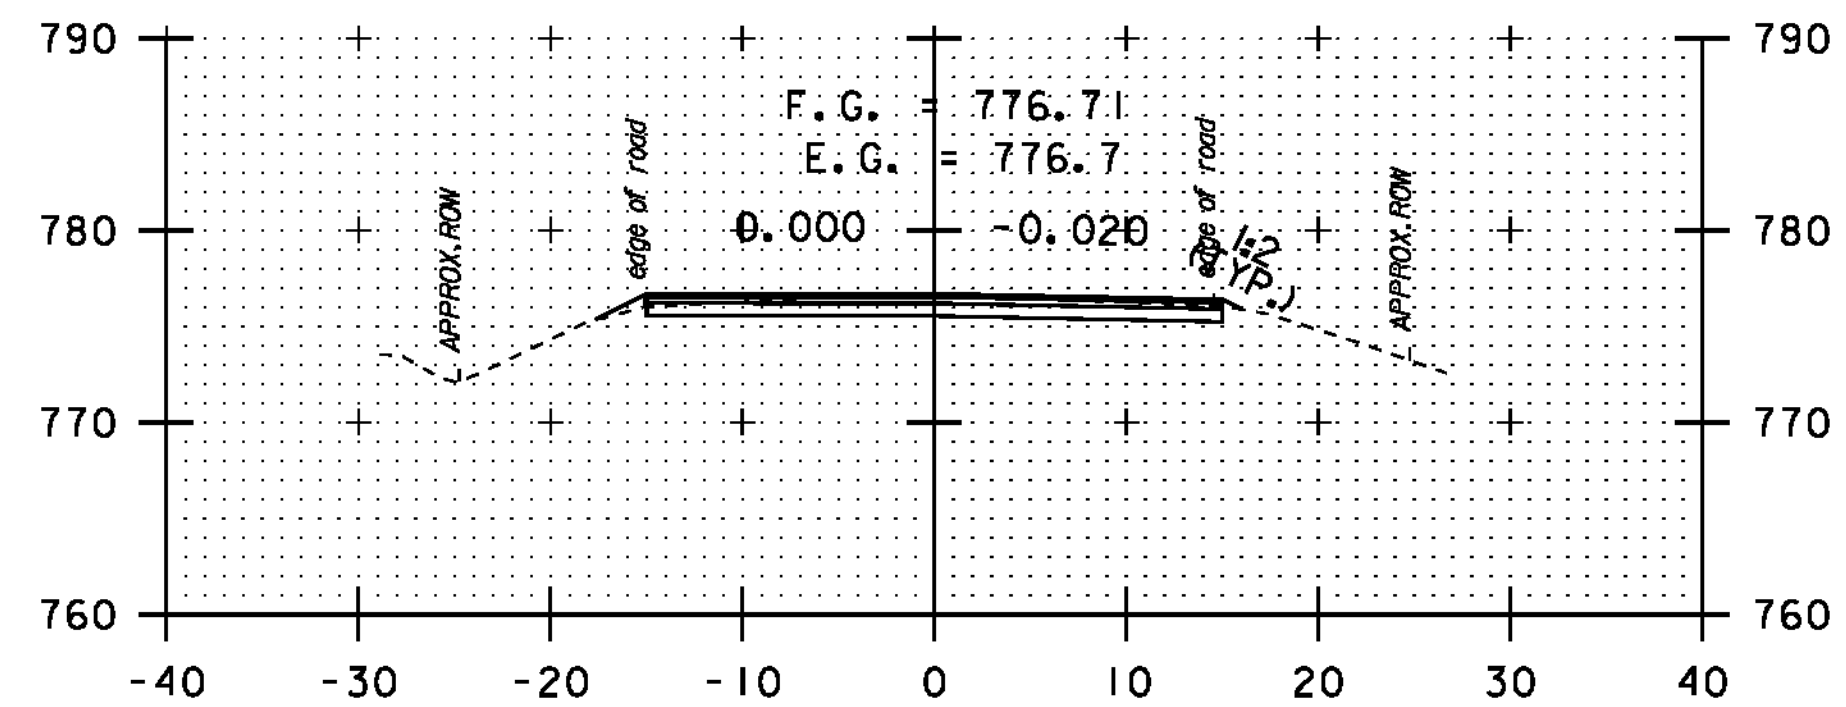

154+95

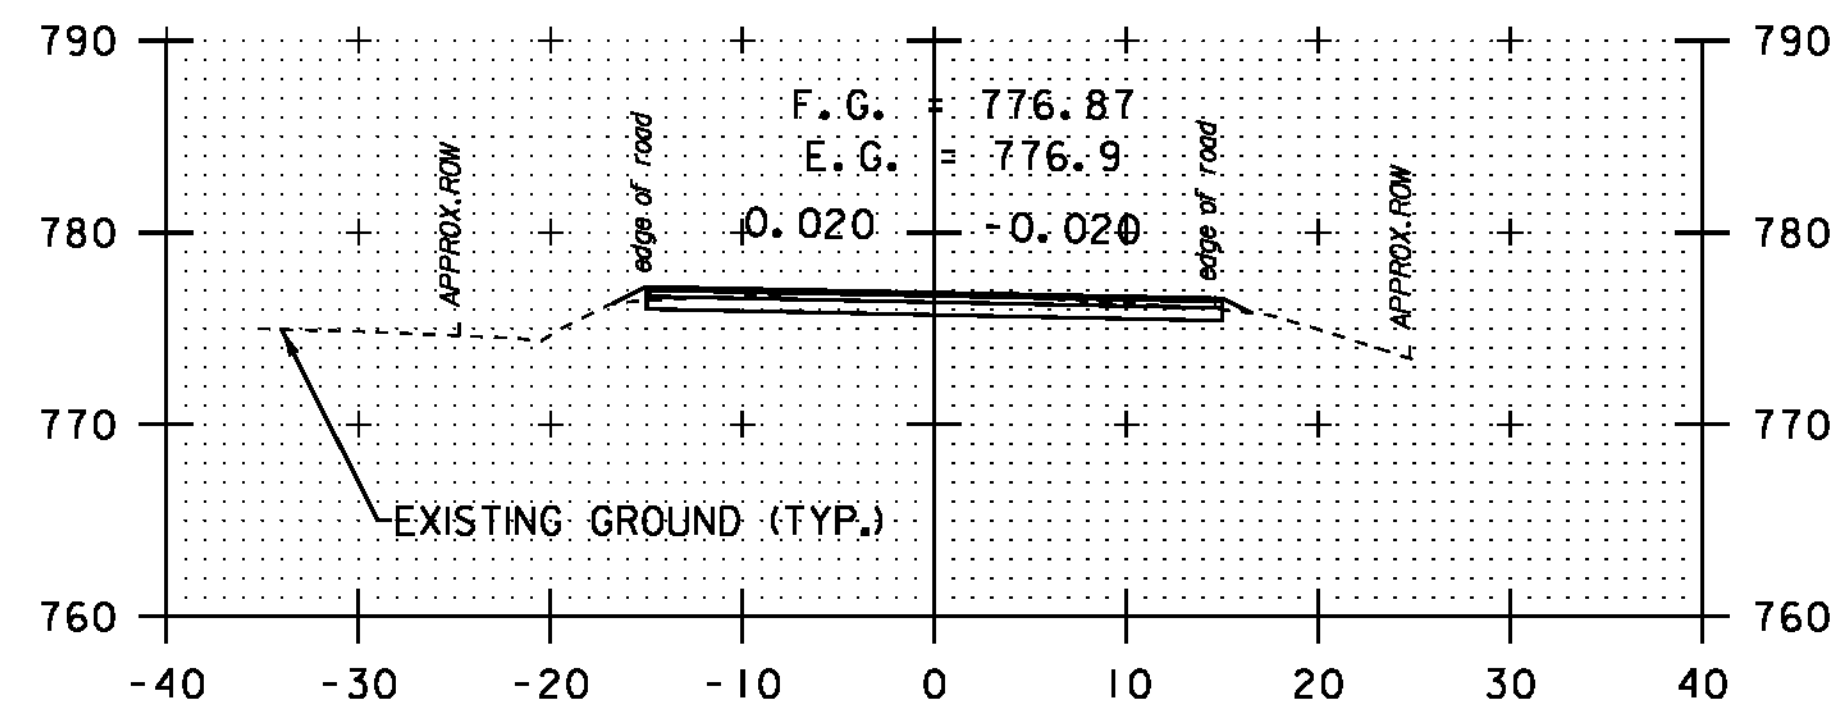

154+43

DATUM	NAVD 88
	NAD 83



STA. 152+00
-
STA. 155+95

CROSS SECTION SHEET 2

PROJECT NAME:	NEWPORT-COVENTRY-NEWPORT
PROJECT NUMBER:	STP 2802(I)
FILE NAME:	08b158.dgn
PROJECT LEADER:	CDL
DESIGNED BY:	BMB
PLOT FILE:	08b158-75.1
PLOT DATE:	8/3/2011
DRAWN BY:	BMB
CHECKED BY:	EPD
SHEET	75 OF 134