




180+60

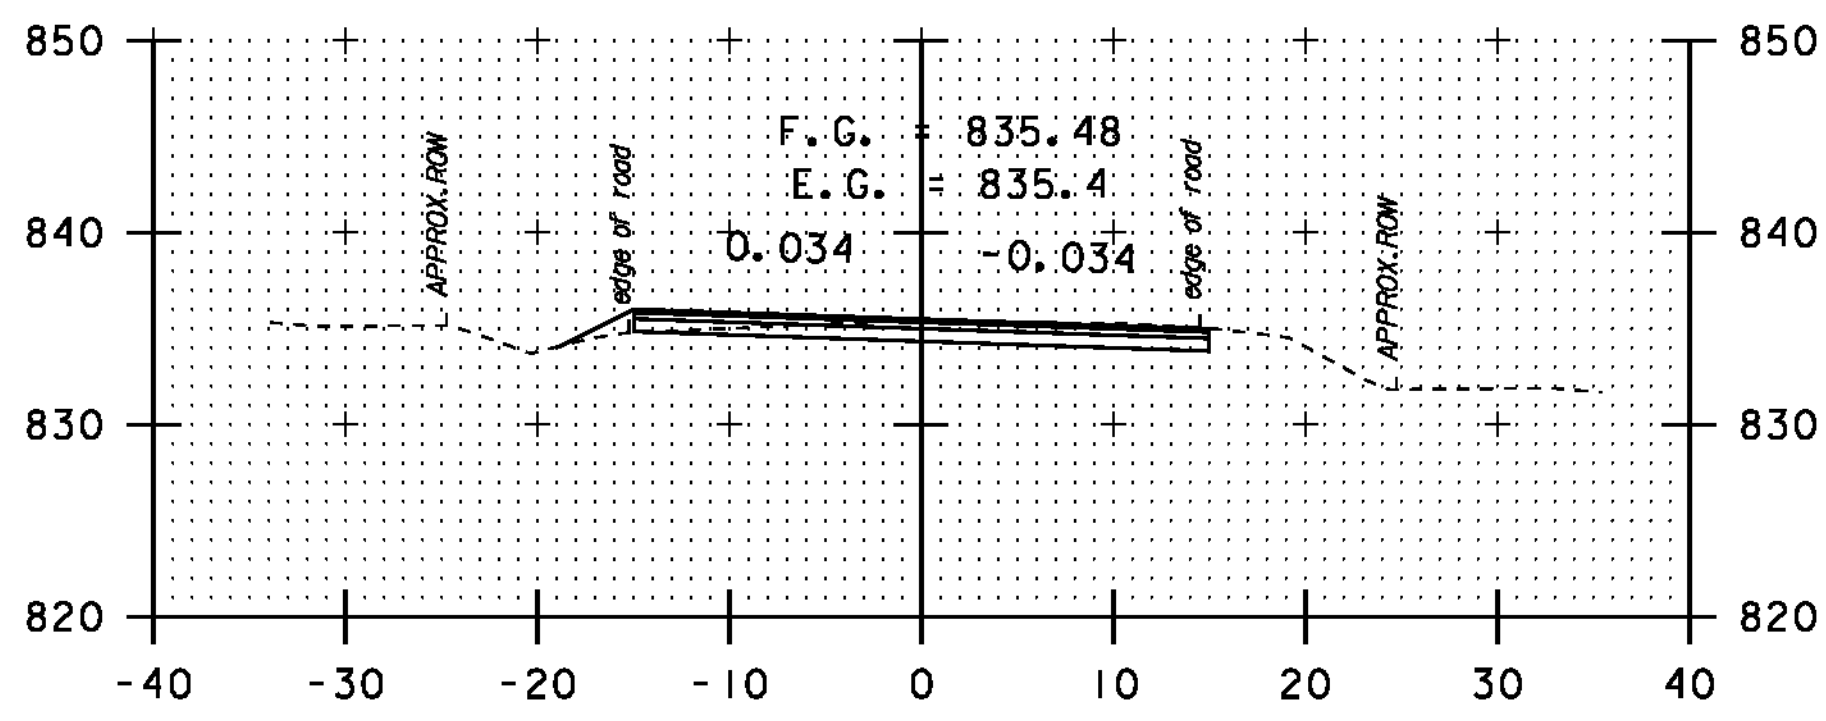


182+97

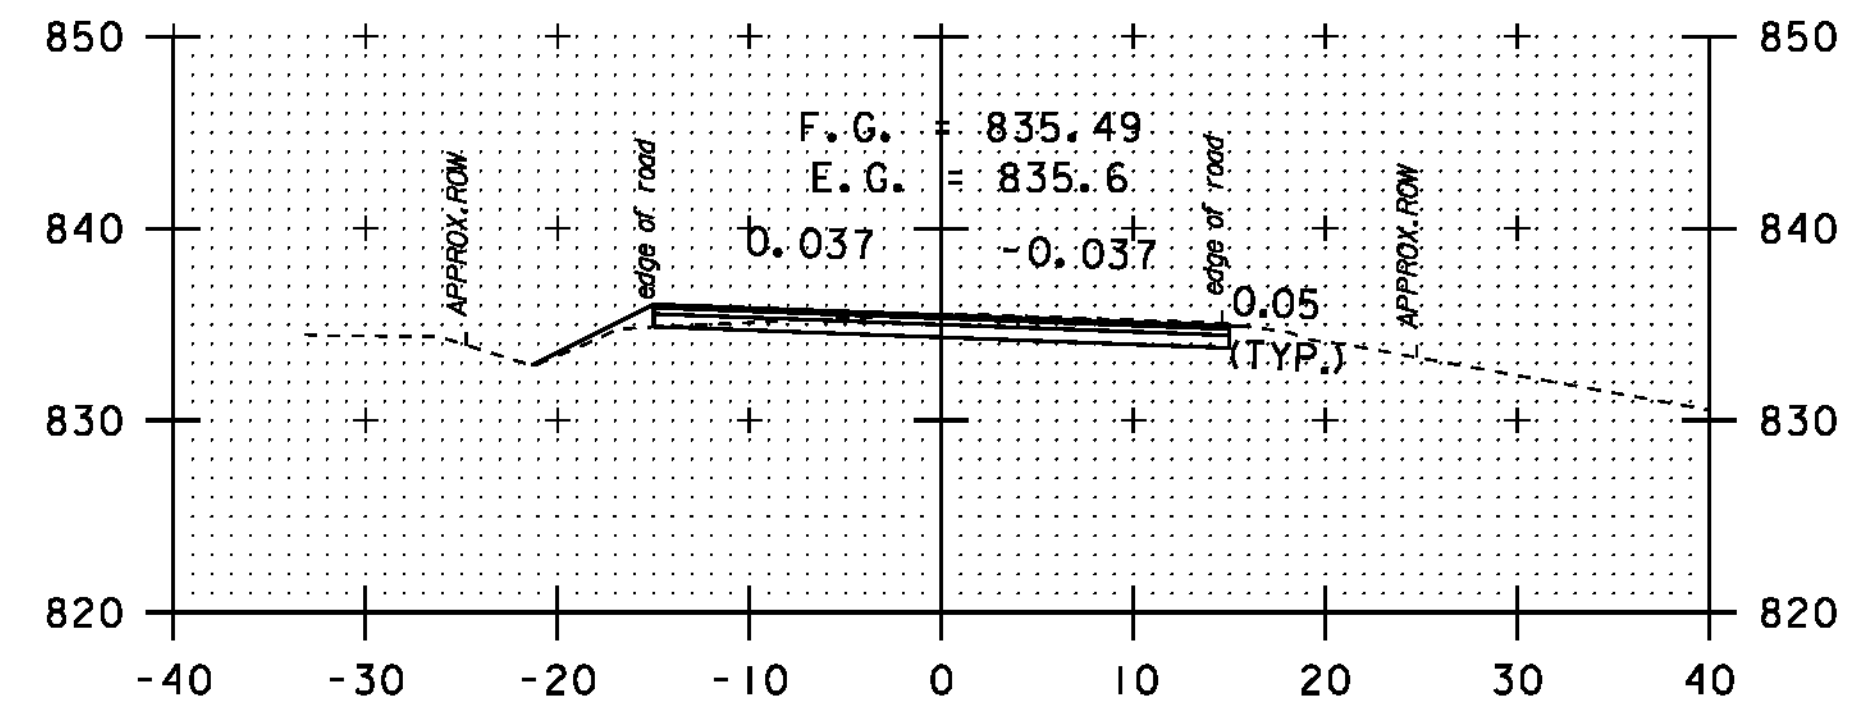


184+00

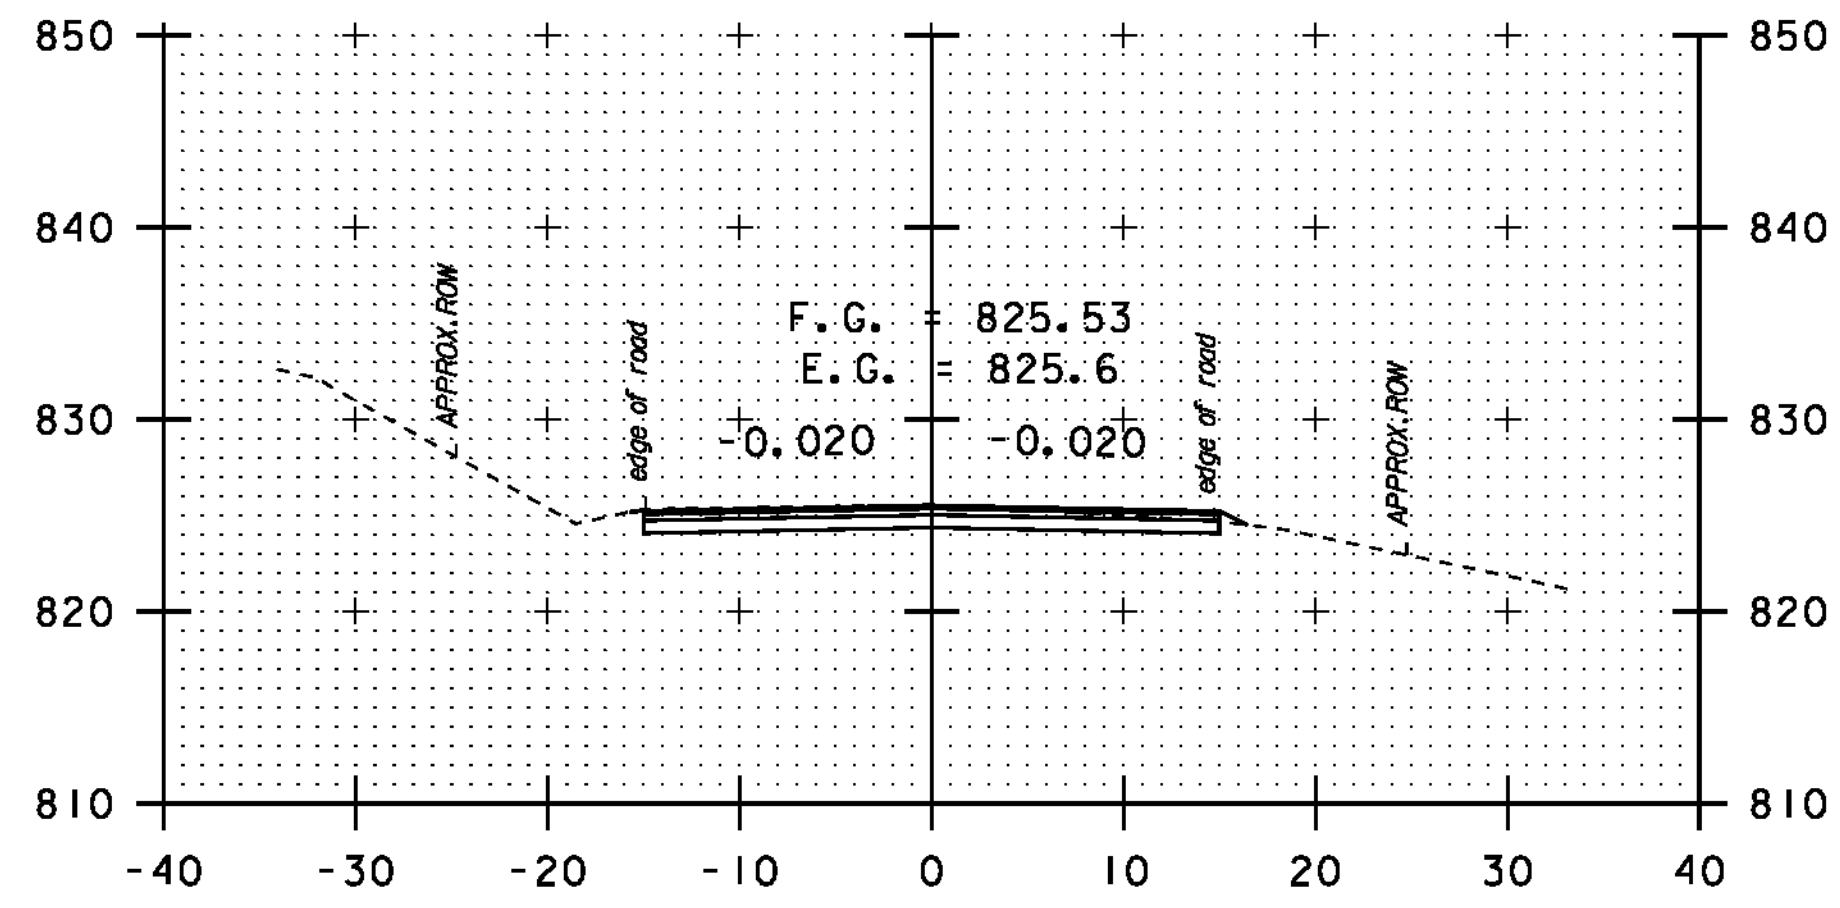


180+50

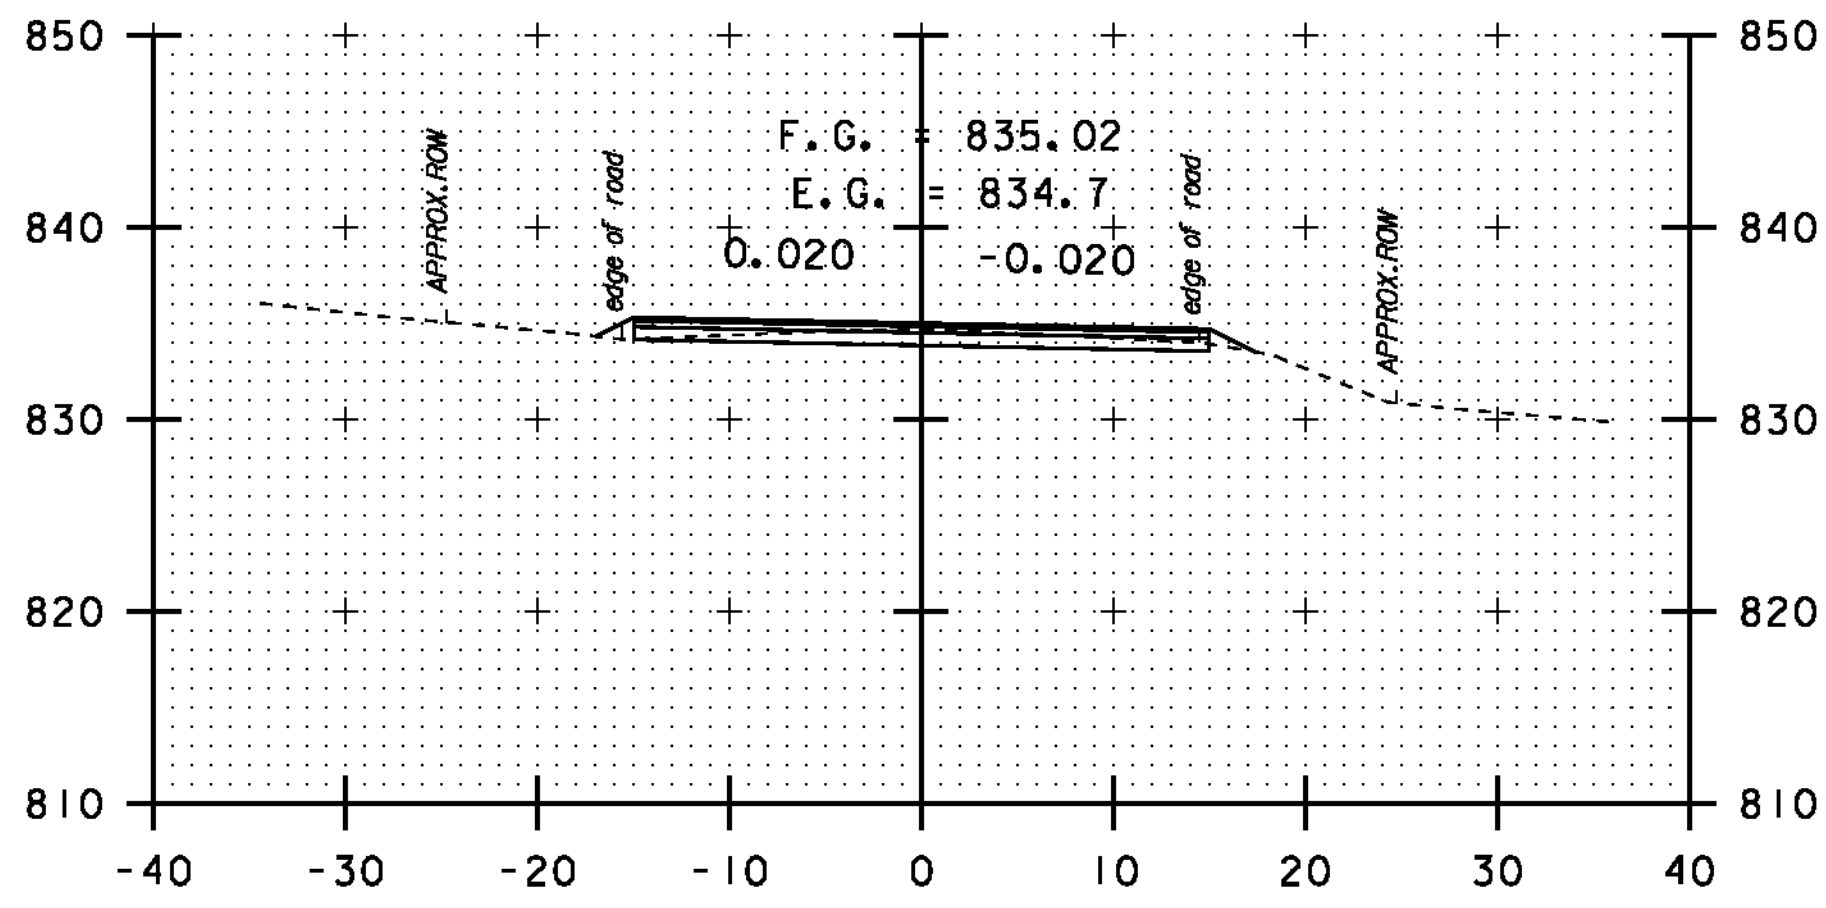


182+41

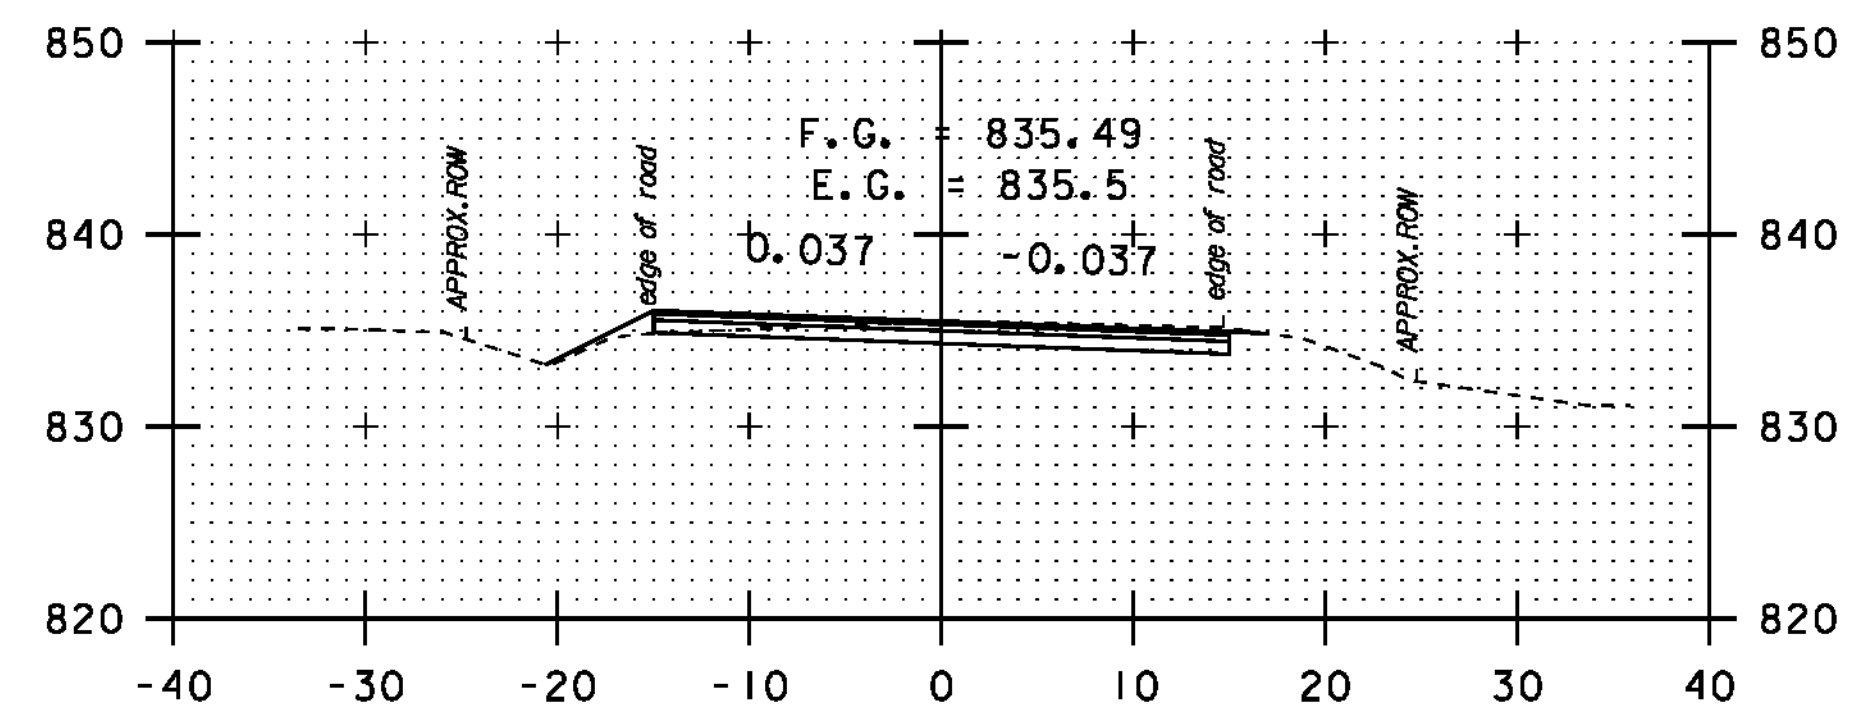


183+50

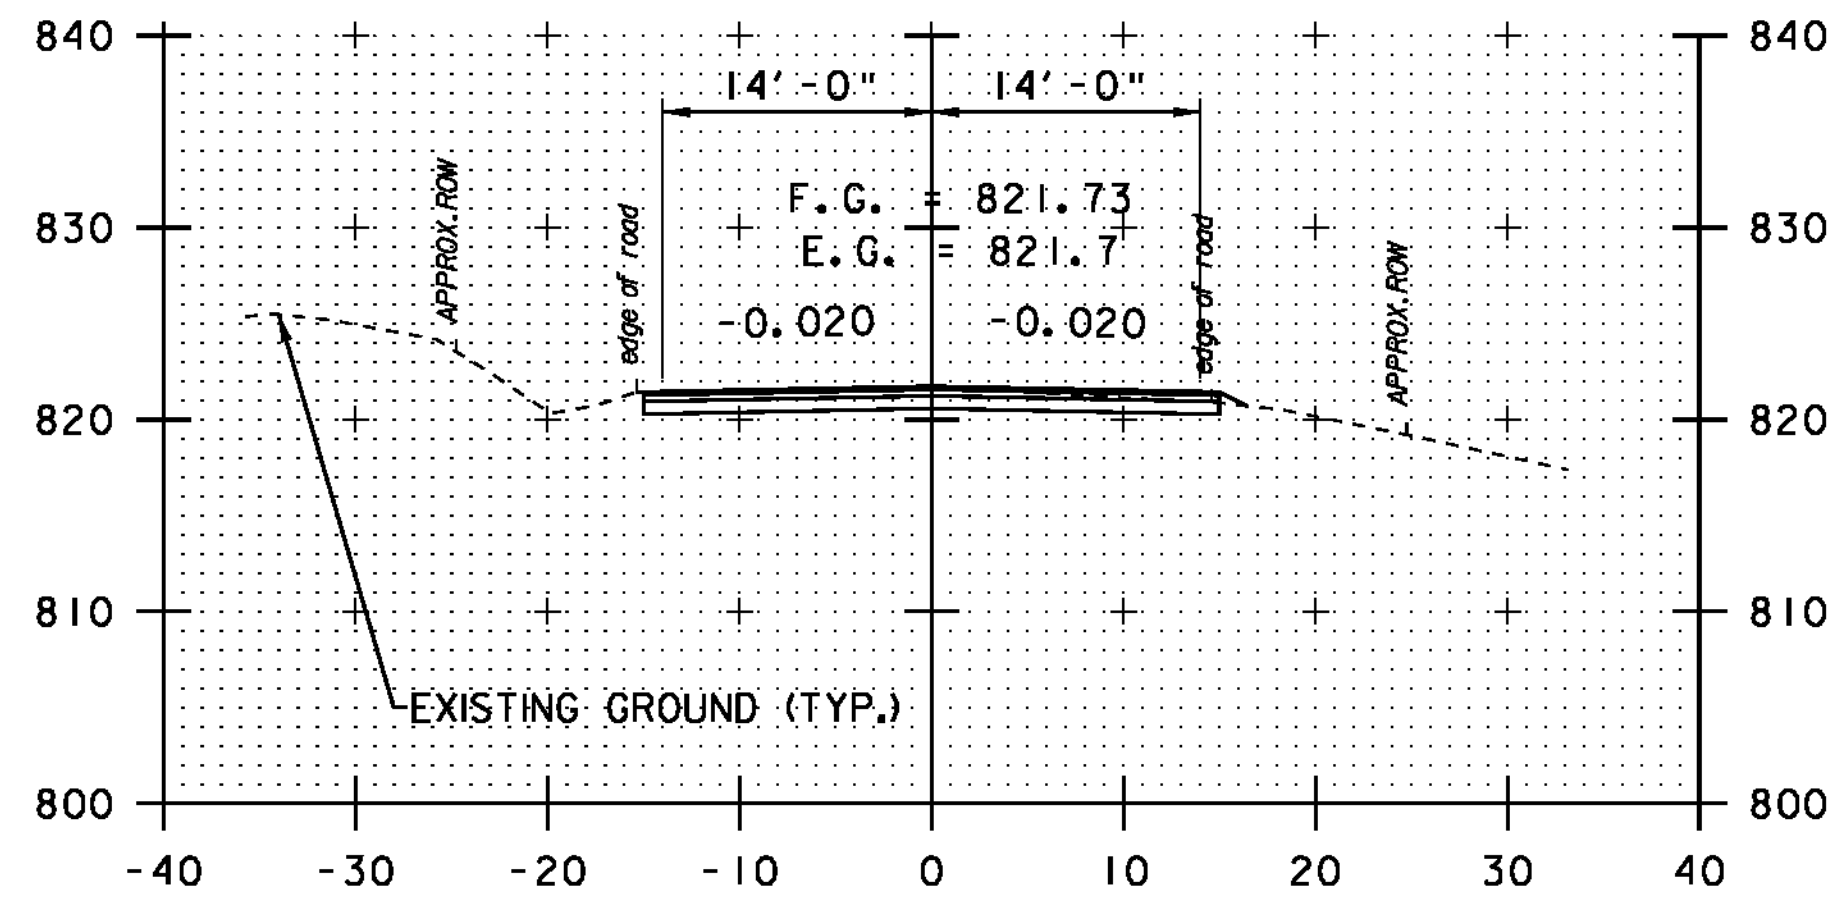

180+00

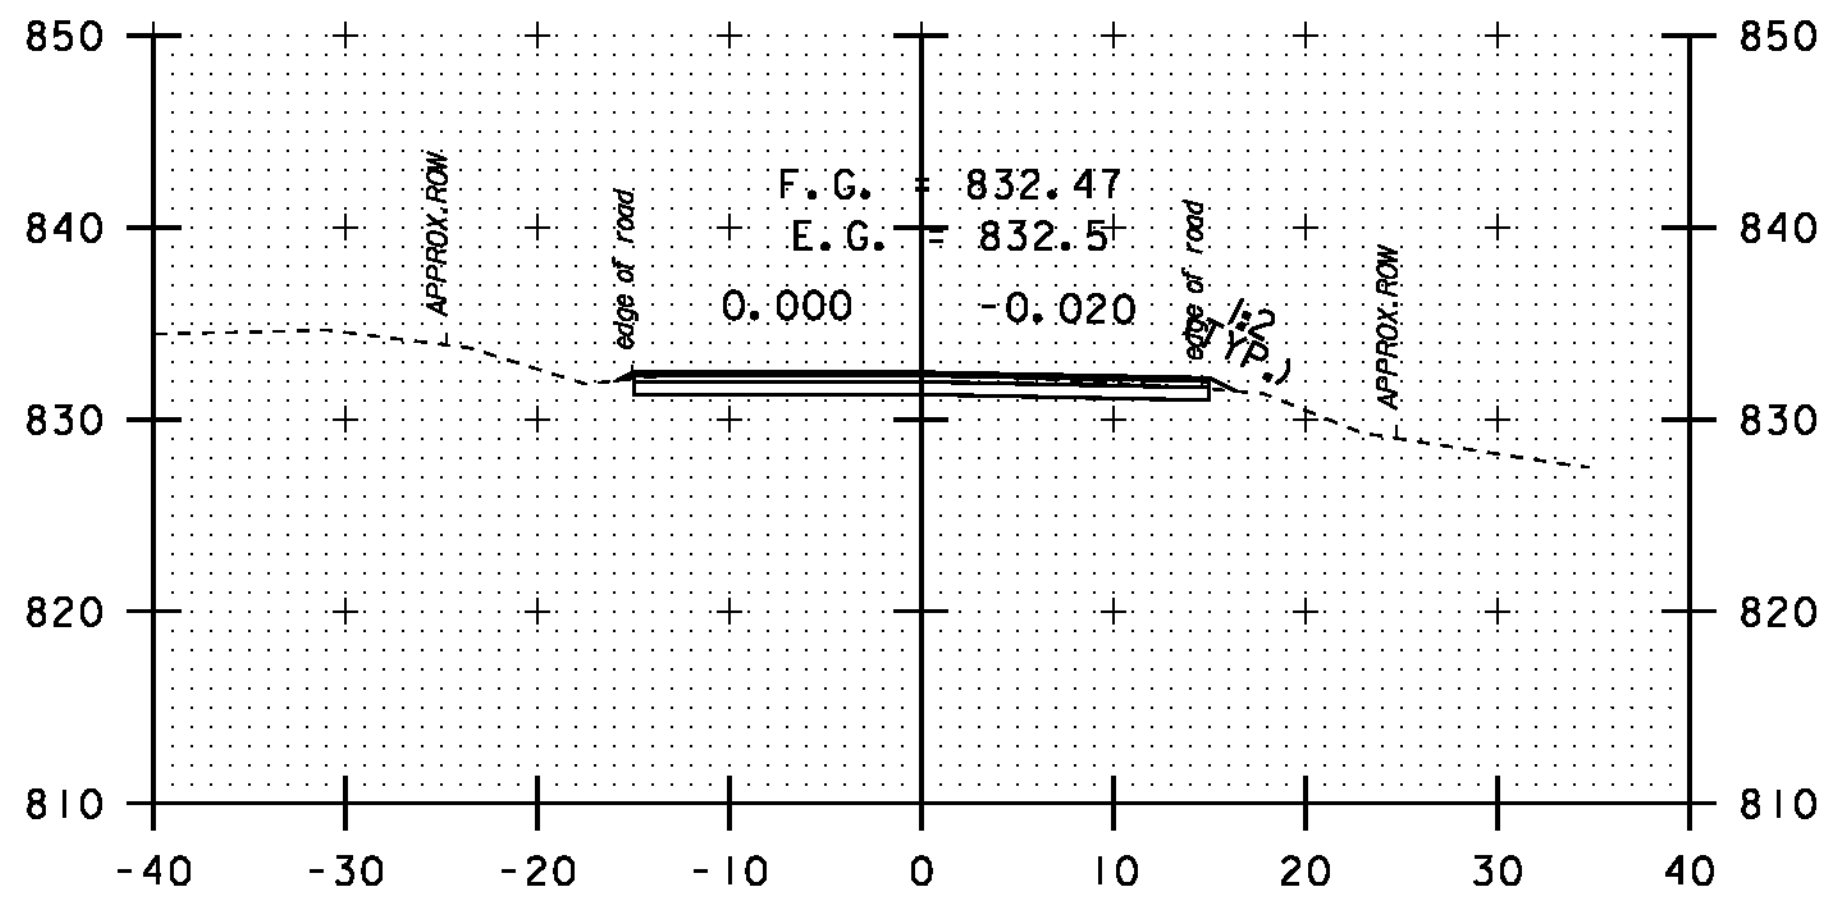

181+60

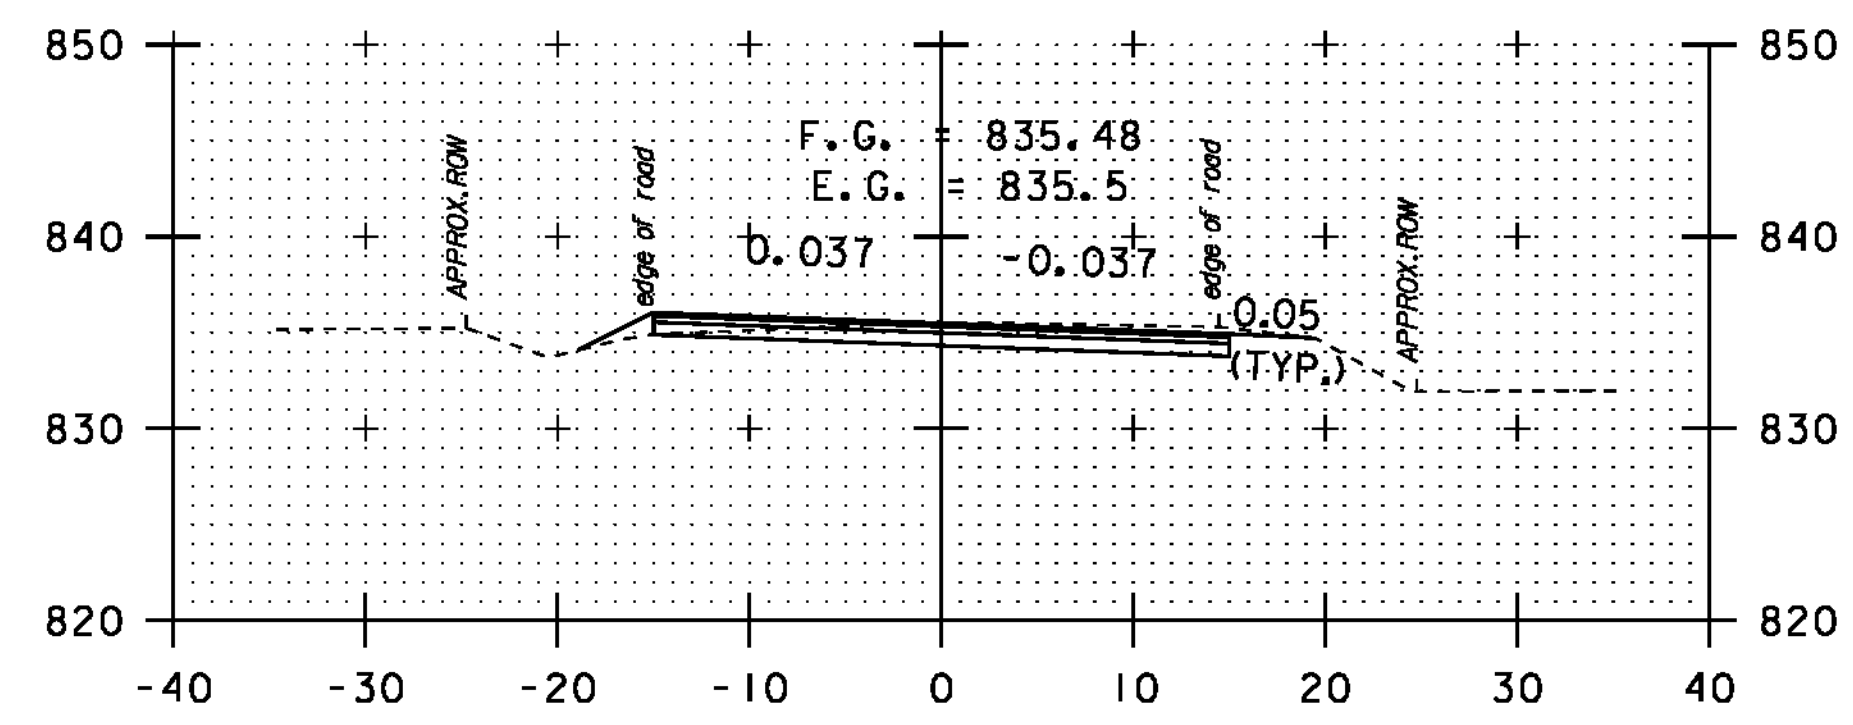

183+10

DATUM	NAVD 88
	NAD 83



STA. 180+00
-
STA. 184+00

CROSS SECTION SHEET 3

PROJECT NAME:	NEWPORT-COVENTRY-NEWPORT
PROJECT NUMBER:	STP 2802(I)
FILE NAME:	08b158.dgn
PROJECT LEADER:	CDL
DESIGNED BY:	BMB
PLOT FILE:	08b158-76.1
PLOT DATE:	8/3/2011
DRAWN BY:	BMB
CHECKED BY:	EPD
SHEET	76 OF 134