




186+05

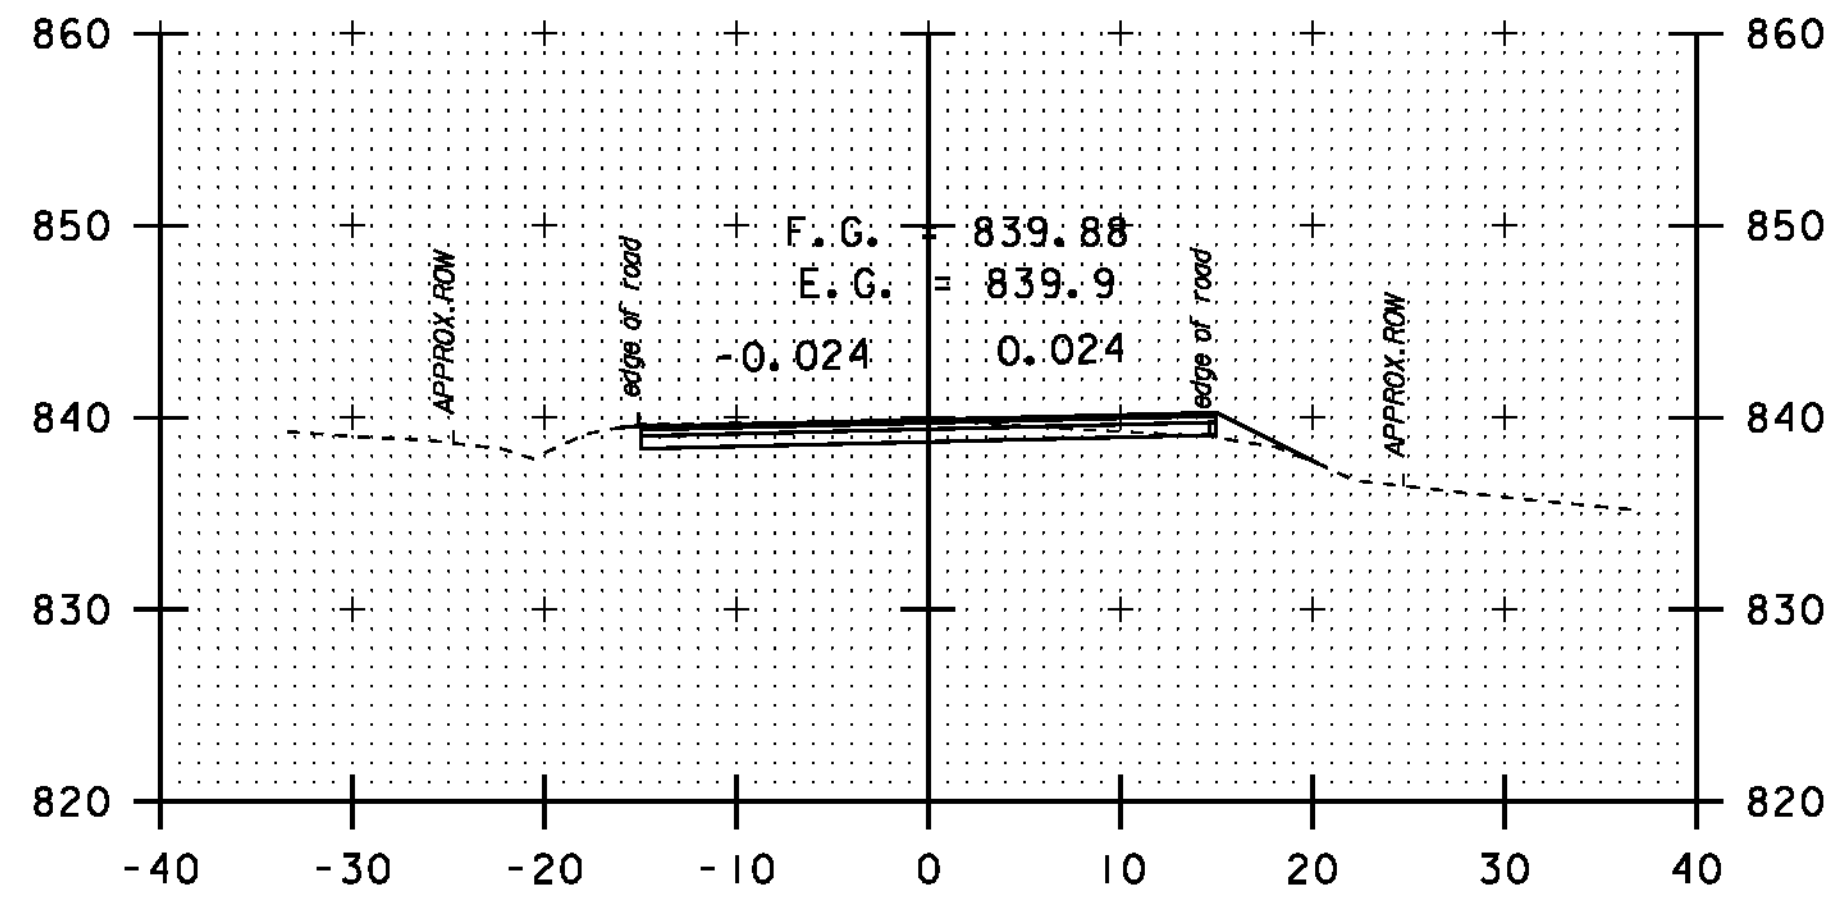


186+74

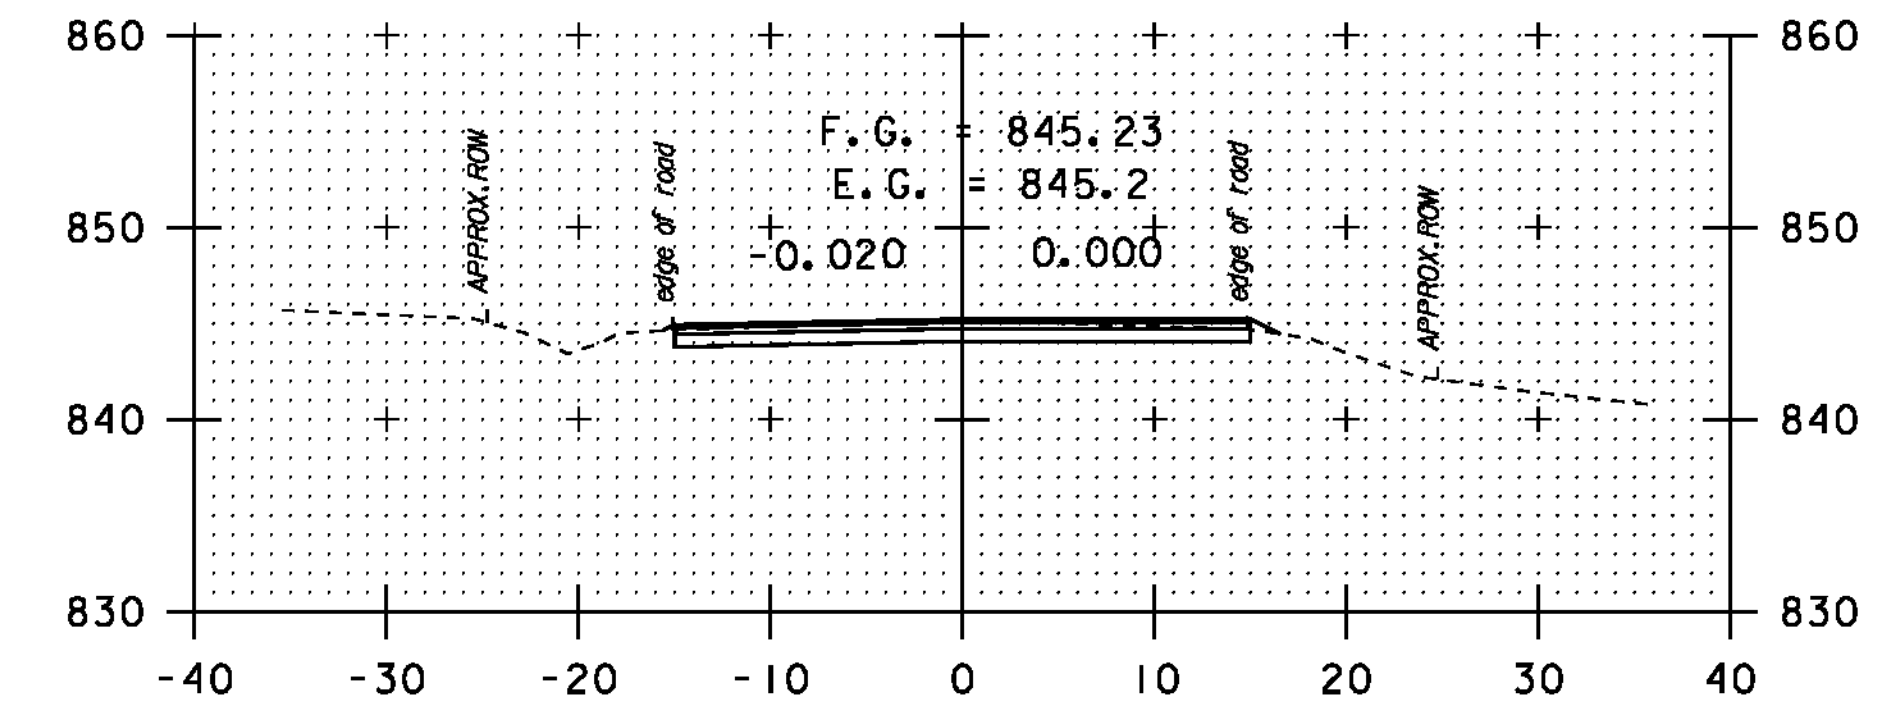


188+25

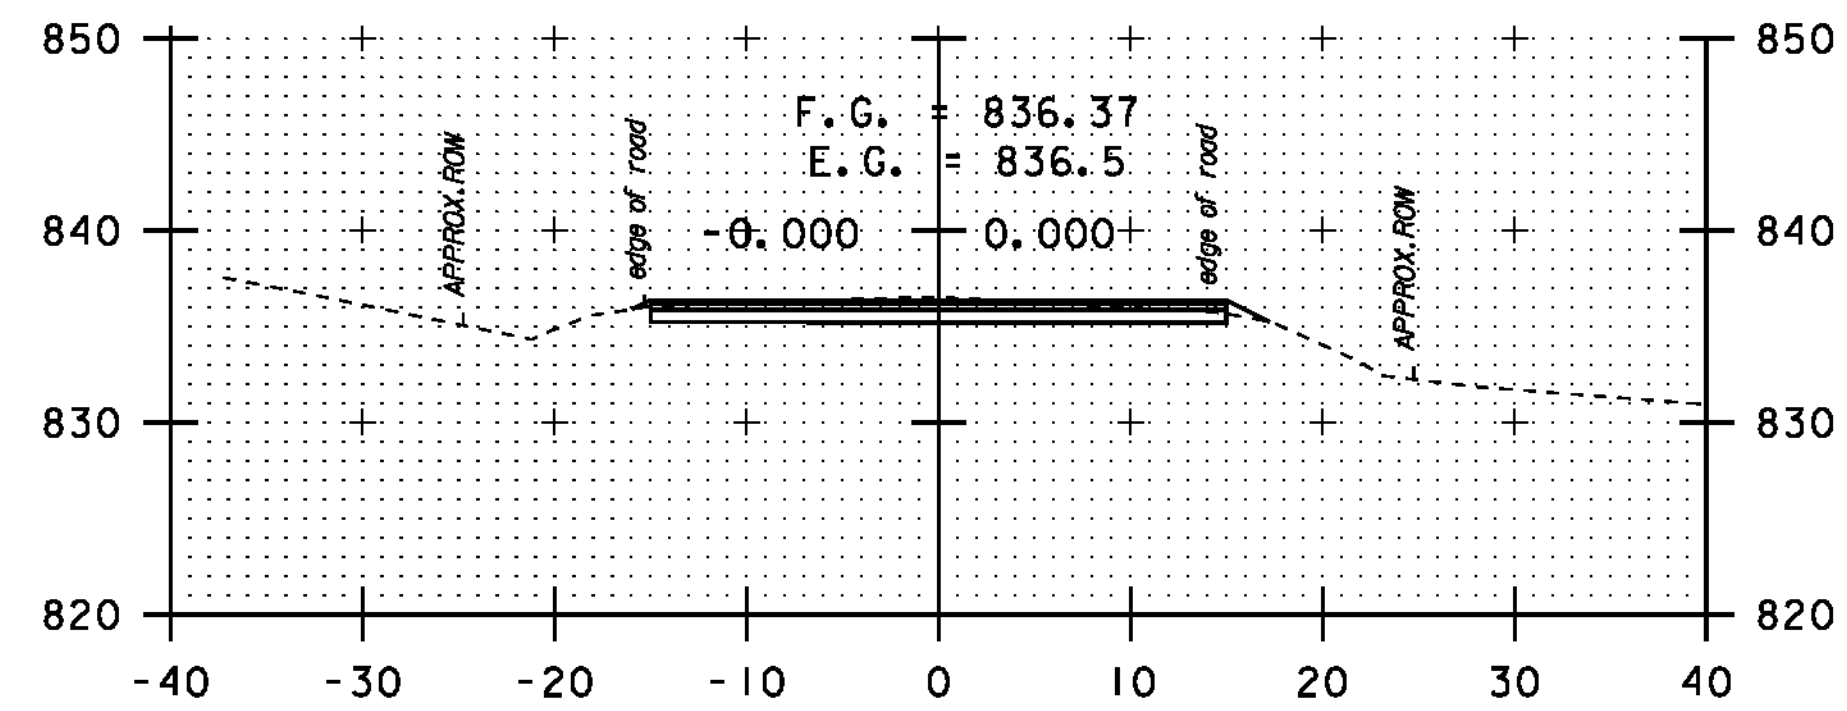


185+32

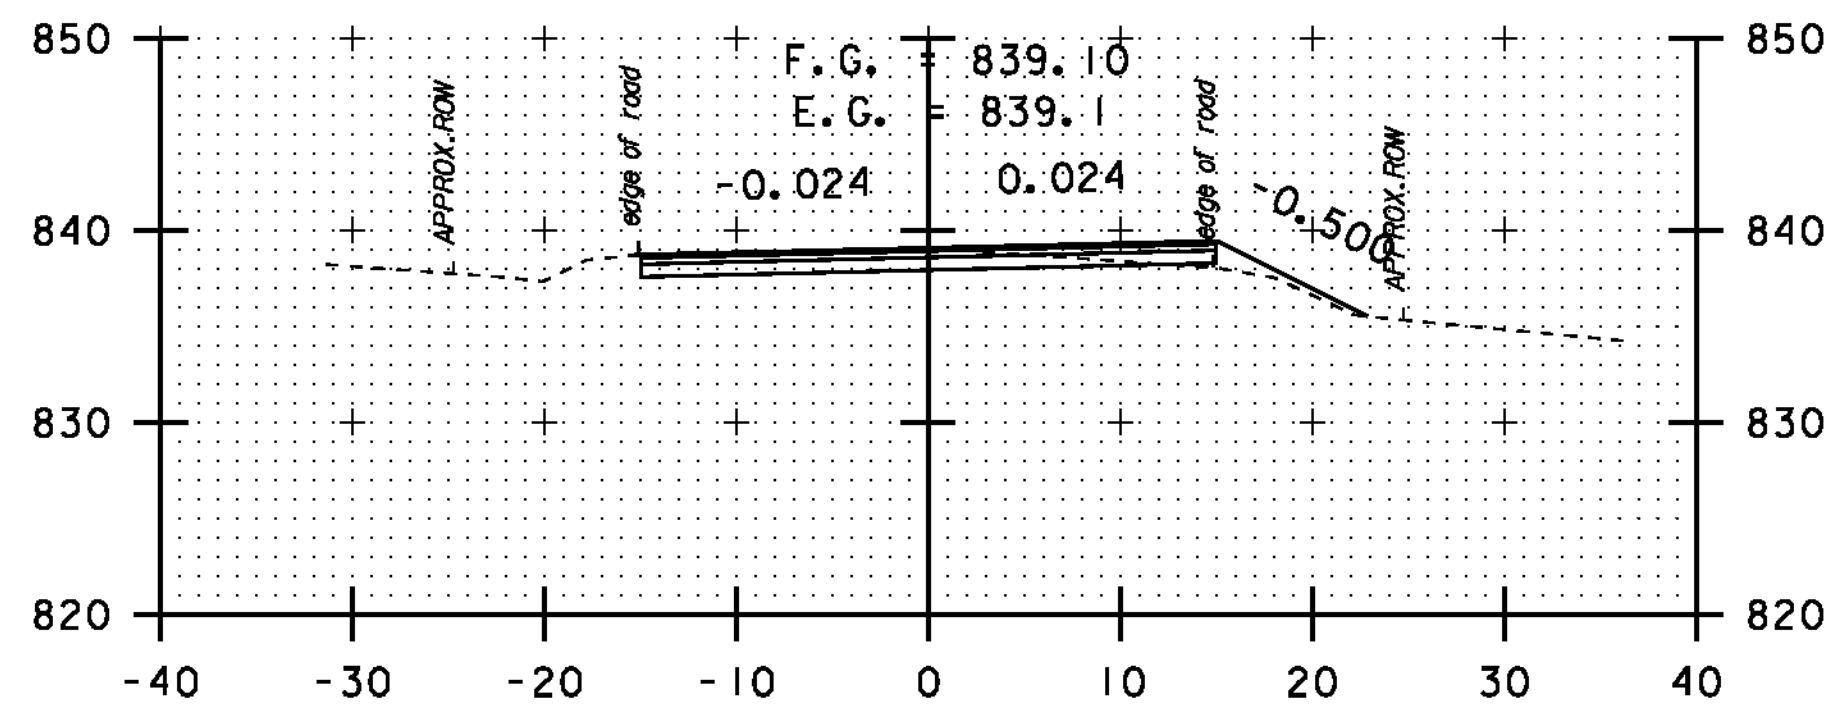


186+50

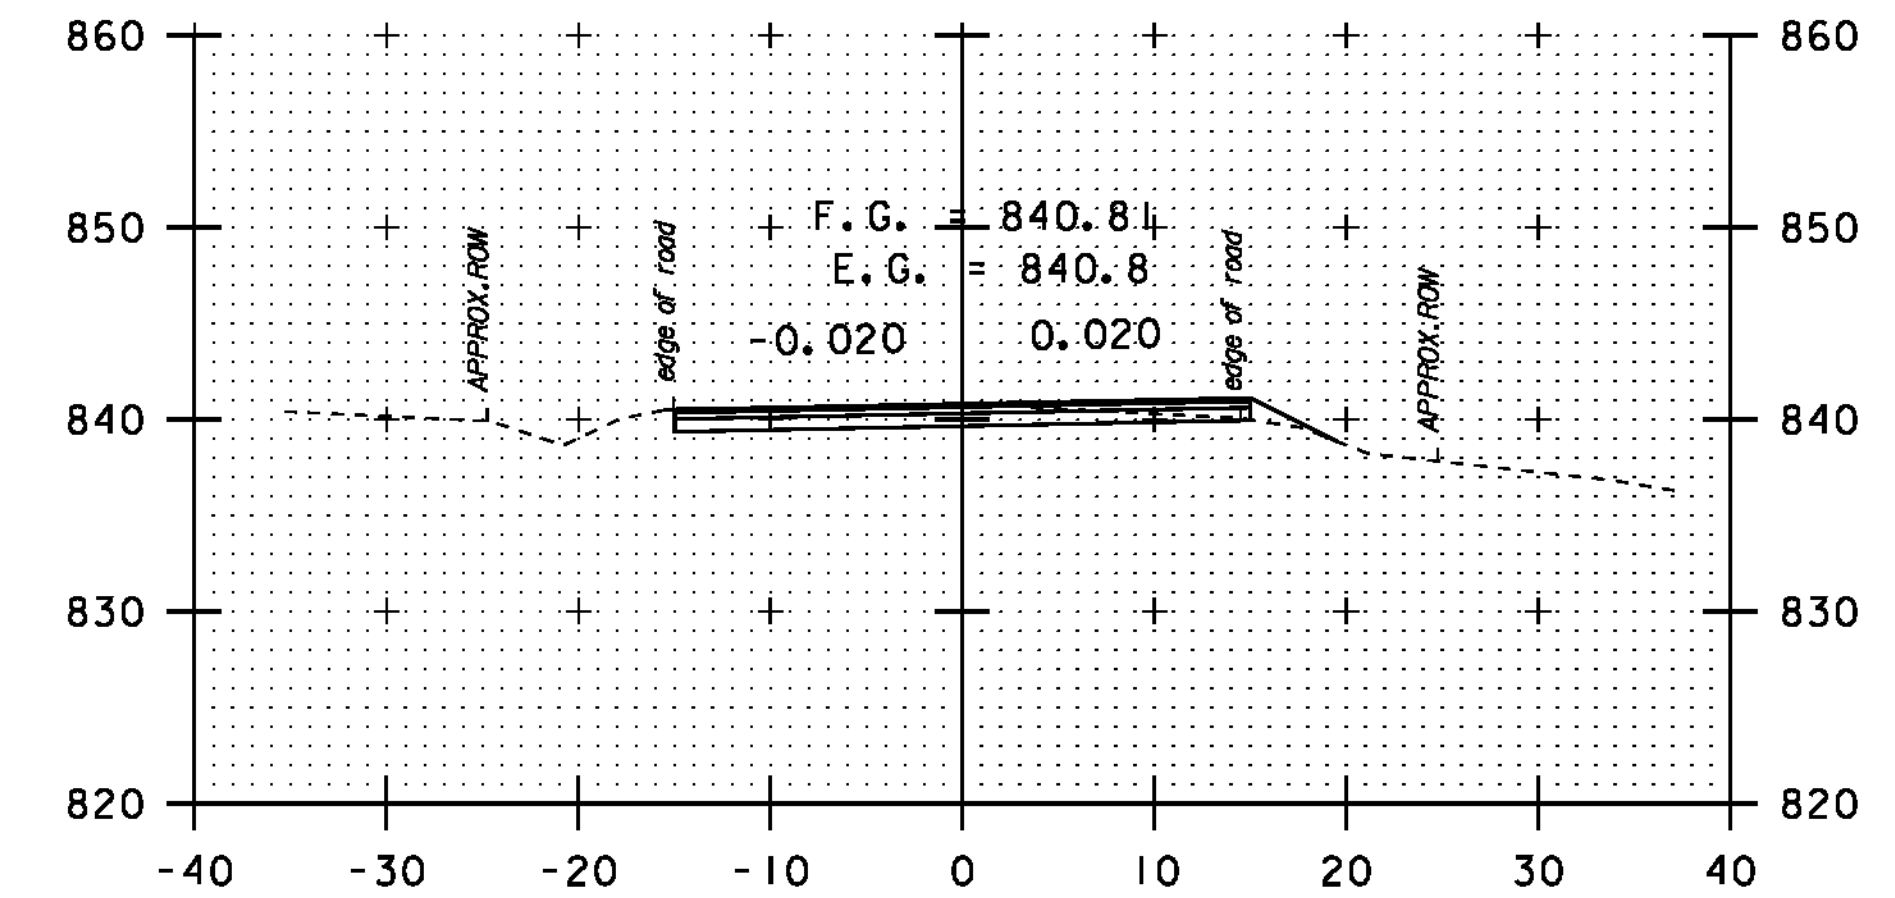


187+00

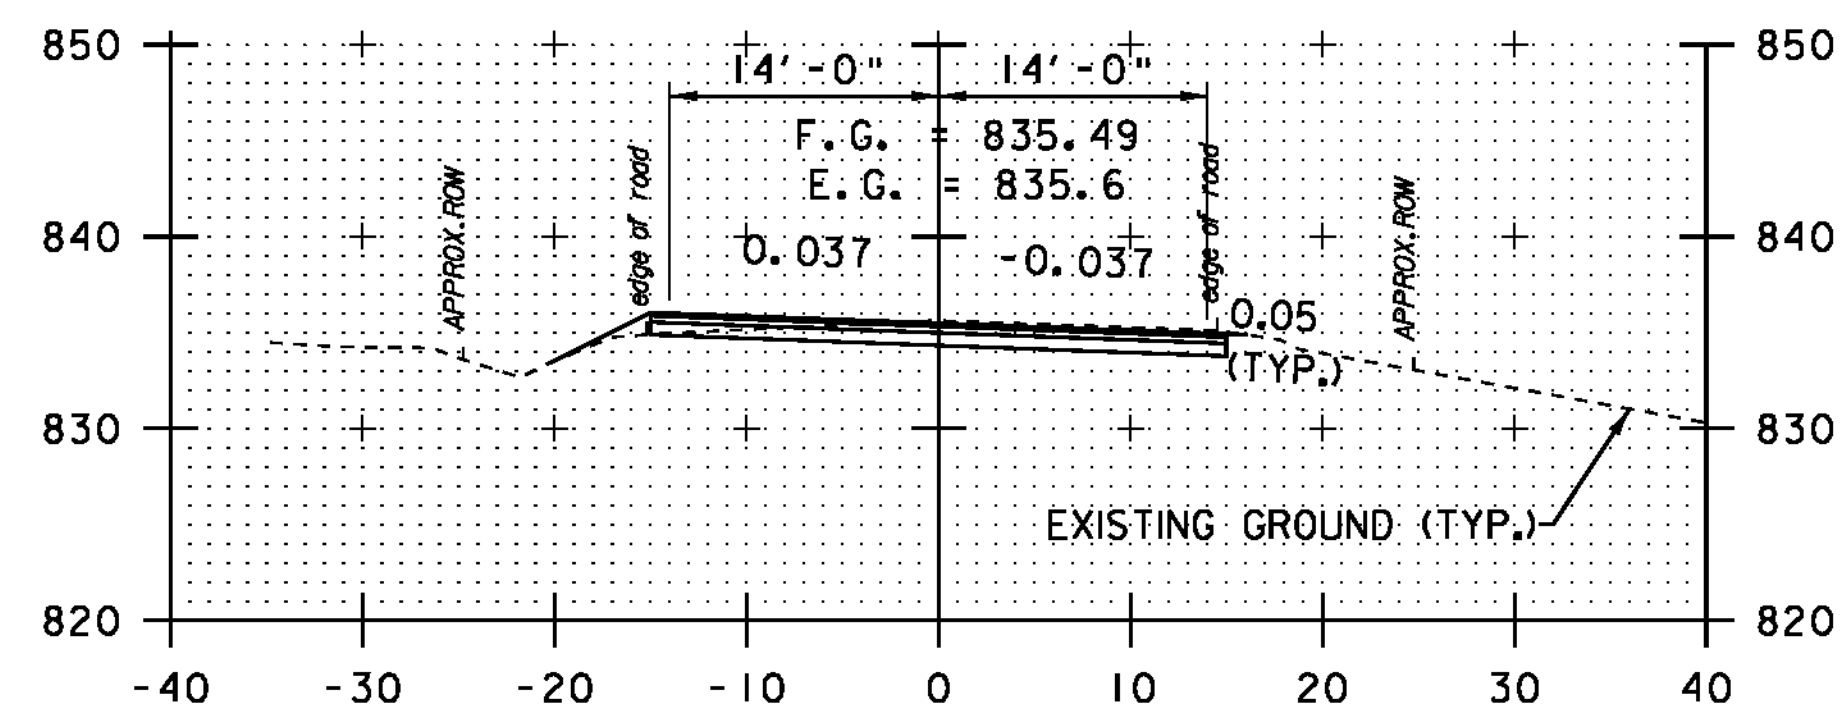

184+20

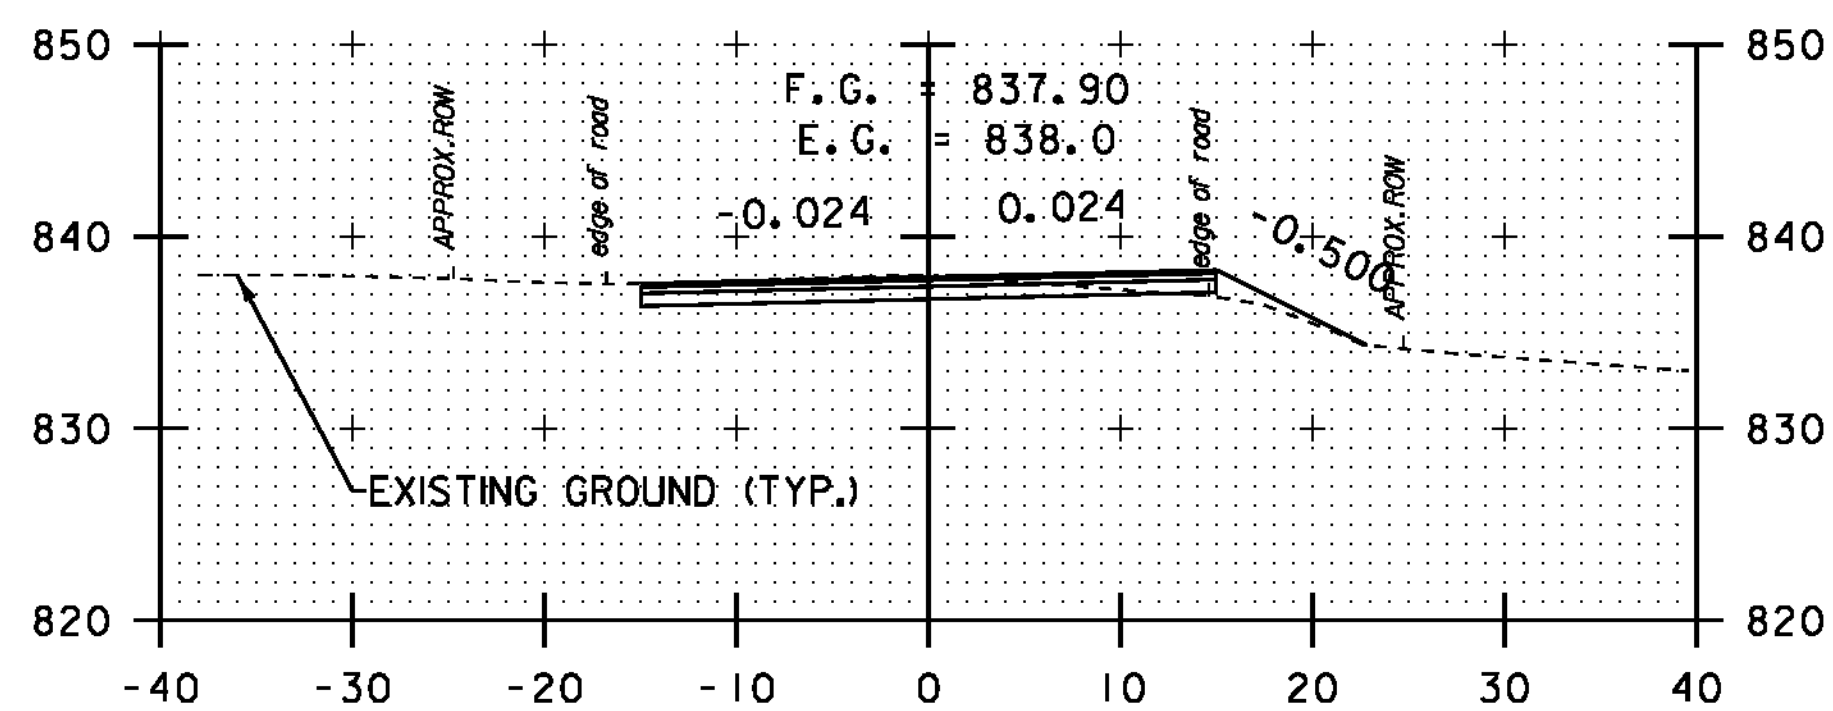

186+07

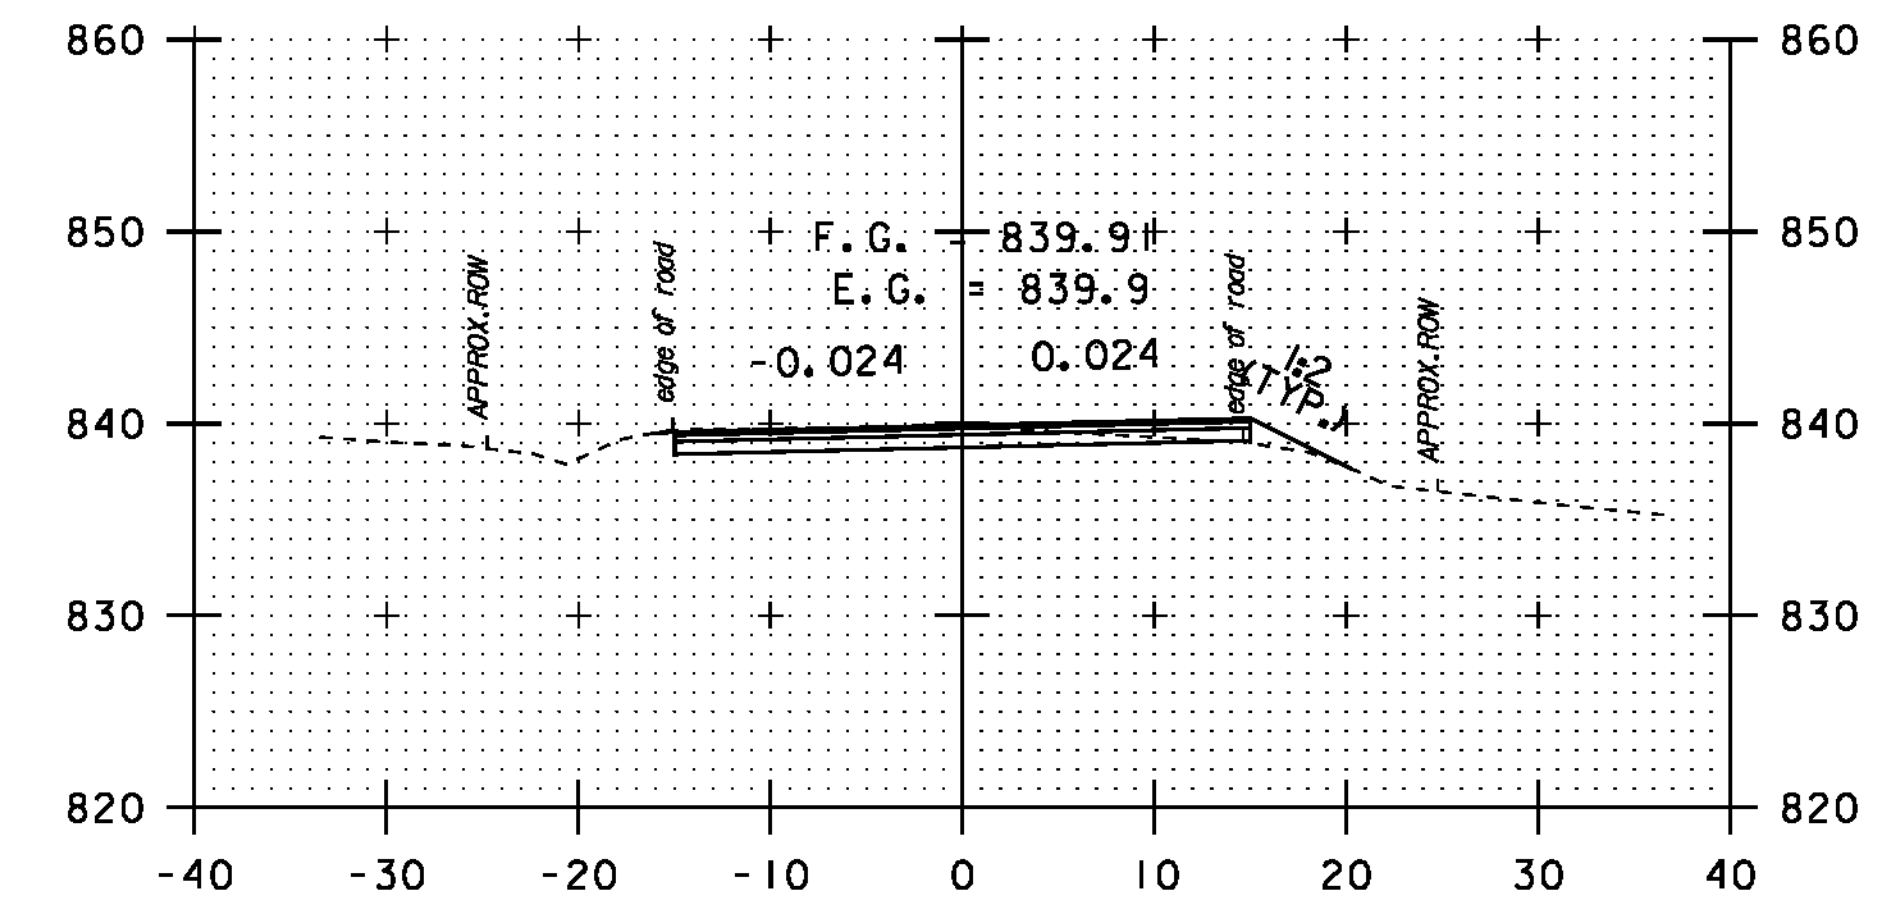

186+75

DATUM	NAVD 88
	NAD 83



STA. 184 + 20
-
STA. 188 + 25

CROSS SECTION SHEET 4

PROJECT NAME:	NEWPORT-COVENTRY-NEWPORT
PROJECT NUMBER:	STP 2802(I)
FILE NAME:	08b158.dgn
PROJECT LEADER:	CDL
DESIGNED BY:	BMB
PLOT FILE:	08b158-77.1
PLOT DATE:	8/3/2011
DRAWN BY:	BMB
CHECKED BY:	EPD
SHEET	77 OF 134