




194+00

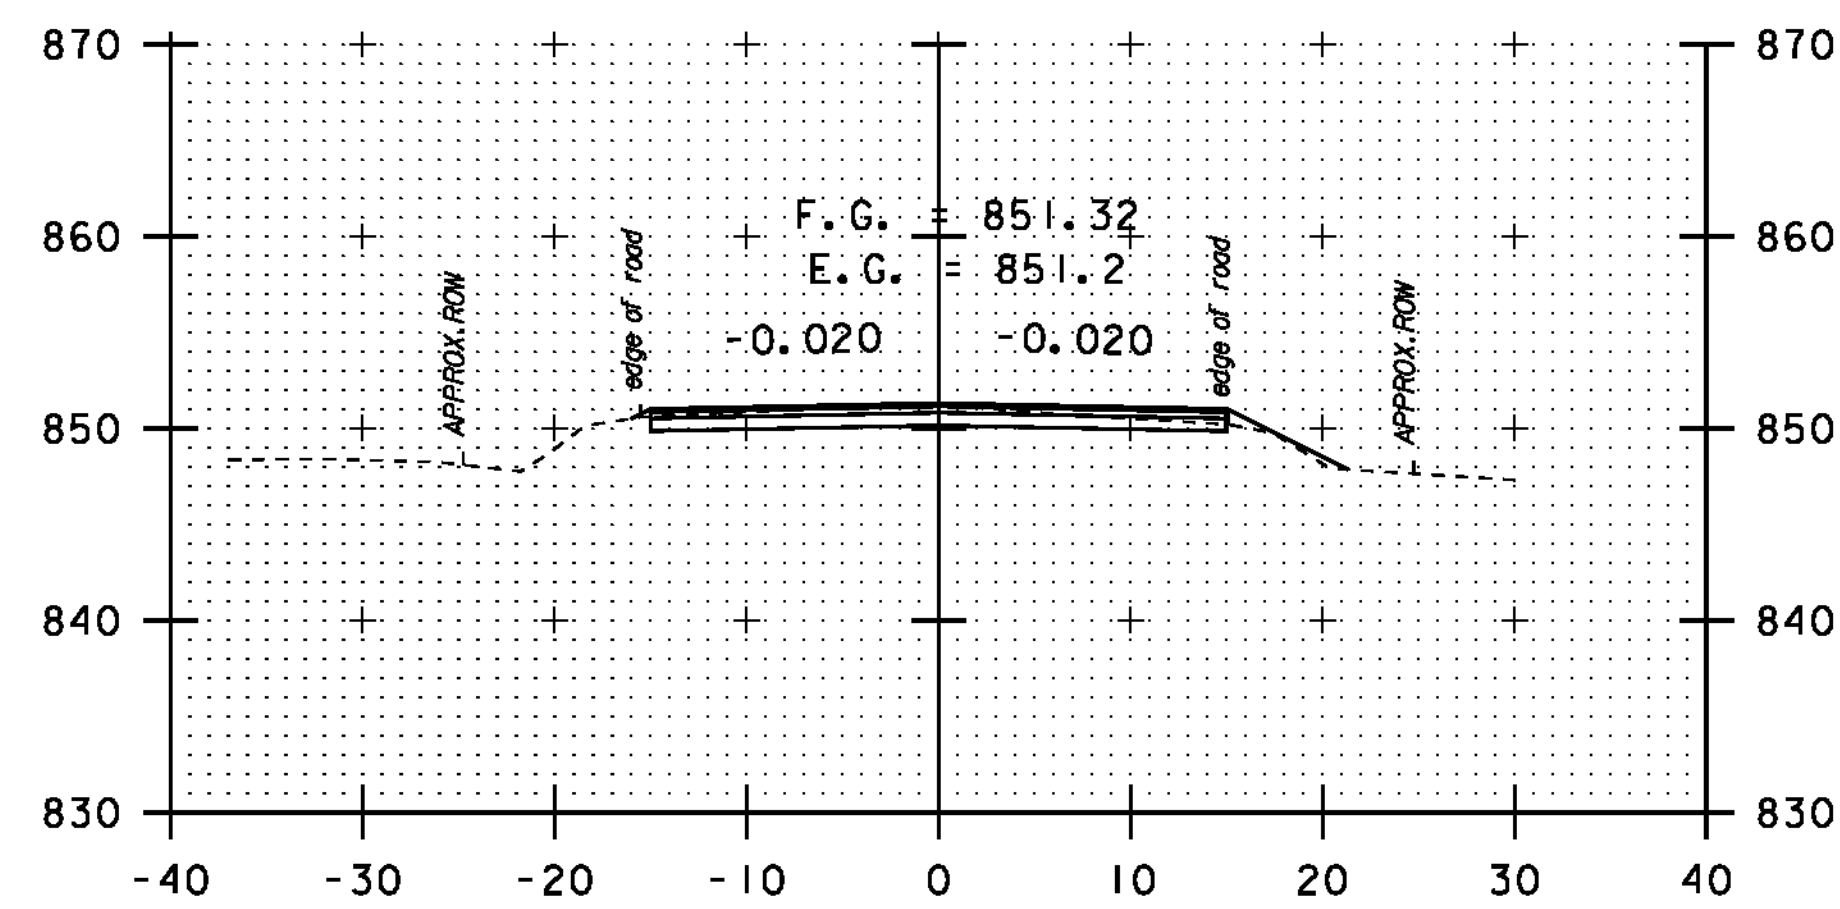


193+50

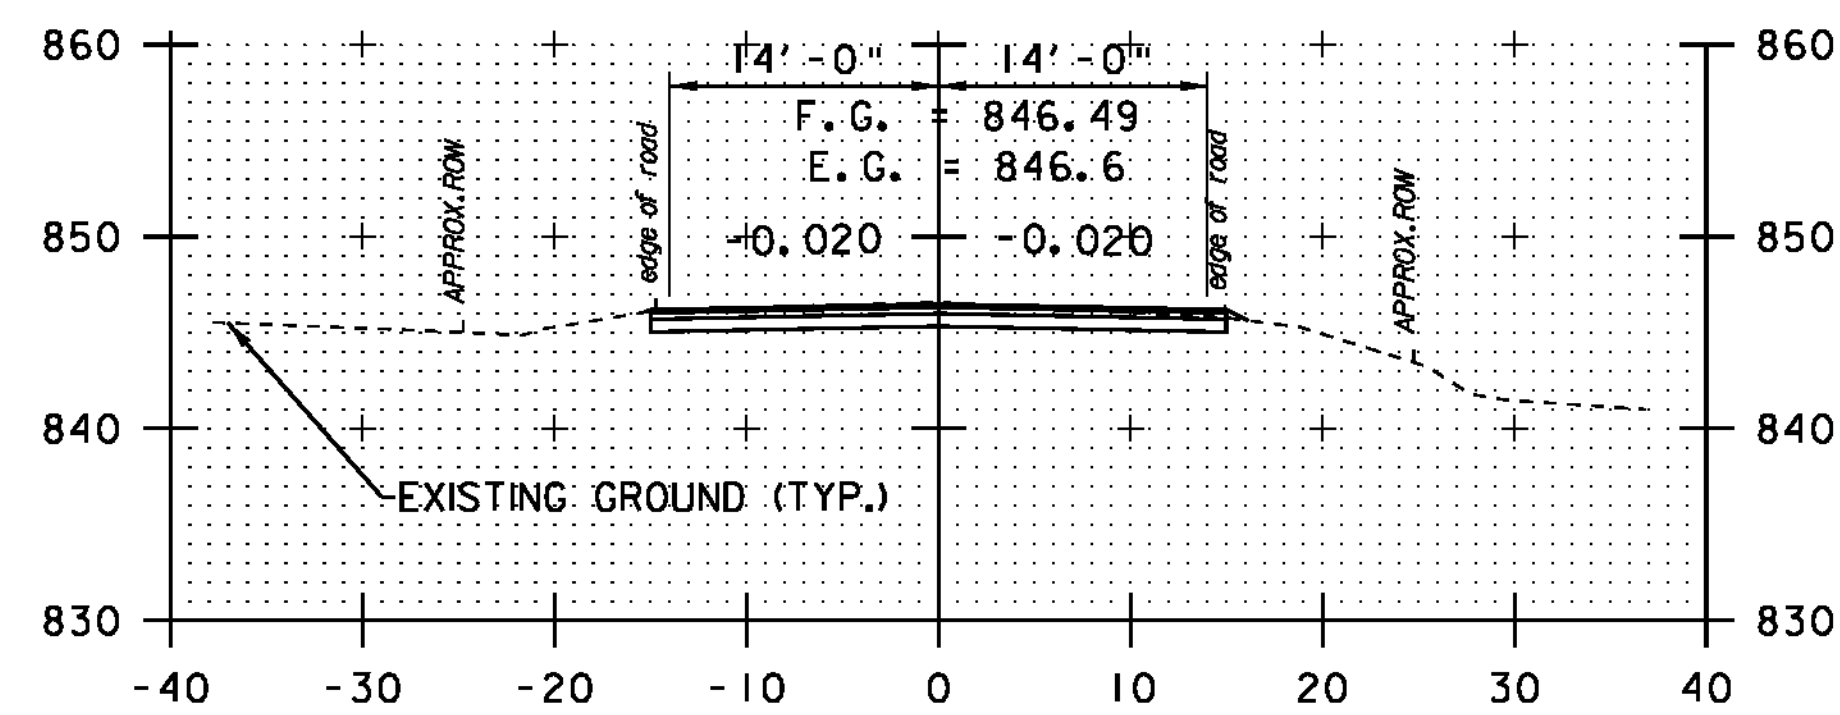


189+25

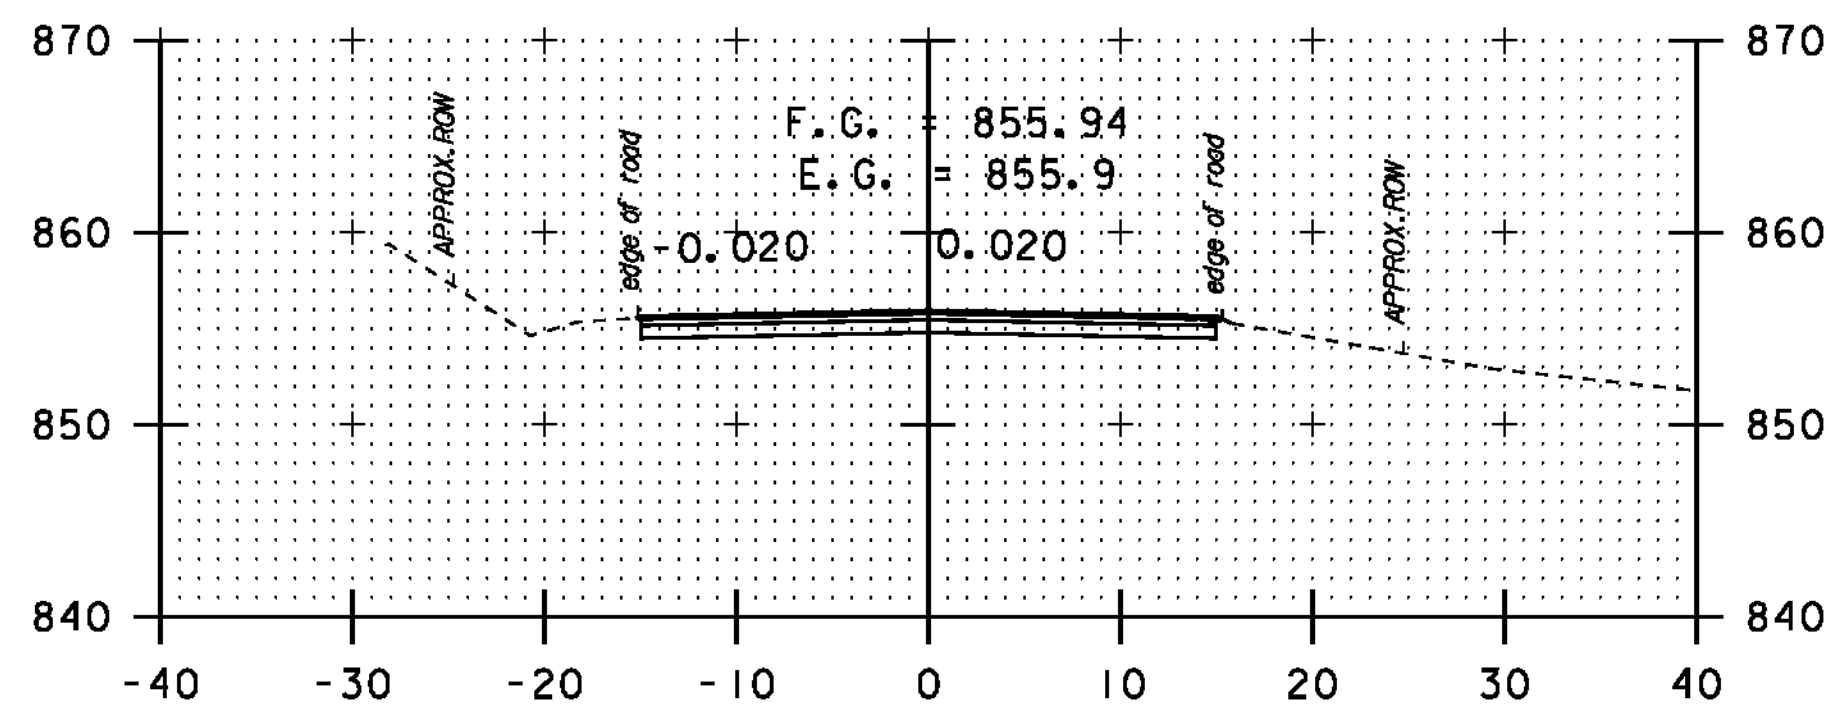


195+86

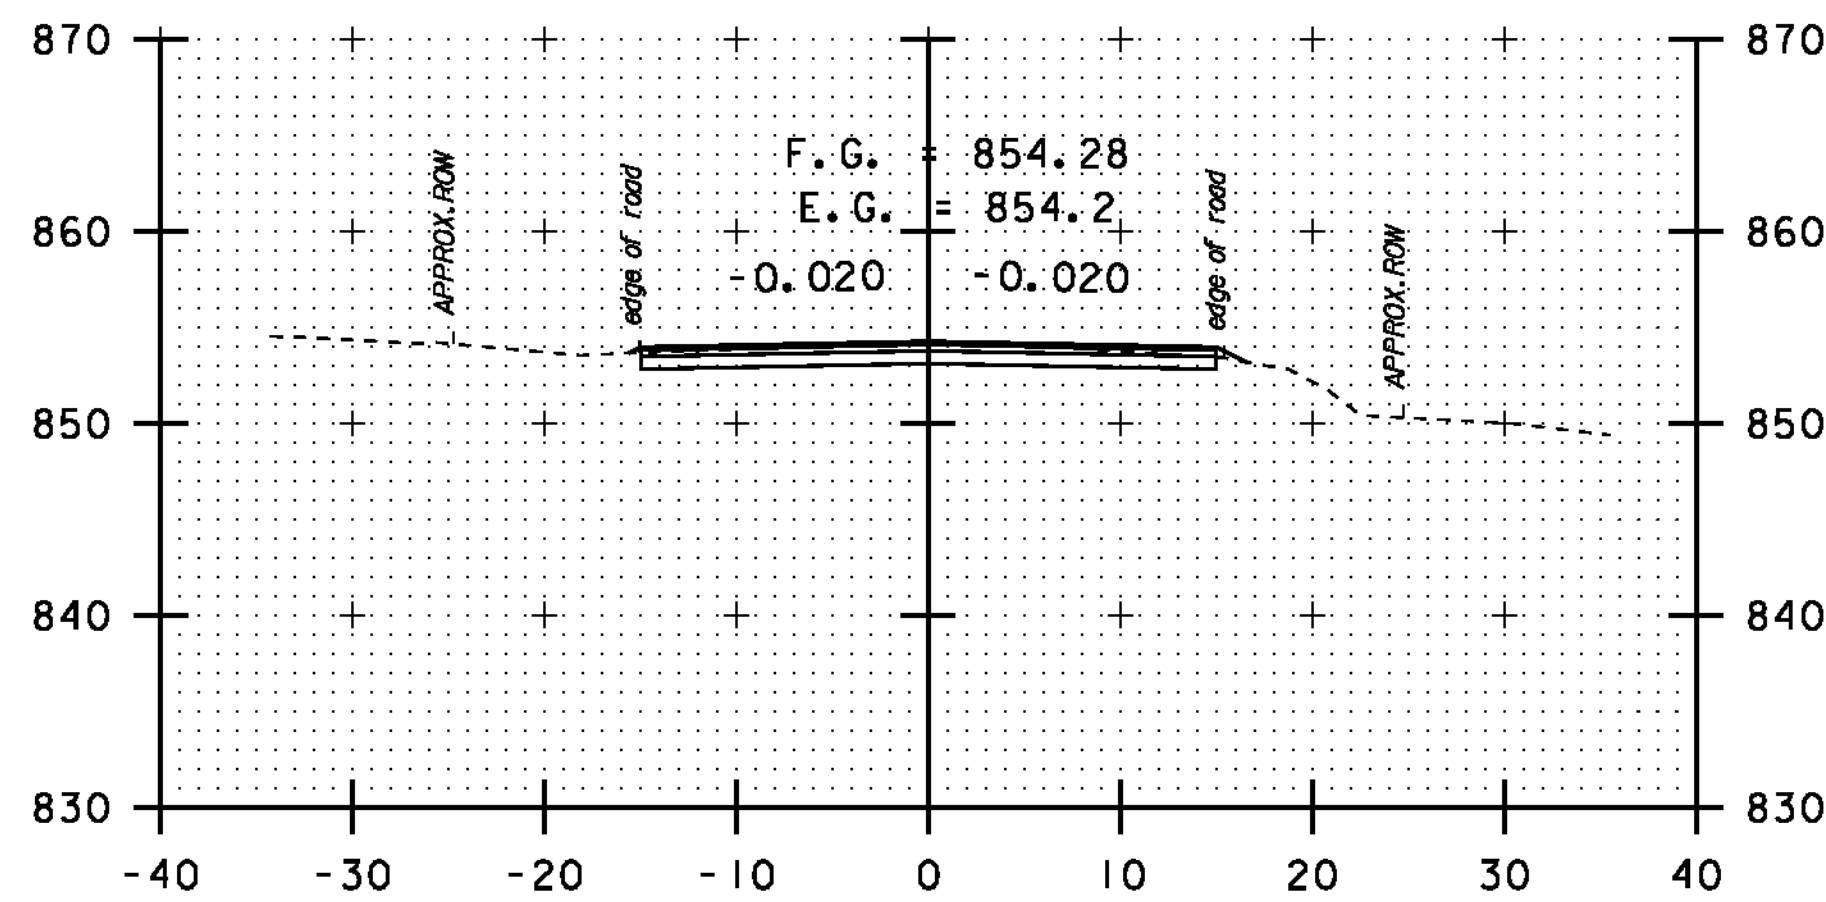


195+05

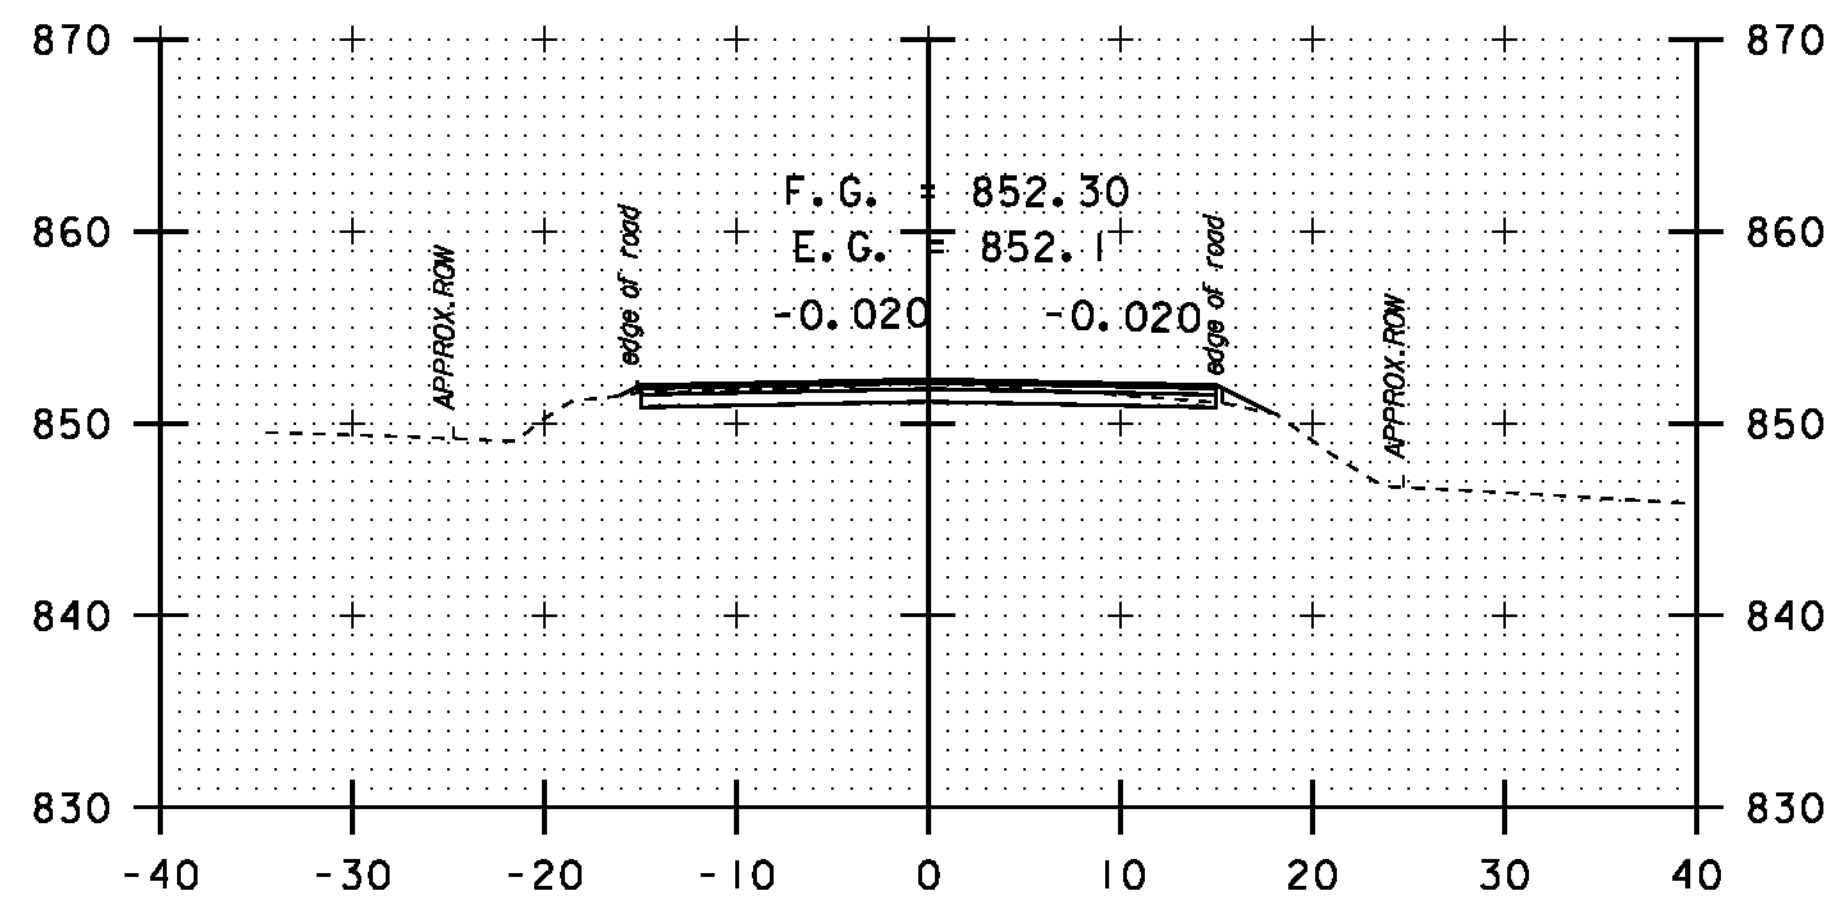


194+05

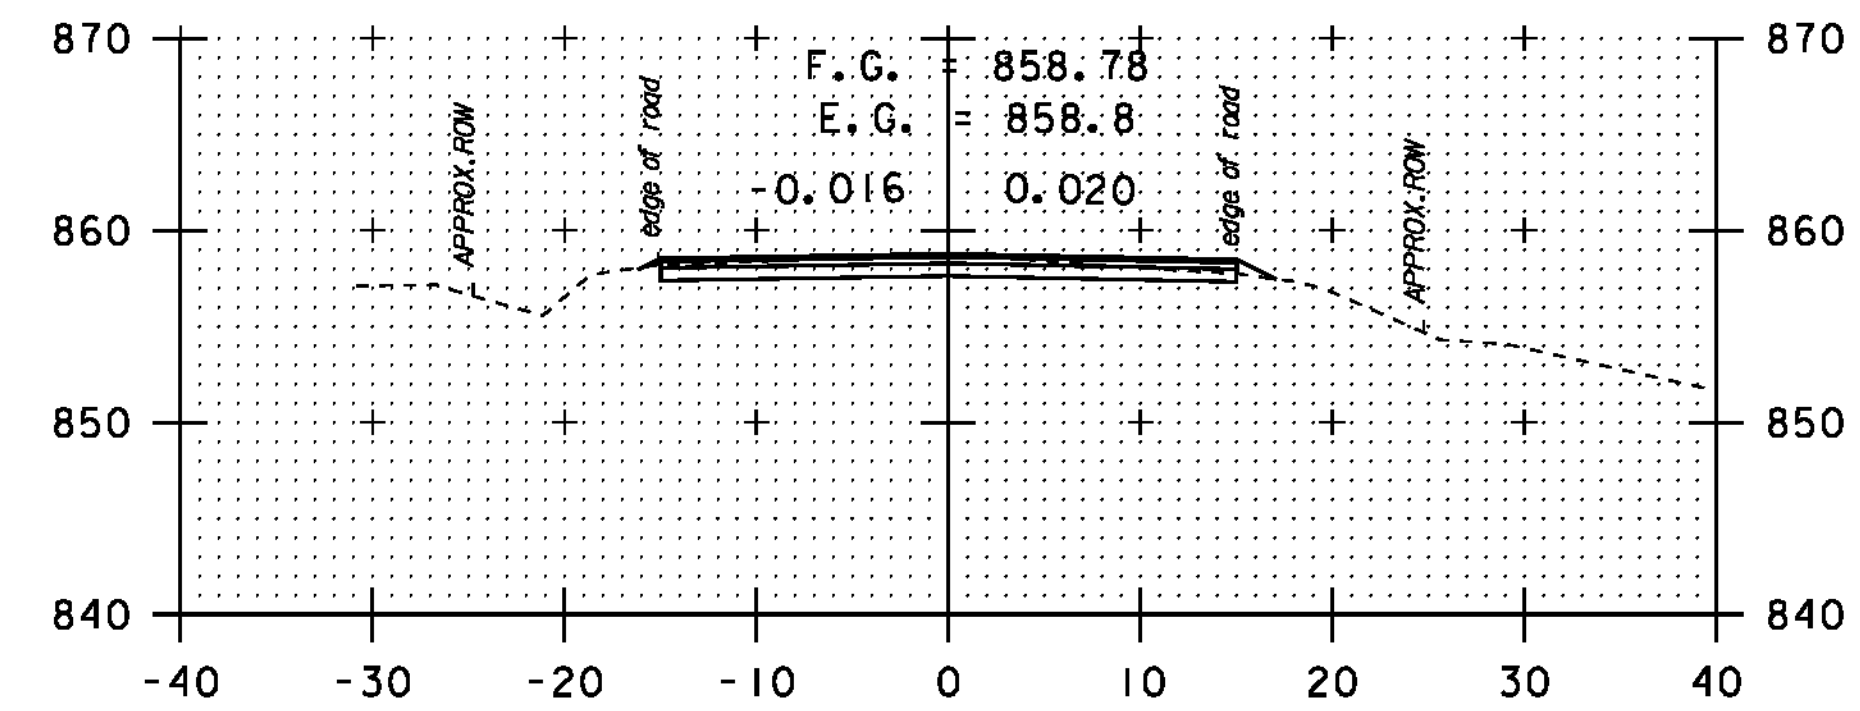

197+25

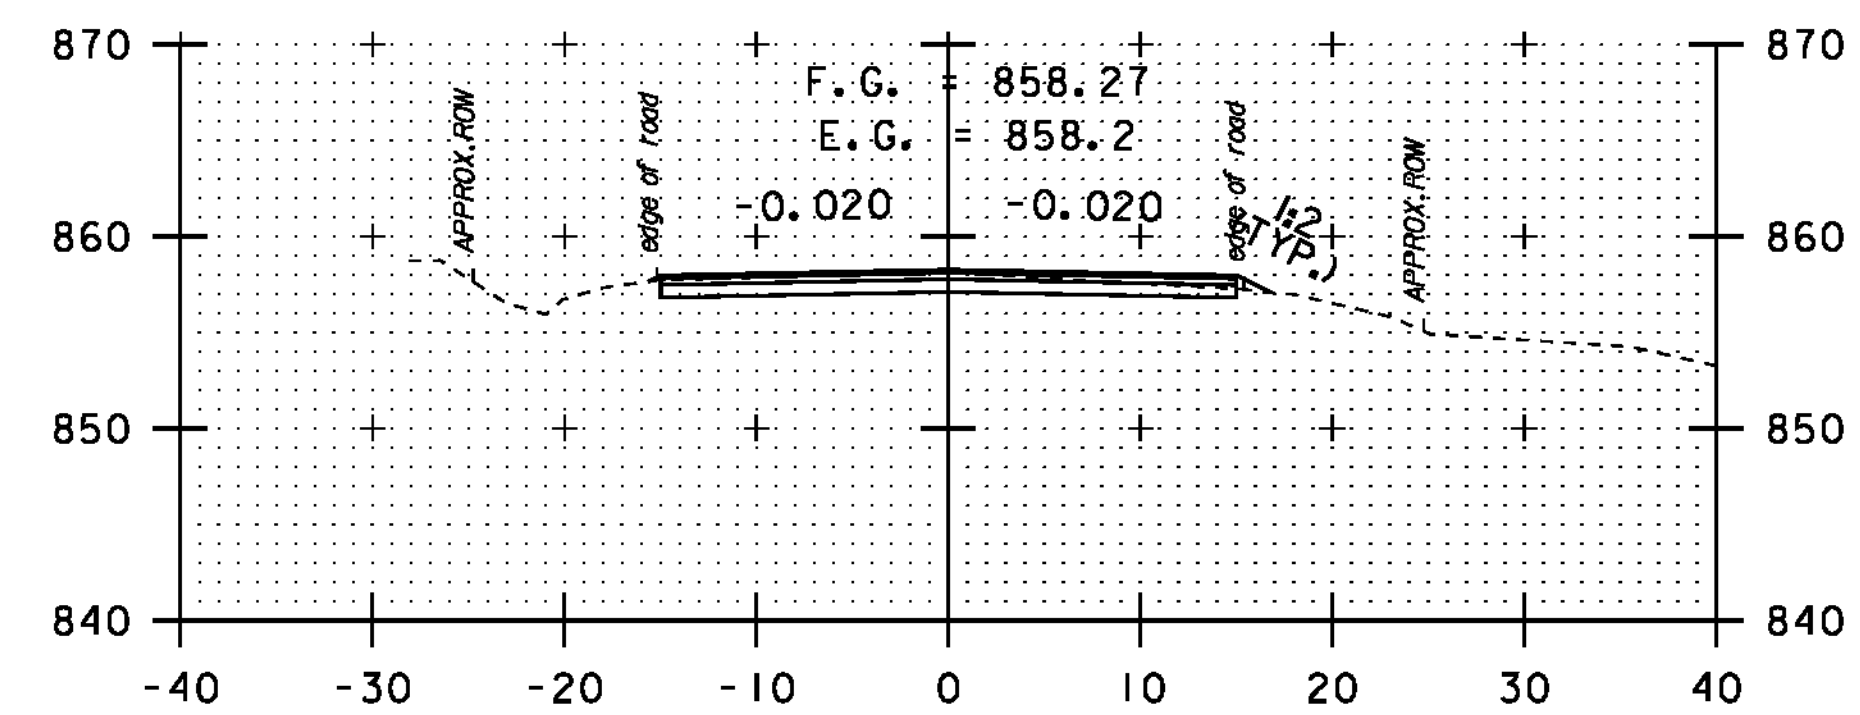

197+00

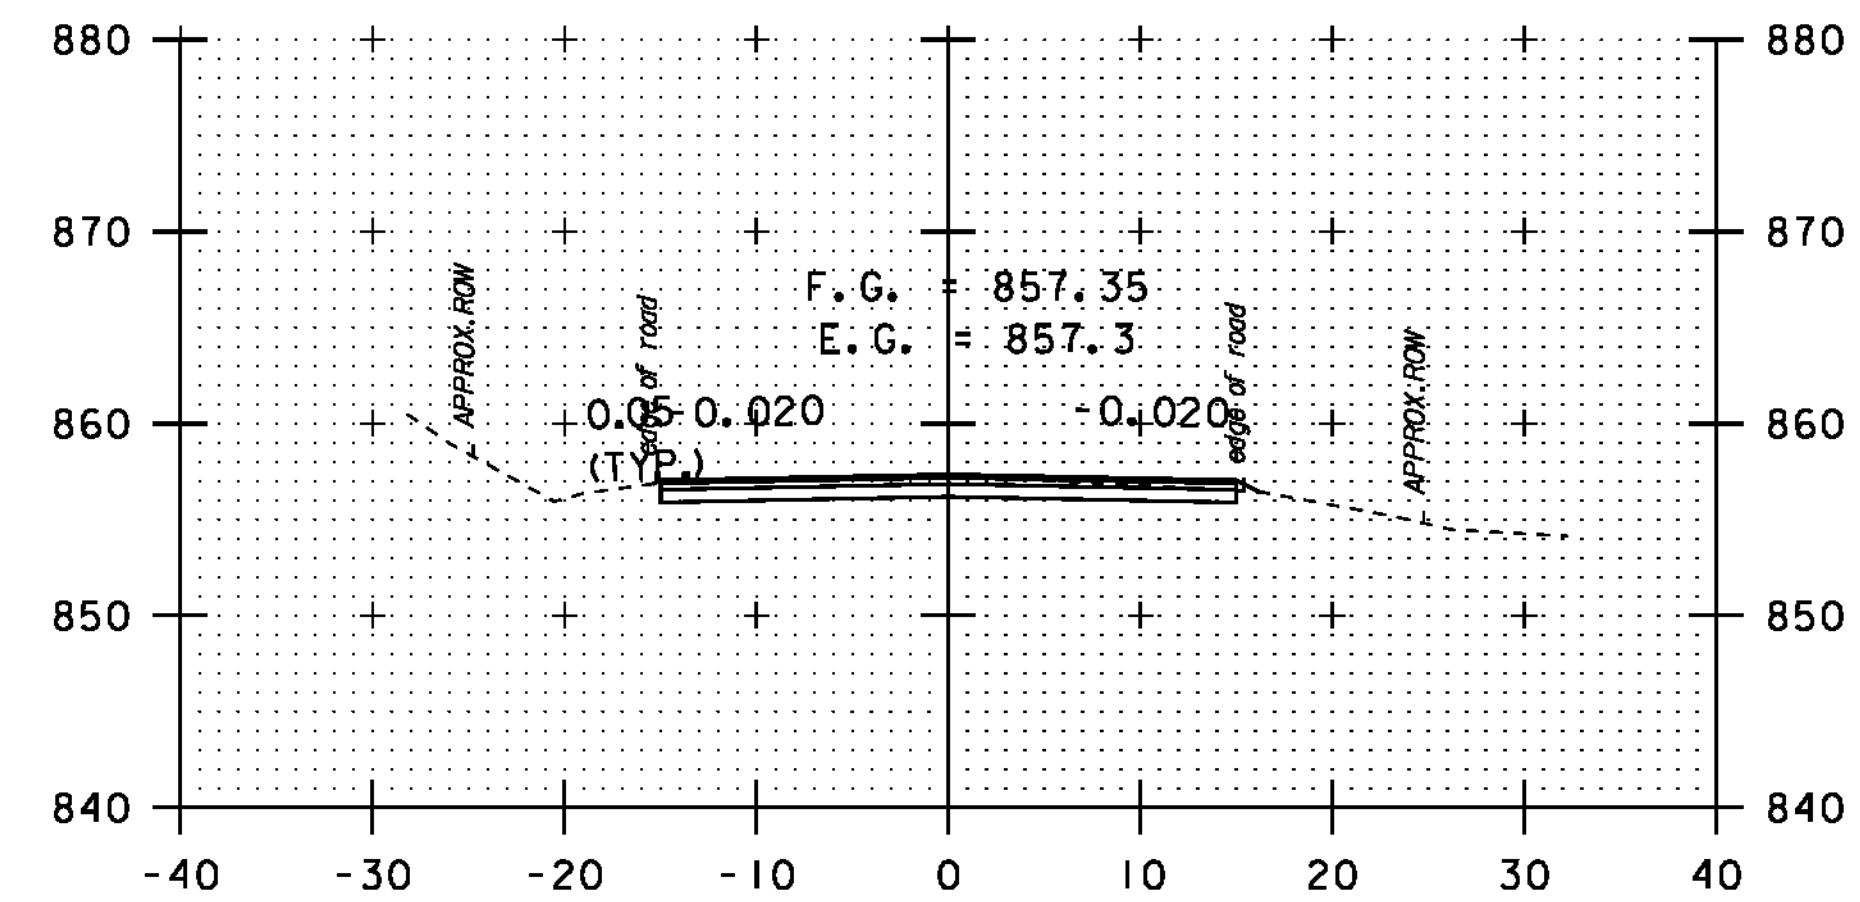

196+55

DATUM	NAVD 88
	NAD 83



STA. 189+25
-
STA. 197+25

CROSS SECTION SHEET 5

PROJECT NAME:	NEWPORT-COVENTRY-NEWPORT
PROJECT NUMBER:	STP 2802(I)
FILE NAME:	08b158.dgn
PROJECT LEADER:	CDL
DESIGNED BY:	BMB
PLOT FILE:	08b158-78.1
PLOT DATE:	8/3/2011
DRAWN BY:	BMB
CHECKED BY:	EPD
SHEET	78 OF 134