




209+00

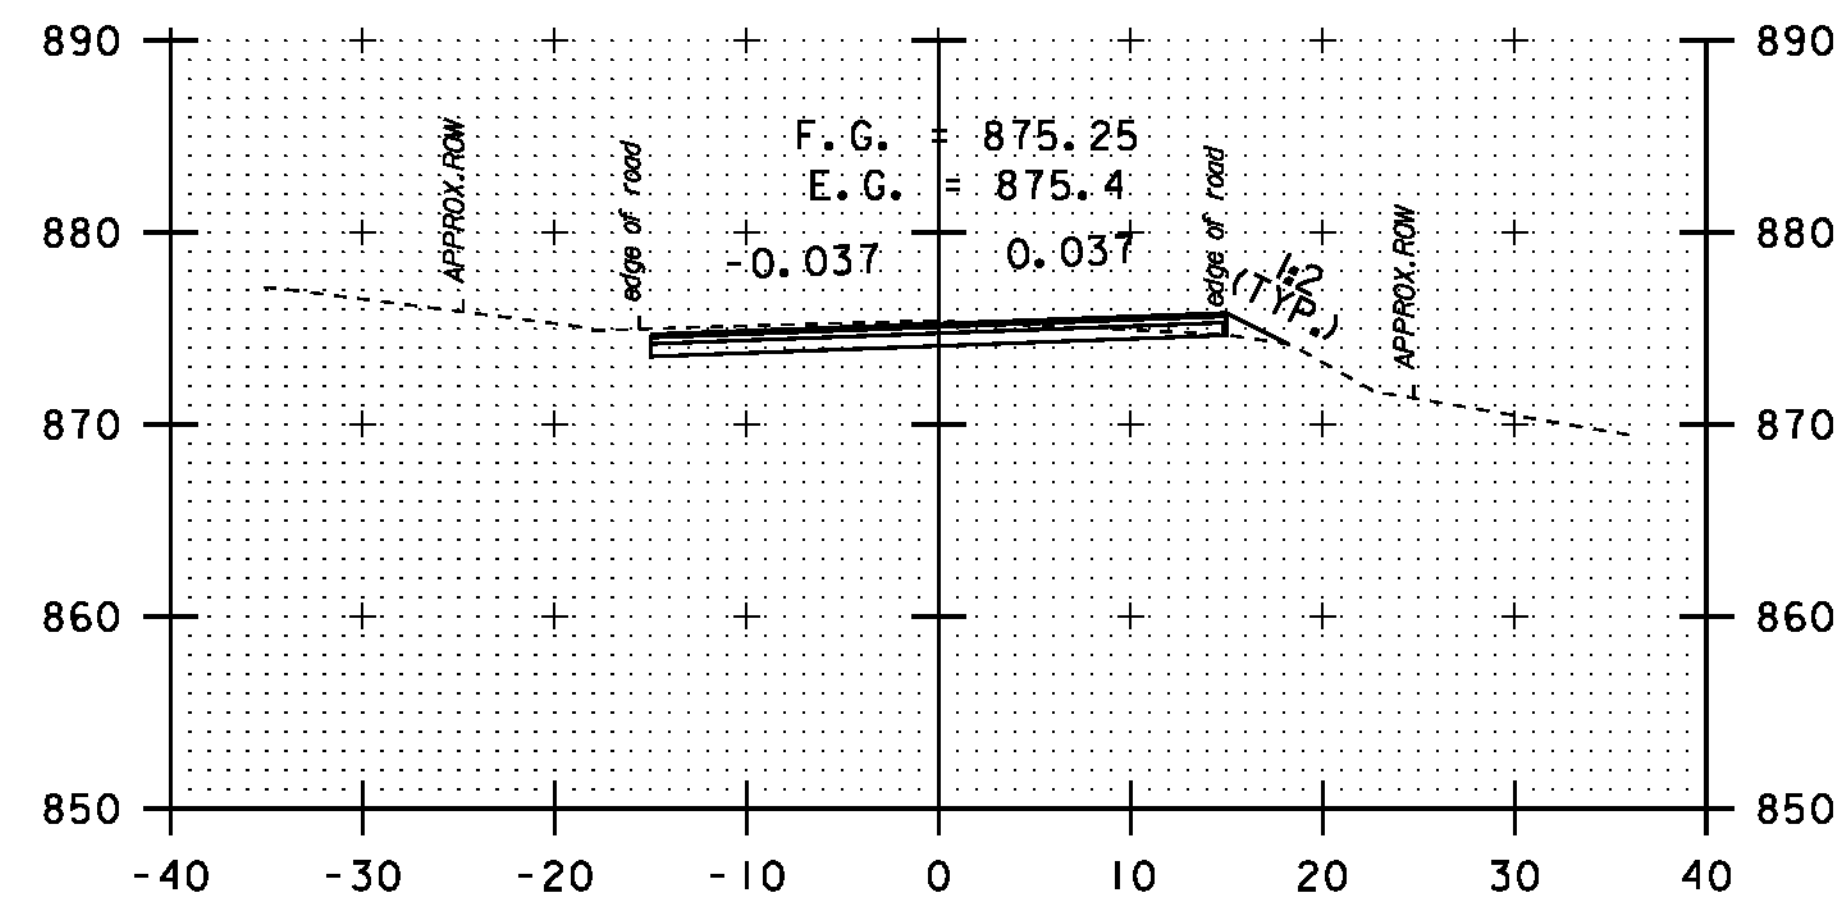


208+60

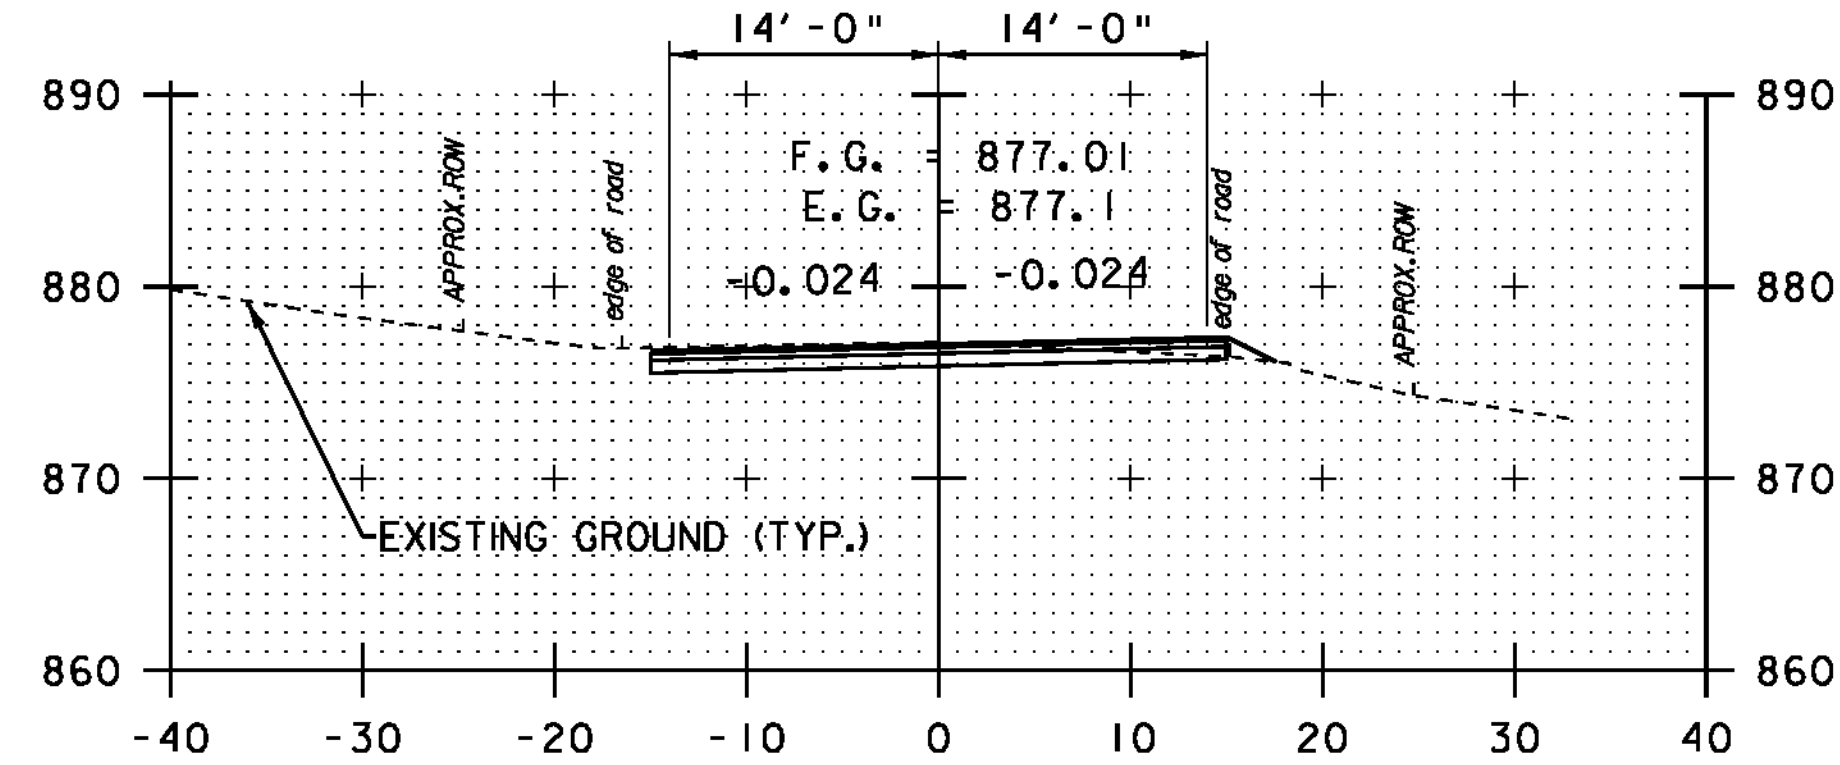


208+15

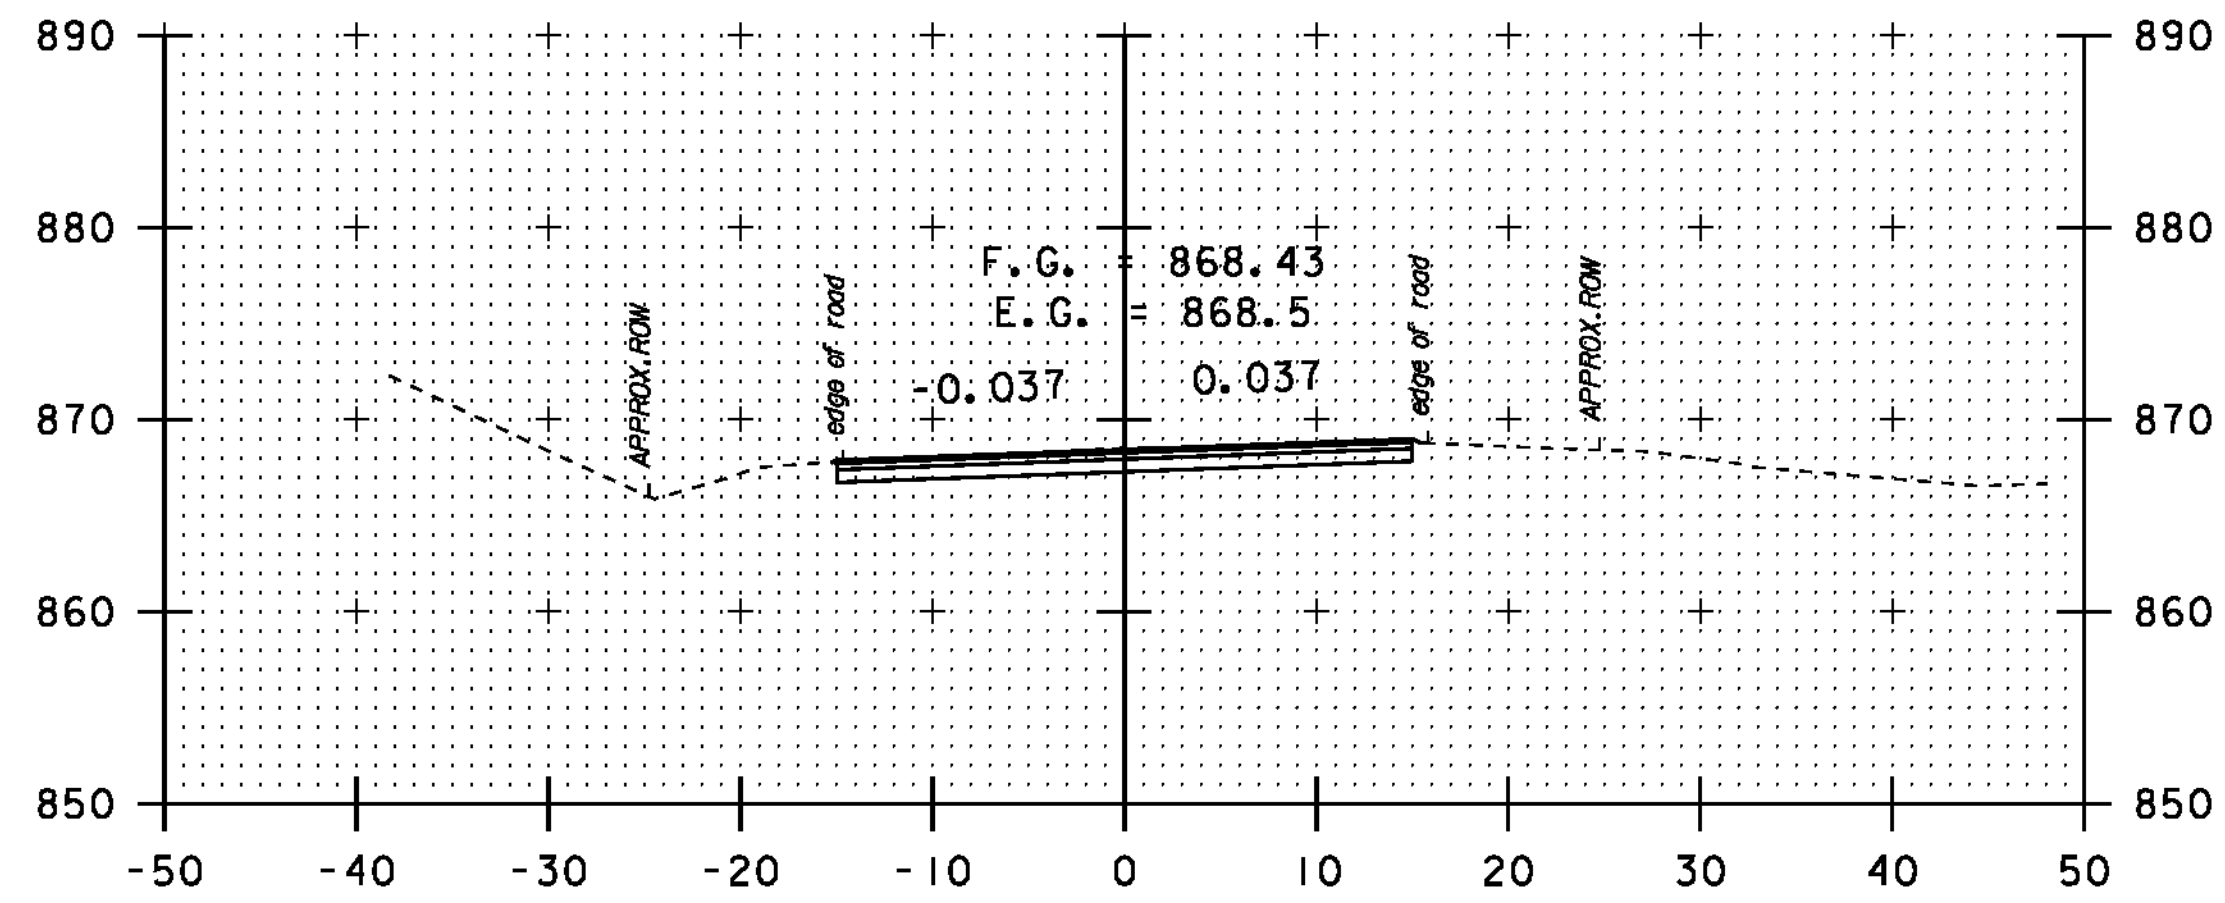

210+50

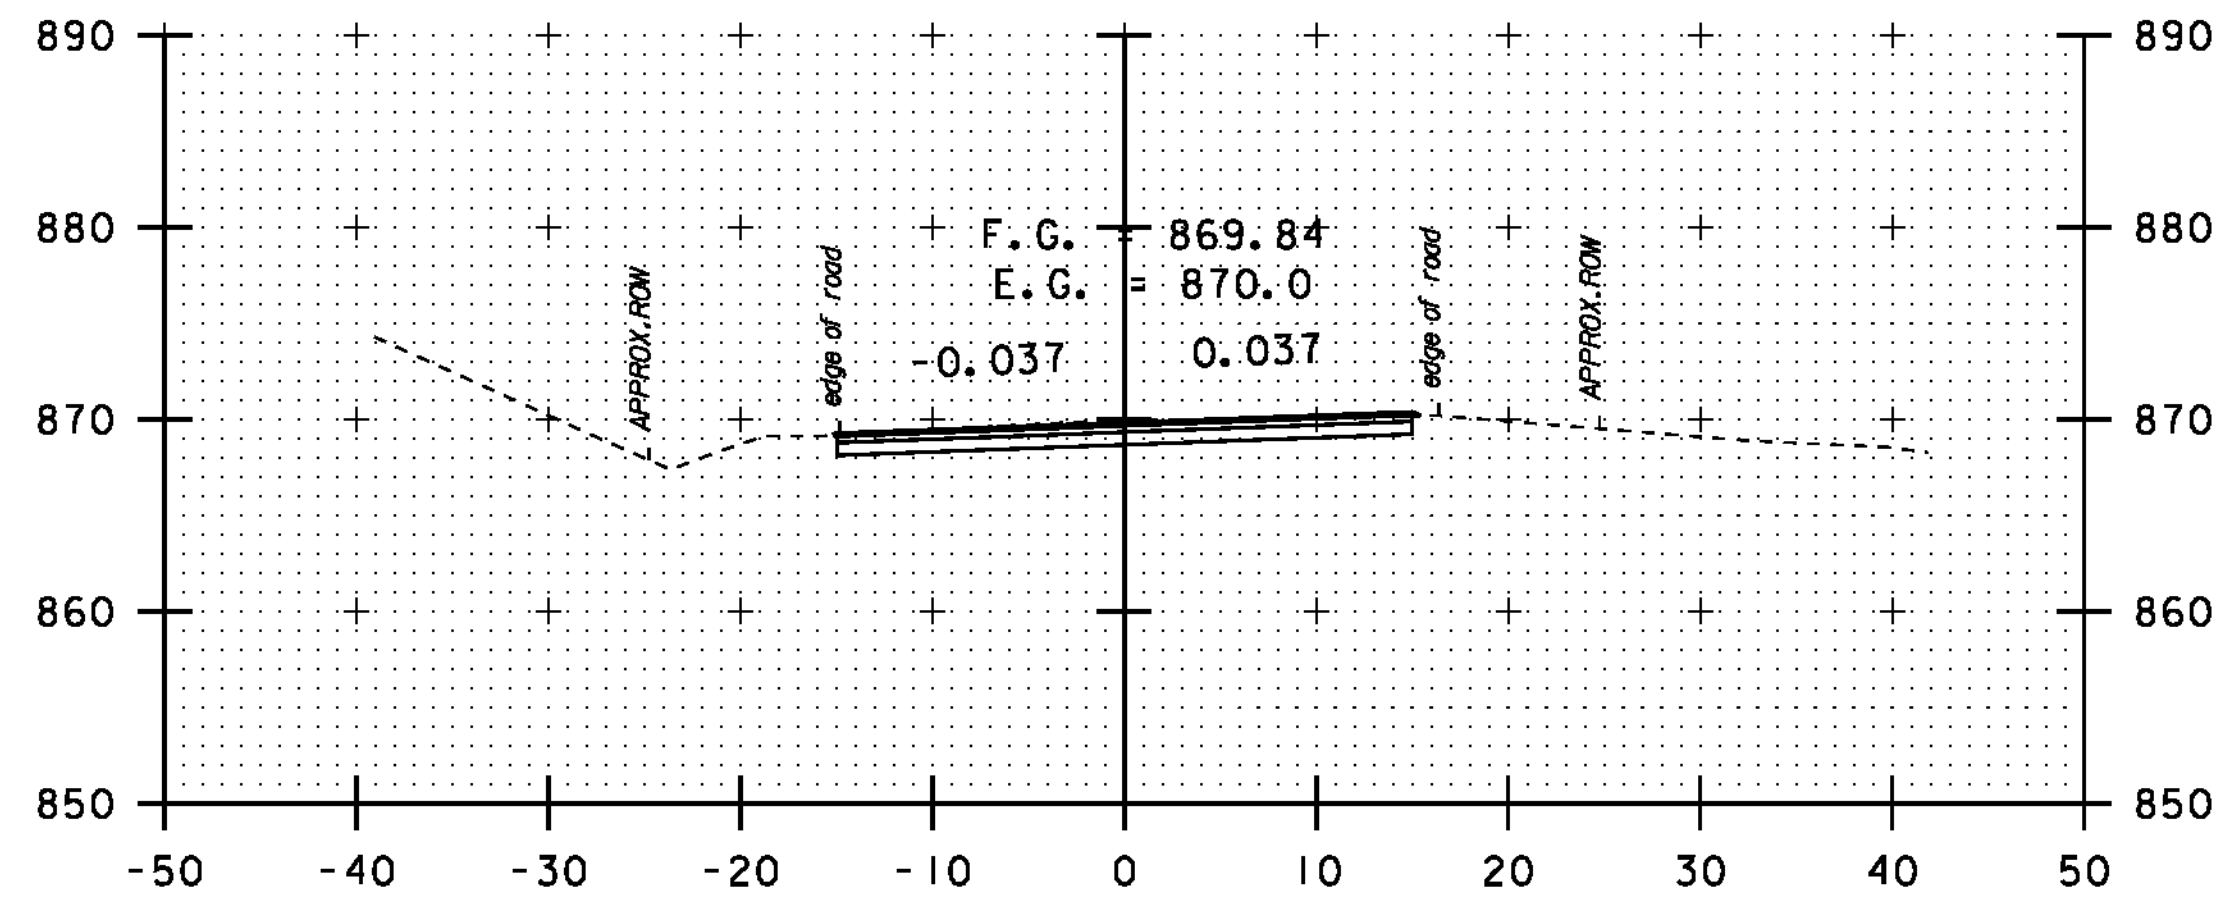

210+00

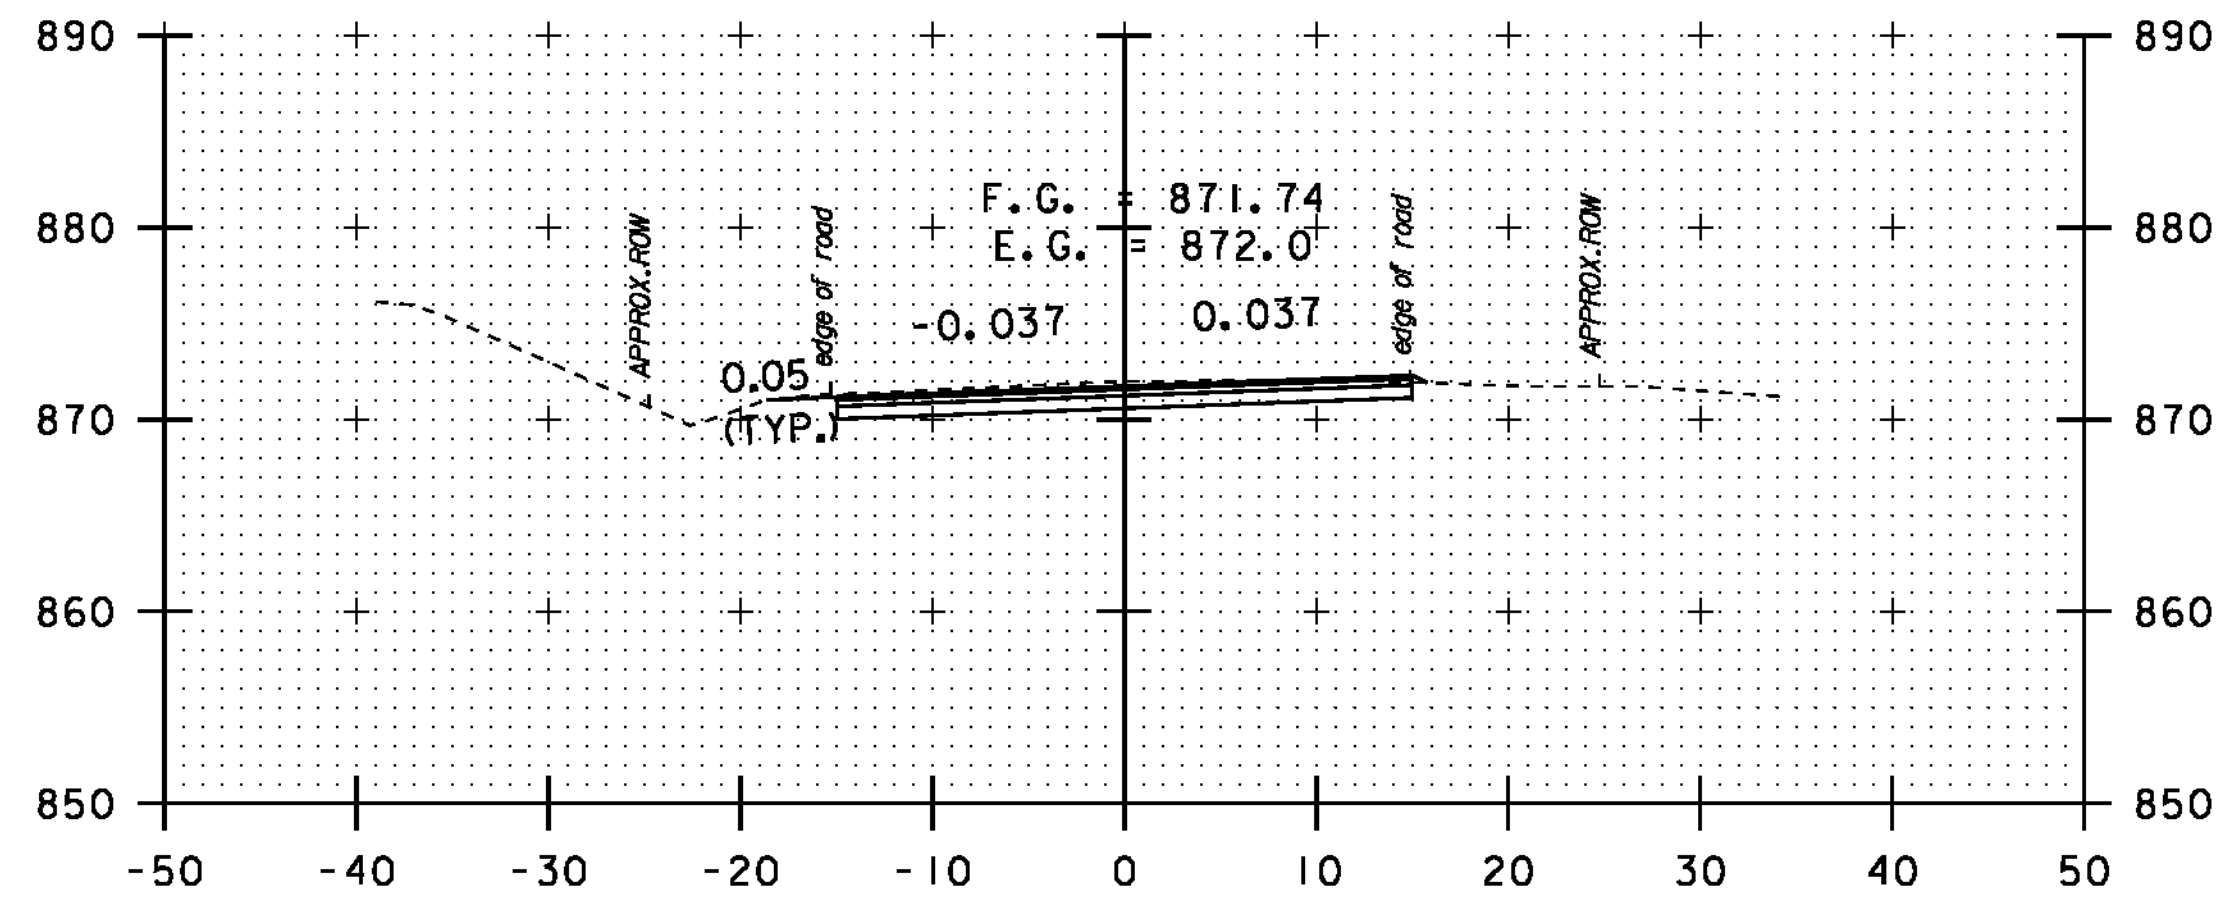

209+50

DATUM	NAVD 88
	NAD 83



**STA. 208+15**  
-  
**STA. 210+50**

**CROSS SECTION SHEET 7**

PROJECT NAME:	NEWPORT-COVENTRY-NEWPORT
PROJECT NUMBER:	STP 2802(I)
FILE NAME:	08b158.dgn
PROJECT LEADER:	CDL
DESIGNED BY:	BMB
PLOT FILE:	08b158-80.1
PLOT DATE:	8/3/2011
DRAWN BY:	BMB
CHECKED BY:	EPD
SHEET	80 OF 134