




212+00

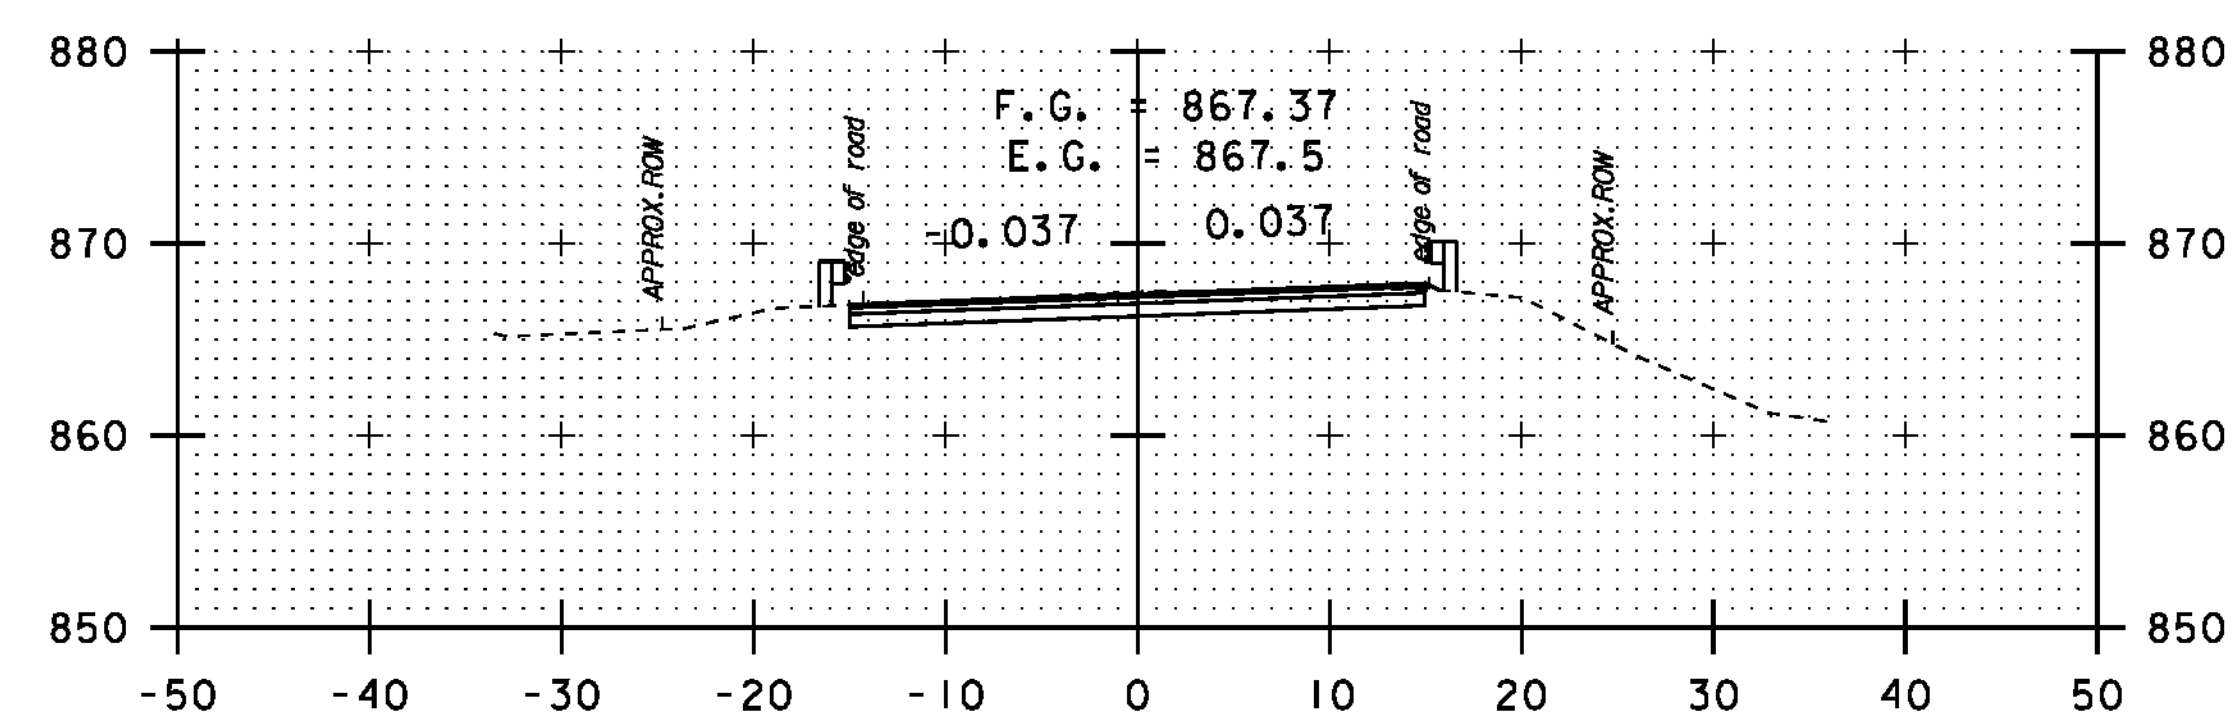


211+00

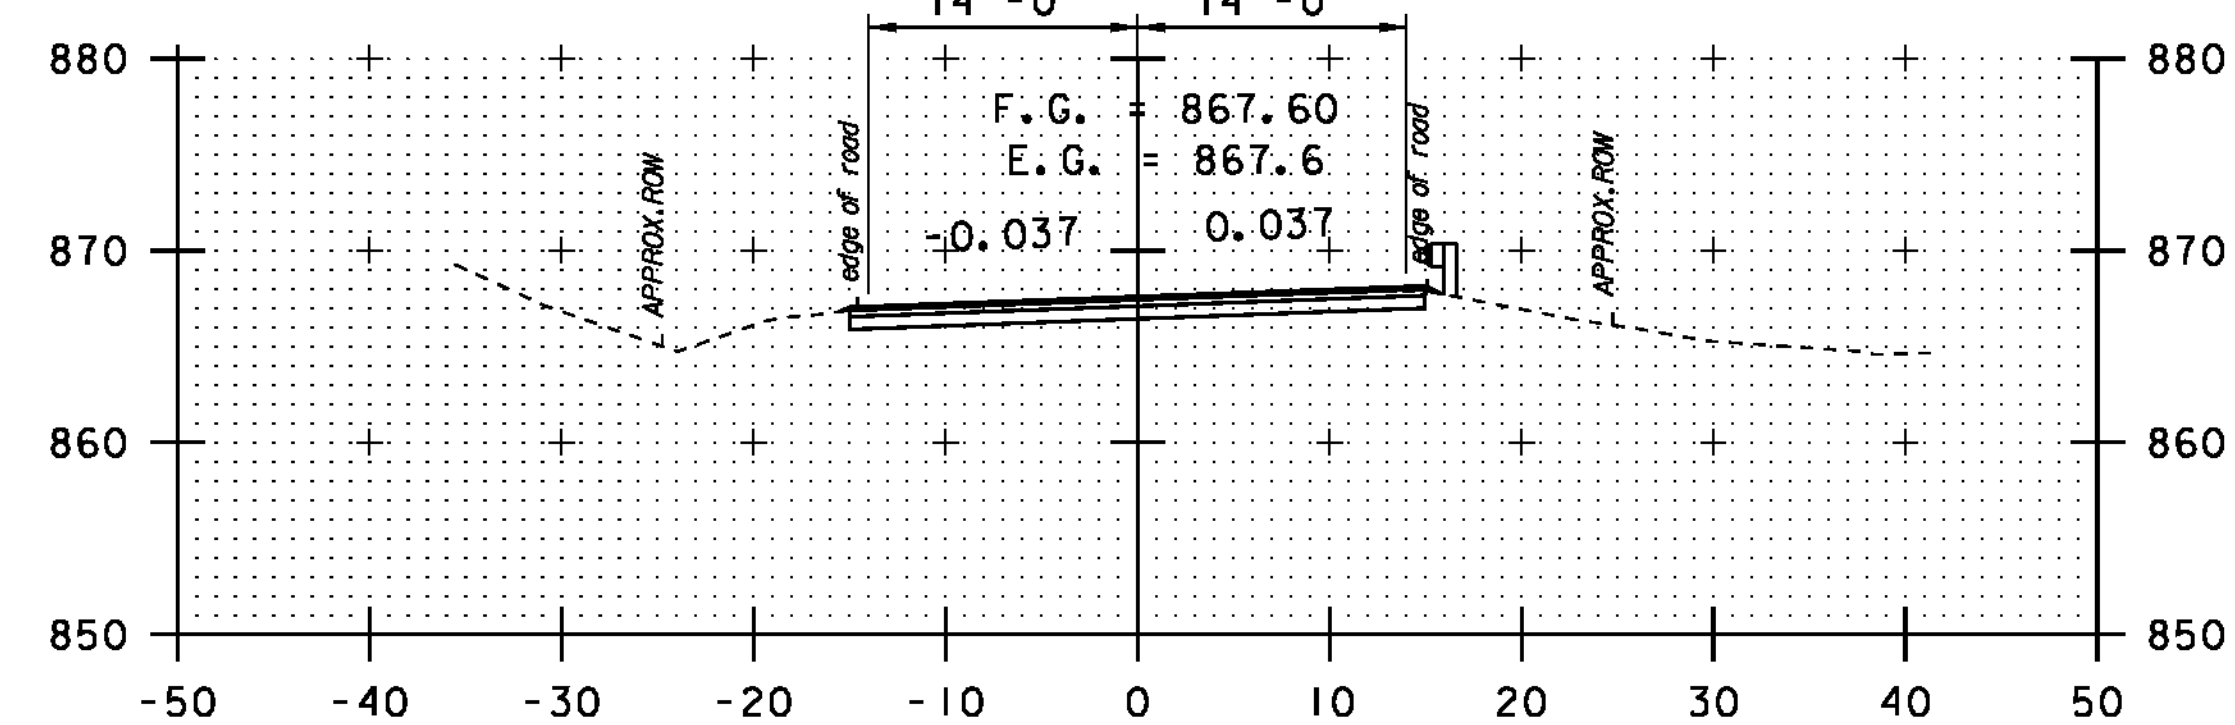


211+00

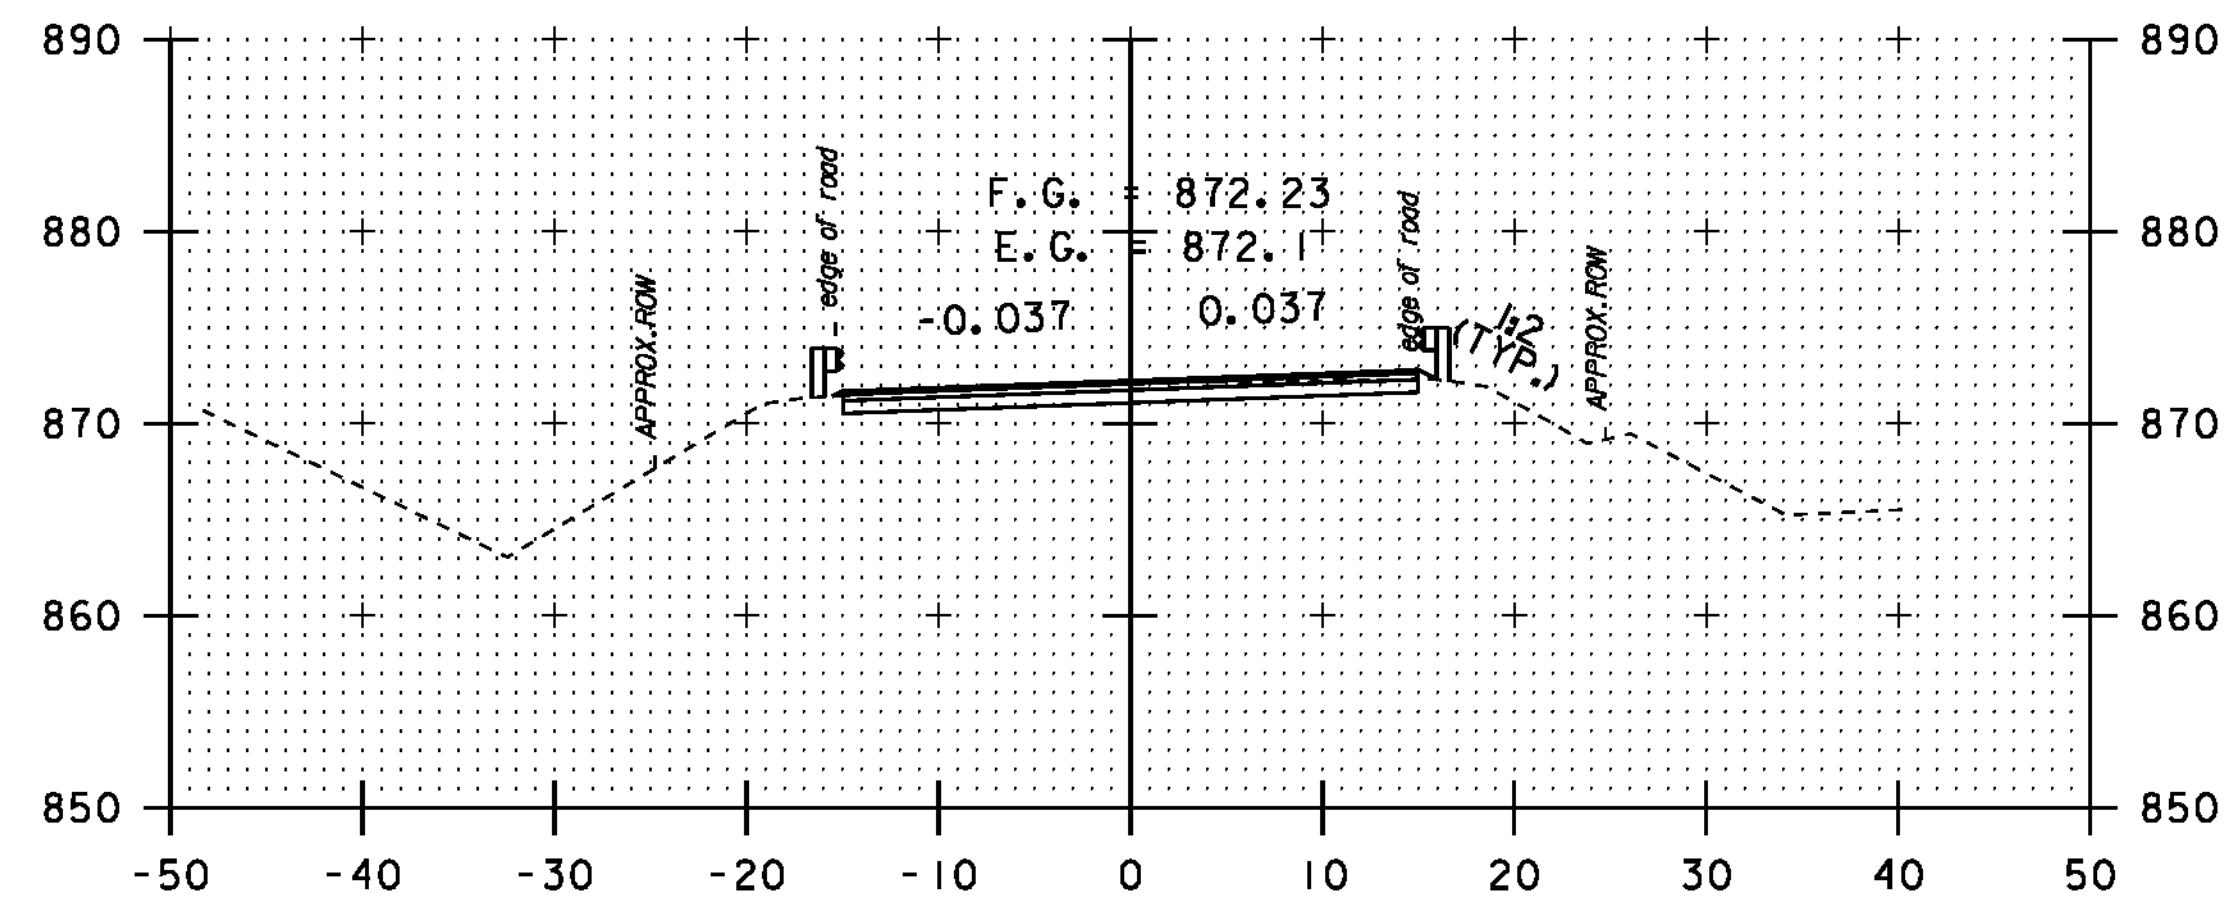

213+50

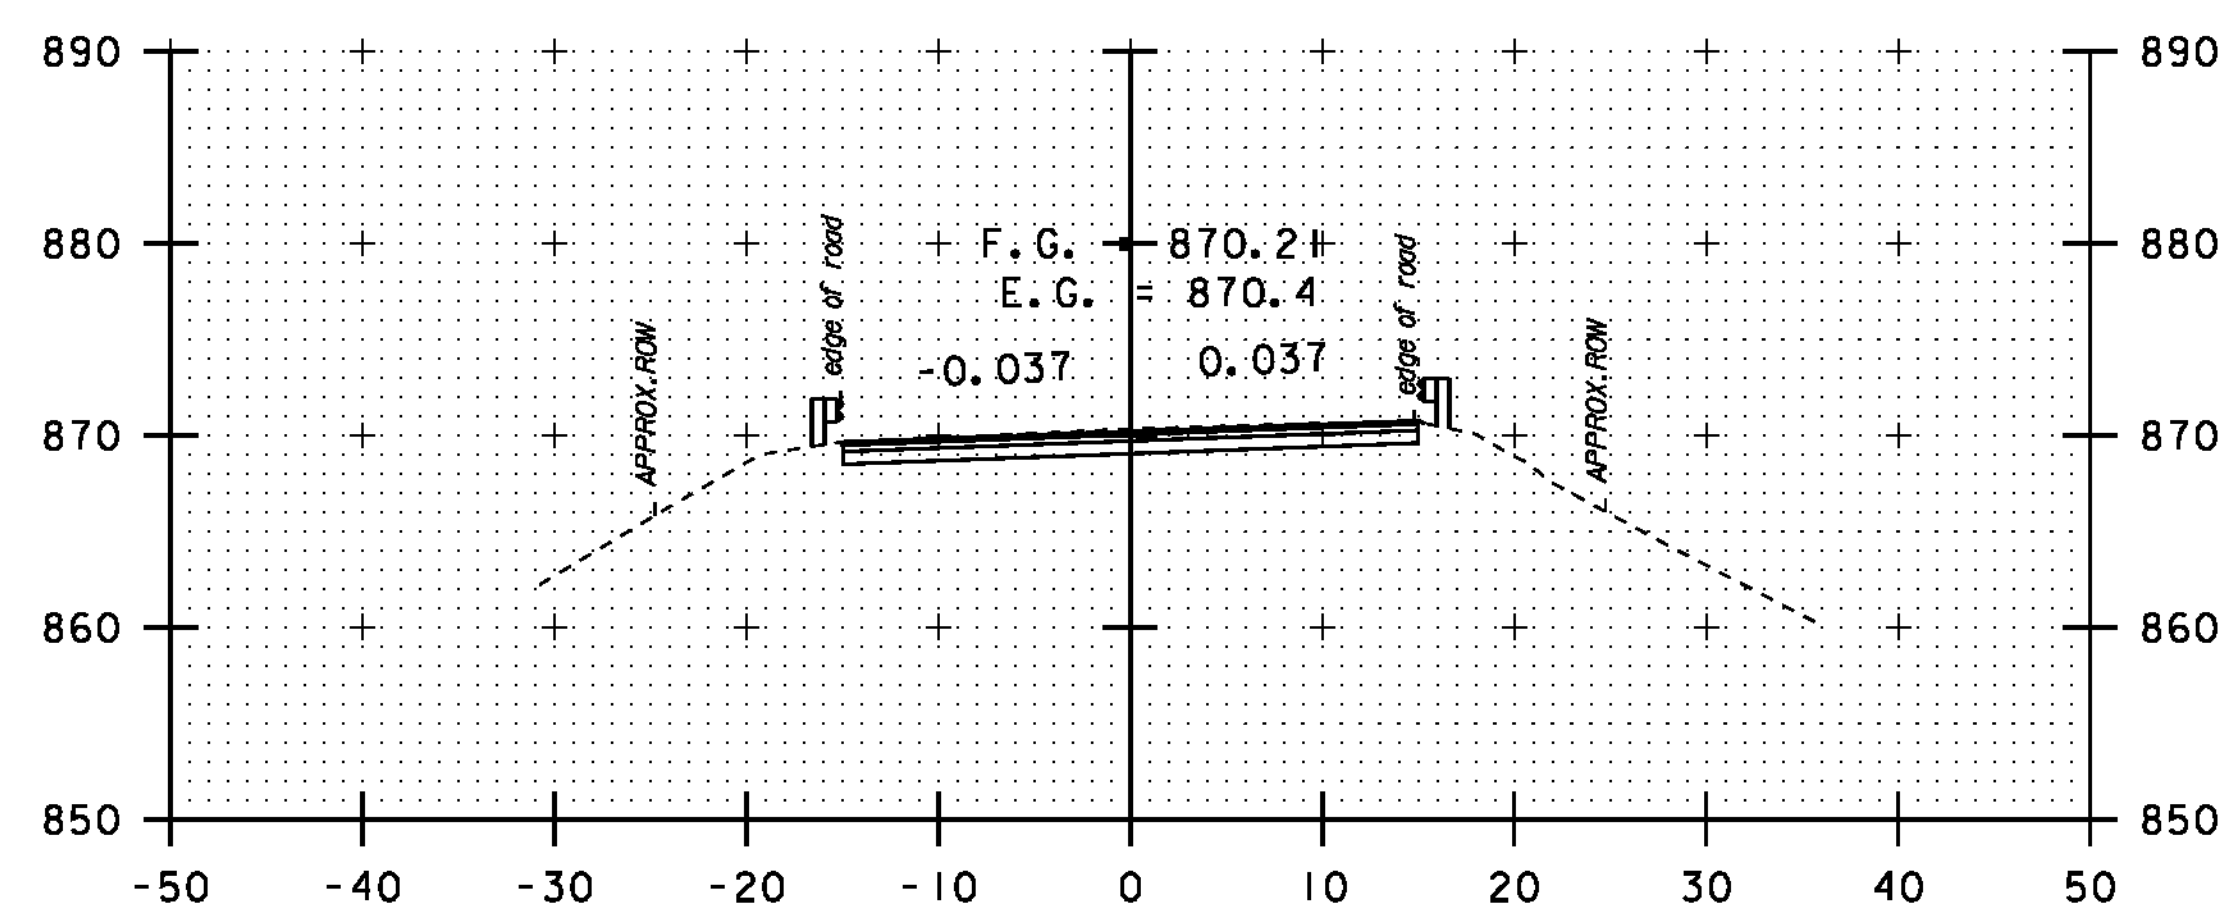

213+00

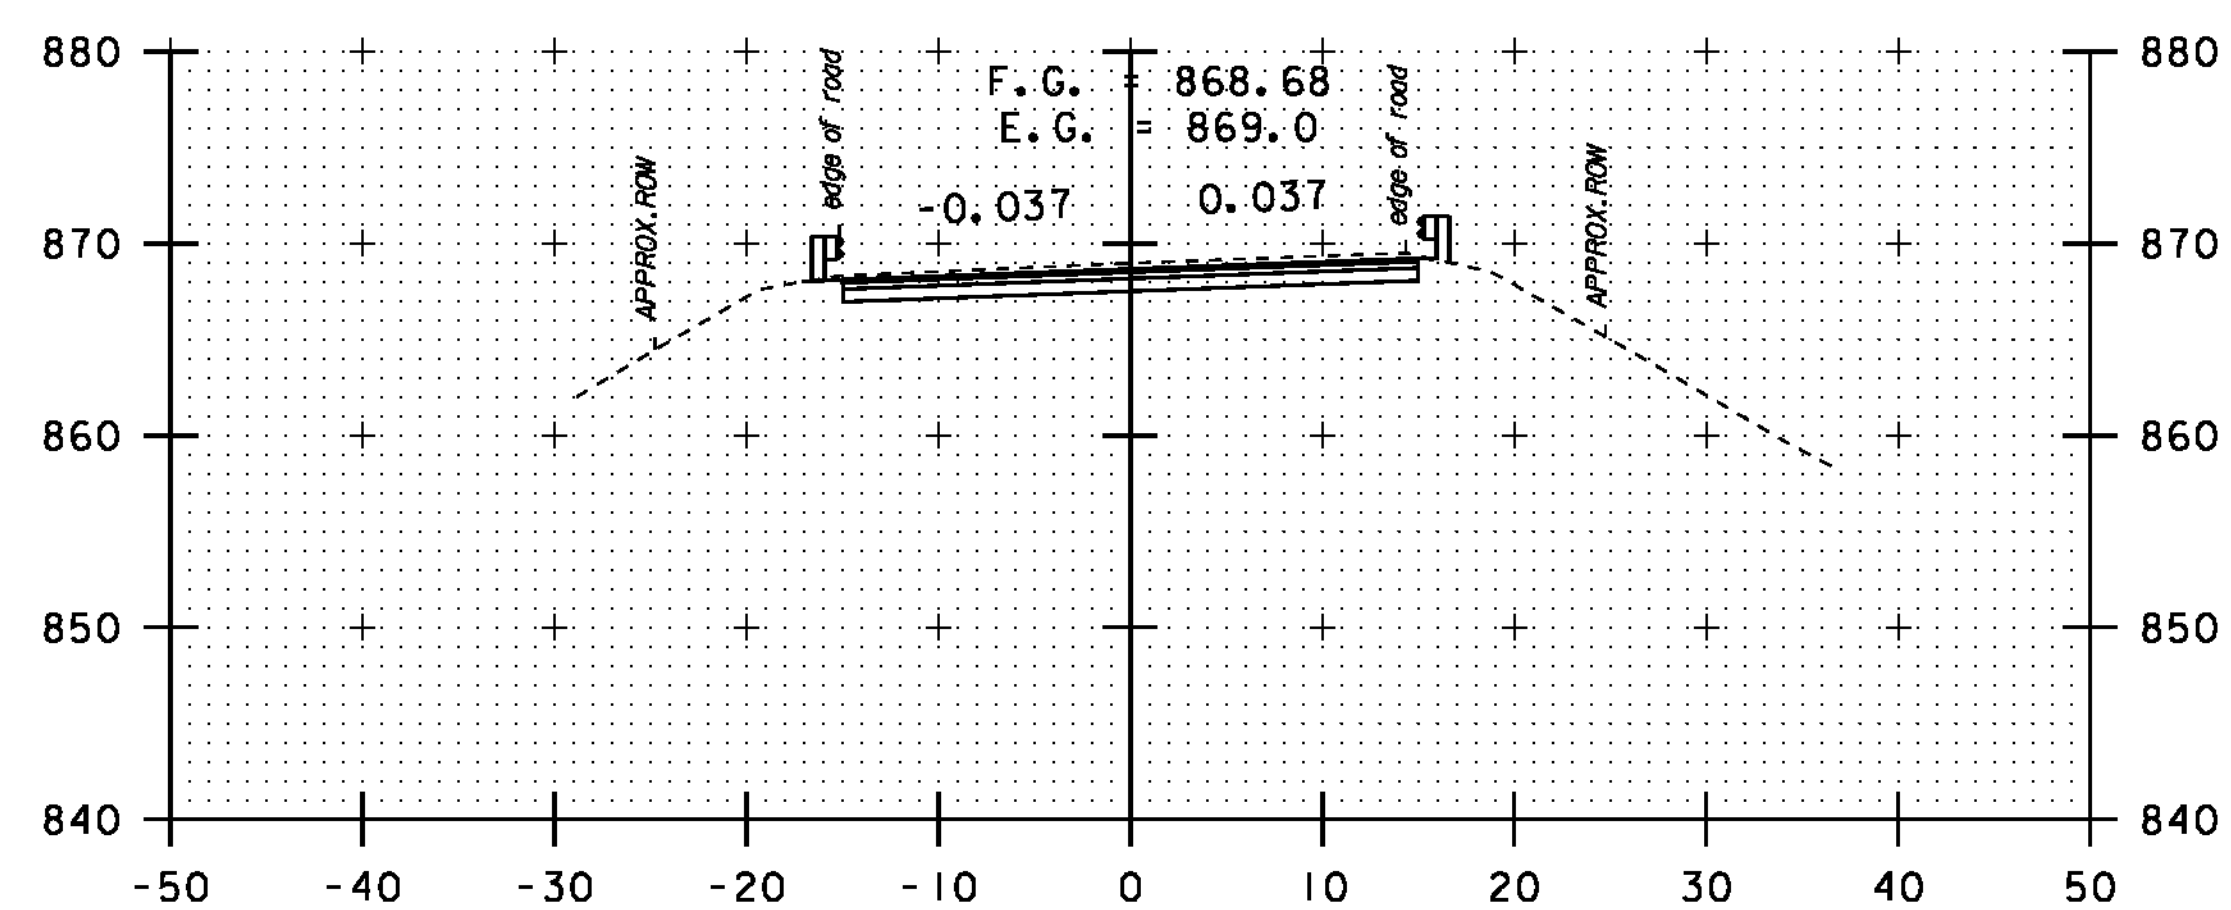

212+50

DATUM	NAVD 88
	NAD 83



STA. 211 + 00
-
STA. 213 + 50

CROSS SECTION SHEET 8

PROJECT NAME:	NEWPORT-COVENTRY-NEWPORT
PROJECT NUMBER:	STP 2802(I)
FILE NAME:	08b158.dgn
PROJECT LEADER:	CDL
DESIGNED BY:	BMB
PLOT FILE:	08b158-81.1
PLOT DATE:	8/3/2011
DRAWN BY:	BMB
CHECKED BY:	EPD
SHEET	81 OF 134