




220+25

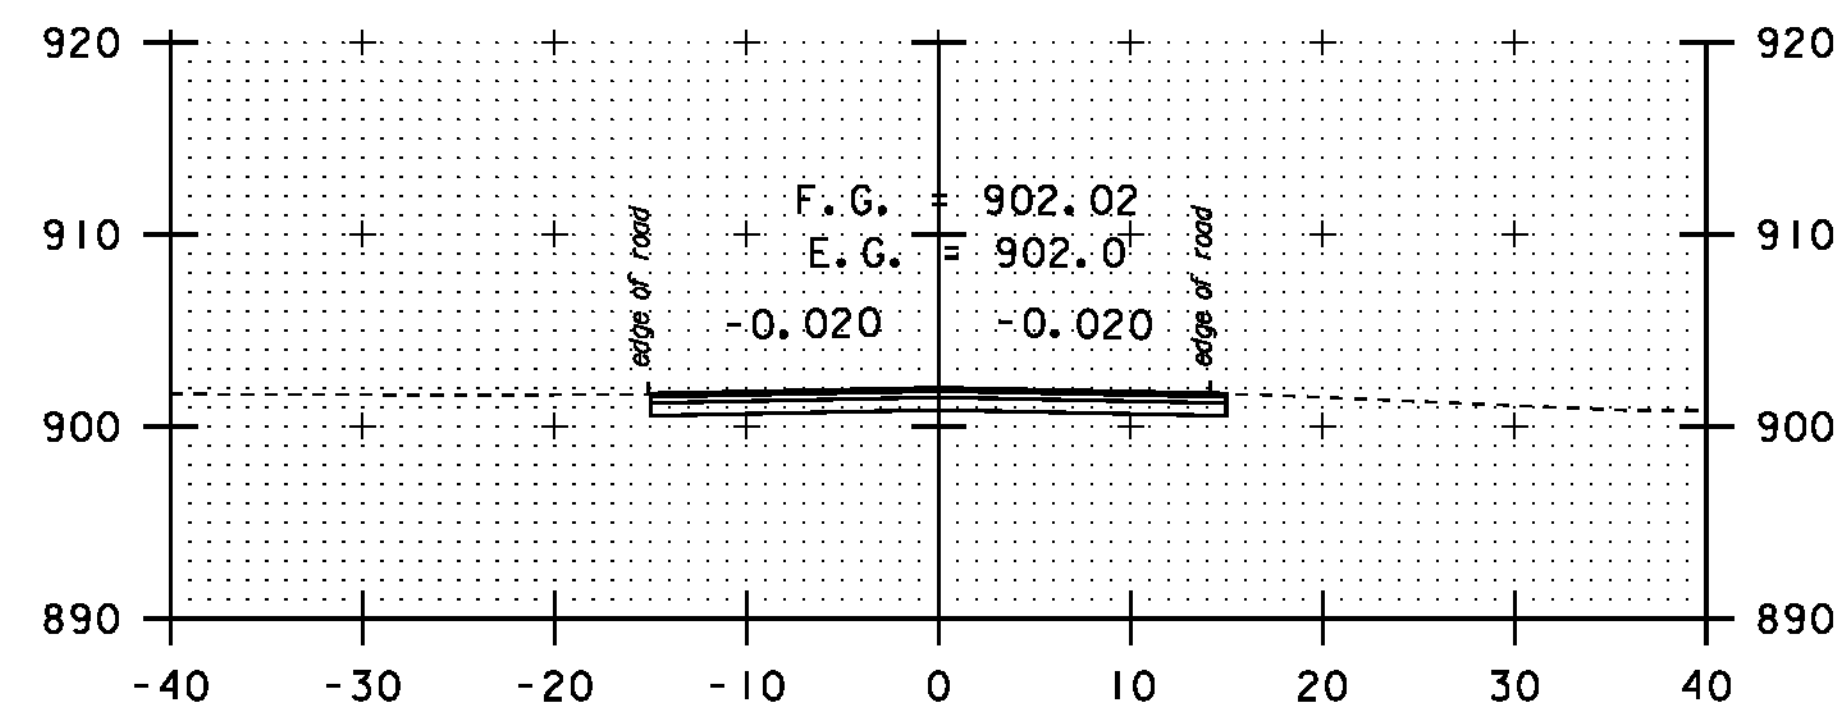


220+00

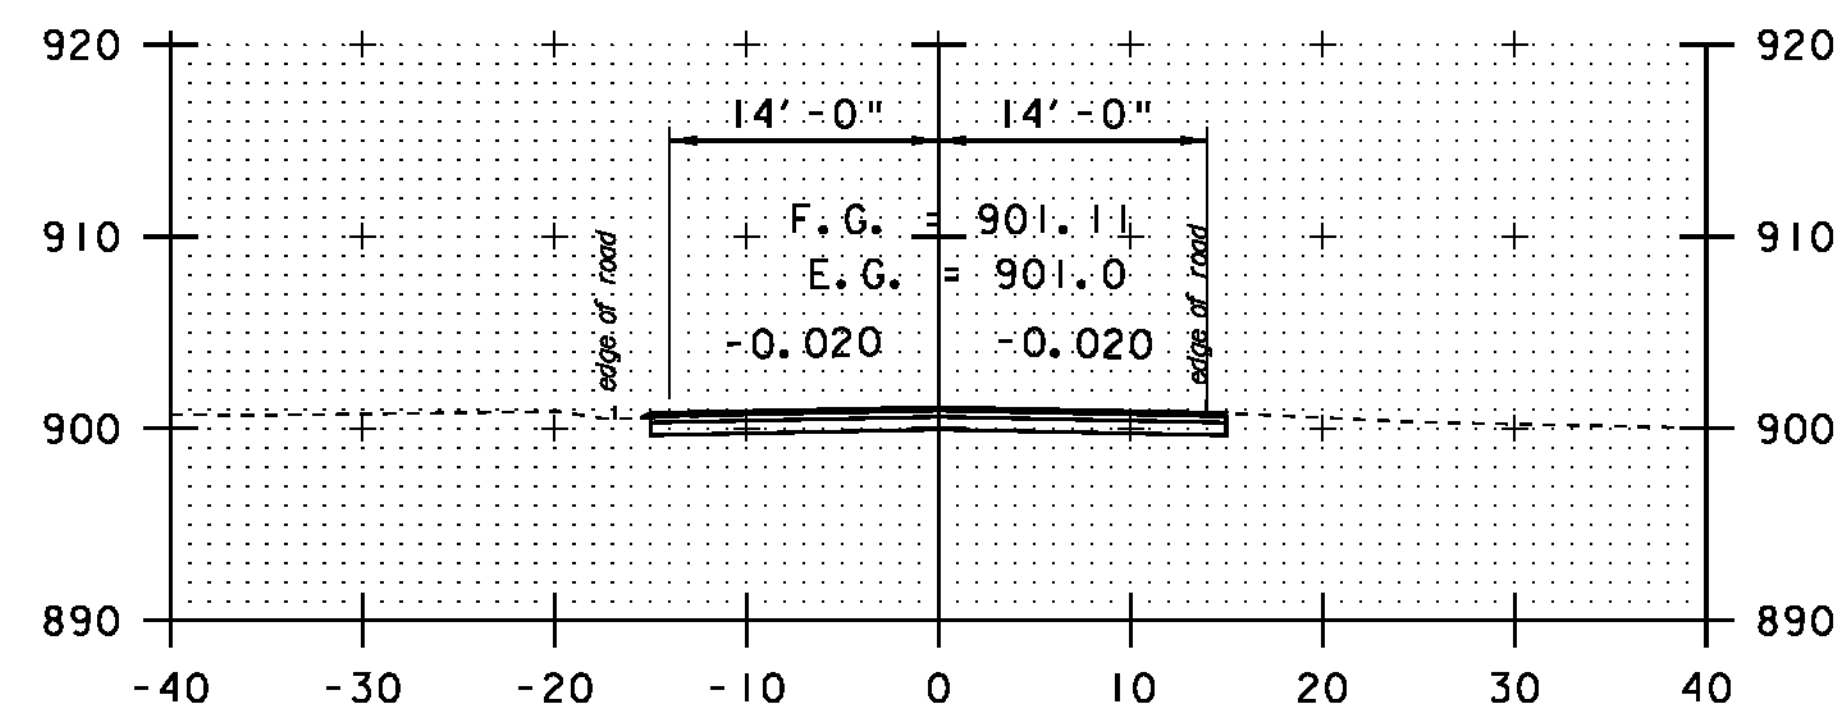


219+50

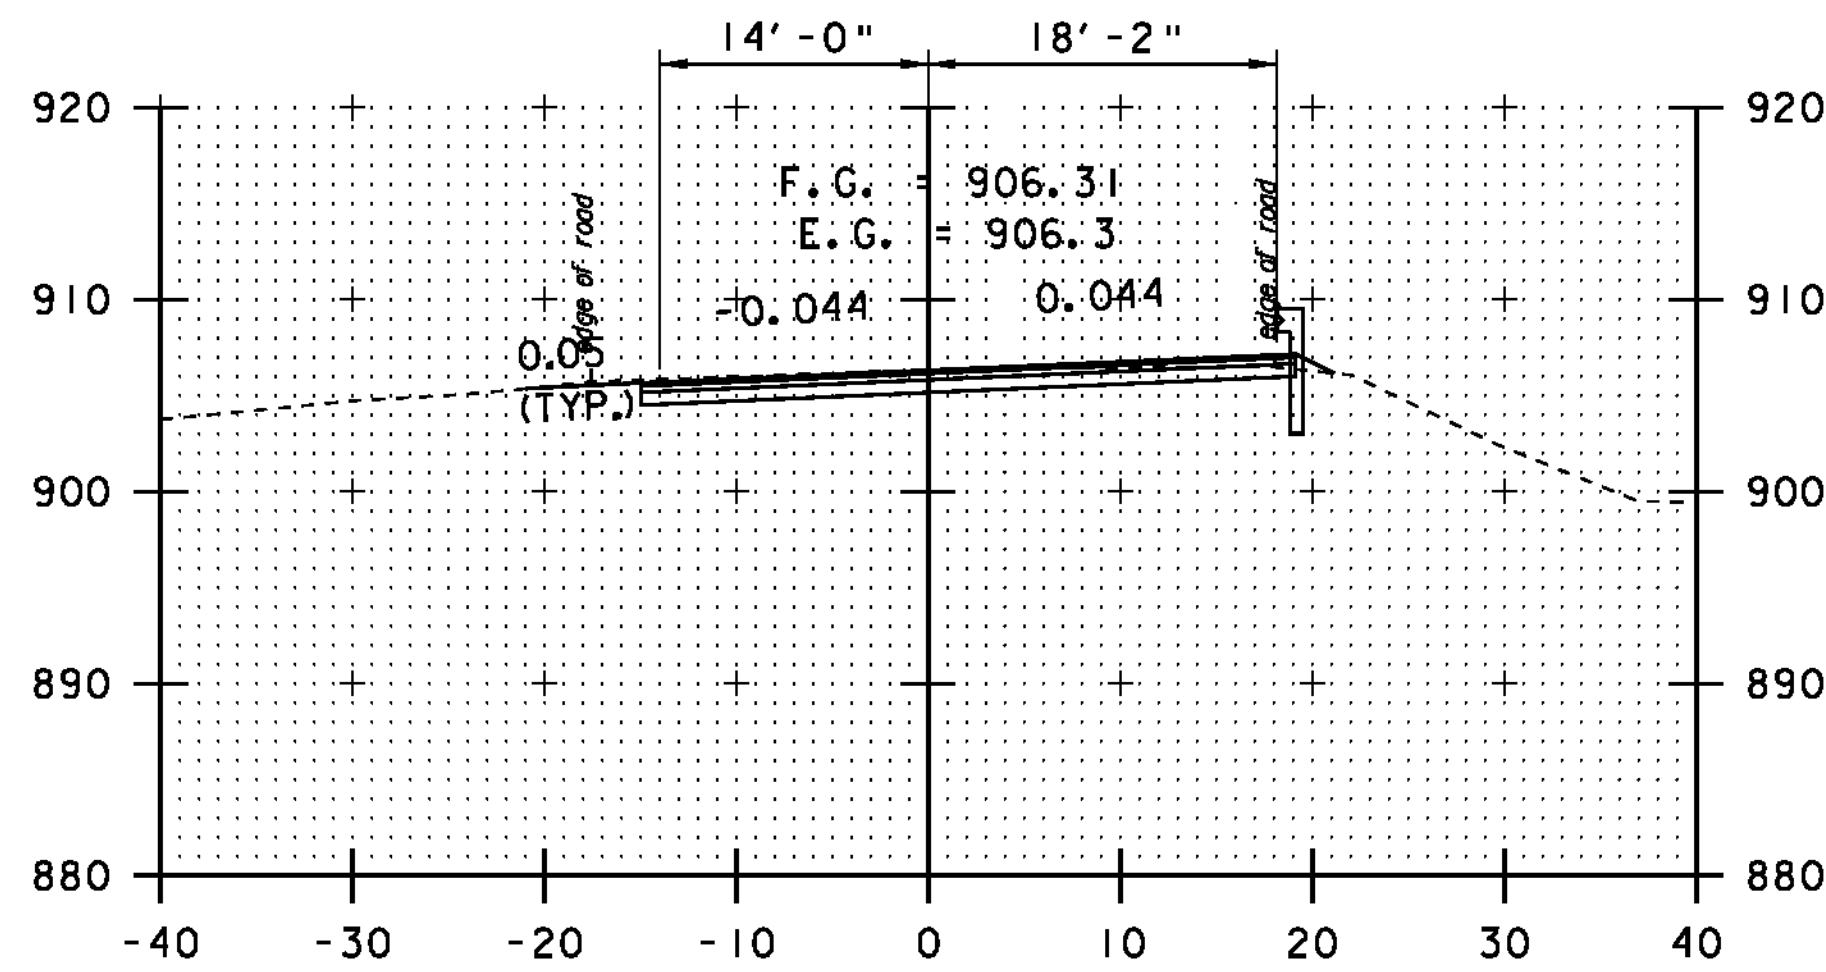


222+50

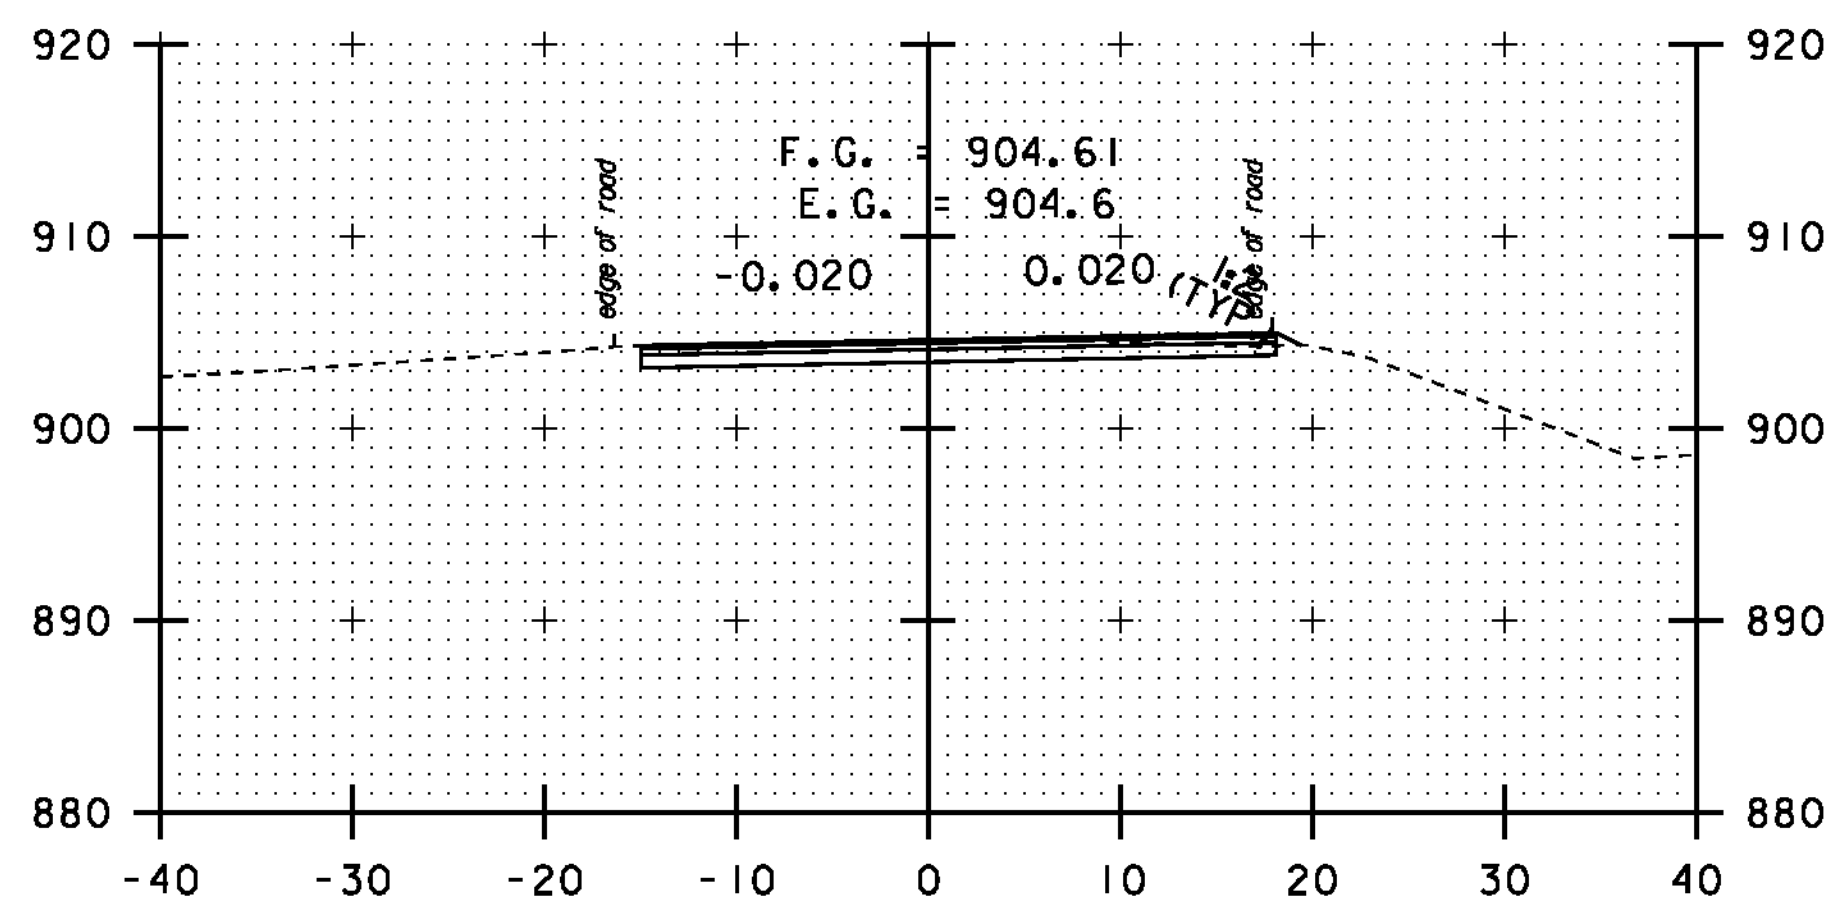


221+82

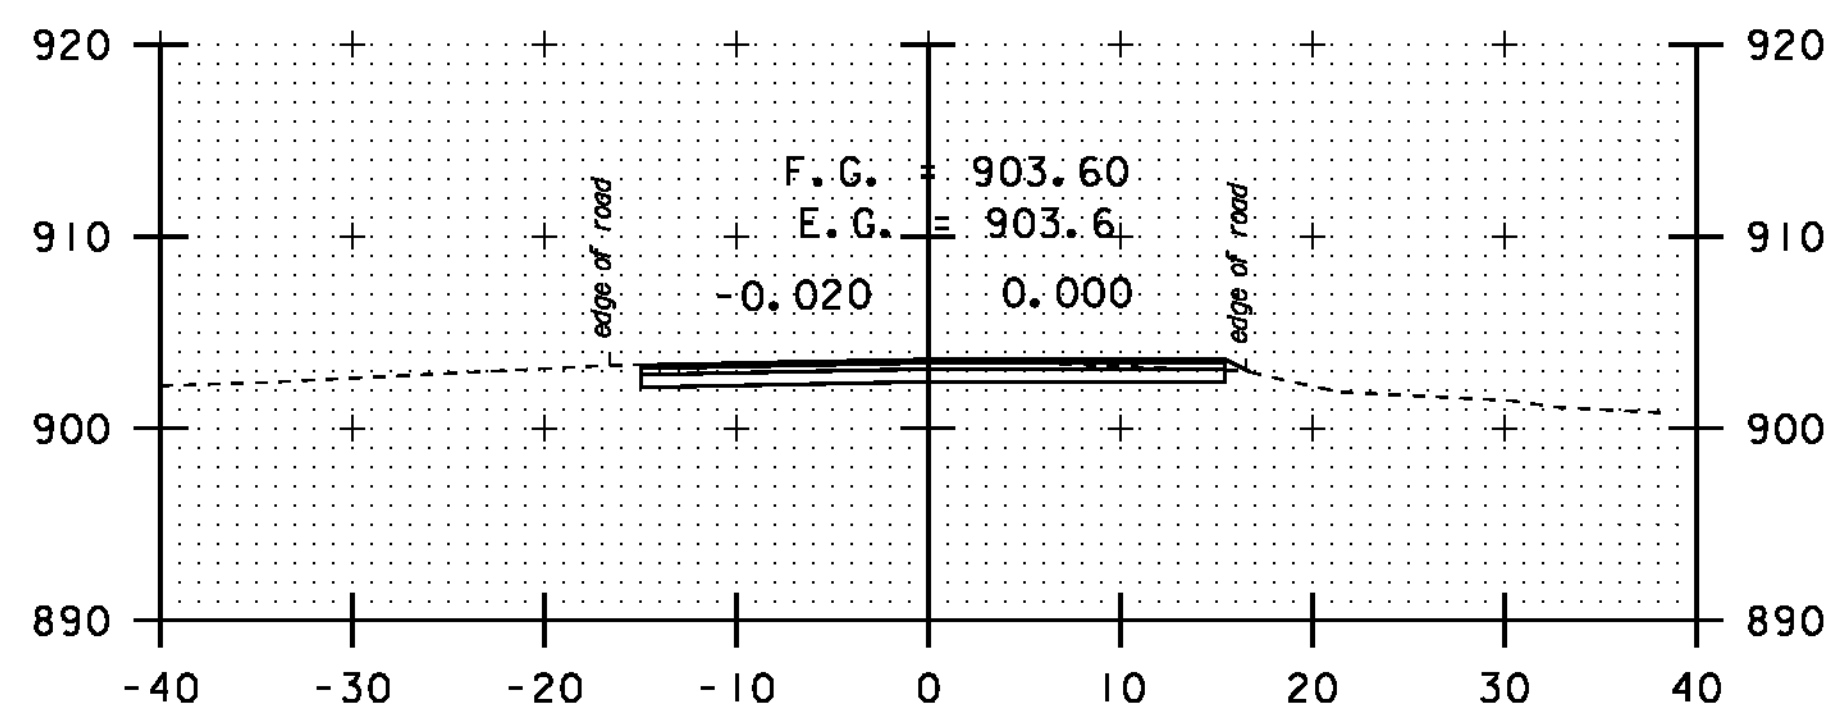


221+25

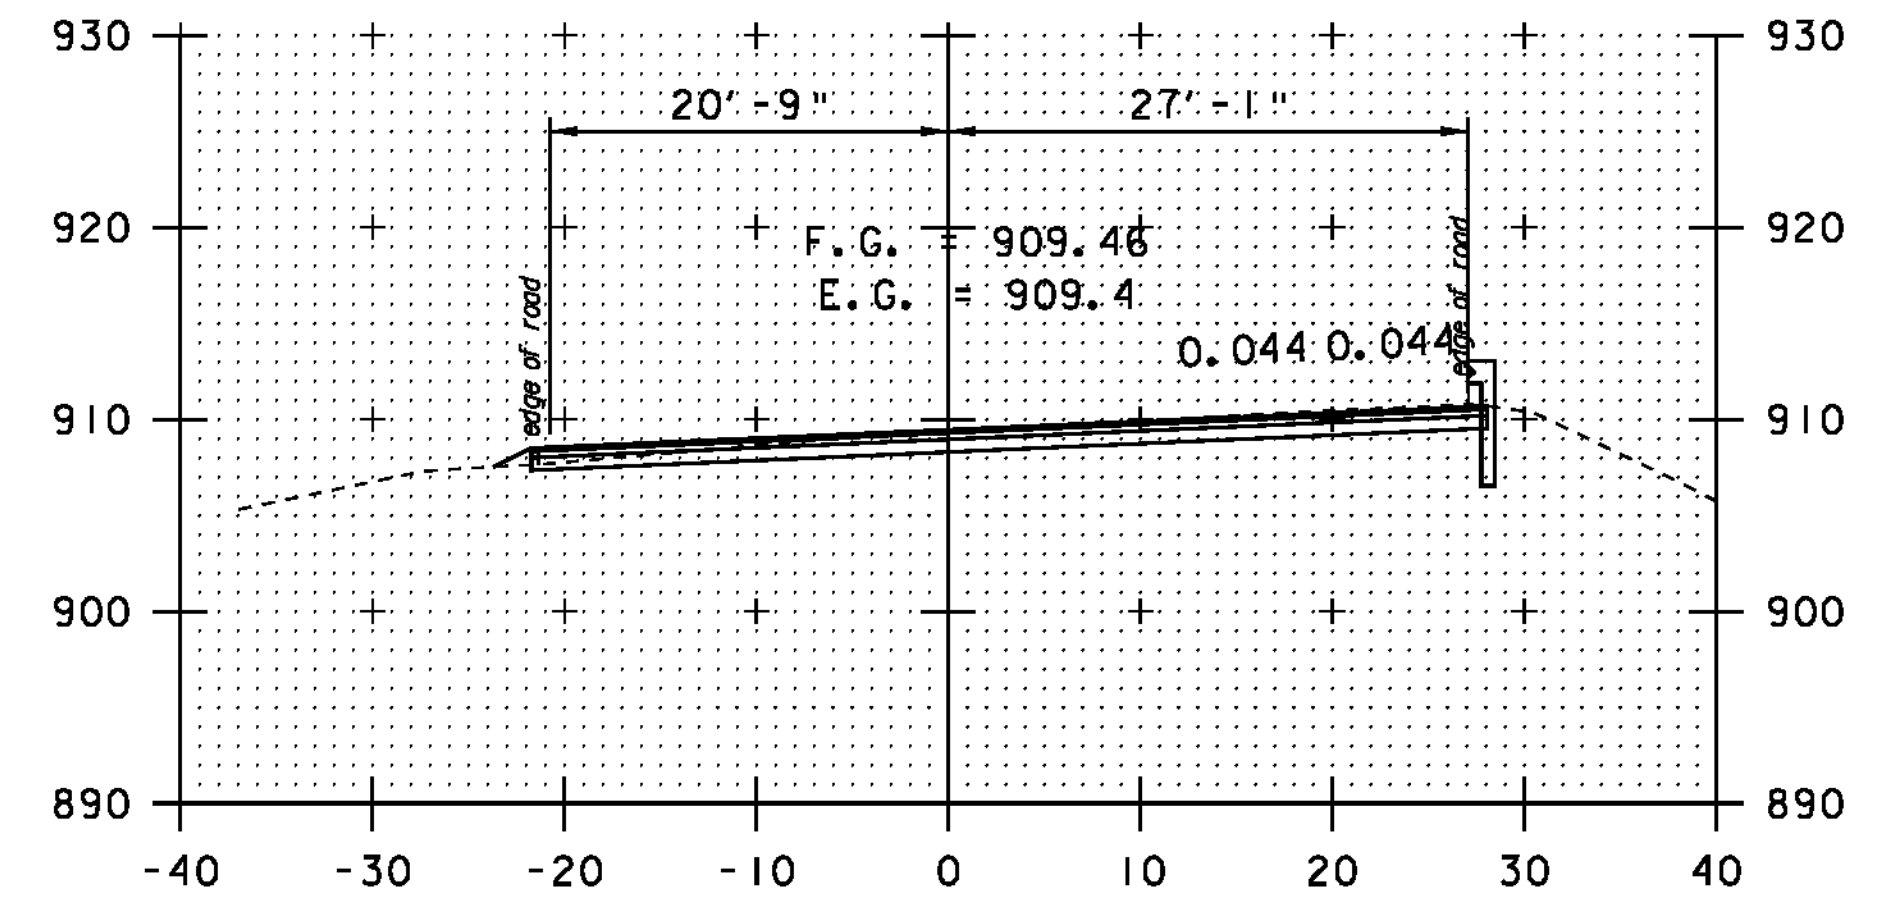

223+75

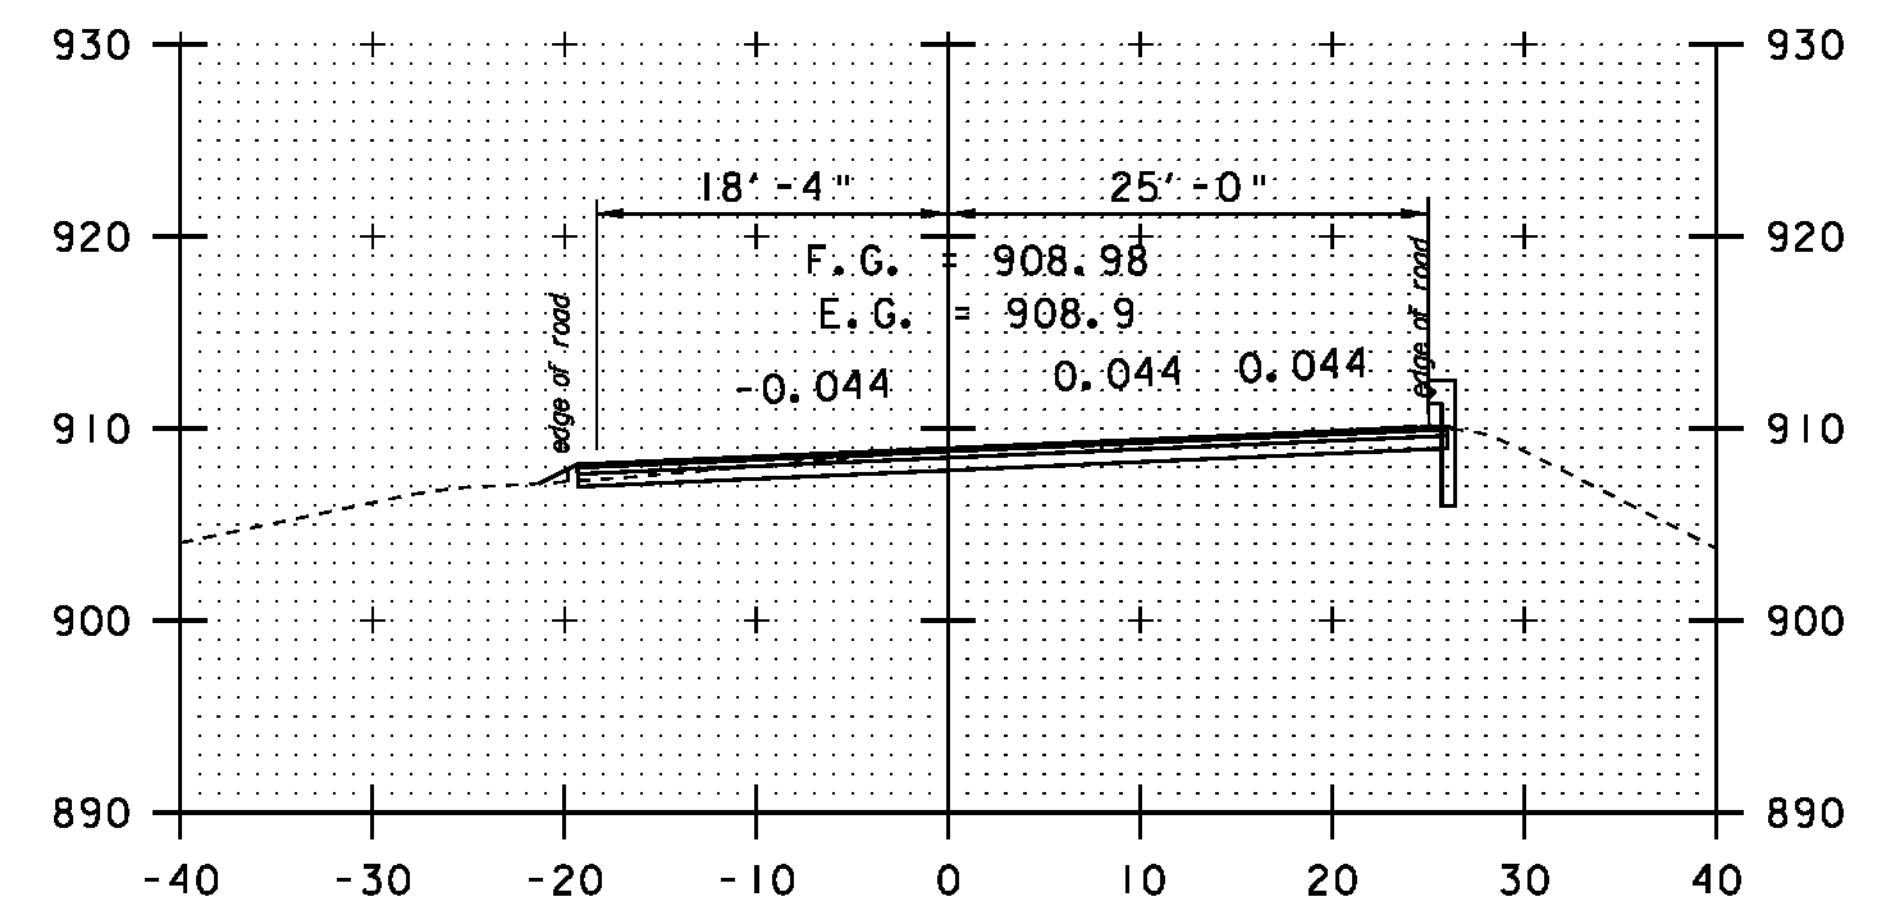


223+50

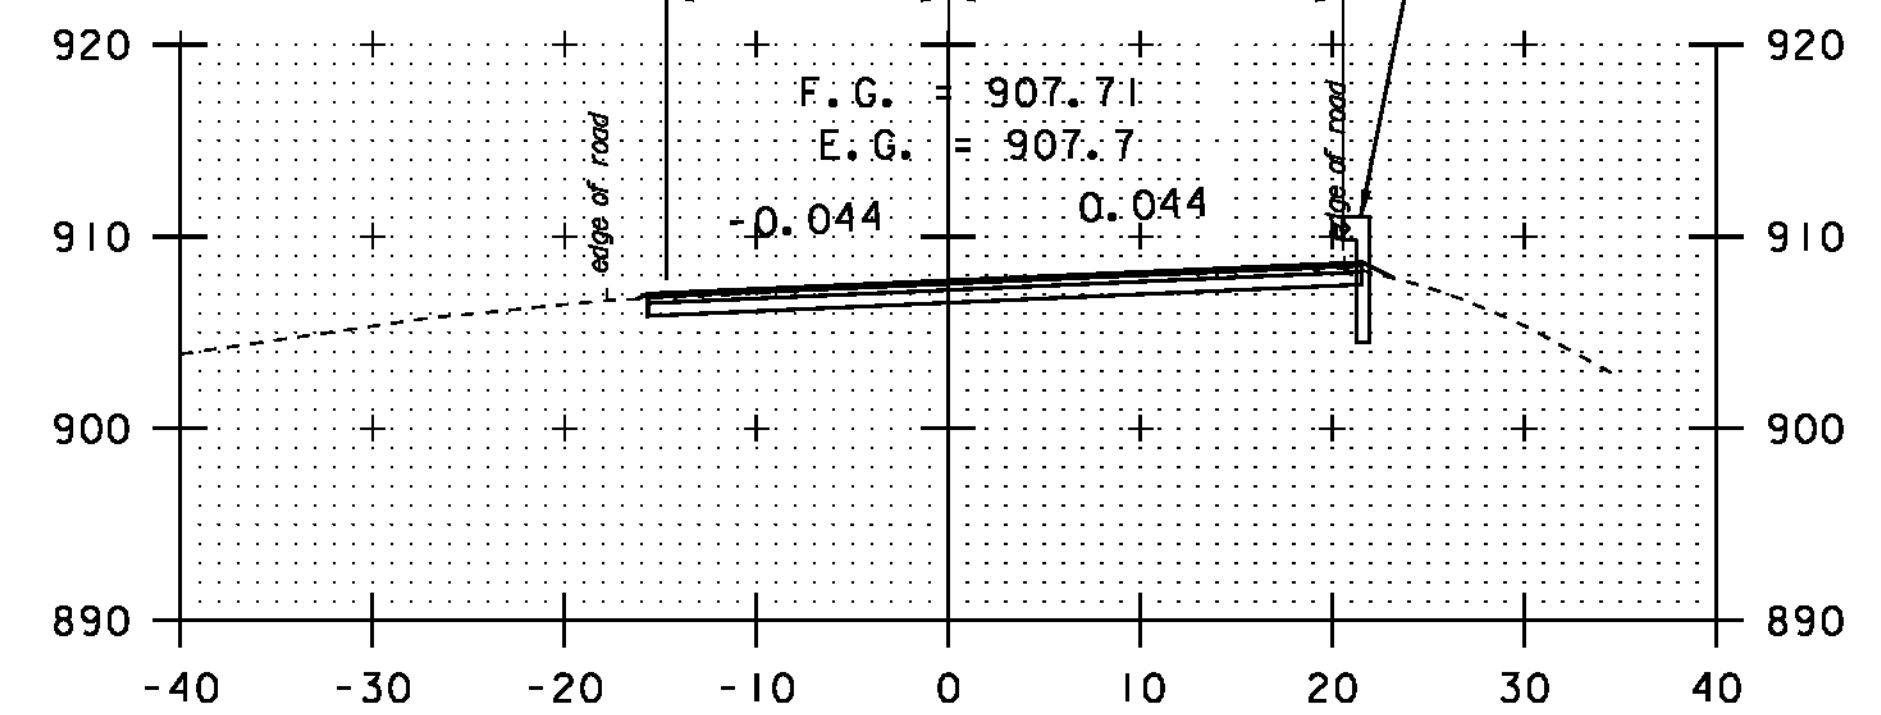

223+00

DATUM	NAVD 88
	NAD 83

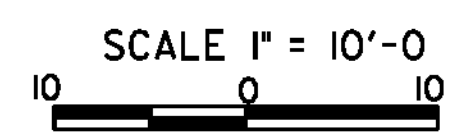

STA. 219 + 50
-
STA. 223 + 75

CROSS SECTION SHEET 10

PROJECT NAME:	NEWPORT-COVENTRY-NEWPORT
PROJECT NUMBER:	STP 2802(I)
FILE NAME:	08b158.dgn
PROJECT LEADER:	CDL
DESIGNED BY:	BMB
PLOT FILE:	08b158-83.1
PLOT DATE:	8/3/2011
DRAWN BY:	BMB
CHECKED BY:	EPD
SHEET	83 OF 134