




1223+50

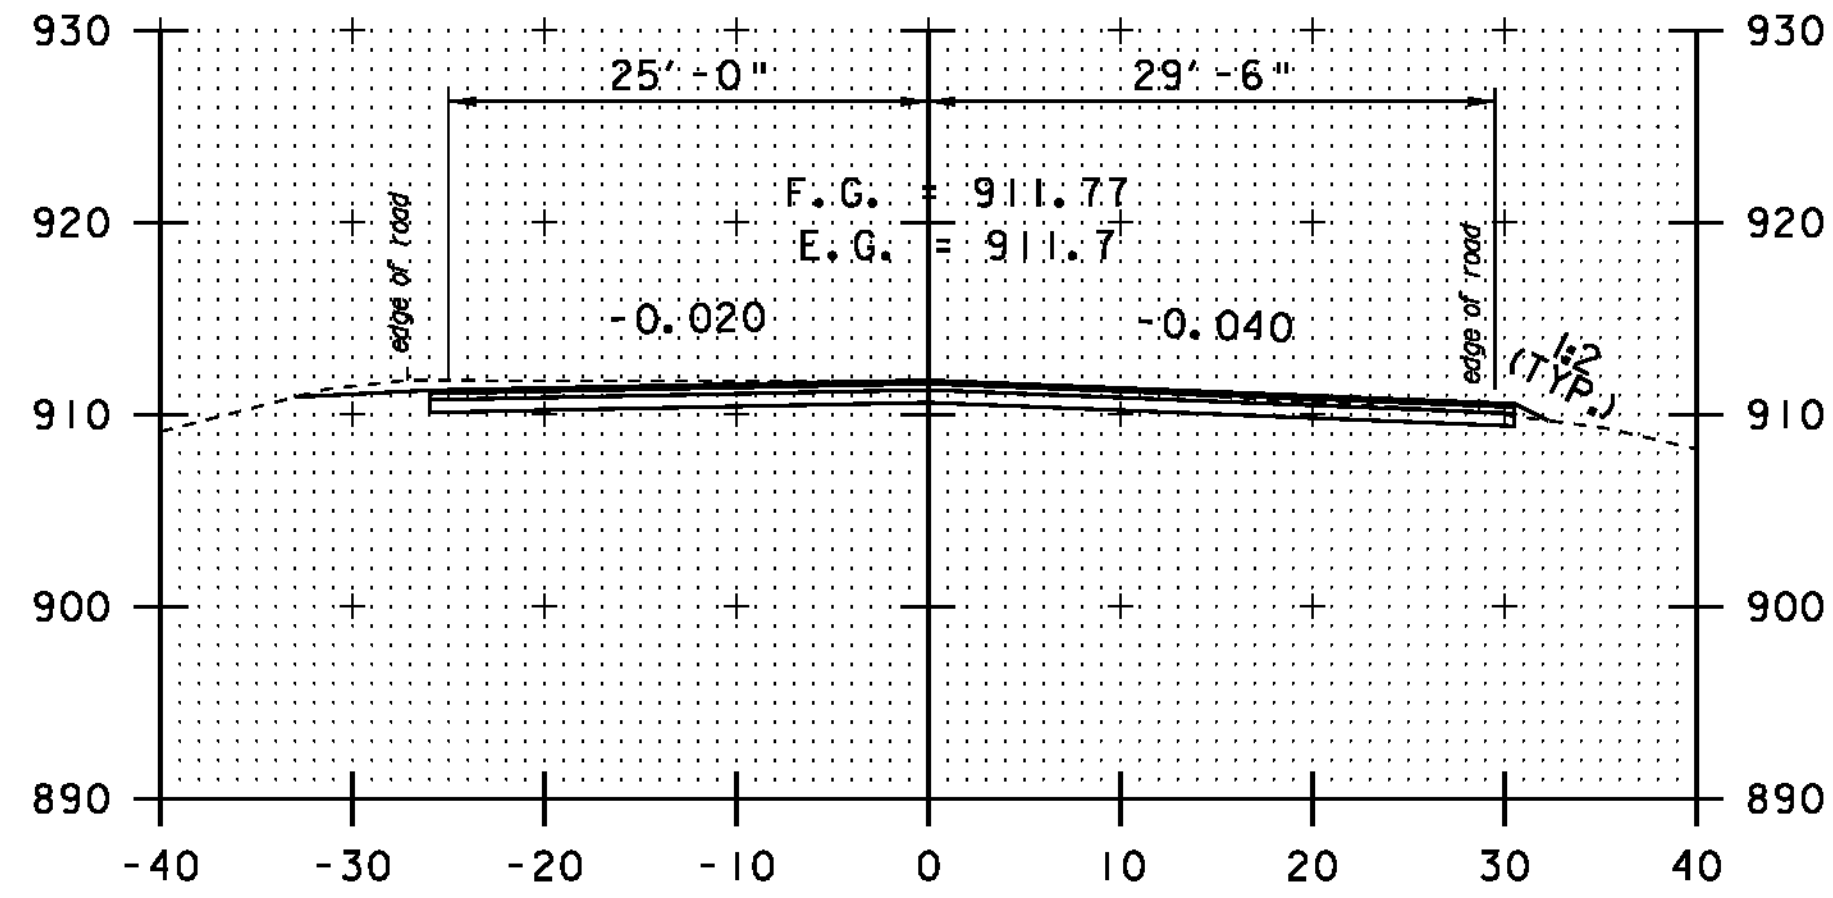


226+50

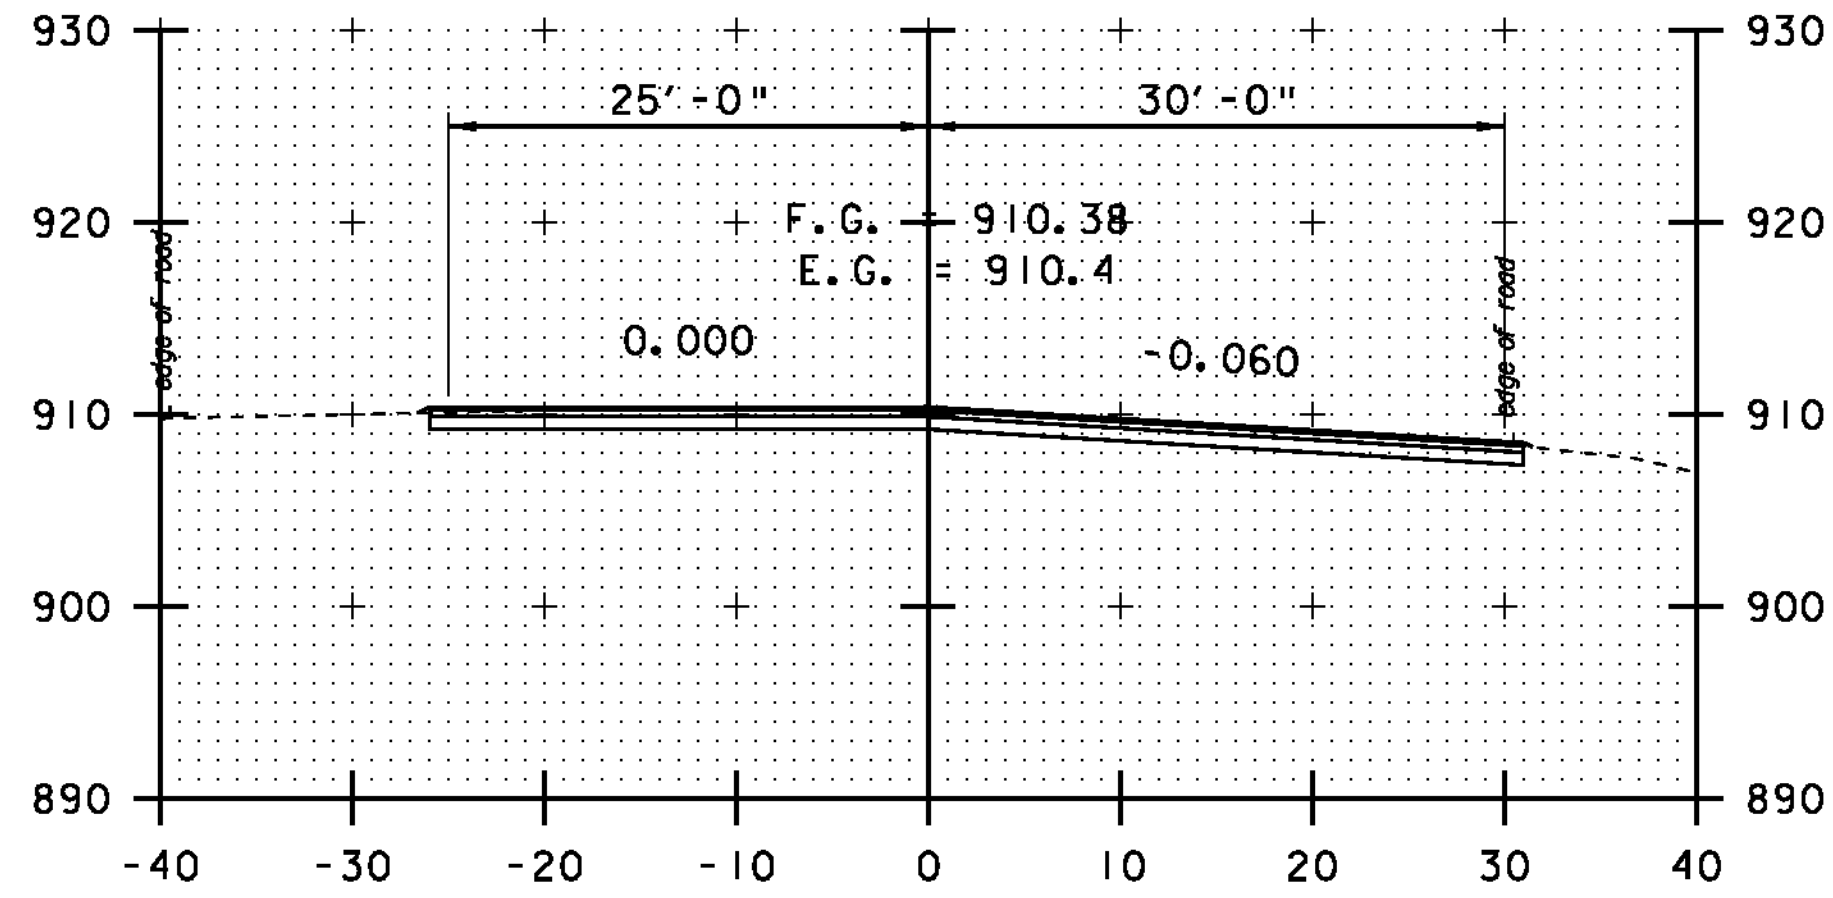


226+00

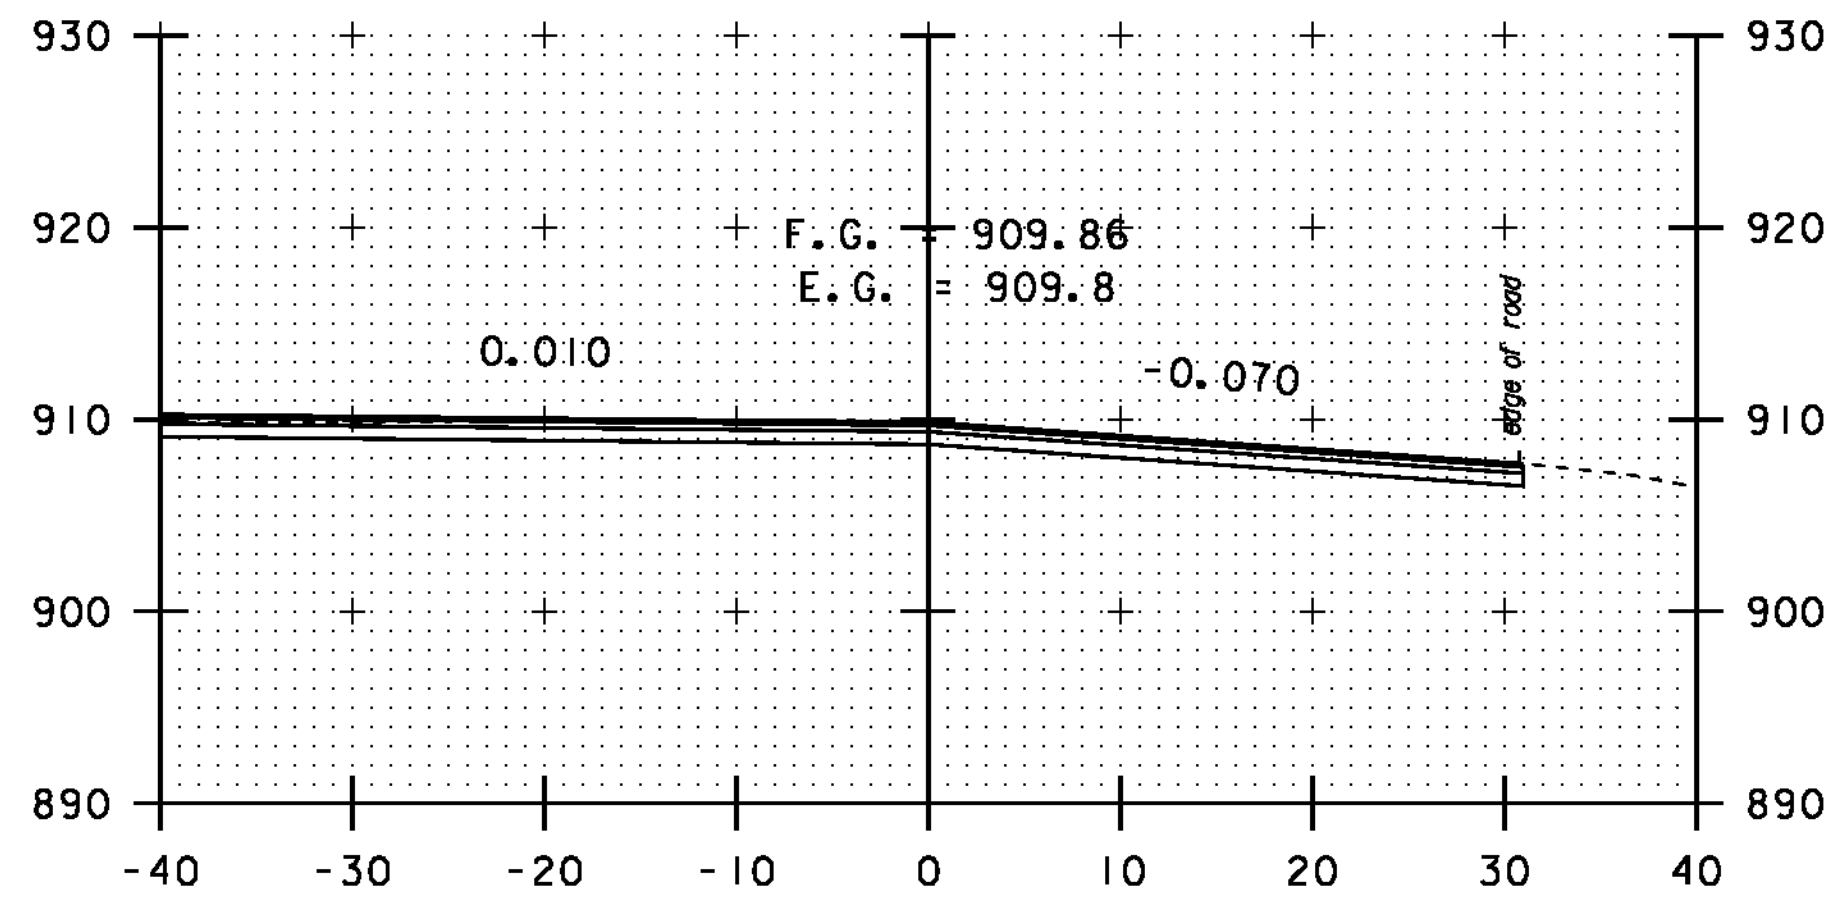


225+75

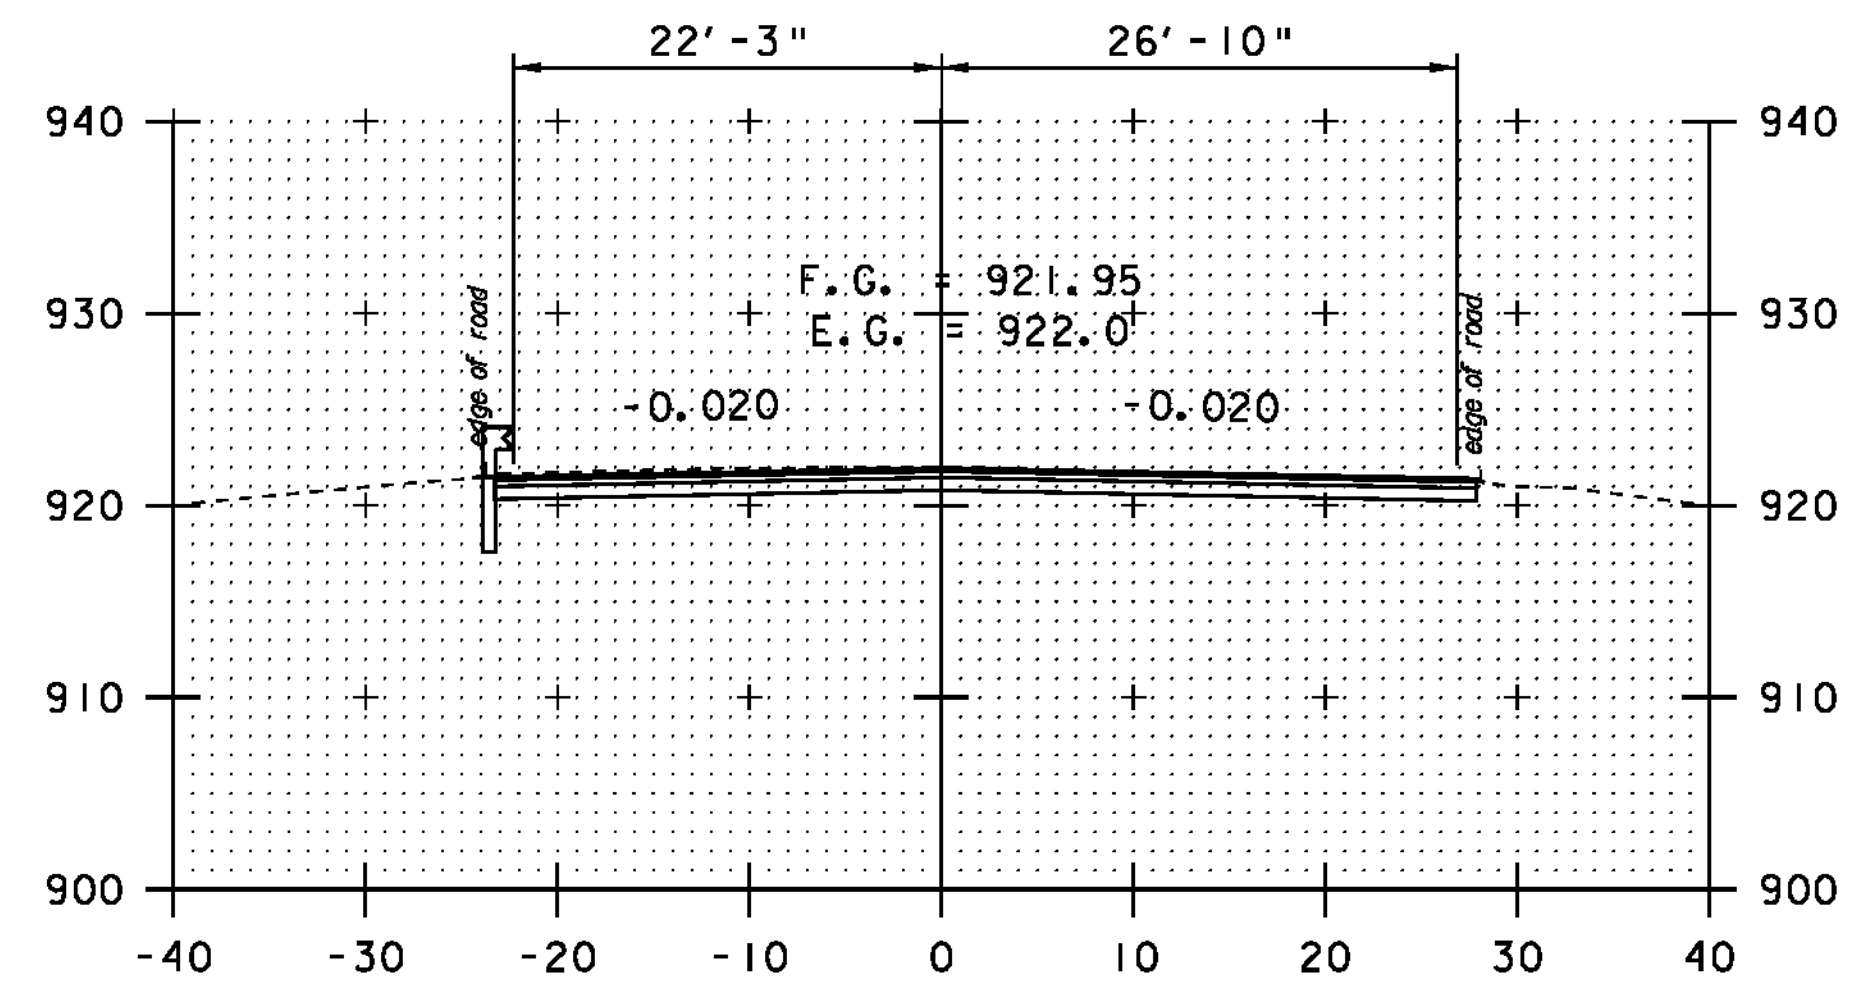

228+50

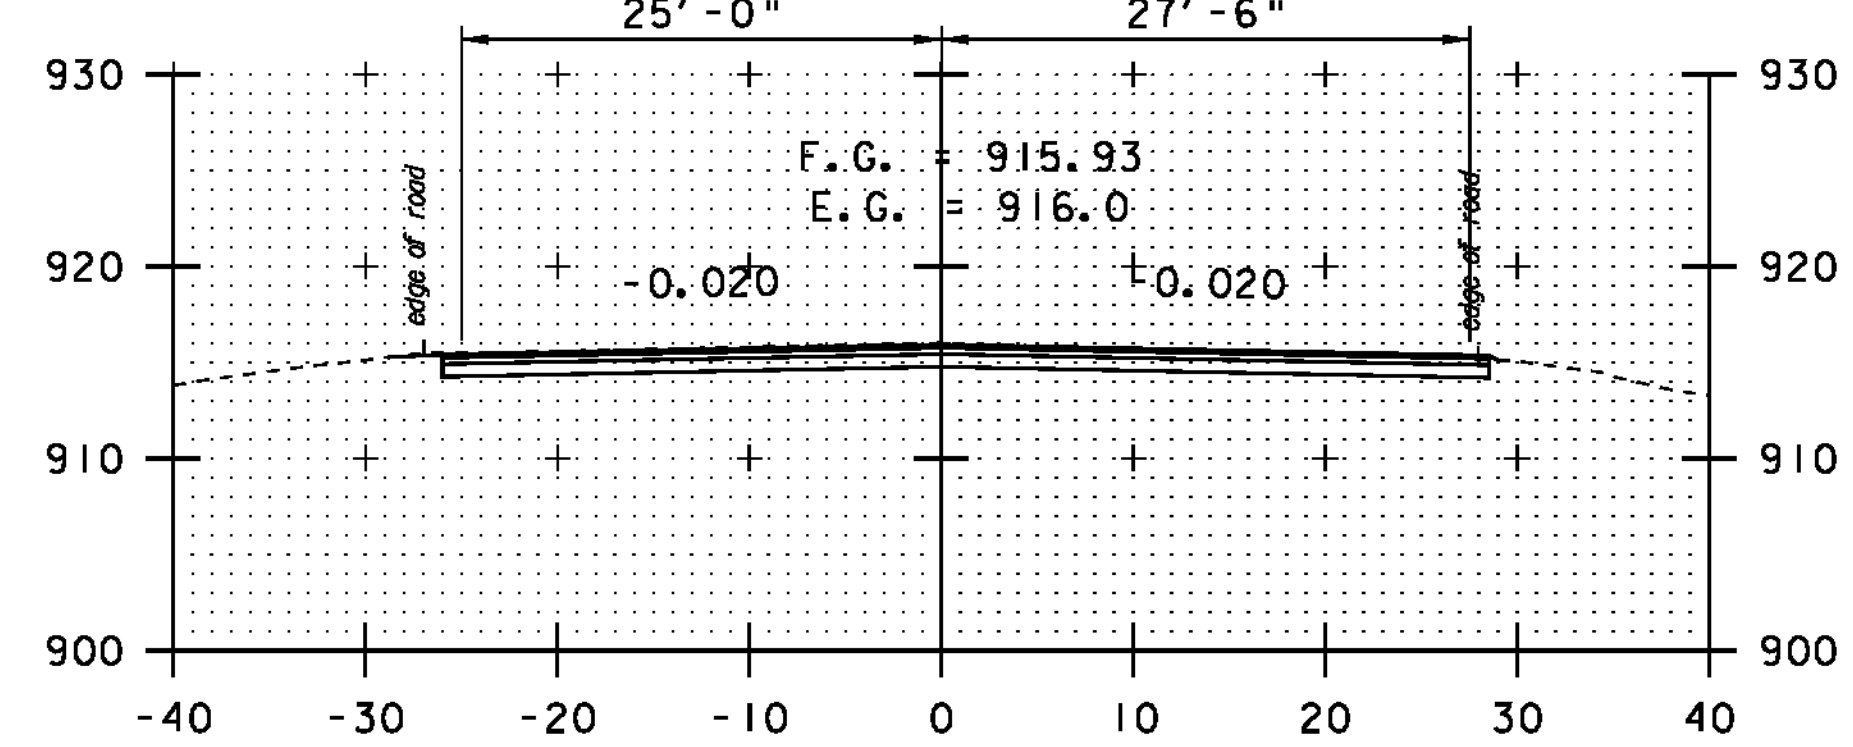

227+50

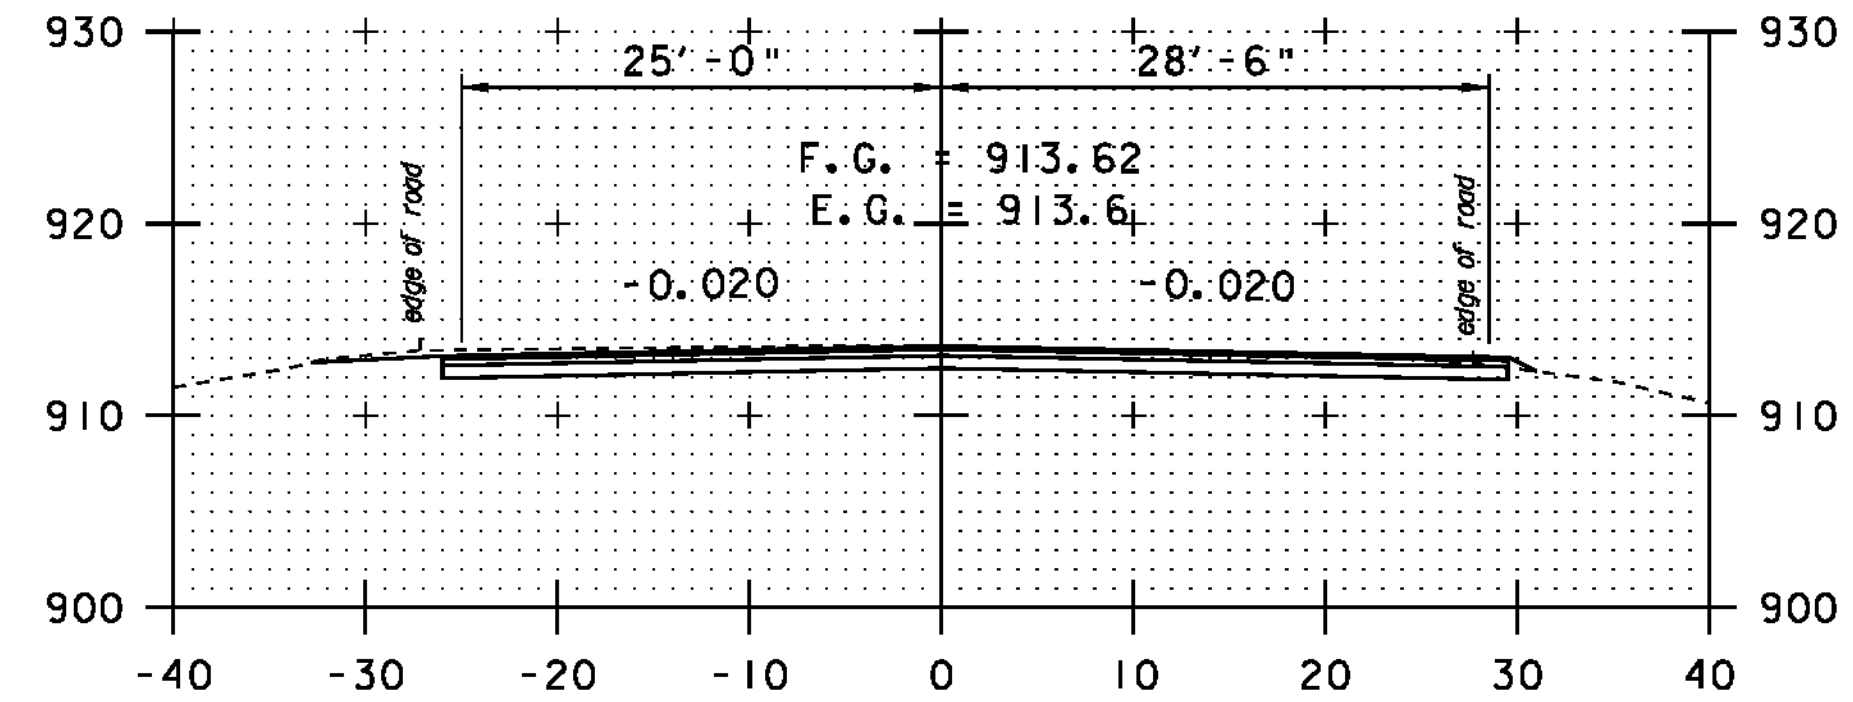

227+00

DATUM	NAVD 88
	NAD 83



STA. 1223+50
-
STA. 228+50

CROSS SECTION SHEET 12

PROJECT NAME:	NEWPORT-COVENTRY-NEWPORT
PROJECT NUMBER:	STP 2802(I)
FILE NAME:	08b158.dgn
PROJECT LEADER:	CDL
DESIGNED BY:	BMB
PLOT FILE:	08b158-85.1
PLOT DATE:	8/3/2011
DRAWN BY:	BMB
CHECKED BY:	EPD
SHEET	85 OF 134